

8/25/93
① Early
② Noon

PERMIT

SEWAGE DISPOSAL SYSTEM

DEPARTMENT OF HEALTH AND MENTAL HYGIENE

HOWARD COUNTY HEALTH DEPARTMENT

BUREAU OF ENVIRONMENTAL HEALTH

313-2640

File not found

INDEXED

✓ ① P.C.O.
P 4959 C.B.D.
A REPAIR

DISTRICT _____

DATE 9/9/93

DATE SYSTEM APPROVED 8/25/93

INSPECTOR C.B.D.

Jack Fyock Septic Services

IS PERMITTED TO INSTALL ☒ ALTER _____

ADDRESS _____ PHONE 988-9270

SUBDIVISION Pembroke Knolls LOT 1 ROAD 6874 Sanner Road

PROPERTY OWNER Baxter
ADDRESS 6874 Sanner Road
Fulton, Maryland 20759

SEPTIC TANK CAPACITY 1250 GALLONS

NUMBER OF BEDROOMS 4

125 SQUARE FEET PER BEDROOM

LINEAR FEET OF TRENCH REQUIRED 75'

REPAIR - PURPOSE - SEPTIC SYSTEM HAS FAILED.

Call for inspection when ground is opened so sanitarian can recommend repair. 08/18/93

(See back!! please) C.B.D. 8/25/93

PLANS APPROVED BY

C.B.D. for "C.W." (8/25/93)

DATE 8/25/93

COVER NO WORK UNTIL INSPECTED AND APPROVED

NEITHER THE HOWARD COUNTY COUNCIL NOR THE HEALTH DEPARTMENT IS RESPONSIBLE FOR THE SUCCESSFUL OPERATION OF ANY SYSTEM

NOTE: CLEANOUT REQUIRED EVERY 70 FEET OF SEWER LINE AND/OR AT 90° SWEEPS IN LINES FROM HOUSE TO DRAIN FIELDS, 90° ELBOWS NOT ACCEPTABLE.

NOTE: ALL PARTS OF SEPTIC SYSTEMS (I.E. TANK, DISTRIBUTION BOX TRENCHES) TO BE 100 FEET FROM WELL (UNLESS OTHERWISE SPECIFICALLY AUTHORIZED)

NOTE: IF DEEP TRENCH(ES) ARE USED CALL FOR INSPECTION BEFORE AND AFTER PLACING GRAVEL IN TRENCH(ES)

NOTE: NO DRY WELL SHALL EXCEED 15 FOOT IN DIAMETER NO ABSORPTION TRENCH TO EXCEED 100 FEET IN LENGTH

NOTE: ALL PIPE FROM HOUSE TO SEPTIC TANK MUST BE CAST IRON OR SCHEDULE 35/40 PVC OR ABS

PERMIT VOID AFTER TWO YEARS

NOTE: INSTALL STAND PIPE ON SEPTIC TANK AND DRY WELL STAND PIPES MUST BE 6 INCHES IN DIAMETER CAST IRON, CONCRETE OR TERRA COTTA OR PVA OR ABS ACCEPTED. IF TOP OF SEPTIC TANK IS DEEPER THAN 3 FEET. MANHOLE TO GRADE REQUIRED.

NOTE: DISTRIBUTION BOXES MUST HAVE BAFFLES


*INSTALLER IS RESPONSIBLE FOR OBTAINING FINAL APPROVAL ON THIS PERMIT

BLDG. PERMIT SIGNED
AND RETURNED 7/24/95

Serial # 60922

addition deck

P 49599

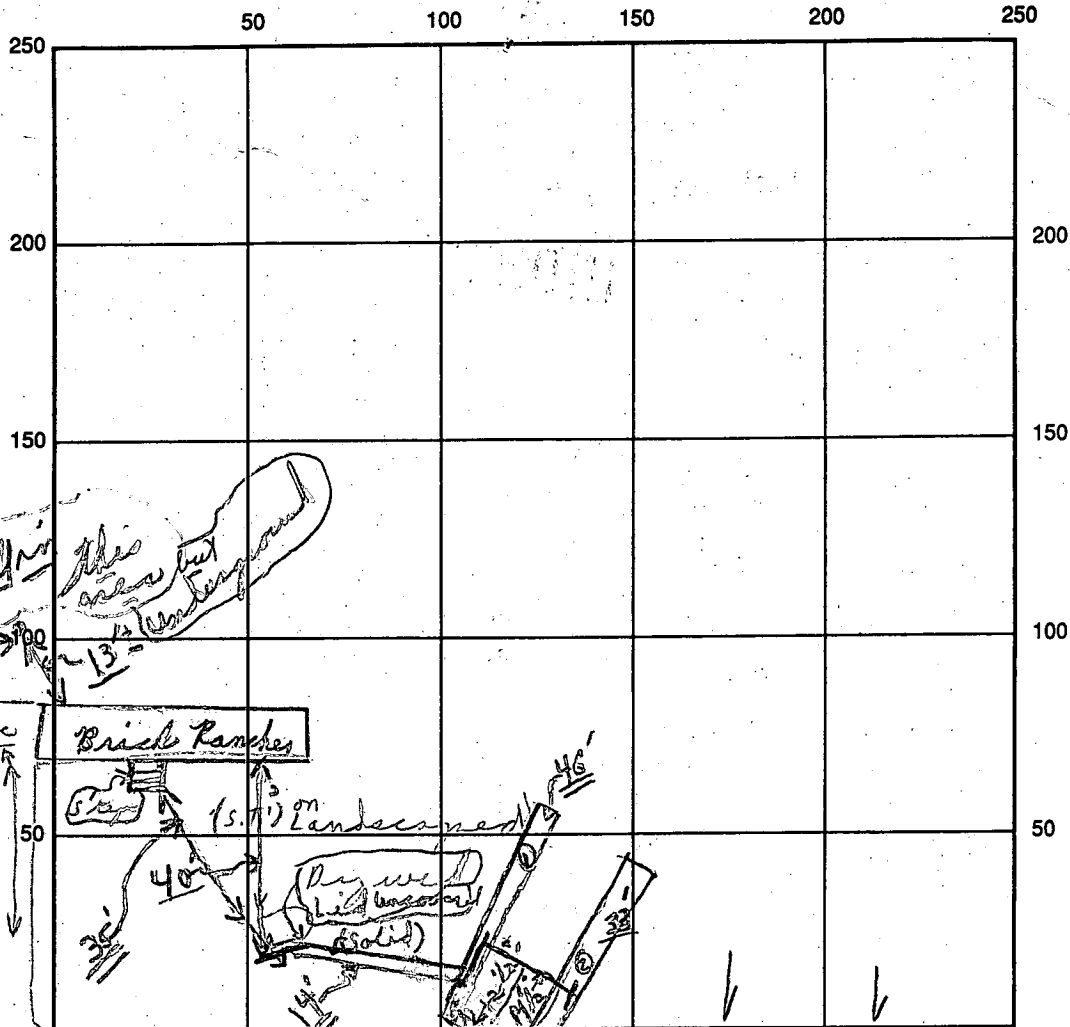

INDICATE NORTH - NAME ADJOINING ROADWAY AS BASE LINE

SEPTIC TANK LEVEL Existing CLEANOUTS Existing (D.W. C.O. To be completed)

DISTRIBUTION BOX LEVEL 1/4" (coming off old dry well)

DRAIN FIELD/TITLE DEPTH 10 FT. TRENCH WIDTH 2 FT. INLET DEPTH 2 1/2 FT.

EFFECTIVE GRAVEL DEPTH 7 1/2 FT. TOTAL LENGTH 46' + 33' = 79'

NUMBER OF TRENCHES 2 ONE SIDEWALL/BOTTOM AREA 593 SQ. FT. (Plus old system)

DRYWALL INSIDE DIAMETER — FT. EFFECTIVE DEPTH BELOW INLET — FT.

EARLY ABSORBENT AREA 593 SQ. FT. (Plus old system)


REMARKS: 8/25 Partial - ok to continue #1 trench and to dig #2 trench; 8/25 OK TO COVER AS FINISH - Material - On Site - FINAL; CR

DATE SYSTEM APPROVED 8/25/93 INSPECTOR Charles Bryan Starker

LANDTECH ASSOCIATES, INC.
1410 CRAIN HIGHWAY N.W. SUITE 70
GLEN BURNIE, MARYLAND 21061
(301) 768-2121

4-9

COPY RECEIVED: _____

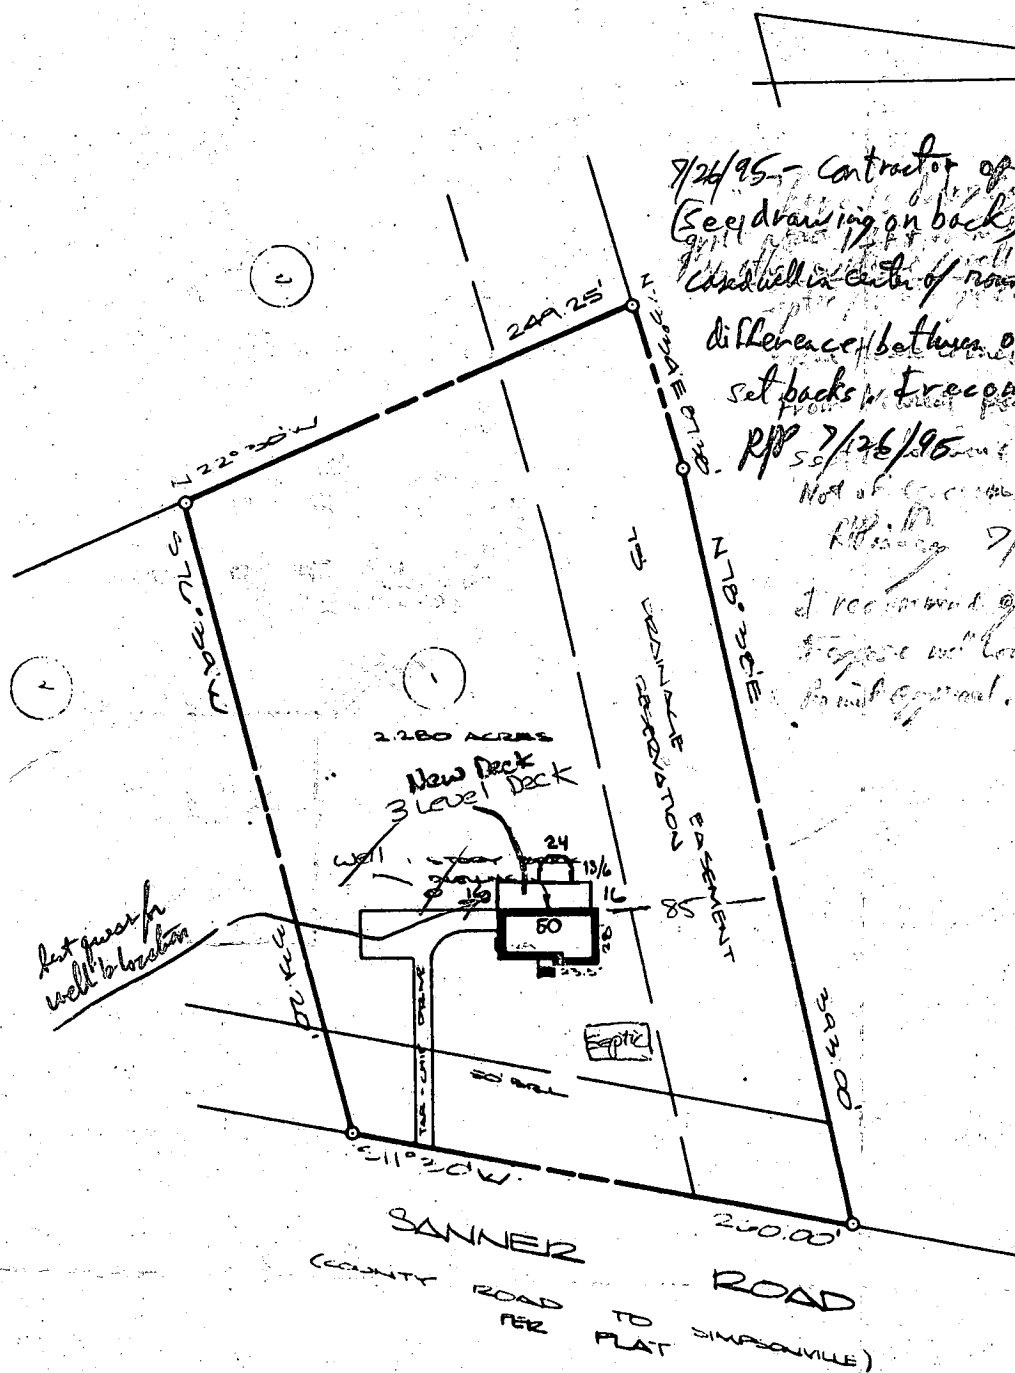

7/24/95 - Contractor opened well pit
(See drawing on back) for dimensions.
Check well in center of round pit. Not fixed
difference between old + New Bldg
set backs. I recommend approval.

RPP 7/26/95

Not of record.

7/26/95

I recommend approval
to set well location as per Bldg
Foundation.

NOTE: THIS PROPERTY LIES
IN FLOOD ZONE C, AN AREA
OF MINIMAL FLOODING, AS
DELINEATED ON THE MAPS
OF THE NATIONAL FLOOD
INSURANCE PROGRAM

NOTE: PROPERTY SUBJECT TO
SAVING - EXCEPTING, SEE
REC PLAT 52400

PROPERTY SUBJECT TO ANY AND ALL RIGHTS-OF-
WAYS, EASEMENTS AND/OR COVENANTS OF
RECORD AND/OR IMPOSED BY LAW.



NOTE: No title report furnished.

CERTIFICATION: This is to certify that the improvements
indicated hereon are located as shown. This is not a property
line survey and should not be used for the erection of fences
or any other improvements.

GRADEN A. ROGERS - PROP. L.S. MD. LIC. NO. 119

LIDER _____ FOLIO _____

LOT _____ BLOCK _____ SECT. I PLAT _____


PLAT ENTITLED Mr. & Mrs. F. J. Kline

RECORDED IN Howard Co. MD.

PLAT BOOK 4 FOLIO 52

874 Sanner Road

SCALE 1" = 20' CASE NO. H-110022
DATE 6-14, 1991 JOB NO. -T-11000

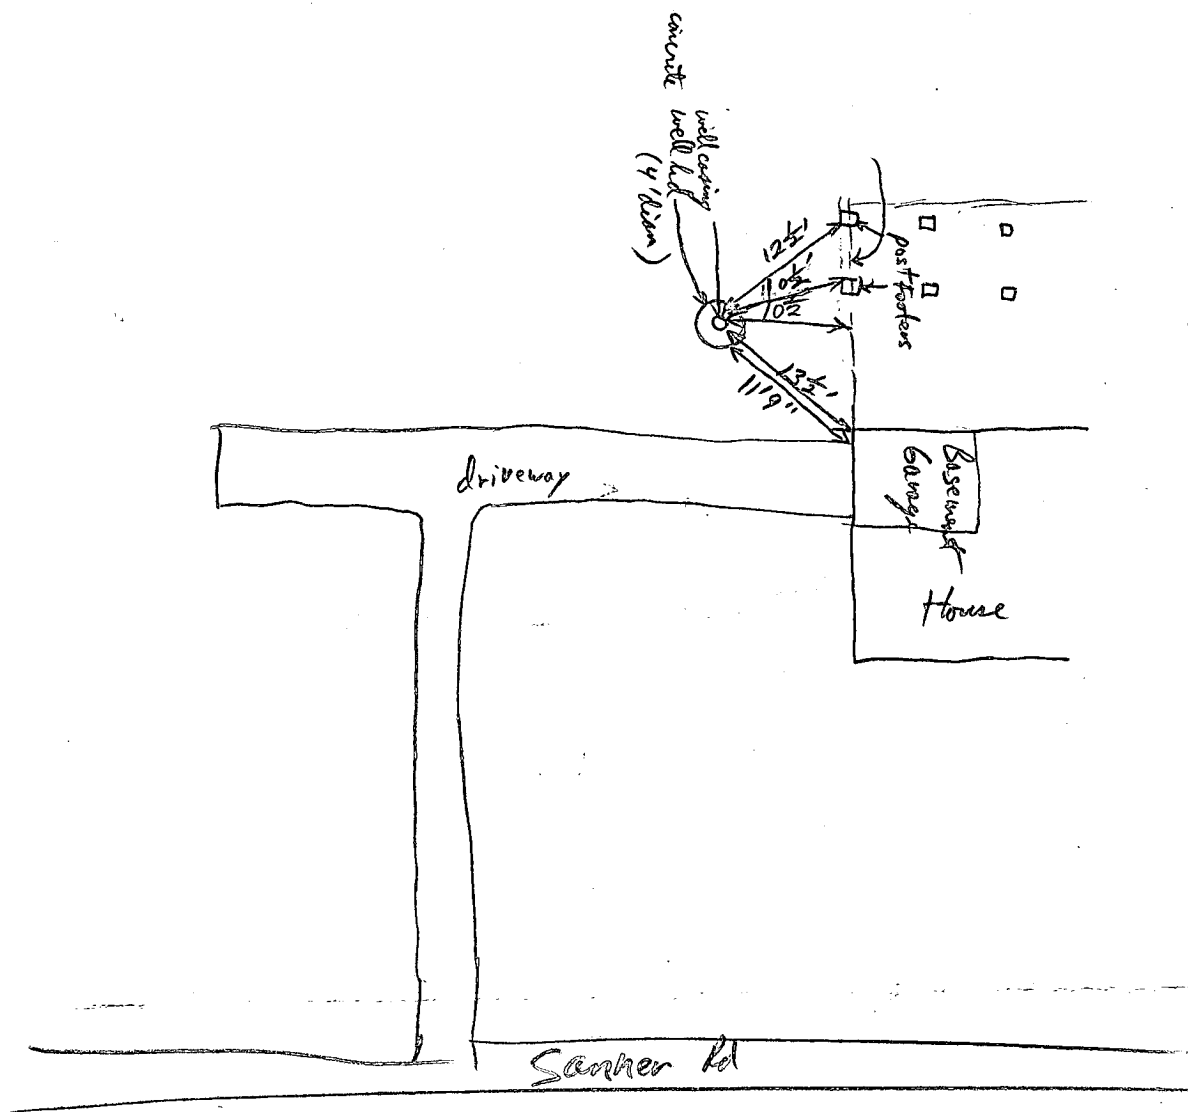

RECEIVED
HOMER COUNTY
HEALTH DEPT.
95 JUL 24 PM 2:58