

12-9-87

1 pm. Rock problems.

PERMIT

SEWAGE DISPOSAL SYSTEM

MARYLAND STATE DEPARTMENT OF HEALTH

DISTRICT 3rd

HOWARD COUNTY

BUREAU OF ENVIRONMENTAL HEALTH

461-9933

INDEXED

DATE 6/26/87

DATE SYSTEM APPROVED 12/11/87

INSPECTOR RH

03-307891

Mechanical Systems Company

IS PERMITTED TO INSTALL X ALTER

ADDRESS 940 Sunset Valley Drive, Sykesville, MD 21784 PHONE 442-1718

SUBDIVISION Sunset Valley ROAD 945 Sunset Valley Dr LOT 5

PROPERTY OWNER Patel **BUILDING PERMIT SIGNED**

ADDRESS **AND RETURNED**

IF GARBAGE GRINDER IS USED INCREASE SEPTIC TANK CAPACITY BY 50% AND ABSORPTION AREA BY 22%.

GARBAGE GRINDER? YES NO X

SEPTIC TANK CAPACITY 1250 GALLONS NUMBER OF BEDROOMS 4

TRENCHES - 200 sq. ft. per bedroom. Trench to be 3 feet wide. Inlet 3½ feet below original grade. Bottom maximum depth 5½ feet below original grade. Effective area begins at 3½ feet below original grade. 2 feet of stone below distribution pipe.

LOCATION - Shallow System Only - Start 1st trench 370 feet down the front (213.30/235.36') line beginning from the left (250') and front (213.30') juncture, and 85 feet from the front lot lines as seen when facing property from Sunset Valley Drive/ Run trenches along contour towards the rear (525') lot line.

NOTE - No trench to exceed 100 feet in length. Provide 6" - 8" diameter cleanout and cap to grade or above on septic tank.

90 296 GRAIG CHANGED I TO OK'd 3 TRENCHES END
610 90 FT LONG NIXON 3 FT WIDE IN SOMEB DATE 10/21/86

COVER NO WORK UNTIL INSPECTED AND APPROVED.

WHAT DIFFERENT LOCATION

NEITHER THE HOWARD COUNTY COUNCIL NOR THE HEALTH DEPARTMENT IS RESPONSIBLE FOR THE SUCCESSFUL OPERATION OF ANY SYSTEM.

NOTE: CLEANOUT REQUIRED EVERY 70 FEET OF SEWER LINE AND/OR AT 90° SWEEPS IN LINES FROM HOUSE TO DRAIN FIELDS.

NOTE: ALL PARTS OF SEPTIC SYSTEMS (I.E., TANK, DISTRIBUTION BOX, TRENCHES) TO BE 100 FEET FROM WELL (UNLESS OTHERWISE SPECIFICALLY AUTHORIZED)

NOTE: IF DEEP TRENCHES ARE USED CALL FOR INSPECTION BEFORE AND AFTER PLACING GRAVEL IN TRENCHES.

NOTE: NO DRY WELL SHALL EXCEED 15 FOOT IN DIAMETER. NO ABSORPTION TRENCH TO EXCEED 100 FEET IN LENGTH.

NOTE: ALL PIPE FROM HOUSE TO SEPTIC TANK MUST BE CAST IRON OR SCHEDULE 40 PVC OR ABS.

PERMIT VOID AFTER TWO YEARS.

NOTE: INSTALL STAND PIPE ON SEPTIC TANK AND DRY WELL. STAND PIPES MUST BE 6 INCHES IN DIAMETER. CAST IRON, CONCRETE OR TERRA COTTA OR PVC OR ABS ACCEPTED. IF TOP OF SEPTIC TANK IS DEEPER THAN 3 FEET, MANHOLE TO GRADE REQUIRED.

NOTE: DISTRIBUTION BOXES MUST HAVE BAFFLES.

*INSTALLER IS RESPONSIBLE FOR OBTAINING FINAL APROVAL ON THIS PERMIT


*CALL 461-9933 FOR INSPECTION OF SEPTIC SYSTEMS.

EH - 2-1186

A 37668

12-9-87
 Hole (A)
 0-4' Br si
 Sa lm,
 roots,
 topsoil
 4'-6' Red sandy
 si clay

THIS TRENCH
 ABANDONED
 & DISCONNECTED
 1/2 (rock)

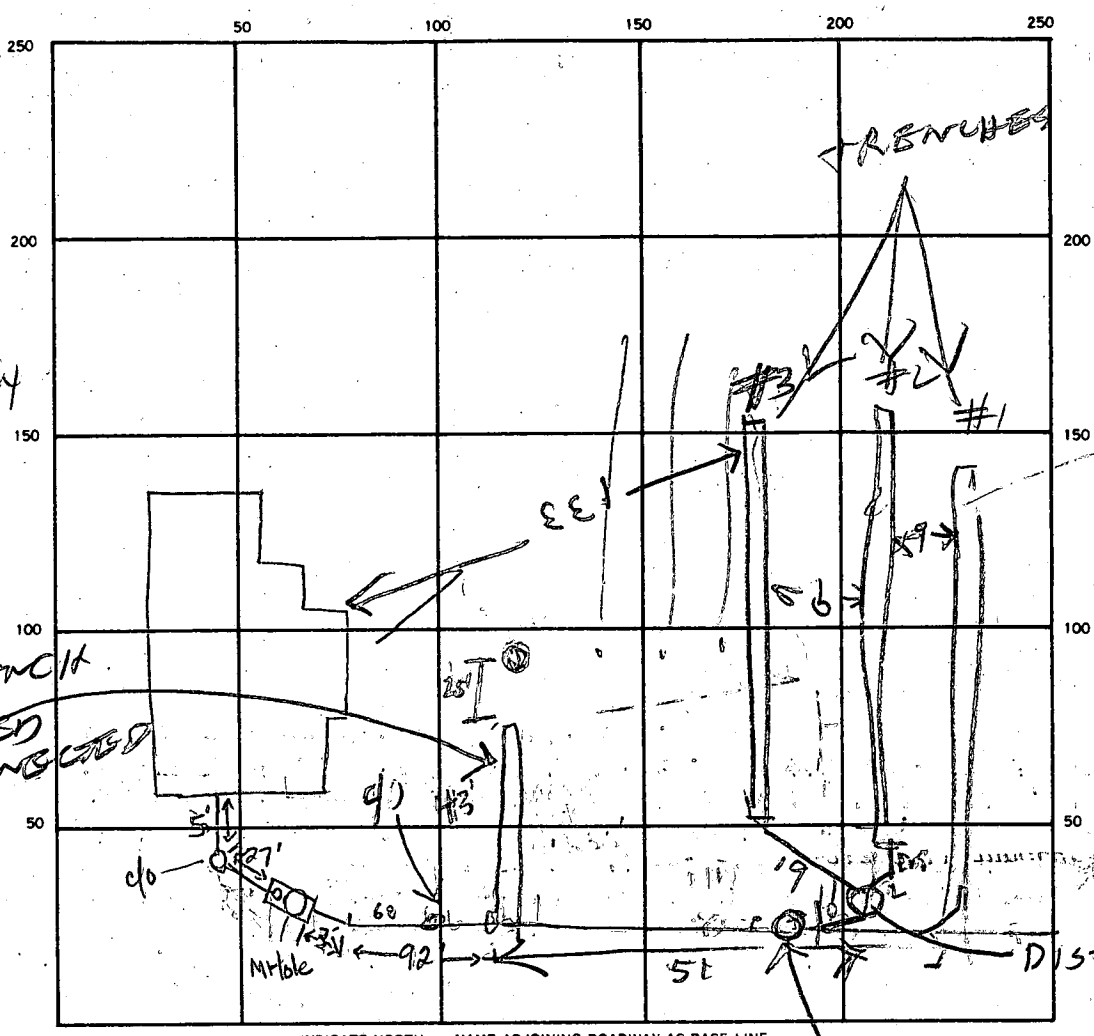

Sunset Valley Drive CLEANOUT C/O

SEPTIC TANK. LEVEL ✓ CLEANOUTS STV INLINE-2 ✓

DISTRIBUTION BOX. LEVEL ✓

DRAIN FIELD/TILE FIELD. DEPTH #1 #2 #3 TRENCH WIDTH #1 #2 #3 INLET DEPTH #1 #2 #3

EFFECTIVE GRAVEL DEPTH 2 1/2 2 1/2 FT. TOTAL LENGTH 97 93 93 FT. 203

NUMBER OF TRENCHES 3 ONE SIDEWALL/BOTTOM AREA 17.34 SQ. FT.

DRYWELL INSIDE DIAMETER FT. EFFECTIVE DEPTH BELOW INLET FT.

ABSORBENT AREA SQ. FT.

28
 26
 30
 8.9
 20
 2283
 26
 1688
 566
 1314

REMARKS 12-9-87 Contractor ran into bedrock at 2' to 5.5' near old perc hole. #13 Move trenches toward perc hole #5, 70ft from perc hole #1. Stay 10ft off back lot line as seen when facing lot from Sunset Valley Drive. Add cleanout to line between s.tank and d.box. OK to cover up to s.tank. Call when trenches are open. JEN 12/10/87 CRAIG & JBN VISITED SITE CHANGED LOCATION OF TRENCHES AFTER VISUAL HOLES 12/11/87 TRENCHES IN NEW LOCATION OK R14

TENTATIVE DATE
9/22/86 1:30

APPLICATION

PERCOLATION TESTING

9/22/86
OK'd pending
approved
plan

A 37668

P _____

HOWARD COUNTY HEALTH DEPARTMENT
BUREAU OF ENVIRONMENTAL HEALTH
P.O. BOX 476 ELLICOTT CITY, MARYLAND 21043
TELEPHONE: 461-9933

DISTRICT _____

DATE 9-4-86

TO: THE COUNTY HEALTH OFFICER
ELLICOTT CITY, MARYLAND

I, HEREBY, APPLY FOR THE NECESSARY TEST IN ORDER TO CONSTRUCT (OR RECONSTRUCT) A SEWAGE DISPOSAL SYSTEM.

PROPERTY OWNER MR. & MRS. PATEL

ADDRESS _____ PHONE _____

PROSPECTIVE BUYER NLP ENTERPRISES DAVID WICKHAM (AGENT)

ADDRESS 11422 REISTERSTOWN RD PHONE 356-7500
OWINGS MILLS, MD 21117

PROPERTY LOCATION:

SUBDIVISION SUNSET VALLEY LOT NO. 5

ROAD AND DESCRIPTION 945 SUNSET VALLEY DR.

TAX MAP _____ PARCEL # _____

SIZE OF LOT APPROX 3 ACRES TYPE BLDG. SFD

BLDG. PERMIT SIGNL
AND RETURNED 11/19/86

(SINGLE FAMILY DWELLING OR COMMERCIAL)

DPH 9012

THE SYSTEM INSTALLED UNDER THIS APPLICATION IS ACCEPTABLE ONLY UNTIL PUBLIC FACILITIES BECOME AVAILABLE. I FULLY UNDERSTAND THE

FEE CONNECTED WITH THE FILING OF THIS PERC TEST APPLICATION IS NON-REFUNDABLE UNDER ANY CIRCUMSTANCES. I ALSO AGREE TO COMPLY

WITH ALL M.O.S.H.A. REQUIREMENTS IN TESTING THIS LOT. David Wickham

(SIGNATURE OF APPLICANT)

APPROVED BY _____ FOR _____ DATE _____

REJECTED BY _____ FOR _____ DATE _____

HOLD PENDING FURTHER TESTS _____ DATE _____

REASONS FOR REJECTION OR HOLDING certified holes (good & bad)

THIS IS NOT A PERMIT

①

SOIL PROFILE

yellow/brown
hard clay
loam mixture
w/ sandy +
silty sands
10% small
rock
↓
rock
layer
8' hard
bottom


SHALLOW SYSTEM

INLET 5 1/2 200 ft steady
MAX 5 1/2

⑤ Visual
13'

similar to
hole ③ w/
less clay in
top 5'

1+4
somewhat

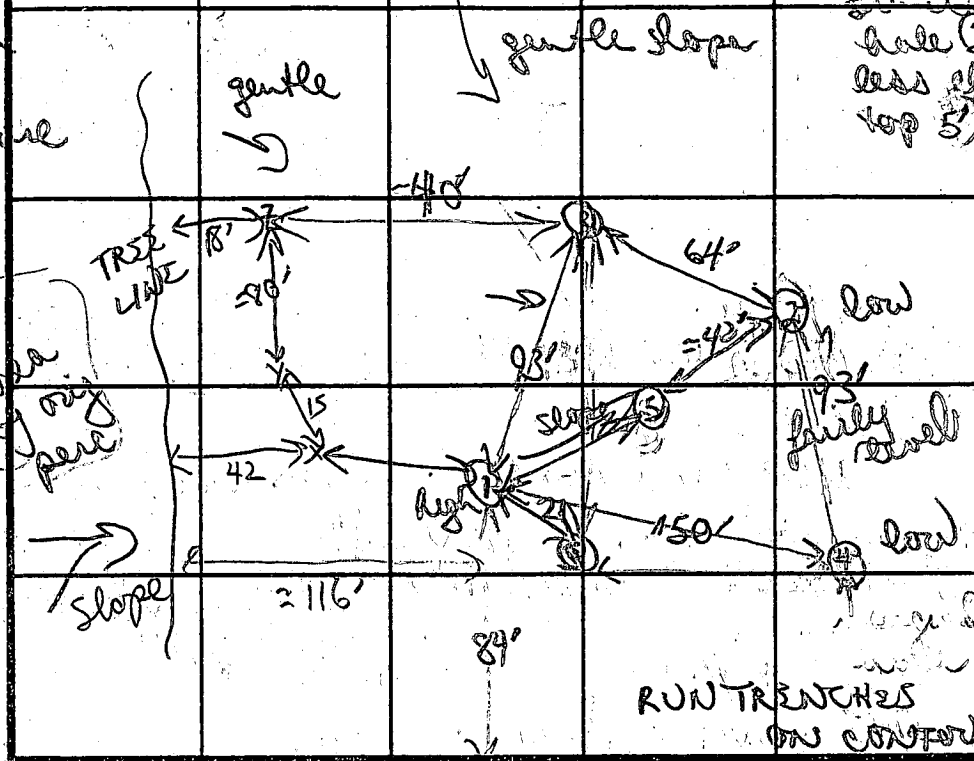

5' log rock frag
2'-4' sand
bottom
X rock 3'
Y heavy clay
w/ rock 4'

②

orange/yellow
brown mixture
of clay loam +
chunky clay - 4 1/2'
changing to
yellow orange
loam mixture
45% rock frags
↓
12' D
③

DATE	TEST NO.	DEPTH	PRE-WET		TEST - 1" DROP		TIME
			START	STOP	START	STOP	
9/22/86	①	2 1/2'	209	229	229	259	30 MIN
		8' D	hard rock bottom				
	②	5'	216	222	222	232	18 MIN
		12' D	bottom (see profile)				
	③	4 1/2'S	240	252	252	317	25 MIN
		13 1/2' D	bottom (see profile)				
	④	2 1/2'	256	308	308	328	20 MIN
		4 1/2'	301	305	305	316	11 MIN
		9' rock bottom	(see profile)				
		> 50%	large rock frags below a				
			heavy red/orange clay layer (5')				

④
AP 1-3"
brown
powdery
silty loam
2'
orange/
yellow
sandy clay
w/ small
rock frag
5'
silty
sandy
loam
8' rock frag
↓
9' sand
rock

REMARKS AREA PLAQUED W/ ROER PROBLEMS, ROCK SEEMS
TO DECREASE IN LOWER FLATTER AREA OF LOT.
yellow orange & red clays (5'); below sandy loams with
varying amounts rock frags
TESTED BY B Nyan ALSO PRESENT

APPLICATION

SEWAGE DISPOSAL TESTING

STATE OF MARYLAND - DEPARTMENT OF HEALTH AND MENTAL HYGIENE

HOWARD COUNTY HEALTH DEPARTMENT
ENVIRONMENTAL HEALTH SERVICES

P.O. BOX 476 ELLICOTT, MARYLAND 21043
TELEPHONE: 992-2330

A 29161

P _____

DISTRICT 3RD

DATE 10/12/78

TO: THE COUNTY HEALTH OFFICER
ELLICOTT CITY, MARYLAND

I, HEREBY, APPLY FOR THE NECESSARY TEST IN ORDER TO CONSTRUCT (OR RECONSTRUCT) A SEWAGE DISPOSAL SYSTEM.

PROPERTY OWNER VIRGINIA M. GARRATT

ADDRESS FORSYTHE ROAD SYKESVILLE, MD. PHONE 301-442-2262
21784

PROPERTY LOCATION:

SUBDIVISION SUNSET VALLEY LOT NO. 113 new 5
ser. 1

ROAD AND DESCRIPTION SUNSET VALLEY DRIVE

SIZE OF LOT 3.0AC.± TYPE BLDG. SINGLE FAMILY RESIDENCE

THE SYSTEM INSTALLED UNDER THIS APPLICATION IS ACCEPTABLE ONLY UNTIL PUBLIC FACILITIES BECOME AVAILABLE.

I FULLY UNDERSTAND THE FEE CONNECTED WITH THE FILING OF THIS PERC TEST APPLICATION IS NON-REFUNDABLE UNDER

ANY CIRCUMSTANCES.

SIGNATURE OF APPLICANT Bruce D. Burt

APPROVED BY Raymond Hodges FOR TRENCH OR DRY WELL DATE 3/10/83

REJECTED BY _____ FOR _____ DATE _____

HOLD PENDING FURTHER TESTS _____ DATE _____


REASONS FOR REJECTION OR HOLDING _____

THIS IS NOT A PERMIT

13

SOIL PROFILE

SUNSET VALLEY DRIVE

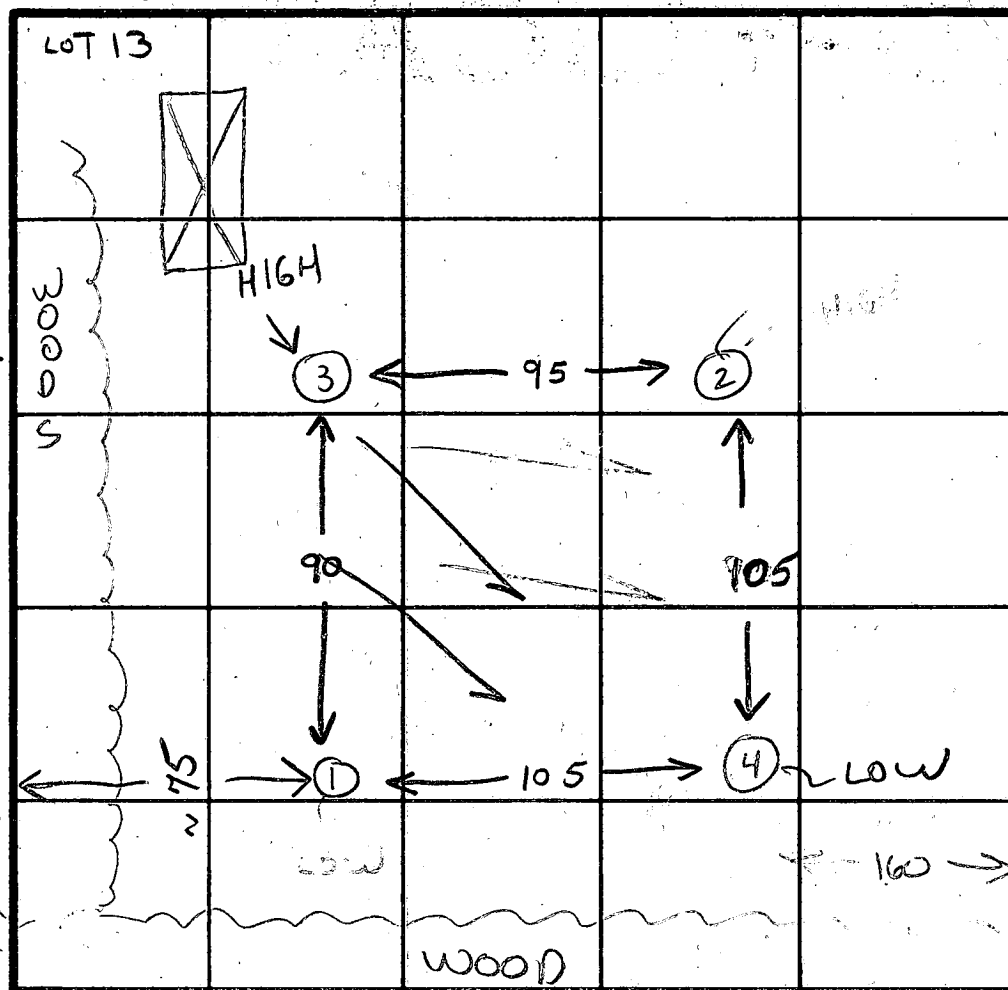

INDICATE NORTH - NAME ADJOINING ROADWAY AS BASE LINE.


DATE	TEST NO.	DEPTH	PRE-WET		TEST - 1" DROP		TIME
			START	STOP	START	STOP	
12/19/78	15	5	305	309	309	315	6
	10 2nd	12 1/2	305	307	307	311	4
	25	15	316	323	323	330	7
	20	12	315	320	320	326	6
	35	5	315	320	320	328	8
	30	12	VISUAL - SANDY				
	45	6	319	323	323	342	19
	40	13	319	323	323	331	8
4/5/79	(4)	14 1/2	SIMILAR TO (3)				
	(3)	15'	250	300	300	315	15

REMARKS open field - highwinds - tests as stated

TYPE OF SOIL sandy loam below clay

TESTED BY GLK + RD

ALSO PRESENT

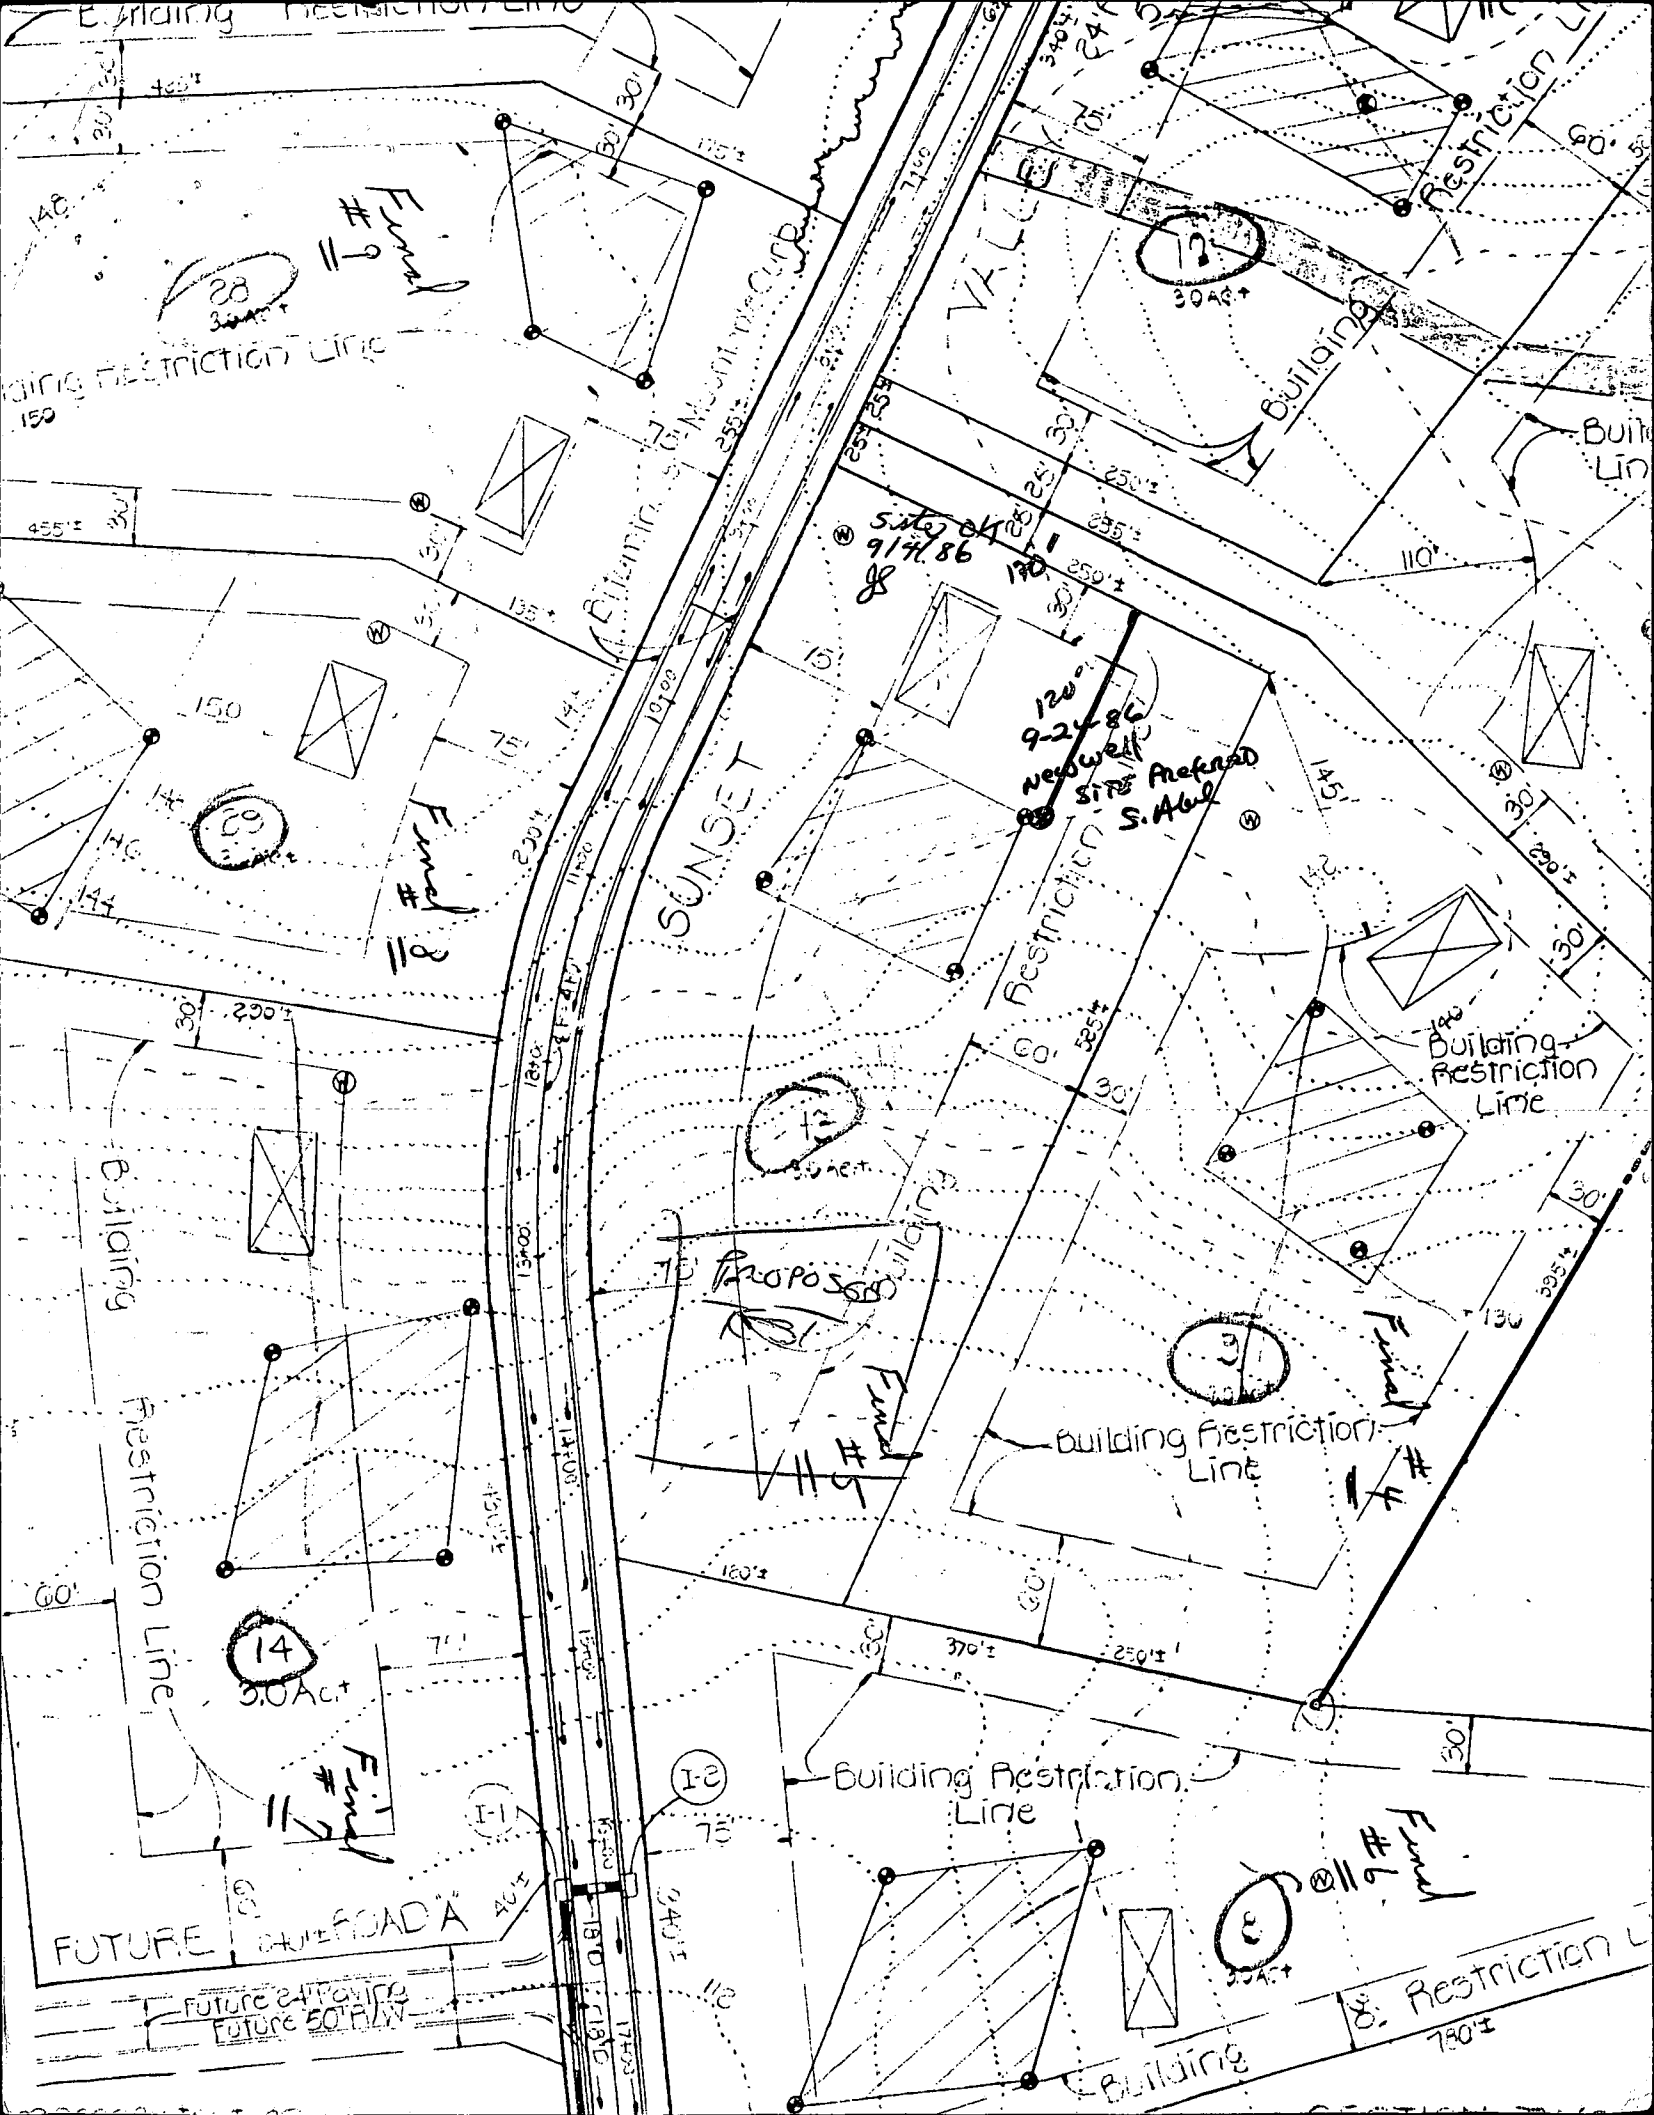

HOWARD COUNTY HEALTH DEPARTMENT
Bureau of Environmental Health
3525-H Ellicott Mills Drive
Ellicott City, MD 21043
461-9933

APPLICATION FOR PITLESS ADAPTER, WELL PUMP AND PRESSURE TANK INSTALLATION

New Installation X
Replacement _____

Receipt # 39502
Date 6/26/87

Name of Installer Mechanical Systems Co Telephone 442-1718

License Number 6681

Certified Well Pump Installer _____ Well Driller _____ Registered Plumber X

Name of Property Owner Patel Telephone _____

Subdivision Sunset Valley Lot # 5 Well Tag # _____

Site Address 945 Sunset Valley Dr Sykesville MD

Pump

1. Type

- a. Deep well jet _____
b. Shallow well jet _____
c. Submersible X _____

2. Make _____

3. Model # _____

4. Capacity _____ GPM

5. Pump exceeds well capacity Yes _____ No _____

6. If Yes, is low pressure cutoff switch installed? Yes _____ No _____

7. What methods are used to protect the pump and electrical wiring from vibrations? Torque arrestors _____ Cable guards _____ Other _____

Motor

1. Horsepower _____

2. RPM _____

3. Voltage _____

a. 110 _____

b. 220 _____

Pitless Adapter

1. Make _____

2. Model # _____

3. Depth _____

Tank

1. Capacity _____

2. Pressure relief valve? _____

Piping

1. Type _____

2. Size _____

3. NSF and/or BOCA Code approved _____

4. Depth of supply line _____

Well data

1. Depth _____ ft.

2. Yield _____ GPM

3. Static water level _____ ft.

4. Will water supply be disinfected by installer? _____

I understand that it is my responsibility to notify the Howard County Health Department when the installation is ready for inspection (otherwise this permit is null and void).

All information given above is true to the best of my knowledge.

Signature of Applicant: Douglas Patel

Date: 6-26-87

Note: A sticker indicating approval/status of the installation will be placed on the well casing at the time of the inspection.

203
2.5
141.5
566

C1 5290 (THIS NUMBER IS TO BE PUNCHED IN COLS. 3-6 ON ALL CARDS)	SEQUENCE NO. (OEP USE ONLY)	STATE OF MARYLAND WELL COMPLETION REPORT FILL IN THIS FORM COMPLETELY PLEASE PRINT OR TYPE	THIS REPORT MUST BE SUBMITTED WITHIN 45 DAYS AFTER WELL IS COMPLETED. COUNTY NUMBER <u>A 27161</u>																																																
DATE Received 	DATE WELL COMPLETED 10/5/86	Depth of Well 260 (TO NEAREST FOOT)	PERMIT NO. FROM "PERMIT TO DRILL WELL" 40-81-1658																																																
OWNER <u>N&P Enterprises Inc</u> STREET OR RFD <u>SUNSET BLVD</u> last name first name TOWN <u>SPRINGVILLE</u> SUBDIVISION <u>SUNSET VALLEY</u> SECTION <u>1</u> LOT <u>5</u>																																																			
WELL LOG Not required for driven wells STATE THE KIND OF FORMATIONS PENETRATED, THEIR COLOR, DEPTH, THICKNESS AND IF WATER BEARING <table border="1" style="width:100%; border-collapse: collapse;"> <thead> <tr> <th rowspan="2">DESCRIPTION (Use additional sheets if needed)</th> <th colspan="2">FEET</th> <th rowspan="2">Check if water bearing</th> </tr> <tr> <th>FROM</th> <th>TO</th> </tr> </thead> <tbody> <tr> <td>Top Soil</td> <td>0</td> <td>2</td> <td></td> </tr> <tr> <td>Sandy</td> <td>2</td> <td>30</td> <td></td> </tr> <tr> <td>Sand Stone</td> <td>30</td> <td>35</td> <td></td> </tr> <tr> <td>Micka</td> <td>35</td> <td>45</td> <td></td> </tr> <tr> <td>Sand Stone</td> <td>45</td> <td>50</td> <td></td> </tr> <tr> <td>Micka</td> <td>50</td> <td>260</td> <td></td> </tr> </tbody> </table>		DESCRIPTION (Use additional sheets if needed)	FEET		Check if water bearing	FROM	TO	Top Soil	0	2		Sandy	2	30		Sand Stone	30	35		Micka	35	45		Sand Stone	45	50		Micka	50	260		GROUTING RECORD WELL HAS BEEN GROUTED ☒ YES ☐ NO TYPE OF GROUTING MATERIAL CEMENT ☒ BENTONITE CLAY ☐ NO. OF BAGS <u>54</u> NO. OF POUNDS <u>780</u> GALLONS OF WATER <u>54</u> DEPTH OF GROUT SEAL (to nearest foot) from <u>0</u> ft. to <u>54</u> ft. (enter 0 if from surface) CASING RECORD casing types insert appropriate code below ST CO STEEL CONCRETE PL OT PLASTIC OTHER MAIN CASING TYPE <u>PL</u> Nominal diameter <u>6</u> Total depth of main casing (nearest foot) <u>13</u> (nearest inch) OTHER CASING (if used) diameter inch <u> </u> depth (feet) from <u> </u> to <u> </u> SCREEN RECORD screen type or open hole insert appropriate code below ST BR HO STEEL BRASS OPEN PL OT PLASTIC OTHER C2 DEPTH (nearest ft.) <table border="1" style="width:100%; border-collapse: collapse;"> <tr> <td>8</td><td>9</td><td>11</td><td>15</td><td>17</td><td>21</td> </tr> <tr> <td>23</td><td>24</td><td>26</td><td>30</td><td>32</td><td>36</td> </tr> <tr> <td>38</td><td>39</td><td>41</td><td>45</td><td>47</td><td>51</td> </tr> </table> SLOT SIZE 1 <u> </u> 2 <u> </u> 3 <u> </u> DIAMETER OF SCREEN <u> </u> (NEAREST INCH) from to GRAVEL PACK IF WELL DRILLED WAS FLOWING WELL INSERT F IN BOX 68 ☐		8	9	11	15	17	21	23	24	26	30	32	36	38	39	41	45	47	51
DESCRIPTION (Use additional sheets if needed)	FEET		Check if water bearing																																																
	FROM	TO																																																	
Top Soil	0	2																																																	
Sandy	2	30																																																	
Sand Stone	30	35																																																	
Micka	35	45																																																	
Sand Stone	45	50																																																	
Micka	50	260																																																	
8	9	11	15	17	21																																														
23	24	26	30	32	36																																														
38	39	41	45	47	51																																														
A WELL WAS ABANDONED AND SEALED WHEN THIS WELL WAS COMPLETED E ELECTRIC LOG OBTAINED P TEST WELL CONVERTED TO PRODUCTION WELL I HEREBY CERTIFY THAT THIS WELL HAS BEEN CONSTRUCTED IN ACCORDANCE WITH COMAR 10.17.13 "WELL CONSTRUCTION" AND IN CONFORMANCE WITH ALL CONDITIONS STATED IN THE ABOVE CAPTIONED PERMIT, AND THAT THE INFORMATION PRESENTED HEREIN IS ACCURATE AND COMPLETE TO THE BEST OF MY KNOWLEDGE. DRILLERS IDENT. NO. <u>273</u> DRILLERS SIGNATURE <u>Ralph E. Wayne</u> (MUST MATCH SIGNATURE ON APPLICATION) SITE SUPERVISOR (sign. of driller or journeyman responsible for sitework if different from permittee)		PUMPING TEST HOURS PUMPED (nearest hour) <u>3</u> PUMPING RATE (gal. per min. to nearest gal.) <u>7</u> METHOD USED TO MEASURE PUMPING RATE <u>Bucket</u> WATER LEVEL (distance from land surface) BEFORE PUMPING <u>10</u> WHEN PUMPING <u>10</u> TYPE OF PUMP USED (for test) ☒ air ☐ piston ☐ turbine ☐ centrifugal ☐ rotary ☐ other (describe below) ☐ jet ☒ submersible PUMP INSTALLED DRILLER WILL INSTALL PUMP YES ☒ NO ☐ IF DRILLER INSTALLS PUMP, THIS SECTION MUST BE COMPLETED FOR ALL WELLS EXCEPT HOME USE TYPE OF PUMP INSTALLED <u> </u> PLACE (A,C,J,P,R,S,T,O) IN BOX - SEE ABOVE: <u> </u> CAPACITY: GALLONS PER MINUTE (to nearest gallon) <u> </u> PUMP HORSE POWER <u> </u> PUMP COLUMN LENGTH (nearest ft.) <u> </u> CASING HEIGHT (circle appropriate box and enter casing height) ☒ above ☐ below LAND SURFACE <u> </u> (nearest foot) LOCATION OF WELL ON LOT SHOW PERMANENT STRUCTURE SUCH AS BUILDING, SEPTIC TANKS, AND/OR LANDMARKS AND INDICATE NOT LESS THAN TWO DISTANCES (MEASUREMENTS TO WELL) 																																																	
T ☐ (E.R.O.S.) ☐ WQ ☐ 70 ☐ 72 ☐ 74 ☐ 75 ☐ 76 ☐ TELESCOPE CASING LOG INDICATOR OTHER DATA		HEALTH																																																	

Review OL S. Atal 5-4-87


Well Permit No. HO - 81-1658
Location of property (road) Sun SET Valley Dr.
subdivision Sunset Valley Lot 15 Block _____ Plat _____ Sec. _____
Well Driller Ralph Maynard Owner NLP Enterprises Inc

1. High rate pumping -- reservoir drawdown

II. Recovery pump test data - observations to be recorded every 15 minutes

[illegible]

43 ft 37 open 9 bags

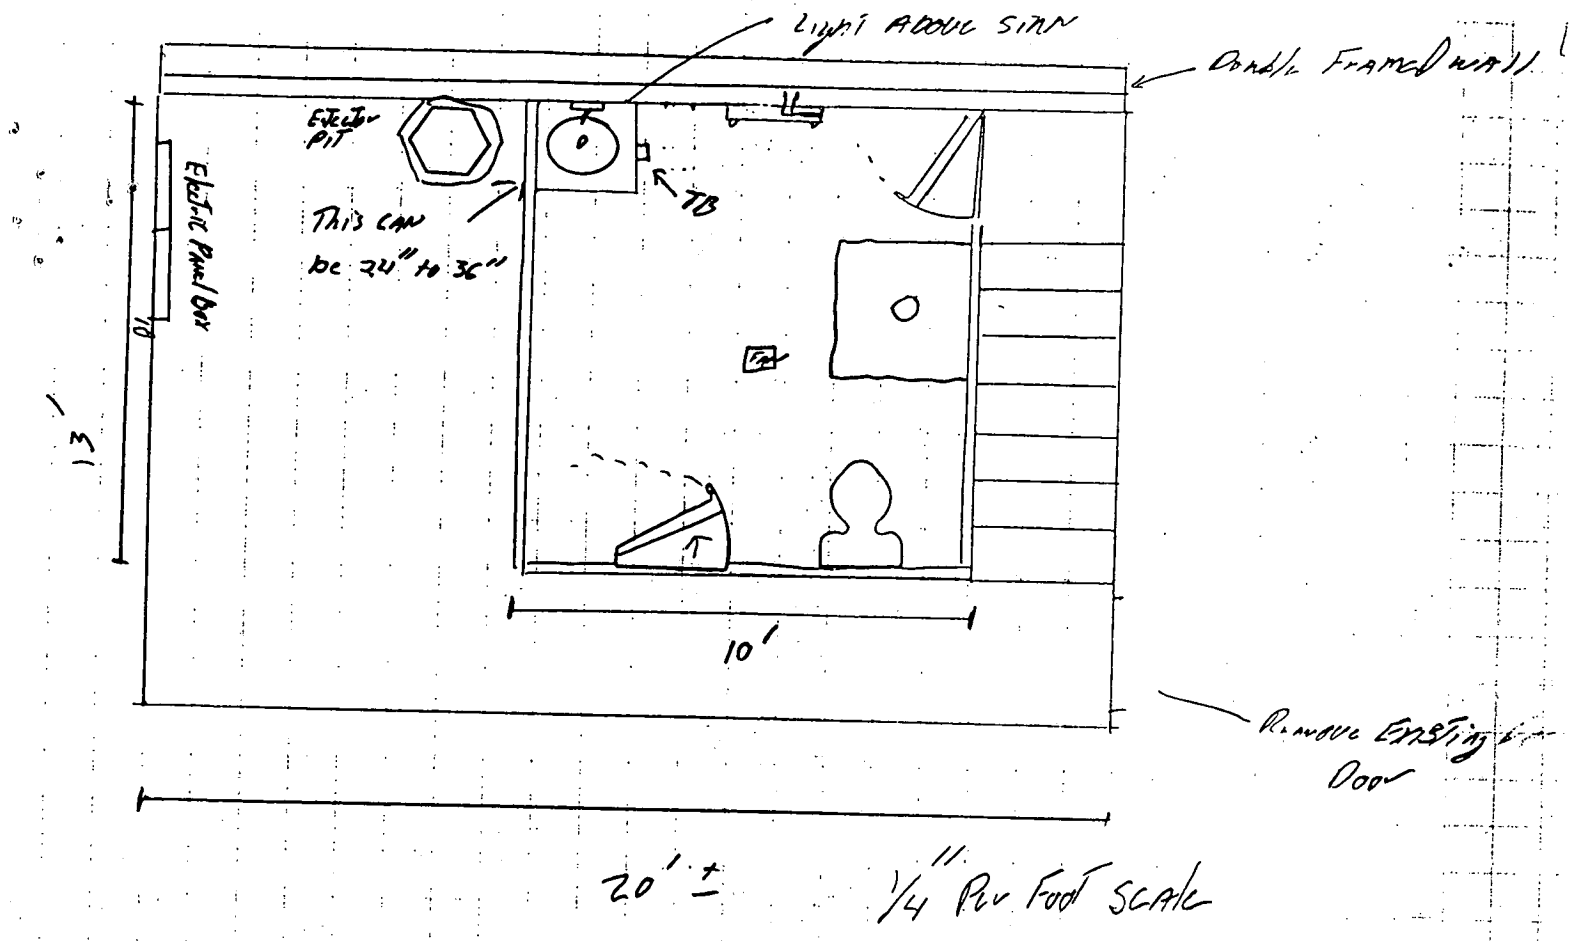

APPROVED

WALK-THRU BUILDING PERMIT

BP# 00148432 A# 37668

APP. SAN K7L DATE: 5/26/04

DESC. OF WORK: BATHROOM

in basement


Property known as: **Lot 5**
SUNSET VALLEY
ROW ONE

LOTS 1-10 PLAT 4616
3RD ELECTION DISTRICT
HOWARD COUNTY, MD

THIS PLAT CAN NOT BE USED TO ESTABLISH PROPERTY LINES OR CORNERS.

SUNSET VALLEY DRIVE

APPROVED
WALK-THRU BUILDING PERMIT
BP# B00152854 A# 37668
APP. SAN P.A.Y. DATE: 11/3/05
DESC. OF WORK: 25x28 irregular
shaped deck.

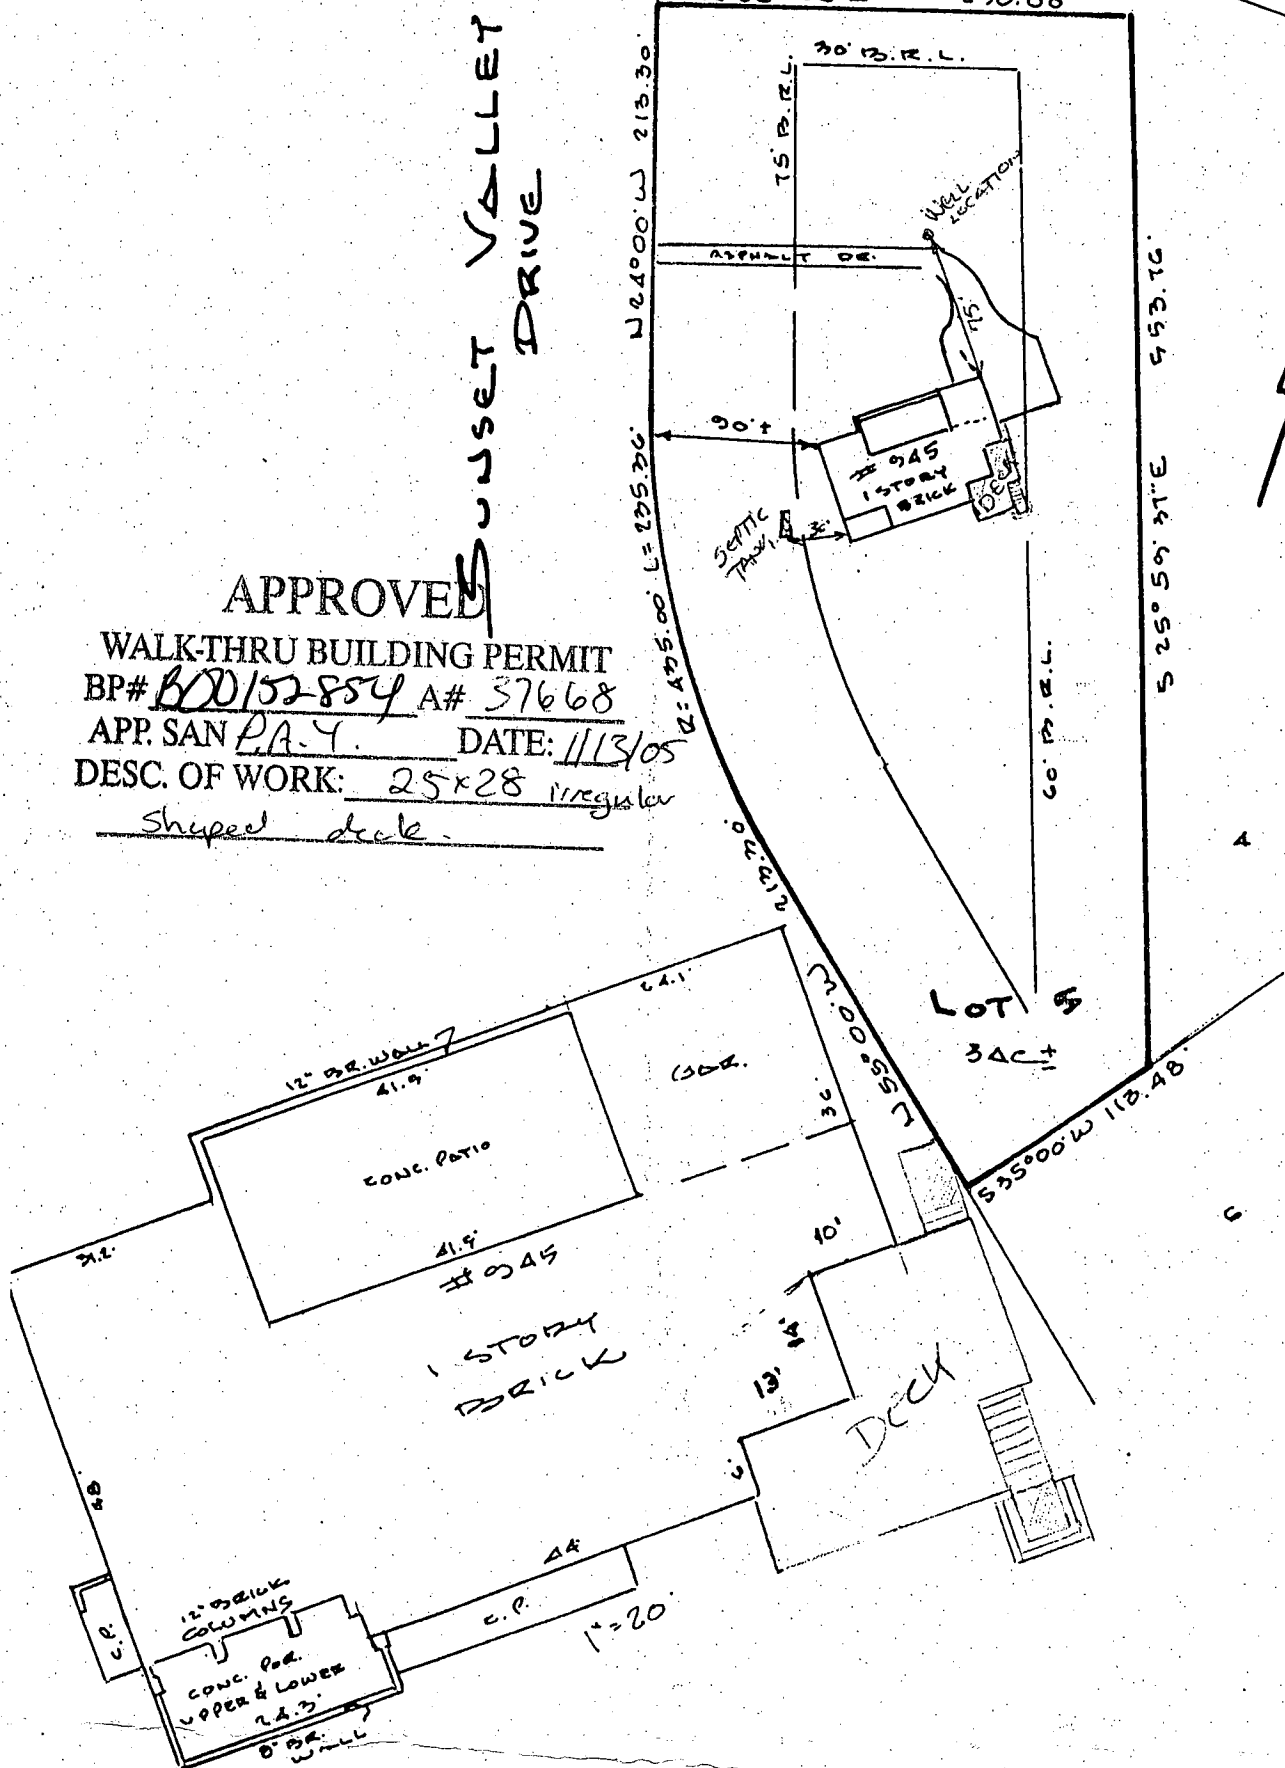


LOCATION SURVEY PLAT
PROJECT PROPERTY NOT LOCATED IN A FLOOD PLAIN AREA UNLESS OTHERWISE NOTED

CERTIFICATION

SEAL

SCALE 1"=100' DATE 5-15-1997

I am to certify that I have surveyed
property known as: 945
SUNSET VALLEY DRIVE

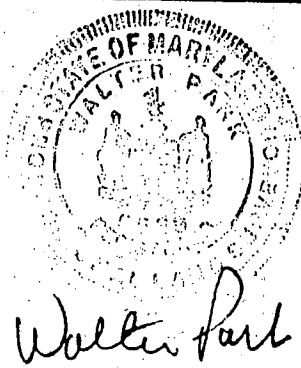

LDE Inc.

9250 Rumsey Road Suite 106
Columbia, Maryland 21045

(Balt.) 410-715-1070
(Wash.) 301-596-3424
(FAX) 410-715-9540

for the purpose of locating the im-
provements thereon, and the improvements
are located as shown.