

2/14/89 3:04 PM
2/15/89 2:04 PM

Tax ID - 05-404230 File

WELL COMPLETION 2/11 P.C.O. C.B.S.

PERMIT

SEWAGE DISPOSAL SYSTEM

MARYLAND STATE DEPARTMENT OF HEALTH

HOWARD COUNTY
BUREAU OF ENVIRONMENTAL HEALTH
461-9933

INDEXED

P 44389
A 37760
DISTRICT 5th
DATE 5/25/89
DATE SYSTEM APPROVED 2/11/89
INSPECTOR C.B.S.

Frall Septic Service, Inc.

IS PERMITTED TO INSTALL X ALTER

ADDRESS P. O. Box 659, Mt. Airy, Maryland 21771 PHONE 795-5674

SUBDIVISION Newhouse S/D ROAD 5270 Ten Oaks Road LOT 24

PROPERTY OWNER G. W. Smith Associates, Inc.

ADDRESS ~~Lawrence Morris~~ Carl Lynch

IF GARBAGE GRINDER IS USED INCREASE SEPTIC TANK CAPACITY BY 50% AND ABSORPTION AREA BY 22%.

GARBAGE GRINDER? YES X NO

SEPTIC TANK CAPACITY 2000 GALLONS NUMBER OF BEDROOMS 4

220
3 (8810)
293 ft trench

TRENCHES - 220 sq. ft. per bedroom with garbage disposal. Trench to be 3 feet wide. Inlet 3.5 feet below original grade. Bottom maximum depth 5.5 feet below original grade. Effective area begins at 3.5 feet below original grade. 2 feet of stone below distribution pipe.

LOCATION - Beginning from the ~~LEFT REAR~~ lot corner, place 1st trench 180 feet down the rear (277.55') lot line and 15 feet off the rear line as seen when facing property from Ten Oaks Road. Run trenches along contour towards the left (470.57') line.

NOTE - No trench to exceed 100 feet in length. Provide 6" - 8" diameter cleanout and cap to grade or above on septic tank.

OK TO INSTALL 1-1 1/2" DEEPER 7/10/89 CW

PLANS APPROVED BY B. Nixon DATE 6/24/87

COVER NO WORK UNTIL INSPECTED AND APPROVED

NEITHER THE HOWARD COUNTY COUNCIL NOR THE HEALTH DEPARTMENT IS RESPONSIBLE FOR THE SUCCESSFUL OPERATION OF ANY SYSTEM.

NOTE: CLEANOUT REQUIRED EVERY 70 FEET OF SEWER LINE AND/OR AT 90° SWEEPS IN LINES FROM HOUSE TO DRAIN FIELDS

NOTE: ALL PARTS OF SEPTIC SYSTEMS (I.E. TANK, DISTRIBUTION BOX, TRENCHES) TO BE 100 FEET FROM WELL (UNLESS OTHERWISE SPECIFICALLY AUTHORIZED)

NOTE: IF DEEP TRENCHES ARE USED CALL FOR INSPECTION BEFORE AND AFTER PLACING GRAVEL IN TRENCHES

NOTE: NO DRY WELL SHALL EXCEED 15 FOOT IN DIAMETER NO ABSORPTION TRENCH TO EXCEED 100 FEET IN LENGTH

NOTE: ALL PIPE FROM HOUSE TO SEPTIC TANK MUST BE CAST IRON OR SCHEDULE 40 PVC OR ABS

PERMIT VOID AFTER TWO YEARS

NOTE: INSTALL STAND PIPE ON SEPTIC TANK AND DRY WELL. STAND PIPES MUST BE 6 INCHES IN DIAMETER. CAST IRON, CONCRETE OR TERRA COTTA OR PVC OR ABS ACCEPTED. IF TOP OF SEPTIC TANK IS DEEPER THAN 3 FEET, MANHOLE TO GRADE REQUIRED

NOTE: DISTRIBUTION BOXES MUST HAVE BAFFLES

B00128409/FINISH BASEMENT-RECRM AND 1/2 bath


*INSTALLER IS RESPONSIBLE FOR OBTAINING FINAL APPROVAL ON THIS PERMIT

*CALL 461-9933 FOR INSPECTION OF SEPTIC SYSTEMS.

BUDG. PERMIT SIGNED
AND RETURNED 7-15-98
Serial # B10112993
Inground P.H.

BUDG. PERMIT SIGNED
AND RETURNED 4/25/90
Serial # 52232 - deck

37760

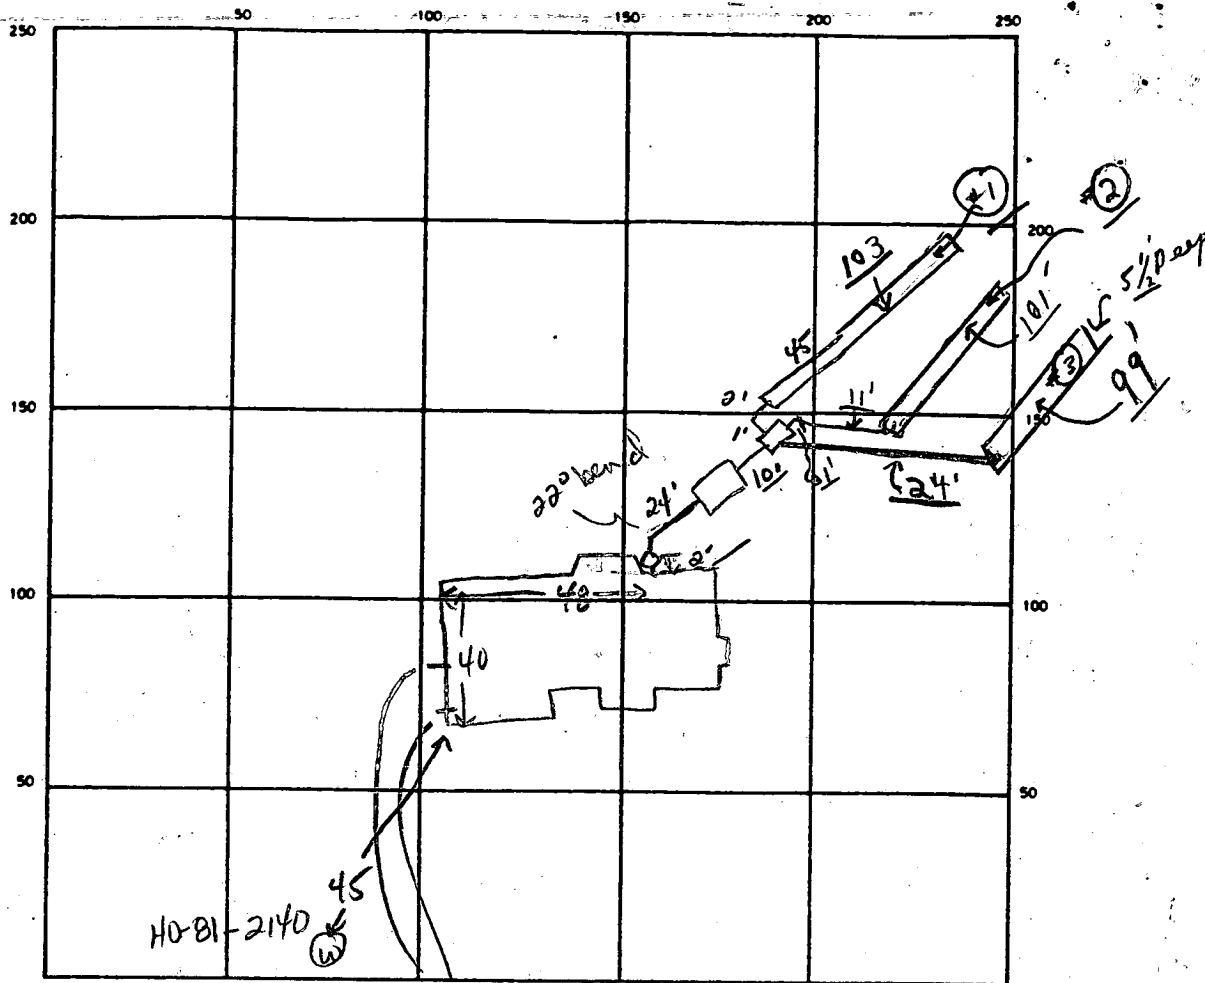

INDICATE NORTH — NAME ADJOINING ROADWAY AS BASE LINE

Ten Oaks Road

SEPTIC TANK LEVEL 2000 gal CLEANOUTS Lat house

DISTRIBUTION BOX LEVEL OK w/ baffle ✓

DRAIN FIELD/TILE FIELD DEPTH 5.5 FT. TRENCH WIDTH 3 FT. INLET DEPTH 35 FT.

EFFECTIVE GRAVEL DEPTH 2.0, 2.0, 2.0 FT. TOTAL LENGTH 103, 101, 99 FT. 303

NUMBER OF TRENCHES 3 ONE STOPPAGE BOTTOM AREA 909 SQ. FT.

DRYWELL INSIDE DIAMETER FT. EFFECTIVE DEPTH BELOW INLET FT.

ABSORBENT AREA 909 SQ. FT.

REMARKS 7-10-89 OK to continue trenches, DEN 7/11/89 A.M. - OK

TO COVER ALL WORK; EXCEPT LAST 50' ± OF ③ TRENCH. PARTIAL
7/11 A.M. - OK TO COVER - FINAL.


7/11 A.M. - PARTIAL - W.P.I. - {WATER? Lines} + pitless adapters - only - OK
DATE SYSTEM APPROVED 7/11/89 INSPECTOR Charles Byron Wheeler

PERCOLATION TESTING




DATE 7-21-86

THIS IS NOT A PERMIT

A37760

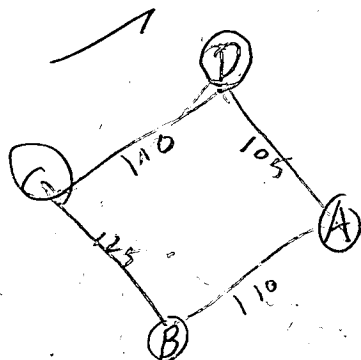

HOLE
ELEVATIONS
(B)(C) = HIGH
(D)(A) = LOW

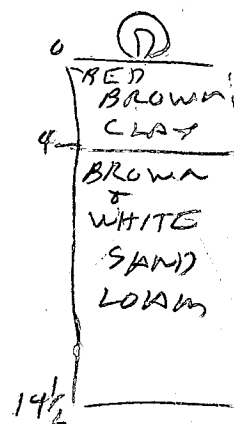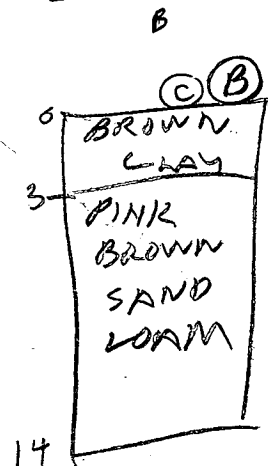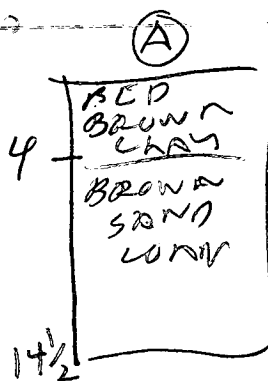

TEW OAKS RD

9/8/86	As	5 1/2	1107	1109	1109	1109	2
9/9/86	AV	14 1/2	LOOKS OK				
9/9/86	DS	6	1144	1149	1149	1153	4
	DV	14 1/2	LOOKS OK				
	BS	5	1159	1203	1203	1207	4
	BD	7 1/2	1201	1210	1210	1226	16
	BV	14 1/2	LOOKS OK				
	CS	4 1/2	1237	1241	1241	1249	8
	CV	14	LOOKS OK				

Test by R. Hodges

also Present
Alli Freedom Sanitation

APPLICATION

PERCOLATION TESTING

HOWARD COUNTY HEALTH DEPARTMENT
BUREAU OF ENVIRONMENTAL HEALTH
P.O. BOX 476, ELLICOTT CITY, MARYLAND 21043
TELEPHONE: 461-9933

A _____
P _____

DISTRICT _____

DATE _____

TO: THE COUNTY HEALTH OFFICER
ELLICOTT CITY, MARYLAND

I, HEREBY, APPLY FOR THE NECESSARY TEST, IN ORDER TO CONSTRUCT (OR RECONSTRUCT) A SEWAGE DISPOSAL SYSTEM.

PROPERTY OWNER _____

ADDRESS _____ PHONE _____

PROSPECTIVE BUYER _____

ADDRESS _____ PHONE _____

PROPERTY LOCATION:

SUBDIVISION _____ LOT NO. 2

ROAD AND DESCRIPTION Newhouse Property

Ten Oaks Rd.

TAX MAP _____ PARCEL # _____

SIZE OF LOT _____ TYPE BLDG. _____

(SINGLE FAMILY DWELLING OR COMMERCIAL)

THE SYSTEM INSTALLED UNDER THIS APPLICATION IS ACCEPTABLE ONLY UNTIL PUBLIC FACILITIES BECOME AVAILABLE. I FULLY UNDERSTAND THE FEE CONNECTED WITH THE FILING OF THIS PERC TEST APPLICATION IS NON-REFUNDABLE UNDER ANY CIRCUMSTANCES. I ALSO AGREE TO COMPLY WITH ALL M.O.S.H.A. REQUIREMENTS IN TESTING THIS LOT.

(SIGNATURE OF APPLICANT)

APPROVED BY _____ FOR _____ DATE _____


REJECTED BY _____ FOR _____ DATE _____

HOLD PENDING FURTHER TESTS _____ DATE _____

REASONS FOR REJECTION OR HOLDING _____

THIS IS NOT A PERMIT

12"	7-D Yellow BR Silt LOAM C 7% CLAY 10-15% FRAGS
3.5'	Yellow BR w/ Pinkie Cats B RICHIOUS Silt LOAM 10-15% FRAGS

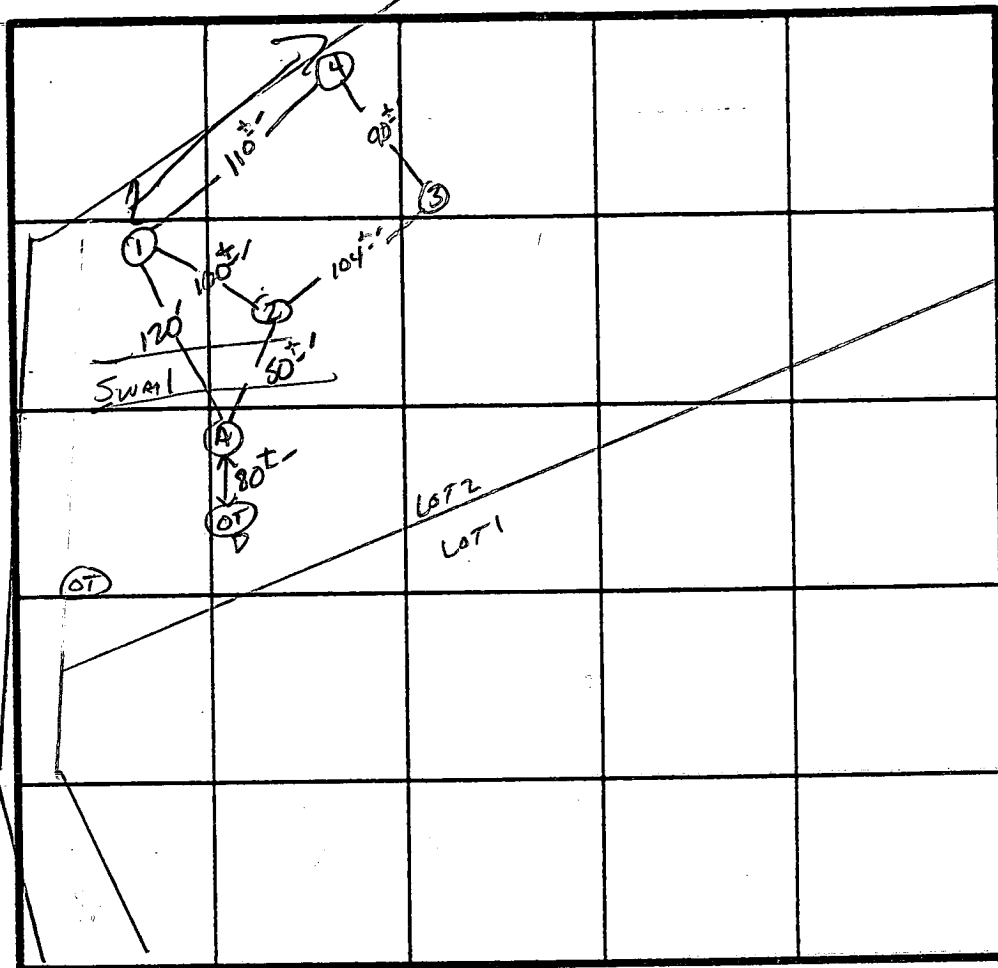

Hand-drawn stratigraphic column with four units. Unit 1 (top): 0-12 ft, (4) AP, Yellow Br. silt loam 12-15%, clay - 20%, frags. large stones. Unit 2: 4-9 ft, Yellow Br. silt loam 10-15%, frags. 15. Unit 3: 9-13 ft, Brown micaceous silt loam 20-30%, frags. Unit 4 (bottom): 13-15 ft, Yellow Br. silt loam 10-15%, frags. 15.

[illegible]


REMARKS Shallow Cyst. Only. Holes Diff. Than PLAT

TYPE OF SOIL Glenoid

TESTED BY S. Abel

ALSO PRESENT

New House	Freedom Sanitation Housing
-----------	----------------------------------

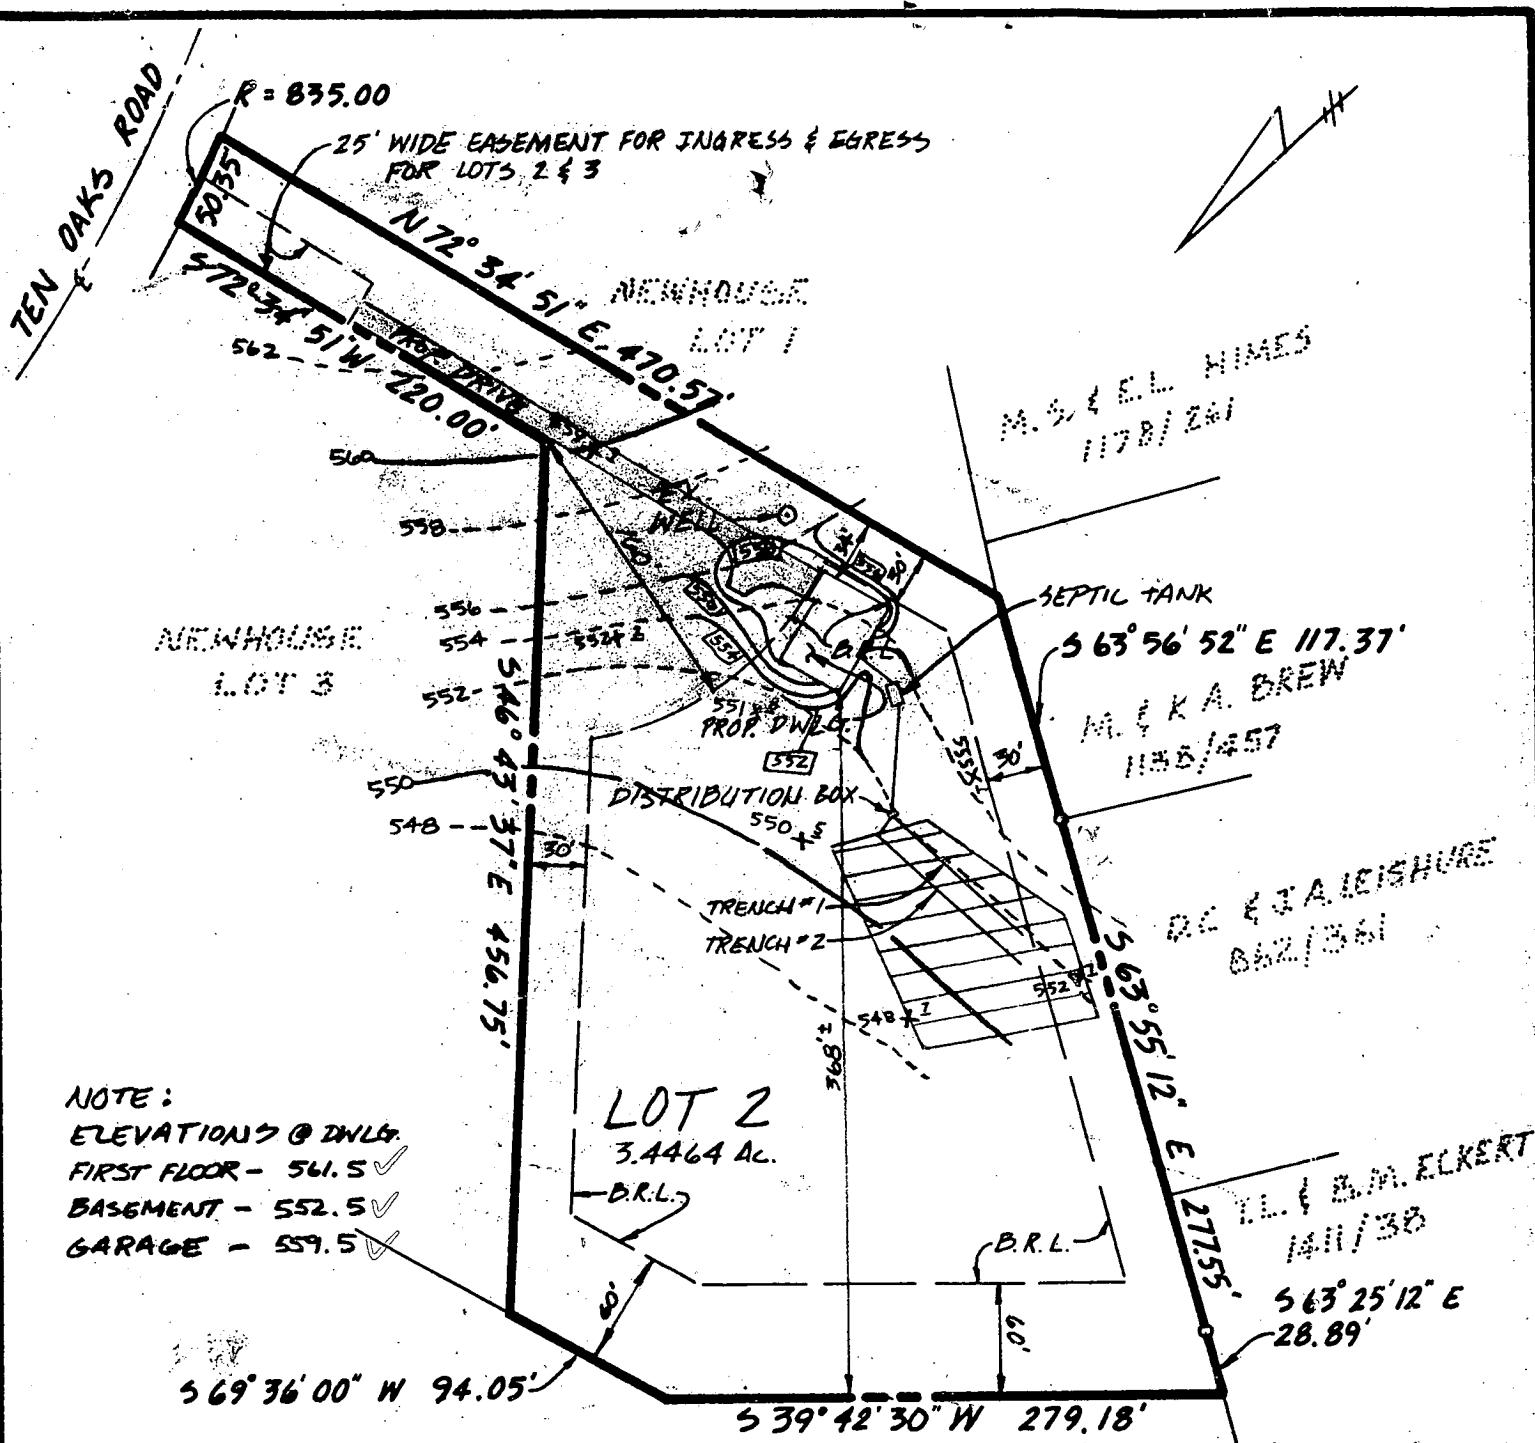

9/29/88
 elevations
 Sabe

S.T. & L.A. CUNNINGHAM
 570/649

BLDG. PERMIT SIGNED
 AND RETURNED 10/10/88 BP21546
 84

SHANABERGER & LANE


8726 TOWN & COUNTRY BLVD.
 SUITE 203
 ELLICOTT CITY, MD 21043
 461-9563

**SITE PLAN
 NEWHOUSE SUBDIVISION
 LOT 2**


TAX MAP 28 PARCEL 65
 5th ELECTION DISTRICT HOWARD COUNTY, MD
 SCALE: 1"=100'
 DATE 8/11/87

B 1 1785 SEQUENCE NO. (OEP USE ONLY) (THIS NUMBER IS TO BE PUNCHED IN COLS. 3-6 ON ALL CARDS)	STATE OF MARYLAND PERMIT TO DRILL WELL please print or type	OEP PERMIT NUMBER HO-81-2140 fill in this form completely
Date Received 050787 OWNER INFORMATION G W Smith Associates 15 Last Name Owner First Name 34 7626 Haines Court 36 Street or RFD 55 Laurel Md 20707 57 Town 70 State 72 Zip 76	B 3 LOCATION OF WELL Howard 8 COUNTY 21 Newhouse 23 SUBDIVISION 42 SECTION 44 46 LOT 2 48 50 Dayton 52 NEAREST TOWN 71 MILES FROM TOWN (enter 0 if in town) 1 73 76 77 78 MI	B 4 DIRECTION OF WELL FROM TOWN (CIRCLE BOX) ON WHICH SIDE OF ROAD (CIRCLE APPROPRIATE BOX) NEAR WHAT ROAD Ten Oaks rd 11 30 DISTANCE FROM ROAD 370 37 ENTER FT or MI FT 38 39
B 2 WELL INFORMATION APPROX. PUMPING RATE (GAL. PER MIN.) 5 8 12 AVERAGE DAILY QUANTITY NEEDED (GAL. PER DAY) 500 14 20 USE FOR WATER (CIRCLE APPROPRIATE BOX) ☒ HOME (SINGLE OR DOUBLE HOUSEHOLD UNIT ONLY) ☐ FARMING (LIVESTOCK WATERING & AGRICULTURAL IRRIGATION) ☐ INDUSTRIAL, COMMERCIAL, STATE AND FEDERAL GOV. OTHER (REQUIRES APPROPRIATION PERMIT) ☐ PUBLIC OR PRIVATE WATER COMPANY (REQUIRES APPROPRIATION PERMIT AND STATE HEALTH DEPARTMENT APPROVAL) ☐ TEST, OBSERVATION, MONITORING (MAY REQUIRE APPROPRIATION PERMIT)	NOT TO BE FILLED IN BY DRILLER HEALTH DEPARTMENT APPROVAL HOWARD A 37760 COUNTY NAME COUNTY NO. OEP SIGNATURE STATE HEALTH INSERT S 41 DATE ISSUED 062487 B Nifan 12/24/87 43 48 CO SIGNATURE EXP. DATE NORTH GRID 507000 55 EAST GRID 0806000 57 63	
APPROXIMATE DEPTH OF WELL 250 24 28 FEET APPROXIMATE DIAMETER OF WELL 6 NEAREST INCH METHOD OF DRILLING (circle one) BORED (or Augered) JETTED Jetted & DRIVEN ☒ AIR-ROTARY AIR-PERCussion ROTARY (Hydraulic Rotary) CABLE REVERSE-ROTARY Drive-POINT other _____	SHOW MAJOR FEATURES OF BOX & LOCATE WELL WITH AN X SOURCES OF DRILLING WATER 1. _____ 2. _____ 3. _____ WRITE THE BOX NUMBER FROM THE MAP HERE 8006 5007 5 6 7 8 9 0 000 000	
REPLACEMENT OR DEEPEMED WELLS (CIRCLE APPROPRIATE BOX) ☒ THIS WELL WILL NOT REPLACE AN EXISTING WELL ☐ THIS WELL WILL REPLACE A WELL THAT WILL BE ABANDONED AND SEALED 39 ☐ THIS WELL WILL REPLACE A WELL THAT WILL BE USED AS A STANDBY ☐ THIS WELL WILL DEEPEN AN EXISTING WELL PERMIT NUMBER OF WELL TO BE REPLACED OR DEEPEMED (IF AVAILABLE) 41 42 43 44 45 46 47 48 49 50 51 52	DRAW A SKETCH BELOW SHOWING LOCATION OF WELL IN RELATION TO NEARBY TOWNS AND ROADS AND GIVE DISTANCE FROM WELL TO NEAREST ROAD JUNCTION	
Not to be filled in by driller (OEP USE ONLY) APPROP. PERMIT NUMBER 54 55 56 57 58 59 60 61 62 63 FORCE A 67 68 69 70 71 72 73 74 75 76 77 78 79 WRITE INITIALS IN BOX PERMIT No. HO-81-2140 SPECIAL CONDITIONS		

SITE MTG. w/CONTRACTOR
POOL LOC OK
7/15/98 (MR)

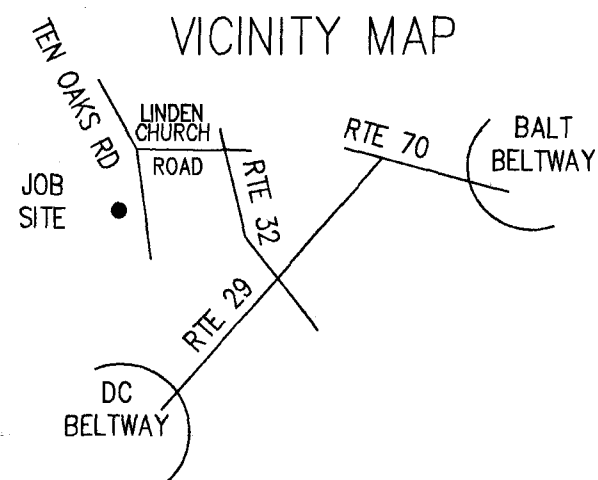

DIRECTIONS:
FROM THE DC BELTWAY TAKE
RTE 29 NORTH TO
(L) RTE 32 TO
(L) LINDEN CHURCH ROAD TO
(L) TEN OAKS ROAD

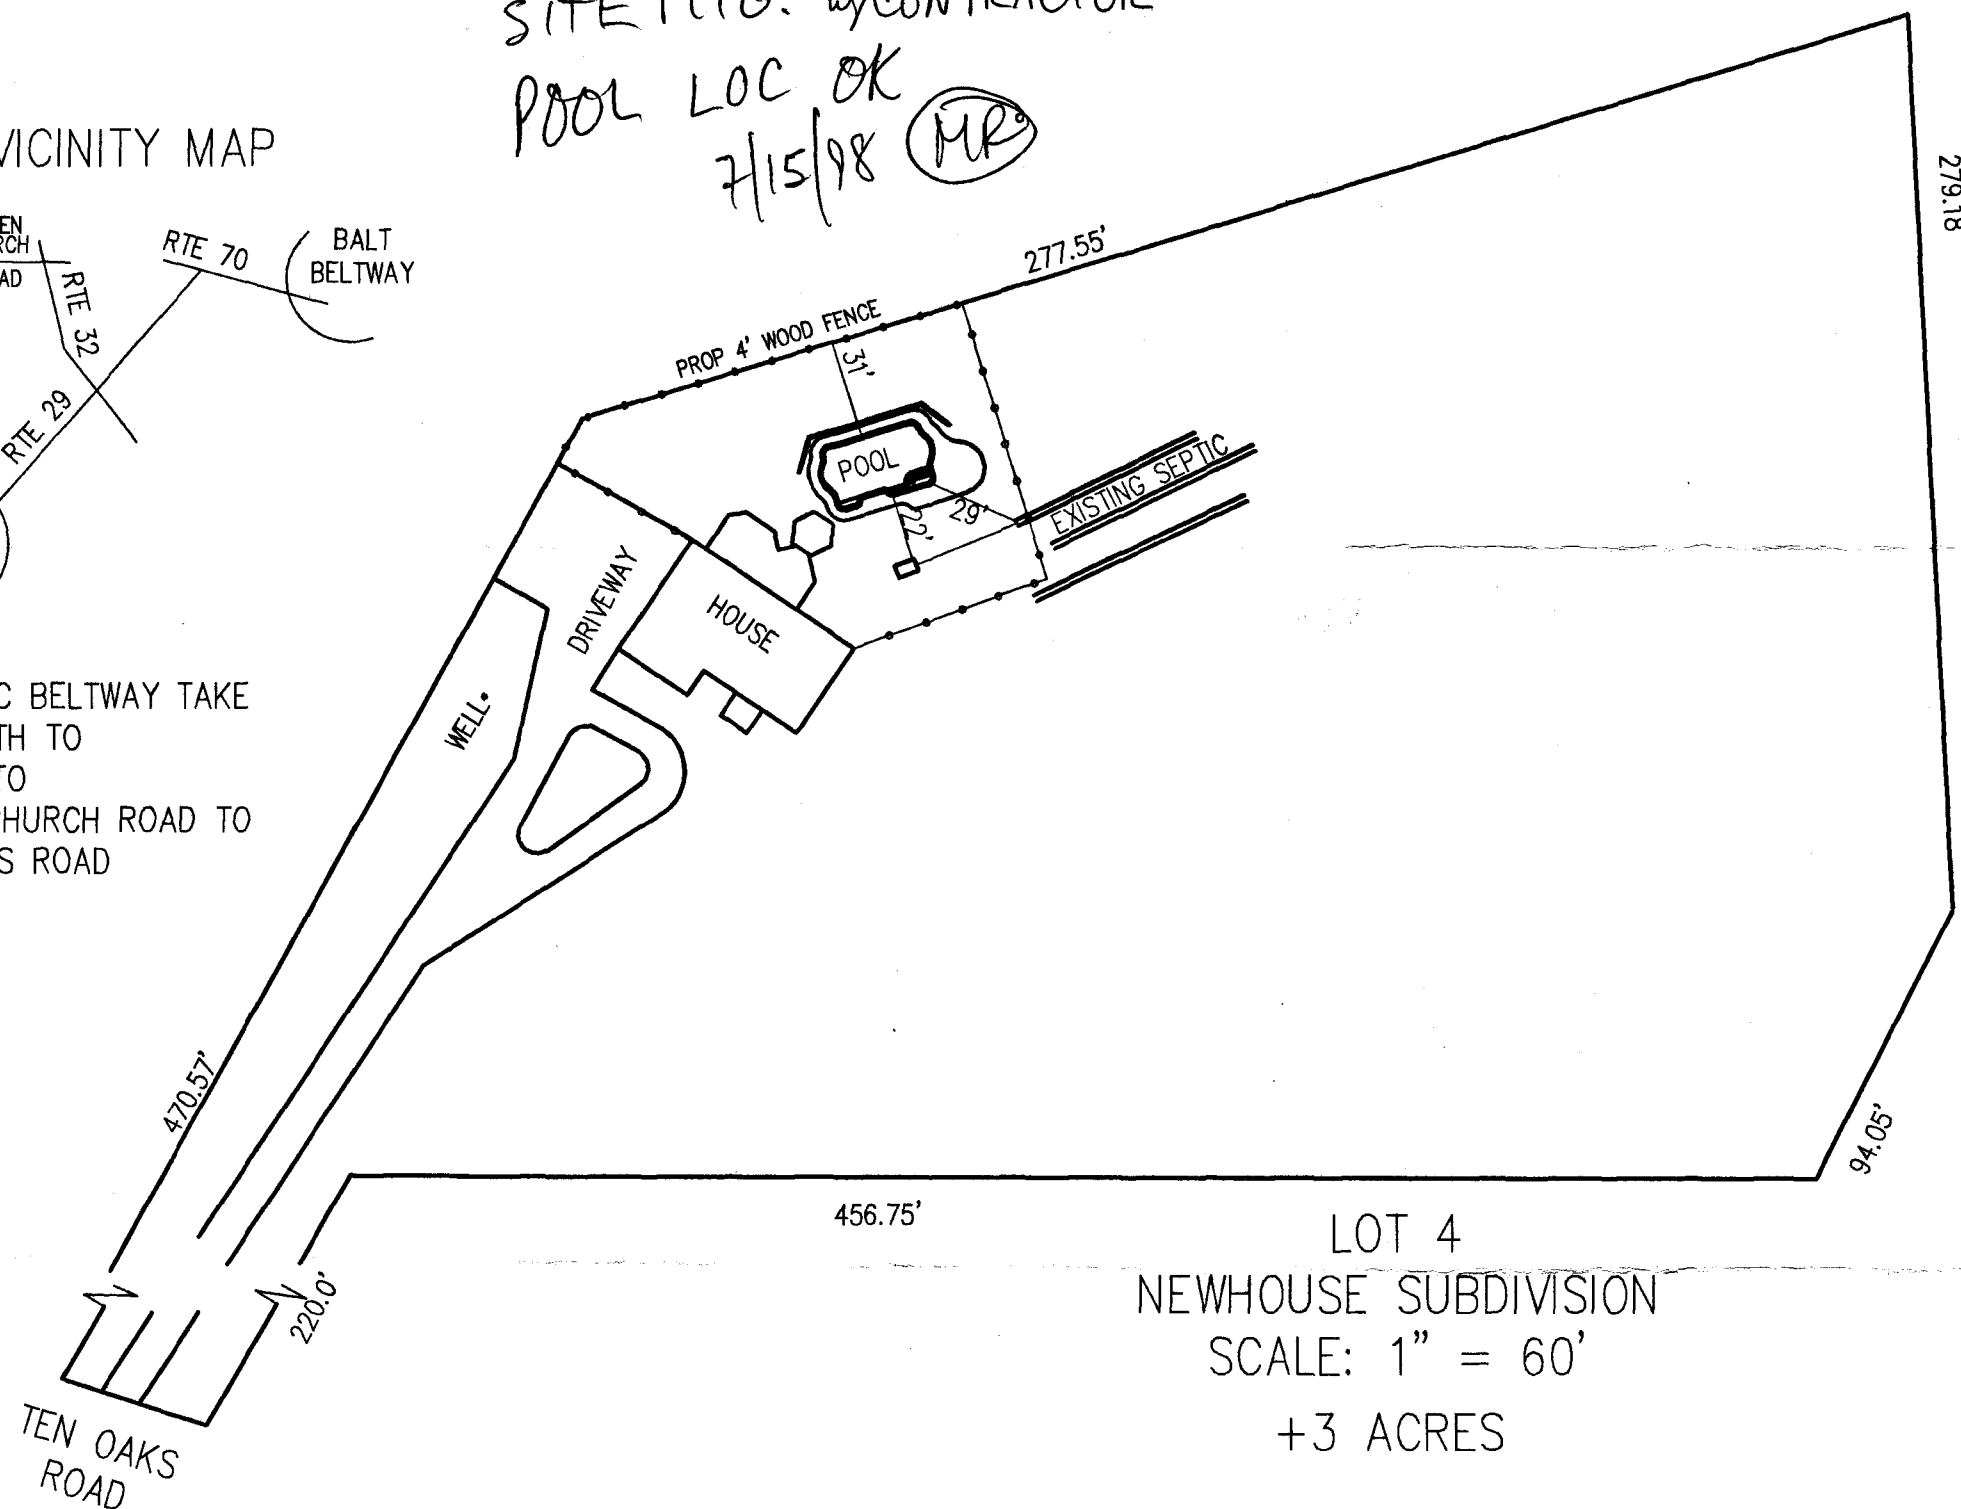

JOB NUMBER _____ CONTRACT DATE **6-30-98**
SALESMAN **PETE MOUSAW**
CONSTRUCTION OFFICE PH # **(703) 257-0007**
(888) 257-0007

MAP NUMBER
13
K-4

COUNTY **HOWARD**
LOT # **4** BLOCK _____
SUB DIV **NEWHOUSE SUBDIVISION**
CROSS ST **LINDEN CHURCH RD**

GENERAL NOTES

- 1) TWO SKIMMERS ON POOL
- 2) BLUE QUARTZ POOL FINISH
- 3) THREE FIBER OPTIC LIGHTS
- 4) 600 SQ FT COLORED CONCRETE DECK
- 5) 125 SQ FT WOOD RETAINING WALL

BLUE HAVEN POOLS
SINCE 1954

Prepared Especially For:

NAME **CARL & MARY LYNCH**
STREET **5270 TEN OAKS ROAD**
CITY **CLARKSVILLE** STATE **MD** ZIP **21029**
HOME PHONE **301 854-3807**
WORK PHONE _____

DRAWN BY **CMB** DATE DRAWN: **7-8-98** SHEET **1 OF 2**