

3/15/88 AM
3/16/88 AM
6-15-90 pm

Tax ID - 05-404649

HOUSE CONNECTION REQ'D
6-15-90 House connection ck JEN

PERMIT

SEWAGE DISPOSAL SYSTEM

MARYLAND STATE DEPARTMENT OF HEALTH

HOWARD COUNTY

BUREAU OF ENVIRONMENTAL HEALTH
461-9933

P 41207

A 37761

DISTRICT 5th

DATE 3/14/88

DATE SYSTEM APPROVED 6-15-90

INSPECTOR JEN

INDEXED

Frall Septic Service

IS PERMITTED TO INSTALL X ALTER

ADDRESS P. O. Box 659, Woodbine, Maryland 21771 PHONE 795-5674

SUBDIVISION Newhouse ROAD 5260 Ten Oaks Road LOT 3

PROPERTY OWNER GREGORY SMITH Scott and Peggy Coulson

ADDRESS

IF GARBAGE GRINDER IS USED INCREASE SEPTIC TANK CAPACITY BY 50% AND ABSORPTION AREA BY 22%.

GARBAGE GRINDER? YES NO X

SEPTIC TANK CAPACITY 1250 GALLONS

NUMBER OF BEDROOMS 4

BLDG. PERMIT SIGNED

AND RETURNED 11/21/94

Serial # 52016

Severndrift

TRENCHES - 190 sq. ft. per bedroom. Trench to be 3 feet wide. Inlet 3 feet below original grade. Bottom maximum depth 5 feet below original grade. Effective area begins at 3 feet below original grade. 2 feet of stone below distribution pipe.

LOCATION - Place the distribution box 130 feet from the front lot line and 75 feet from the left lot line as seen when facing the lot from Ten Oaks Road. Run trenches on contour toward back of lot.

NOTE - No trench to exceed 100 feet in length. Provide 6" - 8" diameter cleanout and cap to grade or above on septic tank. or/cw

INSPECTION REQ'D PRIOR TO SETTING TANK. CW 3/11/88

LOCATION - PUNT TRENCH THROUGH HIGH

PLANS APPROVED BY S. Abel DATE 8/19/87

COVER NO WORK UNTIL INSPECTED AND APPROVED.

PERC HOLE LOCATED 50FT

NEITHER THE HOWARD COUNTY COUNCIL NOR THE HEALTH DEPARTMENT IS RESPONSIBLE FOR THE SUCCESSFUL OPERATION OF ANY SYSTEM.

NOTE: CLEANOUT REQUIRED EVERY 70 FEET OF SEWER LINE AND/OR AT 90° SWEEPS IN LINES FROM HOUSE TO DRAIN FIELDS.

NOTE: ALL PARTS OF SEPTIC SYSTEMS (I.E., TANK, DISTRIBUTION BOX, TRENCHES) TO BE 100 FEET FROM WELL (UNLESS OTHERWISE SPECIFICALLY AUTHORIZED).

NOTE: IF DEEP TRENCHES ARE USED CALL FOR INSPECTION BEFORE AND AFTER PLACING GRAVEL IN TRENCHES.

NOTE: NO DRY WELL SHALL EXCEED 15 FOOT IN DIAMETER. NO ABSORPTION TRENCH TO EXCEED 100 FEET IN LENGTH.

NOTE: ALL PIPE FROM HOUSE TO SEPTIC TANK MUST BE CAST IRON OR SCHEDULE 40 PVC OR ABS.

PERMIT VOID AFTER TWO YEARS.

NOTE: INSTALL STAND PIPE ON SEPTIC TANK AND DRY WELL. STAND PIPES MUST BE 6 INCHES IN DIAMETER. CAST IRON, CONCRETE OR TERRA COTTA OR PVC OR ABS ACCEPTED. IF TOP OF SEPTIC TANK IS DEEPER THAN 9 FEET TO GRADE REQUIRED.

NOTE: DISTRIBUTION BOXES MUST HAVE BAFFLES.


BLDG. PERMIT SIGNED
AND RETURNED 7/19/01

B00131594 - REC ROOM + POWDER ROOM

*INSTALLER IS RESPONSIBLE FOR OBTAINING FINAL APPROVAL ON THIS PERMIT

*CALL 461-9933 FOR INSPECTION OF SEPTIC SYSTEMS.

EH - 2-1186

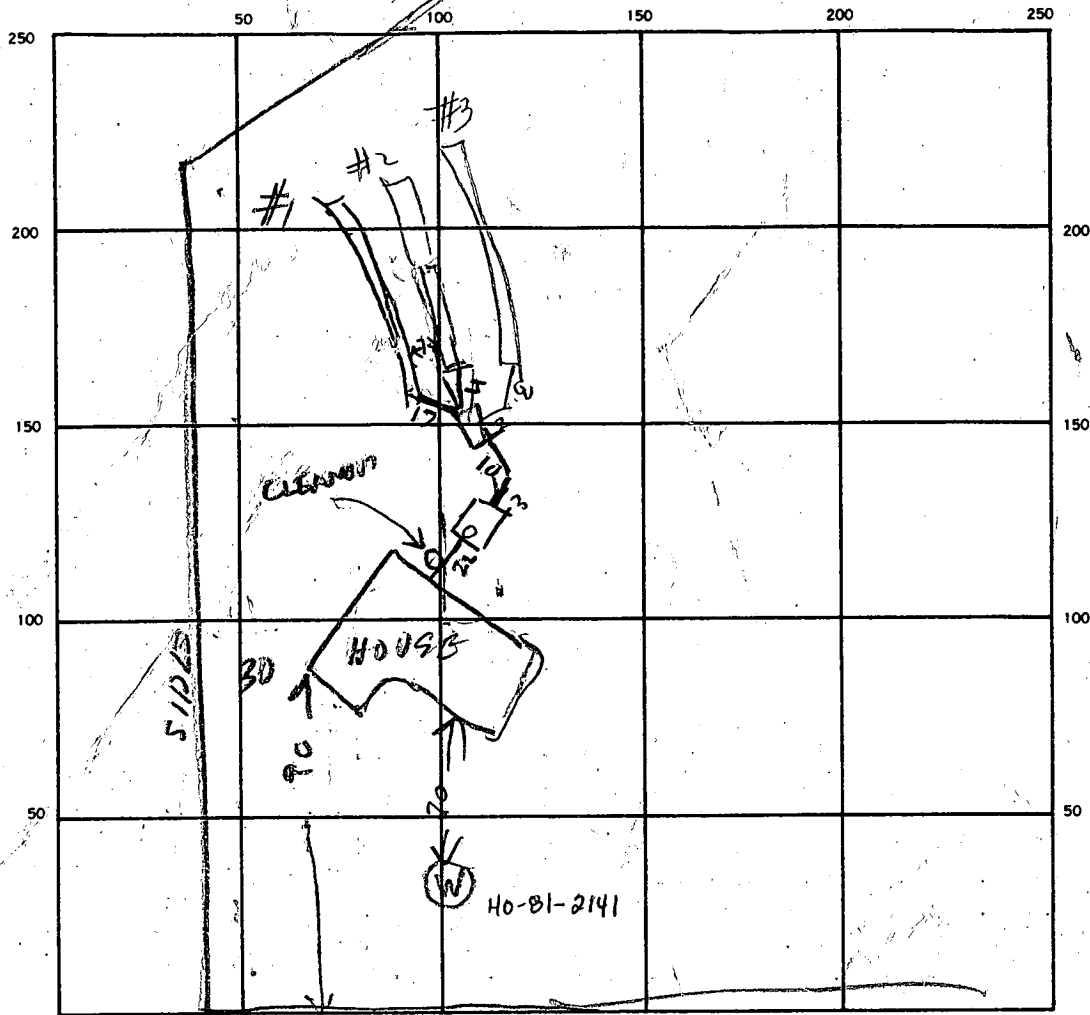

INDICATE NORTH - NAME ADJOINING ROADWAY AS BASE LINE.

TEN OAKS RD

SEPTIC TANK. LEVEL 250

CLEANOUTS 51 / 01 / 1 in line

DISTRIBUTION BOX. LEVEL _____

DRAIN FIELD/TILE FIELD. DEPTH 1 1/2 / 3 / 5 FT. TRENCH WIDTH 3 / 3 / 3 FT. INLET DEPTH 3 / 3 / 3 FT.

EFFECTIVE GRAVEL DEPTH 1 1/2 / 2 / 2 FT. TOTAL LENGTH 84 / 88 / 86 FT. 59

NUMBER OF TRENCHES 3 ONE SIDEWALL/BOTTOM AREA 77 / 44 SQ. FT. 60

DRYWELL INSIDE DIAMETER _____ FT. EFFECTIVE DEPTH BELOW INLET _____ FT.

ABSORBENT AREA _____ SQ. FT.

REMARKS 3/15/88 CHECKED PERC/TILES & CHANGED LOCATION ALTHOUGH

3/15/88 - COVER TRENCH #1 & TANK FINISH TRENCH #2 & #3 & CALL

3/16/88 - TRENCHES #1, #2, #3 COMPLETE CONNECT

HOUSE TO TANK & CALL RH

6-15-90 House connection OK, JEN

DATE SYSTEM APPROVED

6-15-90

INSPECTOR

Jane E. Nadeau

B.T. & L.A. CUNNINGHAM
574/649

LINDEN CHAPEL WOODS
LOT 1
P.B. 12, P. 29

N 05° 07' 21" E 35.35'

S 69° 36' 00" W 628.00'

LOT 3
3.3256 Ac. ±

LOT 2
NEWHOUSE SUB.

TEN OAKS ROAD

PROPOSED
DWELLING

FF. 569.00 ✓
B.E. 560.00 ✓
GAR. 567.00 ✓

25' EASEMENT FOR
INGRESS & EGRESS
FOR LOTS 2 & 3.

SEPTIC SYSTEM DATA

INV. @ HOUSE 557.5 + BSMT.

ITEM TYPE	EX. GRADE	FIN. GRADE	INV. IN	INV. OUT
SEPTIC TANK	560.5 ✓	560.5 ✓	557.2 ✓	556.9 ✓
DIST. BOX	559.5 ✓	559.5 ✓	556.8 ✓	556.6 ✓
TRENCH #1	559.5 ✓	559.5 ✓	556.5 ✓	555.5 ✓
TRENCH #2	559.0 ✓	559.0 ✓	556.0 ✓	555.0 ✓

LOT 1
NEWHOUSE
SUB.

BLDG. PERMIT SIGNED
AND RETURNED 8/19/87

BP 14099

S. Al

SITE PLAN

NEWHOUSE SUBDIVISION

LOT 3

SHANABERGER & LANE

8726 TOWN & COUNTRY BLVD.

SUITE 203

ELLICOTT CITY, MD 21043

461-9563

TAX MAP 28 PARCEL 65

5TH ELECTION DISTRICT

HOWARD COUNTY, MD

SCALE: 1"=100' DATE: 8/11/87

APPLICATION

PERCOLATION TESTING

HOWARD COUNTY HEALTH DEPARTMENT
BUREAU OF ENVIRONMENTAL HEALTH
P.O. BOX 476 ELLICOTT CITY, MARYLAND 21043
TELEPHONE: 461-9933

A 37761

P _____

DISTRICT 5

DATE 7-21-86

TO: THE COUNTY HEALTH OFFICER
ELLICOTT CITY, MARYLAND

I, HEREBY, APPLY FOR THE NECESSARY TEST IN ORDER TO CONSTRUCT (OR RECONSTRUCT) A SEWAGE DISPOSAL SYSTEM.

Gregory Smith

PROPERTY OWNER Howard A. Newhouse & Eva Marie Newhouse

ADDRESS 5280 Ten Oaks Rd. PHONE 531-2106

PROSPECTIVE BUYER _____

ADDRESS _____ PHONE _____

PROPERTY LOCATION:

SUBDIVISION NEWHOUSE PROPERTY 5260 TEN OAKS Rd. LOT NO. 8 & LOT #3

ROAD AND DESCRIPTION WESTSIDE TEN OAKS RD, SOUTH OF LINDEN CHURCH RD

TAX MAP 34 PARCEL # 69?

SIZE OF LOT 3.75 AC TYPE BLDG. Single Family

BLDG. PERMIT SIGNED

AND RETURNED 8/19/87

BP # 57016

(SINGLE FAMILY DWELLING OR COMMERCIAL)

THE SYSTEM INSTALLED UNDER THIS APPLICATION IS ACCEPTABLE ONLY UNTIL PUBLIC FACILITIES BECOME AVAILABLE. I FULLY UNDERSTAND THE
FEE CONNECTED WITH THE FILING OF THIS PERC TEST APPLICATION IS NON-REFUNDABLE UNDER ANY CIRCUMSTANCES. I ALSO AGREE TO COMPLY
WITH ALL M.O.S.H.A. REQUIREMENTS IN TESTING THIS LOT.

(SIGNATURE OF APPLICANT)

APPROVED BY Sid Abel FOR Shallow trenches DATE 8-19-87

REJECTED BY _____ FOR _____ DATE _____

HOLD PENDING FURTHER TESTS _____ DATE _____

REASONS FOR REJECTION OR HOLDING 9/8/86 VISUAL HOLES WET HOLD

FOR WET SEASON RIT

BLDG. PERMIT SIGNED

AND RETURNED 8/19/87

BP # 14099

THIS IS NOT A PERMIT

HOLE ELEVATION






Ⓔ = HIGHEST

Ⓐ = LOWEST

Ⓑ Ⓓ = MEDIUM

Holes dug per surveyor Plat

70

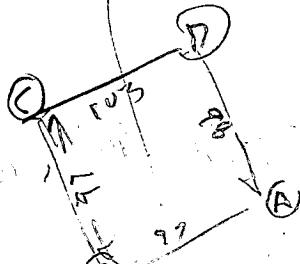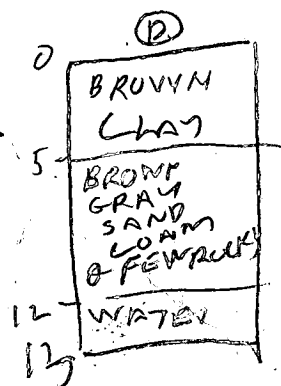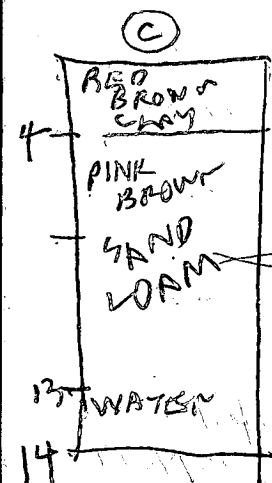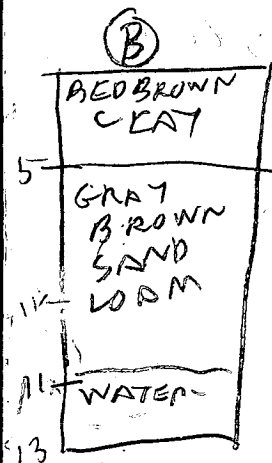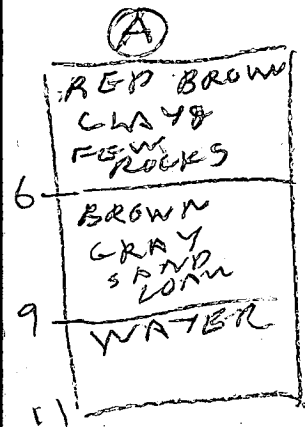

TEN OAKS RD

APPLICATION

PERCOLATION TESTING

HOWARD COUNTY HEALTH DEPARTMENT
BUREAU OF ENVIRONMENTAL HEALTH

P.O. BOX 476 ELLICOTT CITY, MARYLAND 21043
TELEPHONE: 461-9933

A _____

P _____

DISTRICT _____

DATE _____

TO: THE COUNTY HEALTH OFFICER
ELLICOTT CITY, MARYLAND

I, HEREBY, APPLY FOR THE NECESSARY TEST IN ORDER TO CONSTRUCT (OR RECONSTRUCT) A SEWAGE DISPOSAL SYSTEM.

PROPERTY OWNER _____

ADDRESS _____ PHONE _____

PROSPECTIVE BUYER _____

ADDRESS _____ PHONE _____

PROPERTY LOCATION:

SUBDIVISION NEW HOUSE PROPERTY LOT NO. 1

ROAD AND DESCRIPTION TEN OAKS RD.

TAX MAP _____ PARCEL # _____

SIZE OF LOT _____ TYPE BLDG. _____
(SINGLE FAMILY DWELLING OR COMMERCIAL)

THE SYSTEM INSTALLED UNDER THIS APPLICATION IS ACCEPTABLE ONLY UNTIL PUBLIC FACILITIES BECOME AVAILABLE. I FULLY UNDERSTAND THE FEE CONNECTED WITH THE FILING OF THIS PERC TEST APPLICATION IS NON-REFUNDABLE UNDER ANY CIRCUMSTANCES. I ALSO AGREE TO COMPLY WITH ALL M.O.S.H.A. REQUIREMENTS IN TESTING THIS LOT.

(SIGNATURE OF APPLICANT)

APPROVED BY _____ FOR _____ DATE _____


REJECTED BY _____ FOR _____ DATE _____

HOLD PENDING FURTHER TESTS _____ DATE _____

REASONS FOR REJECTION OR HOLDING _____

THIS IS NOT A PERMIT




A37760

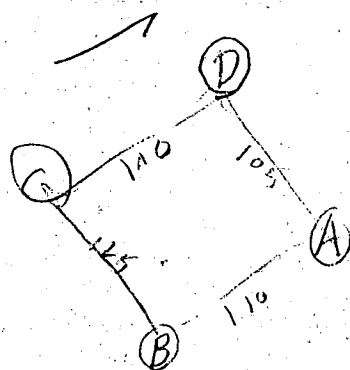

HOLE
ELEVATIONS

(B)(C) = HIGH

(D)(A) = LOW

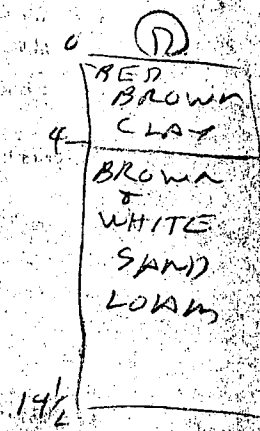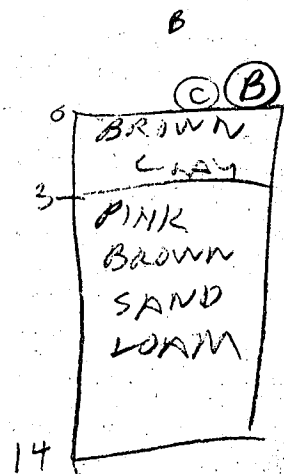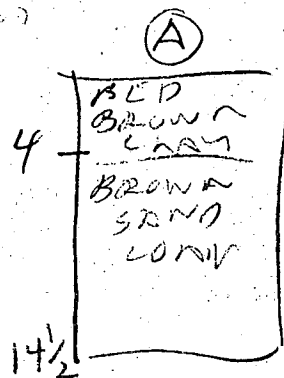

TEN OAKS RD

1/8/36	As	5 1/2	1107	1109	1109	1104	2
1/9/36	AV	14 1/2	LOOKS 51				
2/8/36	DS	6	1144	1149	1149	1153	4
	DV	14 1/2	LOOKS 51				
	BS	5	1159	1205	1203	1207	4
	BD	7 1/2	1201	1210	1210	1226	16
	BV	14 1/2	LOOKS 51				
	CS	4 1/2	1237	1241	1241	1249	8
	CV	14	LOOKS 51				

HOLE 5 A+B

US60 FOR

RECONFIGURED

LOT 3

566 A37761

Also shown

C15941SEQUENCE NO. (OEP USE ONLY)

STATE OF MARYLANDWELL COMPLETION REPORT

THIS REPORT MUST BE SUBMITTED WITHIN 45 DAYS AFTER WELL IS COMPLETED.

COUNTY NUMBERA-37759

DATE ReceivedDATE WELL COMPLETED063087Depth of Well150

OWNERST. MITH ASSOC. G.W. STREET OR RFD100 OAKS ROAD TOWNDAYTON SUBDIVISIONNEWHOUSE SECTION LOT3

WELL LOG

STATE THE KIND OF FORMATIONS PENETRATED, THEIR COLOR, DEPTH, THICKNESS AND IF WATER BEARING

DESCRIPTION (Use additional sheets if needed)FEETFROMTO

Light Brown soil03

Rust color soil335

Brown soil3550

STELL5065

gray65120

White & brown rock120125

gray rock125150

GRROUTING RECORD

WELL HAS BEEN GROUTED

TYPE OF GROUTING MATERIAL

CEMENTCMBENTONITE CLAYBC

NO. OF BAGS32NO. OF POUNDS3008

GALLONS OF WATER192

DEPTH OF GROUT SEAL (to nearest foot)

CASING RECORD

OTHER CASING (if used)

SCREEN RECORD

DEPTH (nearest ft.)

GRAVEL PACK

IF WELL DRILLED WAS FLOWING WELL INSERT F IN BOX 68

OEP USE ONLY

TELESCOPE CASING

LOG INDICATOR

OTHER DATA

PUMPING TEST

HOURS PUMPED (nearest hour)03

PUMPING RATE (gal. per min. to nearest gal.)4

METHOD USED TO MEASURE PUMPING RATE1 gal.

WATER LEVEL (distance from land surface)

BEFORE PUMPING

WHEN PUMPING

TYPE OF PUMP USED (for test)

PUMP INSTALLED

DRILLER WILL INSTALL PUMP

IF DRILLER INSTALLS PUMP, THIS SECTION MUST BE COMPLETED FOR ALL WELLS EXCEPT HOME USE

TYPE OF PUMP INSTALLED

PLACE (A,C,J,P,R,S,T,O)

CAPACITY: GALLONS PER MINUTE

PUMP HORSE POWER

PUMP COLUMN LENGTH

CASING HEIGHT

LOCATION OF WELL ON LOT

SHOW PERMANENT STRUCTURE SUCH AS BUILDING, SEPTIC TANKS, AND/OR LANDMARKS AND INDICATE NOT LESS THAN TWO DISTANCES (MEASUREMENTS TO WELL)

1

2

3

1

2

3

84