

04-347137

PERMIT

SEWAGE DISPOSAL SYSTEM

MARYLAND STATE DEPARTMENT OF HEALTH

HOWARD COUNTY
BUREAU OF ENVIRONMENTAL HEALTH
461-9933

INDEXED

P 43883

A 37905

DISTRICT 4th

DATE

3/28/89

DATE SYSTEM APPROVED

5/9/89

INSPECTOR

C. Wilkins

Alan Whitworth

IS PERMITTED TO INSTALL ☒ ALTER

ADDRESS 12680 Clarksville Pike, Clarksville, Maryland

PHONE 531-5033

854-2513

SUBDIVISION Gaither Sideling

ROAD 613 Sideling Court

LOT 4

PROPERTY OWNER

Major Construction

ADDRESS

JON S HEMATEK

IF GARBAGE GRINDER IS USED INCREASE SEPTIC TANK CAPACITY BY 50% AND ABSORPTION AREA BY 22%.

GARBAGE GRINDER? YES

NO ☒

SEPTIC TANK CAPACITY 1250

GALLONS

NUMBER OF BEDROOMS 4

3189
3(720
240

TRENCHES - 180 sq. ft. per bedroom. Trench to be 3 feet wide. Inlet 3.5 feet below original grade. Bottom maximum depth 5.0 feet below original grade. Effective area begins at 3.5 feet below original grade. 1.5 feet of stone below distribution pipe.

LOCATION - Place the first trench 280 feet down the left (585.38') lot line and 100 feet off the same lot line as seen when facing the lot from Right-of-way to property. Run trenches on contour toward the left lot line. MAINTAIN 100 FEET FROM WELL WITH TRENCHES.

NOTE - No trench to exceed 100 feet in length. Provide 6" - 8" diameter cleanout and cap to grade or above on septic tank.

PLANS APPROVED BY

Sid Abel

DATE

12/20/88

COVER NO WORK UNTIL INSPECTED AND APPROVED

NEITHER THE HOWARD COUNTY COUNCIL NOR THE HEALTH DEPARTMENT IS RESPONSIBLE FOR THE SUCCESSFUL OPERATION OF ANY SYSTEM.

NOTE: CLEANOUT REQUIRED EVERY 70 FEET OF SEWER LINE AND/OR AT 90° SWEEPS IN LINES FROM HOUSE TO DRAIN FIELDS

NOTE: ALL PARTS OF SEPTIC SYSTEMS (I.E. TANK, DISTRIBUTION BOX, TRENCHES) TO BE 100 FEET FROM WELL (UNLESS OTHERWISE SPECIFICALLY AUTHORIZED)

NOTE: IF DEEP TRENCH(ES) ARE USED CALL FOR INSPECTION BEFORE AND AFTER PLACING GRAVEL IN TRENCH(ES)

NOTE: NO DRY WELL SHALL EXCEED 15 FOOT IN DIAMETER NO ABSORPTION TRENCH TO EXCEED 100 FEET IN LENGTH.

NOTE: ALL PIPE FROM HOUSE TO SEPTIC TANK MUST BE CAST IRON OR SCHEDULE 40 PVC OR ABS

PERMIT VOID AFTER TWO YEARS

NOTE: INSTALL STAND PIPE ON SEPTIC TANK AND DRY WELL. STAND PIPES MUST BE 6 INCHES IN DIAMETER. CAST IRON, CONCRETE OR TERRA COTTA OR PVC OR ABS ACCEPTED. IF TOP OF SEPTIC TANK IS DEEPER THAN 3 FEET, MANHOLE TO GRADE REQUIRED

NOTE: DISTRIBUTION BOXES MUST HAVE BAFFLES

BLDG. PERMIT SIGNED

AND RETURNED

4/22/94


Sue # 33680

Pool

A 37905

*INSTALLER IS RESPONSIBLE FOR OBTAINING FINAL APPROVAL ON THIS PERMIT

*CALL 461-9933 FOR INSPECTION OF SEPTIC SYSTEMS.

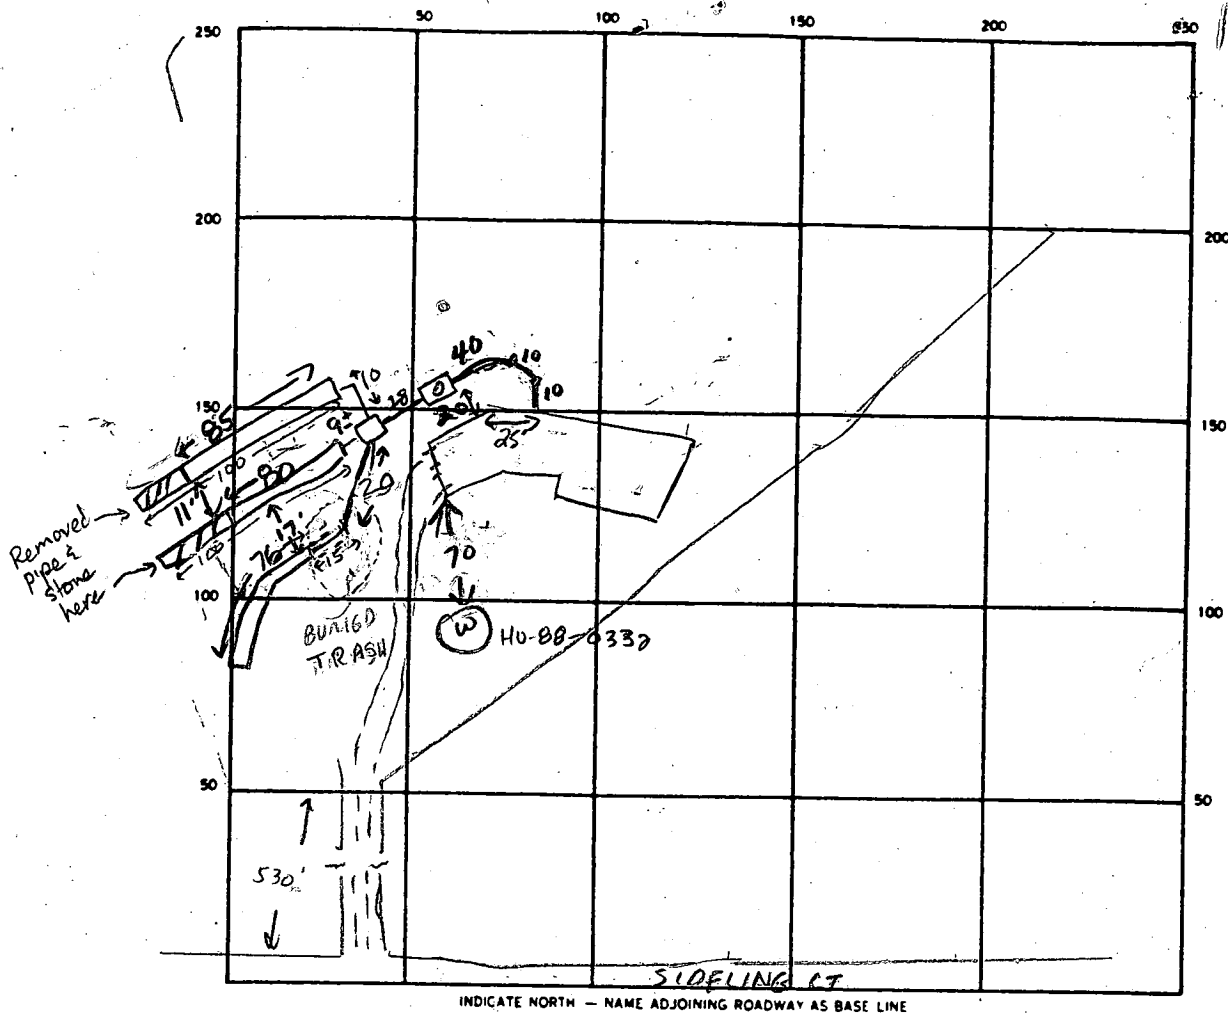

SEPTIC TANK LEVEL ✓ 1500 GA CLEANOUTS MANHOLE AT FINAL GRADE

DISTRIBUTION BOX LEVEL ✓ w/ baffle

Contractor stated ① ② ③

DRAIN FIELD/TILE FIELD DEPTH 5.5 5.5 5.5 FT. TRENCH WIDTH 3 FT. INLET DEPTH ① ② ③ 3 3 4 FT.

EFFECTIVE GRAVEL DEPTH 2.5 2.5 1.5 FT. TOTAL LENGTH 25 80 76 FT.

NUMBER OF TRENCHES _____ ONE SIDEWALL/BOTTOM AREA 255 240 228 SQ. FT.

DRYWELL INSIDE DIAMETER _____ FT. EFFECTIVE DEPTH BELOW INLET _____ FT.

ABSORBENT AREA 723 SQ. FT.

REMARKS 4/25/89 SUBSTANTIAL FILL DIRT ADDED TO LEFT/REAR OF HOUSE COMPLICATES INSTALLATION.

TEST HOLE DUG 75' FROM RIGHT REAR HOUSE CORNER FAILED - ROCK AT 4', MUST USE ORIGINAL LOCATION. C.W.

4-27-89 OK TO INSTALL 2-100' TRENCHES AND 1-40' AT TOP OF FIELD DUE TO

AMOUNT OF FILL. CONT. WORK. SCHED

4/28/89 LONG 2 TRENCHES DIRT TOWARD SWALE, UPPER TWO TRENCHES HAVE BURIED DEBR.

ALL TRENCHES GRAVELLED, UNABLE TO DETERMINE DEPTH. C.W. 5-8-89 OK TO COVER 2 LOWER

trenches. Remove trash from highest trench (x 5' deep) JEN

DATE SYSTEM APPROVED 5/9/89 INSPECTOR C. Willman

5/9/89 TRASH REMOVED FROM TRENCH ALSO, TO BE HAULLED OFF SITE; FINAL GRADE ESTABLISHED AT TANK. OK TO COVER C.W.

A 37905SUBDIVISION: GATHER Sideling
Sec. 4LOT NUMBER: 4DRY WELL OR DRY WELL AND TRENCH

	<u>Septic Tank</u>	<u>Minimum Total Square Feet</u>
3 bedroom	1000 gallon	
4 bedroom	1250 gallon	
5 bedroom	1500 gallon	

Inlet _____ sq. ft./bedroom
_____ feet below original grade.

Bottom maximum depth _____ feet below original grade.

Effective area begins at _____ feet below original grade.

NOTE: If trench is used to make up absorbent area, run the trench on level ground and leave a 5-foot earth buffer between dry well and trench. No trench is to exceed 100 feet in length. Trench inlet to be same as dry well, with _____ feet of stone below distribution pipe.

TRENCHES

Trench to be 3' wide. 180 sq. ft./bedroom
4-No

Inlet 3.5' feet below original grade.

Bottom maximum depth 5.0 feet below original grade.

Effective area begins at 3.5 feet below original grade.

1.5 feet of stone below distribution pipe.

- NOTE:
- (1) No trench to exceed 100 feet in length.
 - (2) If more than one trench used, a distribution box is required.
 - (3) Trenches to be installed on level ground.
 - (4) Call for inspection of trench before gravel is installed.
 - (5) Provide 6" - 8" diameter cleanout and cap to grade or above on septic tank and drywell.
 - (6) If a garbage disposal is used, increase septic tank capacity by 50% and increase absorbent sidewall area by 22%.

LOCATION: PLACE THE FIRST TRENCH 220 FT DOWN THE LEFT (S85.38')
LOT LINE AND 100 FT OFF THE SAME LOT LINE AS SEEN WHEN FACING
THE LOT FROM R.O.W. TO PROPERTY. RUN TRENCHES ON CONTOUR
TOWARD THE LEFT LOT LINE. MAINTAIN 100 FT FROM WELL WITH
TRENCHES. 12/20/88 SAGel

APPLICATION

PERCOLATION TESTING

A 37905

P _____

HOWARD COUNTY HEALTH DEPARTMENT
BUREAU OF ENVIRONMENTAL HEALTH
P.O. BOX 476 ELLICOTT CITY, MARYLAND 21043
TELEPHONE: 461-9933

4/26/86
perc OK w/ approved
plan
@

DISTRICT 4

DATE 7/2/86 10/17/86

TO: THE COUNTY HEALTH OFFICER
ELLICOTT CITY, MARYLAND

I, HEREBY, APPLY FOR THE NECESSARY TEST IN ORDER TO CONSTRUCT (OR RECONSTRUCT) A SEWAGE DISPOSAL SYSTEM.

PROPERTY OWNER Arthur Dadian Major Const.

ADDRESS 1846 16th St NW Wash. D.C. 20009 PHONE 202-332-5364
465-0337

PROSPECTIVE BUYER Gaither Road Joint Venture

ADDRESS 9 Carissa Ct. Owings Mills, MD 21117 PHONE 301-356-9351

PROPERTY LOCATION:

SUBDIVISION Gaither Siding LOT NO. 8 4

ROAD AND DESCRIPTION Gaither Road at Potapscow River
613 Siding St.

TAX MAP 4 PARCEL # 31

SIZE OF LOT 3 ac TYPE BLDG. SFD
(SINGLE FAMILY DWELLING OR COMMERCIAL)

THE SYSTEM INSTALLED UNDER THIS APPLICATION IS ACCEPTABLE ONLY UNTIL PUBLIC FACILITIES BECOME AVAILABLE. I FULLY UNDERSTAND THE
FEE CONNECTED WITH THE FILING OF THIS PERC TEST APPLICATION IS NON-REFUNDABLE UNDER ANY CIRCUMSTANCES. I ALSO AGREE TO COMPLY
WITH ALL M.O.S.H.A. REQUIREMENTS IN TESTING THIS LOT.

(SIGNATURE OF APPLICANT)

APPROVED BY B. Wilson FOR shallow system DATE 7/1/87

REJECTED BY _____ FOR _____ DATE _____

HOLD PENDING FURTHER TESTS _____

REASONS FOR REJECTION OR HOLDING (Circled P)

PERMIT SIGNED

AND RETURNED 1-389

THIS IS NOT A PERMIT

SHALLOW SYSTEM
 INLET 3 1/2'
 MAX D. 5 1/2'
 X = 5 1/2'
 (1)

SOIL PROFILE

0
 orange/brown
 gritty sandy
 silty
 gravelly
 loam
 5 1/2'
 orange/brown
 silty loam
 w/ small
 hard
 weathered
 frags (5%)
 11 1/2'D

(2) CROCKY

orange/red
 silty clay
 chunky loam
 2 1/2'


max tan/
 orange
 gravelly (20%)
 med frags
 3-8"
 10%

11' b

(4)

orange/tan
 gritty/silty
 loam
 2'
 mixed & changes
 into tan
 powdery
 silty
 loam
 6'

EH-12

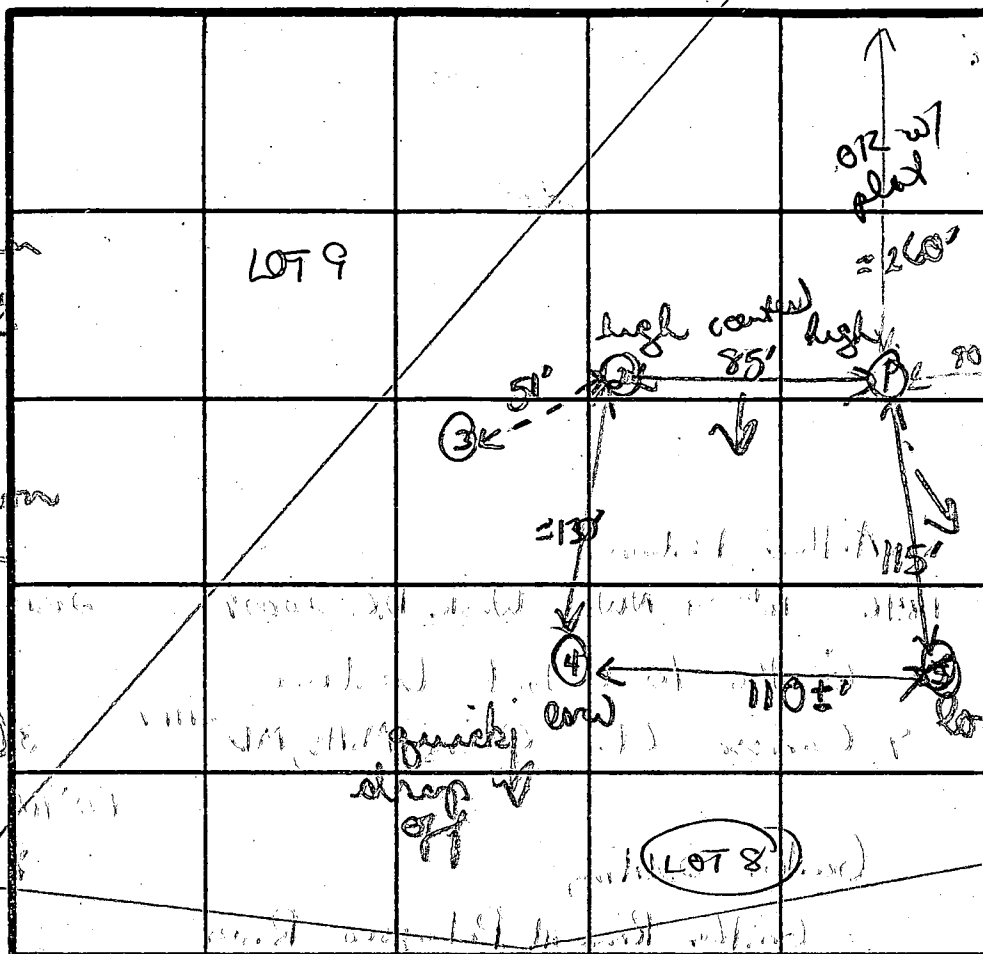

INDICATE NORTH - NAME ADJOINING ROADWAY AS BASE LINE.

DATE	TEST NO.	DEPTH	PRE-WET		TEST - 1" DROP		TIME
			START	STOP	START	STOP	
4/26/86	(1)	4'	340	342	342	347	5 min
		8' m	335	337	337	341	4 min
		11 1/2'D	bottom (see profile)				
	(2)	4' 5"	348	349	349	351	2 min
		11'D	bottom (see profile)				
	(3)	VOID NOT TEST	6-7' (heavy clay)				
	(4)	4' 3"	402	403	403	405	2 min
		8' m	405	407	407	412	3 min
		11 1/2'D	bottom (see profile)				
	(5)	4' 3"	418	431	431	437	16 min
		4' 1/2"	431	437	437	443	
		12'D	bottom (see profile)				

REMARKS

TYPE OF SOIL

TESTED BY

ALSO PRESENT

corner stakes far off, but ~ as shown per plat
 rock content more pronounced (in top holes)
 gritty gravelly loam - 5', silty near soils

(5)
 brown
 orange
 clay/silty
 loam
 4 1/2'
 max to
 tan
 orange
 silty
 loam
 12'D

B 1 <div style="border: 1px solid black; padding: 2px; display: inline-block;">9893</div>	SEQUENCE NO. (DP USE ONLY)	STATE OF MARYLAND PERMIT TO DRILL WELL please print or type	STATE PERMIT NUMBER <div style="border: 1px solid black; padding: 2px; display: inline-block;">70-88-0332</div>
Date Received (APA) <div style="border: 1px solid black; padding: 2px; display: inline-block;">11-15-88</div>		B 3 LOCATION OF WELL HOWARD COUNTY SALTHER SIDE LANE SUBDIVISION SECTION 7 LOT 7 SIKESVILLE NEAREST TOWN MILES FROM TOWN (enter 0 if in town) 3 MI	
OWNER INFORMATION MAITRIK L D V S T F DEVEL 7615 WASHINGTON BLVD BALTIMORE MD Town State Zip		B 4 DIRECTION OF WELL FROM TOWN (CIRCLE BOX) 	
DRILLER INFORMATION George F. Easterday Driller's Name L. Franklin Easterday, Inc. Firm Name 9255 Brown Church Rd., Ma. Ainy, Md. 21771 Address Signature: George F. Easterday Date: 11-14-88		NEAR WHAT ROAD SIDE LANE CT ON WHICH SIDE OF ROAD (CIRCLE APPROPRIATE BOX) NORTH WEST EAST SOUTH DISTANCE FROM ROAD 200 FT ENTER FT or MI	
B 2 WELL INFORMATION APPROX. PUMPING RATE (GAL. PER MIN.) 5 AVERAGE DAILY QUANTITY NEEDED (GAL. PER DAY) 500		NOT TO BE FILLED IN BY DRILLER HEALTH DEPARTMENT APPROVAL HOWARD COUNTY NAME STATE SIGNATURE DATE ISSUED 12-01-88 CO SIGNATURE Charles B. [Signature] NORTH GRID 554000 EAST GRID 0802000 EXP. DATE 01/01/89	
USE FOR WATER (CIRCLE APPROPRIATE BOX) <input checked="" type="checkbox"/> HOME (SINGLE OR DOUBLE HOUSEHOLD UNIT ONLY) <input type="checkbox"/> FARMING (LIVESTOCK WATERING & AGRICULTURAL IRRIGATION) <input type="checkbox"/> INDUSTRIAL, COMMERCIAL, STATE AND FEDERAL GOV. OTHER (REQUIRES APPROPRIATION PERMIT) <input type="checkbox"/> PUBLIC OR PRIVATE WATER COMPANY (REQUIRES APPROPRIATION PERMIT AND STATE HEALTH DEPARTMENT APPROVAL) <input type="checkbox"/> TEST, OBSERVATION, MONITORING (MAY REQUIRE APPROPRIATION PERMIT)		SHOW MAJOR FEATURES OF BOX & LOCATE WELL WITH AN X SOURCES OF DRILLING WATER 1. WELL 2. 3. WRITE THE BOX NUMBER FROM THE MAP HERE 804 2 553 4	
APPROXIMATE DEPTH OF WELL 200 FEET APPROXIMATE DIAMETER OF WELL 6 INCH METHOD OF DRILLING (circle one) BORED (or Augered) JETTED Jetted & DRIVEN AIR-ROTARY AIR-PERCussion ROTARY (Hydraulic Rotary) CABLE REVERSE-ROTARY DRIVE-POINT other		DRAW A SKETCH BELOW SHOWING LOCATION OF WELL IN RELATION TO NEARBY TOWNS AND ROADS AND GIVE DISTANCE FROM WELL TO NEAREST ROAD JUNCTION 	
REPLACEMENT OR DEEPEINED WELLS (CIRCLE APPROPRIATE BOX) <input checked="" type="checkbox"/> THIS WELL WILL NOT REPLACE AN EXISTING WELL <input type="checkbox"/> THIS WELL WILL REPLACE A WELL THAT WILL BE ABANDONED AND SEALED <input type="checkbox"/> THIS WELL WILL REPLACE A WELL THAT WILL BE USED AS A STANDBY <input type="checkbox"/> THIS WELL WILL DEEPEIN AN EXISTING WELL PERMIT NUMBER OF WELL TO BE REPLACED OR DEEPEINED (IF AVAILABLE)		Not to be filled in by driller (OEP USE ONLY) APPROP. PERMIT NUMBER FORCE IN BOX WRITE INITIALS IN BOX PERMIT No. 70-88-0332	
SPECIAL CONDITIONS			

Well Permit No. HO - 88-0332
Location of property (road) SIDELING COURT
Subdivision GATNER SIDELING Lot 4 Block - Plat - Sec. 4
Well Driller G. EASTERDAY Owner MAJOR CONS. & DEVEL.

Depth of well 300
Distance of measuring point (M.P.) above ground 1
Static water level (S.W.L.) below M.P. 42

Time pump started 8:15 Pumping rate 10 G. P. M.
Total time 30 min to reach pumping water level 148 ft. below M.P.

[illegible]

16667

SEQUENCE NO.
(DENV USE ONLY)

STATE OF MARYLAND
WELL COMPLETION REPORT
FILL IN THIS FORM COMPLETELY
PLEASE PRINT OR TYPE

THIS REPORT MUST BE SUBMITTED WITHIN
45 DAYS AFTER WELL IS COMPLETED.

COUNTY
NUMBER

A-39905

DATE Received

DATE WELL COMPLETED

Depth of Well

PERMIT NO.

122098

2230026

FROM "PERMIT TO DRILL WELL"

(TO NEAREST FOOT)

H0-88-0332

OWNER

STREET OR RFD

SUBDIVISION

last name

first name

TOWN

SECTION

LOT

MATOR

121 E. 700' COURT

4

4

SYRACUSEVILLE

WELL LOG

Not required for driven wells

STATE THE KIND OF FORMATIONS
PENETRATED, THEIR COLOR, DEPTH,
THICKNESS AND IF WATER BEARING

DESCRIPTION (Use
additional sheets if needed)

FEET

Check
if water
bearing

FROM

TO

Top Soil

0

1

Red clay

1

3

Br. shale

3

16

Blue SLATR

16

21

Red SLATR

21

28

Blue SLATR

28

30

Red SLATR

30

38

Blue SLATR

38

50

Red SLATR

50

51

Blue SLATR

51

210

White Quartz

210

211

Blue SLATR

211

300

GROUTING RECORD

WELL HAS BEEN GROUTED
(Circle Appropriate Box)

yesno

Y44N44

TYPE OF GROUTING MATERIAL

CEMENTCMBENTONITE CLAYBC

NO. OF BAGS22NO. OF POUNDS2200

GALLONS OF WATER110

DEPTH OF GROUT SEAL (to nearest foot)

from0ft. to30ft.

(enter 0 if from surface)

CASING RECORD

casing
types
insert
appropriate
code
below

STCO
STEEL CONCRETE

PLOT
PLASTIC OTHER

MAIN Casing TYPE

Nominal diameter
top (main) casing
(nearest inch)

Total depth
of main casing
(nearest foot)

ST643

OTHER CASING (if used)

depth (feet)

diameter
inch

from

to

SCREEN RECORD

screen type
or open hole

insert
appropriate
code
below

STBRHO
STEEL BRASS OPEN
HOLE

PLOT
PLASTIC OTHER

DEPTH (nearest ft.)

H043300

EACH SCREEN

18911151721

2232426303236

383941454751

SLOT SIZE 123

DIAMETER
OF SCREEN

(NEAREST
INCH)

5660

GRAVEL PACK

IF WELL DRILLED WAS
FLOWING WELL INSERT
F IN BOX 68

from

to

68

OEP USE ONLY
(NOT TO BE FILLED IN BY DRILLER)

T (E.R.O.S.)

WQ

7072747576

TELESCOPE
CASING

LOG
INDICATOR

OTHER DATA

PUMPING TEST

HOURS PUMPED (nearest hour)

6

PUMPING RATE (gal. per min.
to nearest gal.)

3

METHOD USED TO
MEASURE PUMPING RATE

Bucket

WATER LEVEL (distance from land surface)

BEFORE PUMPING

47

WHEN PUMPING

149

TYPE OF PUMP USED (for test)

Aair

Ppiston

Tturbine

Ccentrifugal

Rrotary

Oother
(describe
below)

Jjet

Ssubmersible

PUMP INSTALLED

DRILLER WILL INSTALL PUMP YESNO

IF DRILLER INSTALLS PUMP, THIS SECTION
MUST BE COMPLETED FOR ALL WELLS
EXCEPT HOME USE

TYPE OF PUMP INSTALLED
PLACE (A,C,J,P,R,S,T,O)
IN BOX-SEE ABOVE:

CAPACITY:
GALLONS PER MINUTE
(to nearest gallon)

PUMP HORSE POWER

PUMP COLUMN LENGTH
(nearest ft.)

CASING HEIGHT (circle appropriate box
and enter casing height)

+above

-below

LAND SURFACE

(nearest
foot)

LOCATION OF WELL ON LOT

SHOW PERMANENT STRUCTURE SUCH AS
BUILDING, SEPTIC TANKS, AND/OR
LANDMARKS AND INDICATE NOT LESS
THAN TWO DISTANCES
(MEASUREMENTS TO WELL)

1000'

150'

1/2" well

CIRCLE APPROPRIATE LETTER

A A WELL WAS ABANDONED AND SEALED
WHEN THIS WELL WAS COMPLETED

E ELECTRIC LOG OBTAINED

P TEST WELL CONVERTED TO PRODUCTION
WELL

I HEREBY CERTIFY THAT THIS WELL HAS BEEN CONSTRUCTED IN
ACCORDANCE WITH COMAR 10.17.13 "WELL CONSTRUCTION"
AND IN CONFORMANCE WITH ALL CONDITIONS STATED IN THE
ABOVE CAPTIONED PERMIT, AND THAT THE INFORMATION
PRESENTED HEREIN IS ACCURATE AND COMPLETE TO THE BEST
OF MY KNOWLEDGE.

DRILLERS IDENT. NO. 40

DRILLERS SIGNATURE

(MUST MATCH SIGNATURE ON APPLICATION)

SITE SUPERVISOR (sign. of driller or journeyman
responsible for sitework if different from permittee)

COUNTY

ft before RR Tracks
of
date

8:00
12-19-88
mm

Review ok 2/13/89 CW

FIELD DATA SHEET
HOWARD COUNTY WELL YIELD TEST

Well Permit No. HO - 88-0332

Location of property (road) SIDELING COURT

Subdivision GAITHER SIDELING Lot 4 Block - Plat - Sec. 4

Well Driller G. EASTERDAY Owner MAJOR CONS. & DEVEL.

Depth of well 300 3.5 GPM

Distance of measuring point (M.P.) above ground

Static water level (S.W.L.) below M.P. 47'

I. High rate pumping -- reservoir drawdown

Time pump started 8:15 Pumping rate 10 G.P.M.

Total time 30 min to reach pumping water level 148 ft. below M.P.

II. Recovery pump test data - observations to be recorded every 15 minutes

TIME (in 15 minute intervals)	WATER LEVEL below M.P.	PUMPING RATE / time to fill 5 gallon bucket	FLOW METER READING (if used)	CALCULATED FLOW (gallons per minute)
8:45	148'	18 sec	N/A	3.3 G.P.M.
9:00	148'	18	Pump at 250'	3.3
9:15	148'	18	R. Hansen	3.5
9:30	147'	18		3.5
9:45	143'	15		4
10:00	143'	15		4
10:15	143'	15		4
10:30	143'	15		4
10:45	143'	15		4
11:00	150'	18		3.3
11:15	150'	18		3.3
11:30	149'	18		3.3
11:45	149'	18		3.3
12:00	149'	18		3.3
12:15	149'	18		3.3
12:30	149'	18		3.3
12:45	149'	18		3.3
1:00	149'	18		3.3
1:15	149'	18		3.3
1:30	149'	18		3.3
1:45	149'	18		3.3
2:00	149'	18		3.3
2:15	149'	18		3.3
2:30	149'	18		3.3

HD-224 2:45

149'

18

3.3

5/5/89 - AM

HOWARD COUNTY HEALTH DEPARTMENT
Bureau of Environmental Health
3525-H Ellicott Mills Drive
Ellicott City, MD 21043
461-9933

APPLICATION FOR PITLESS ADAPTER, WELL PUMP AND PRESSURE TANK INSTALLATION

New Installation X
Replacement _____

Receipt # 44138
Date 5/4/89

Name of Installer T. M. Barnard P. Hg. & Hg.

Telephone 461-6599

License Number 7248

Certified Well Pump Installer _____ Well Driller _____ Registered Plumber X

Name of Property Owner Mayer Const.

Telephone 447-5828

Subdivision Sickling Lot # 4

Well Tag # 40-80-0332

Site Address 613 Sickling Cr.

Pump

1. Type
a. Deep well jet _____
b. Shallow well jet _____
c. Submersible X

Motor

1. Horsepower 3/4
2. RPM _____
3. Voltage _____
a. 110 _____
b. 220 _____

Pitless Adapter

1. Make _____
2. Model # _____
3. Depth _____

2. Make Meyers

3. Model # _____

4. Capacity 5 1/2 GPM

5. Pump exceeds well capacity Yes _____ No X

6. If Yes, is low pressure cutoff switch installed? Yes _____ No _____

7. What methods are used to protect the pump and electrical wiring from vibrations? Torque arrestors X Cable guards X Other _____

Tank

1. Capacity _____
2. Pressure relief valve? _____

Piping

1. Type _____
2. Size _____
3. NSF and/or BOCA Code approved _____
4. Depth of supply line _____

Well data

1. Depth _____ ft.
2. Yield _____ GPM
3. Static water level _____ ft.
4. Will water supply be disinfected by installer? _____


I understand that it is my responsibility to notify the Howard County Health Department when the installation is ready for inspection (otherwise this permit is null and void).

All information given above is true to the best of my knowledge.

Signature of Applicant: Timothy M. Barnard

Date: 5/4/89

Note: A sticker indicating approval/status of the installation will be placed on the well casing at the time of the inspection.

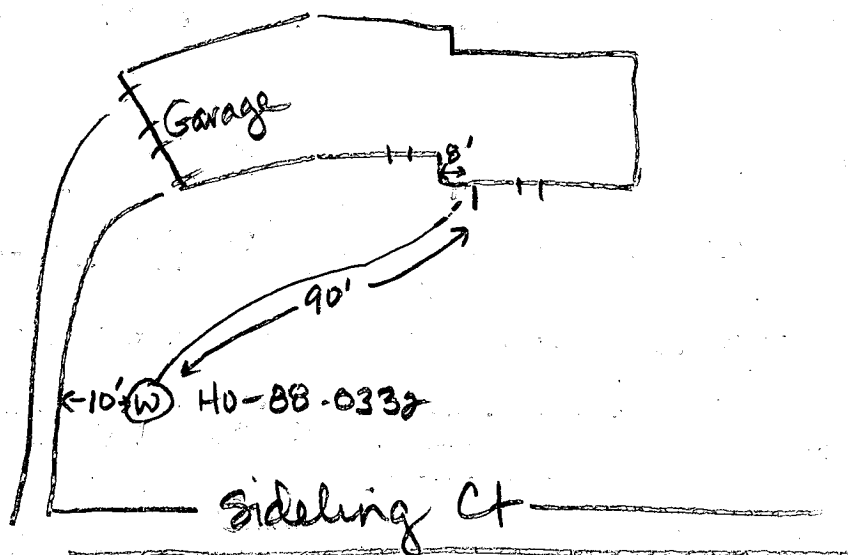

5-8-89

Pitless adaptor at 32 inches, Well line in trench at 36 inches w/ standing water. No ground line, House connection covered, Pump tank installed, House connection inside must be cemented to prevent more water from trench from entering basement. JENadeau.

HOWARD COUNTY HEALTH DEPARTMENT
Bureau of Environmental Health
3525-H Ellicott Mills Drive
Ellicott City, MD 21043
461-9933

APPLICATION FOR PITLESS ADAPTER, WELL PUMP AND PRESSURE TANK INSTALLATION

New Installation ☒
Replacement ☐

Receipt # 43106
Date 11/25/88

Name of Installer Bastarday

Telephone _____

License Number 40

Certified Well Pump Installer _____ Well Driller ☒ Registered Plumber _____

Name of Property Owner Heather Sidley Paul Ventura Telephone _____

Subdivision Garner Sideling Lot # 4 Well Tag # _____

Site Address _____

Pump

1. Type
 - a. Deep well jet _____
 - b. Shallow well jet _____
 - c. Submersible _____
2. Make _____
3. Model # _____
4. Capacity _____ GPM
5. Pump exceeds well capacity Yes _____ No _____
6. If Yes, is low pressure cutoff switch installed? Yes _____ No _____
7. What methods are used to protect the pump and electrical wiring from vibrations? Torque arrestors _____ Cable guards _____ Other _____

Motor

1. Horsepower _____
2. RPM _____
3. Voltage _____
 - a. 110 _____
 - b. 220 _____

Pitless Adapter

1. Make _____
2. Model # _____
3. Depth _____

Tank

1. Capacity _____
2. Pressure relief valve? _____

Piping

1. Type _____
2. Size _____
3. NSF and/or BOCA Code approved _____
4. Depth of supply line _____

Well data

1. Depth _____ ft.
2. Yield _____ GPM
3. Static water level _____ ft.
4. Will water supply be disinfected by installer? _____

I understand that it is my responsibility to notify the Howard County Health Department when the installation is ready for inspection (otherwise this permit is null and void).

All information given above is true to the best of my knowledge.


Signature of Applicant: John H. Fisher

Date: 11/14/88

Sec Treas.

Note: A sticker indicating approval/status of the installation will be placed on the well casing at the time of the inspection.

TABLE	
CAST	
502.609.03	
502.64.03	
502.002.04	
602.121.45	
602.040.50	
601.548.24	
601.547.77	
601.547.00	

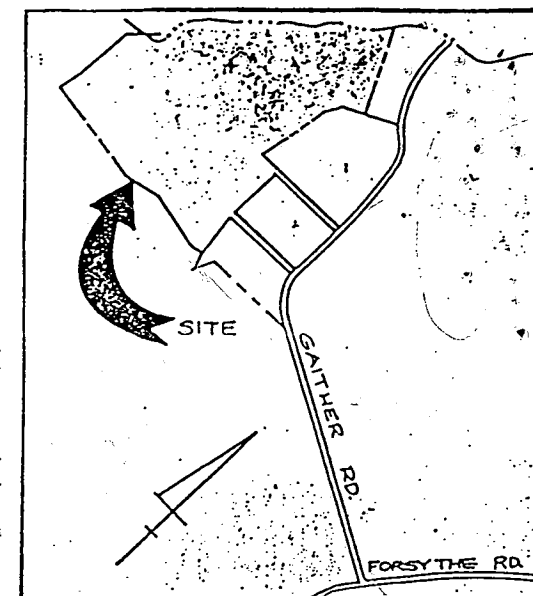

VICINITY MAP
SCALE: 1" = 1300'

DIRECTIONS: From Rt. 70 & Rt. 32,
North Rt. 32 -Left on Rt.99(Old
Frederick Rd)-Right Underwood-
Right Forsythe-Left on Gaither
Rd. to sign on left.

GATHER SIDELING

Price list as of March 11, 1988

LOT # 1- SOLD	4.2 acres			
LOT # 2- SOLD	3.5 acres			
LOT # 3- SOLD	3.2 acres			
LOT # 4- \$84,900	5.3 acres			
LOT # 5- \$84,900	5.8 acres			
LOT # 6- SOLD	3.0 acres			
LOT # 7- SOLD	6.7 acres			
LOT # 8- SOLD	6.2 acres			
LOT # 9- SOLD	7.0 acres			
LOT #10- \$84,900	3.4 acres	10 gal/min	\$1,825	205'
LOT #11- \$84,900	3.4 acres	12 " "	\$2,385	285'
LOT #12- \$84,900	4.2 acres	10 " "	\$2,945	365'
LOT #13- \$79,900	3.0 acres			
LOT #14- \$79,900	3.8 acres			
LOT #15- \$79,900	3.8 acres			
LOT #16- SOLD	3.2 acres			

ALL LOTS ARE 100% WOODED

PRICES ARE SUBJECT TO CHANGE WITHOUT NOTICE

WELLS HAVE ALREADY BEEN DRILLED ON LOTS 9, 10 & 11 WITH THE YIELD INDICATED. WELL COST IS ADDITIONAL.

Croston Endleaf

Major Constr.
+ Development.
1 WITH 465-0337

1/3/89

John H. Gaither Lot # 4 ~ Gaither Siding
Off Gaither Road
Sykesville - Md.


Septic: Tank ~ 4 76.5
Box Pit ~ 4 76.7
IN ~ 4 76.8
Tank out ~ 4 77.0
IN ~ 4 77.25
House ~ 4 77.50

BP # 23046

map 3.5'
Bldg. PERMIT SIGNED
AND RETURNED 1-3-89

Lot - 5

Scale: 1"=100'

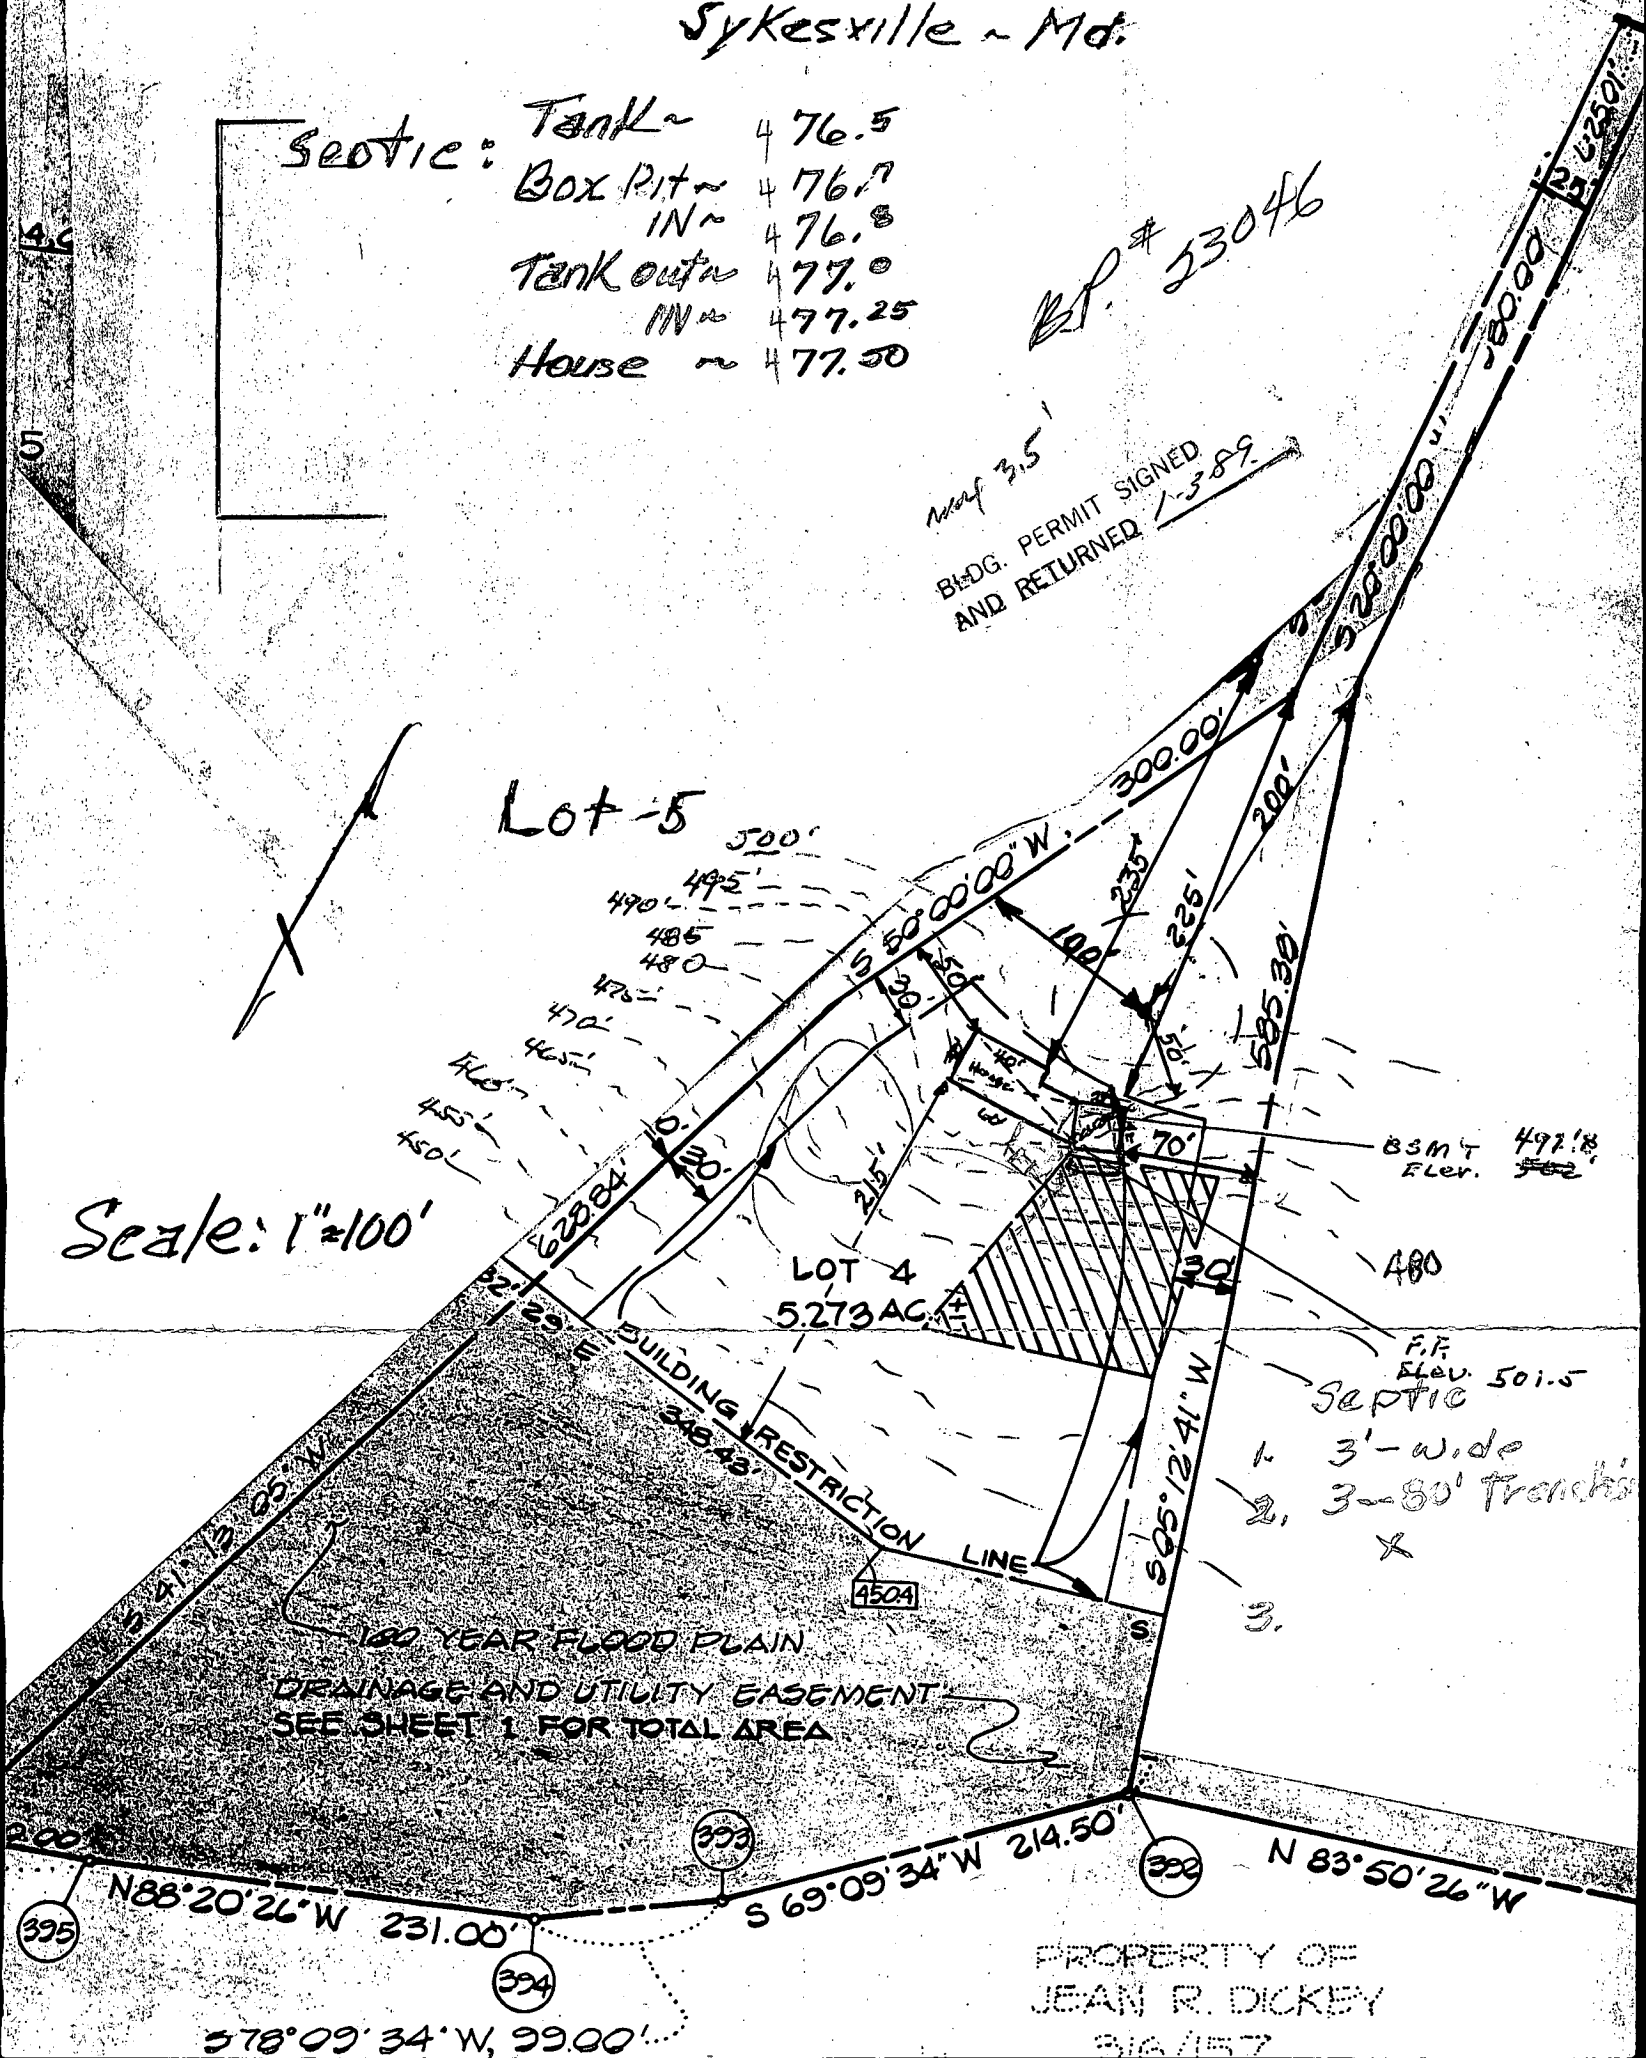

PROPERTY OF
JEAN R. DICKEY

316/157