

7/22/86
AM. ASPP.

7/22/86
Repair K10
BA

PERMIT

SEWAGE DISPOSAL SYSTEM

MARYLAND STATE DEPARTMENT OF HEALTH

P 37365
A Repair

HOWARD COUNTY
BUREAU OF ENVIRONMENTAL HEALTH
1992-2330
461-9933

02-211777

ELLICOTT CITY
DISTRICT _____

DATE 7/18/86

INDEXED

Jenkins Brothers IS PERMITTED TO INSTALL _____ ALTER X
ADDRESS Route 144, Ellicott City, Maryland 21043 PHONE 465-6646
SUBDIVISION _____ ROAD 9398 Suland Circle LOT _____
PROPERTY OWNER Charles Gibson
9398 Suland Circle
ADDRESS Ellicott City, Maryland 21043

IF GARBAGE GRINDER IS USED INCREASE SEPTIC TANK CAPACITY BY 50% AND ABSORPTION AREA BY 22%.

GARBAGE GRINDER? YES _____ NO X

SEPTIC TANK CAPACITY 1000 GALLONS NUMBER OF BEDROOMS 3

REPAIR - Call for inspection when ground is opened up so sanitarian can recommend repair.

new tank (old metal one removed)
sandy loam (w/ mica) soils.

PLANS APPROVED BY C. Williams DATE 7/18/86

COVER NO WORK UNTIL INSPECTED AND APPROVED.

NEITHER THE HOWARD COUNTY COUNCIL NOR THE HEALTH DEPARTMENT IS RESPONSIBLE FOR THE SUCCESSFUL OPERATION OF ANY SYSTEM.

NOTE: IF TRENCH IS USED CALL FOR INSPECTION BEFORE AND AFTER PLACING GRAVEL IN TRENCH.

NOTE: NO DRY WELL SHALL EXCEED 15 FOOT IN DIAMETER. NO ABSORPTION TRENCH TO EXCEED 100 FEET IN LENGTH.

NOTE: ALL PIPE FROM HOUSE TO SEPTIC TANK MUST BE CAST IRON OR SCHEDULE 40 PVC OR ABS.

PERMIT VOID AFTER THREE YEARS.


NOTE: INSTALL STAND PIPE ON SEPTIC TANK AND DRY WELL. STAND PIPES MUST BE 6 INCHES IN DIAMETER. CAST IRON, CONCRETE OR TERRA COTTA, OR PVC OR ABS ACCEPTED. IF TOP OF SEPTIC TANK IS DEEPER THAN 3 FEET MANHOLE TO GRADE REQUIRED.

*INSTALLER IS RESPONSIBLE FOR OBTAINING FINAL APROVAL ON THIS PERMIT

*CALL 992-2330 FOR INSPECTION OF SEPTIC SYSTEMS.

EH - 2-1082

573 65
A Repair

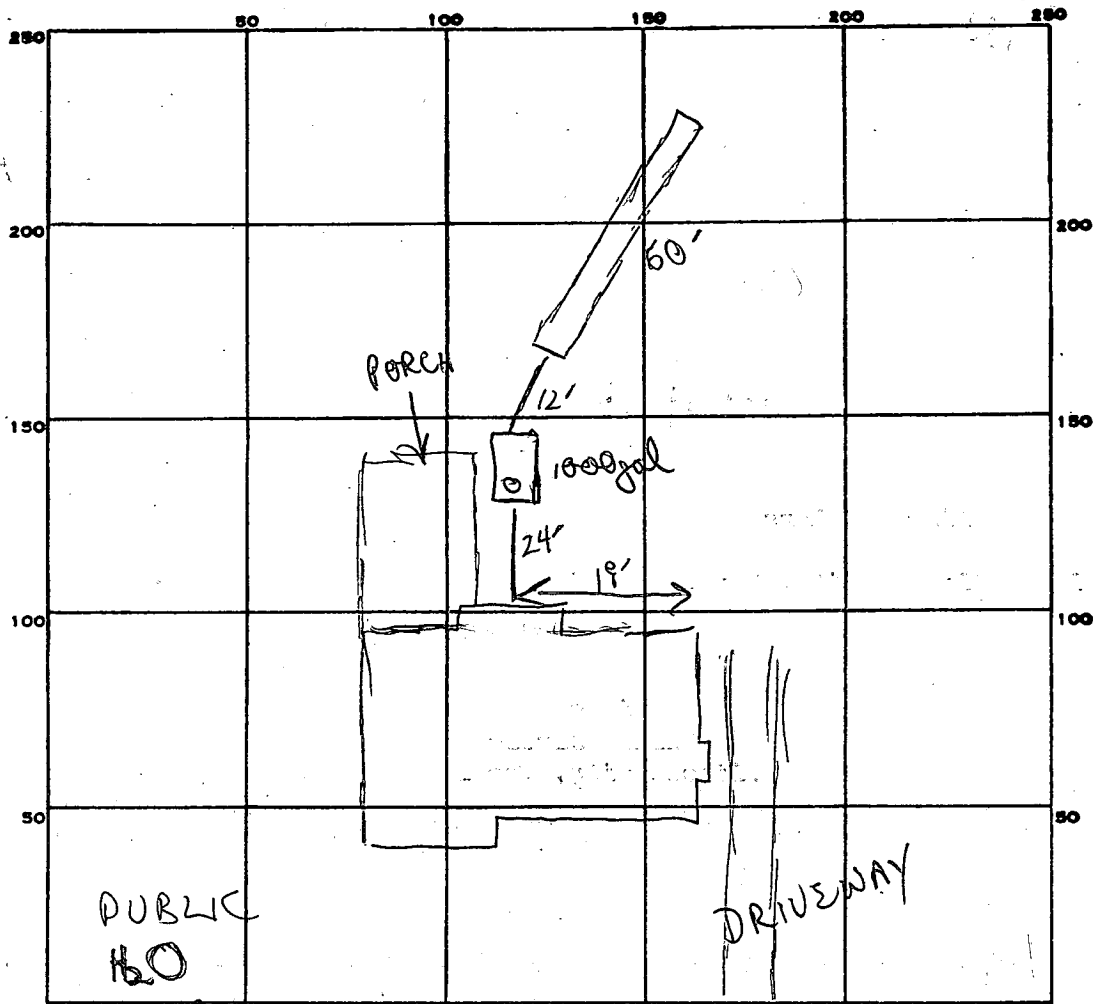

RTE 99

PERMIT CARD final

SEPTIC TANK, LEVEL 1000 gal (new) CLEANOUTS 1 S.T.

DISTRIBUTION BOX, LEVEL

TILE FIELD, DEPTH 9 FT. TRENCH WIDTH 2 FT.

GRAVEL DEPTH 7' IN. TOTAL LENGTH 60 FT.

NUMBER OF TRENCHES 1 1 SIDE WALL TOTAL BOTTOM AREA 420

SEEPAGE PITS, INSIDE DIAMETER FT. DEPTH BELOW INLET FT.

ABSORBENT AREA 420 SQ. FT.

REMARKS 7/22/86 OK to go 2' to 9' deep. Soils all sandy/mica loam

OK to finish adding stone pipe paper to trench.
OK to cover all work

DATE SYSTEM APPROVED 7/22/86 INSPECTOR B. W. Nixon

125
3
325

600
7
420

APPLICATION

HOWARD COUNTY

SERIAL NUMBER

PERMIT APPLICATION

DEPARTMENT OF INSPECTIONS, LICENSES & PERMIT
3430 COURT HOUSE DRIVE, ELLICOTT CITY, MARYLAND 21043

BUILDING ADDRESS (HOUSE NO., STREET, TOWN OR AREA)

9398 Soland Circle
Ellicott City, Md. 29653GRADING/SEDIMENT CONTROL ☐ YES ☐ NO

SDP #

DESCRIPTION OF WORK AUTHORIZED

Construct a 2nd floor bath
addition to be on posts.
12 X 7.5'

LOT NO. PARCEL NO. SEC. AREA BLOCK NO. LIBER FOLIO

70 776 2 16 2nd. 6022

SUB DIVISION ZONE ZONE MAP ELEC. DIST. CENSUS TR.

Brink Leigh R-2 17 2nd. 6022

OWNER NAME AND ADDRESS PHONE NO.
Mr. Eugene & Charlotte Lennick
9398 Soland Circle
Ellicott City, Md. (410) 750-3000OCCUPANT'S NAME AND ADDRESS PHONE NO.
Same

ARCHITECT OR ENGINEER'S NAME AND ADDRESS PHONE NO.

CONTRACTOR'S NAME AND ADDRESS PHONE NO.

Kevin G. Mack
1102 Vernon Ave.
Baltimore, Md. 21229 (410) 242-7882

EXISTING USE PROPOSED USE

None Bathroom Addition

EST. CONSTRUCTION COST LICENSE NUMBER PERMIT FEE

\$15,000 48647 25

W/S CODE FOR OFFICE USE ONLY

DISTANCE IN FEET FROM R/W LINE TO FRONT BUILDING LINE 50' min

SIDE YARD 50' min E.T. = 86'

TO SIDE BUILDING LINE 10' min
DISTANCE IN FEET, REAR YD. REQUIRING SET

BACK 30' min (CORNER LOT ONLY)

Check payable to: DIRECTOR OF FINANCE OF HOWARD COUNTY

CAUTION

To begin construction before a permit placard has been issued
and displayed on the job is a violation of the law.
Use and occupancy permit must be applied for two weeks
before it will be issued.

IMPORTANT: PLEASE SHOW ZIP CODES AND AREA CODES WHEREVER REQUIRED.

LP-68-591

SIZE OF BLDG. FRONT DEPTH HEIGHT

9'-6" x 12' 12' 9'-6" 21'

TYPE OF BLDG. AREA VOLUME ROOF

B. ROOMS 1152 9216 3/12 shing.

FIREPLACES

FOOTINGS FOUNDATION S. WALLS

Concrete Posts Frame

UTILITIES

WATER/WELL SEWER/SEPTIC GAS ELECTRICITY TYPE OF HEAT AC

Public Gas

I have carefully examined and read this application and know the same is true and correct,
and that is doing this work, all provisions of Howard County Ordinances and the State
Laws of Maryland will be complied with, whether specified or not; and I will notify the
Department of Inspections, and Permits twenty-four hours in advance when I am ready for
the inspections called for elsewhere in the application; and that no work will be covered up
until such inspections have been completed with.

Kevin G. Mack 5-8-97

Contractor SIGNATURE DATE

FUNCTION DATE SIGNATURE APPROVAL

ZONING/PLANNING X

SHA

SEDIMENT/GRADING

BUILDING OFFICIAL X 5-8-97 Kimberly A. Maultsby/AM

WATER & SEWER

HEALTH DEPT. X 5-8-97

FIRE PROTECTION

STORM WATER MGM X

APPROVED

DATE


Distribution of Copies:
White - Building Official
Green - Planning & ZoningYellow - Engineering
Pink - Health Dept.
Gold - S.H.A.

(2) PERK # 1533

A

NOTES:

1. This is NOT a Property Line/Boundary Survey and is NOT to be used for the erection of fences or any other improvement. This Survey is for Title Purposes ONLY. Title Report was not furnished.
2. This survey was prepared in accordance with the plat of subdivision and/or deed as recorded in the Land Records of Howard County, Maryland.
3. This property shown hereon is subject to easements and right-of-way(s) of record.
4. The location of any Fence or Fences shown hereon are Approximate ONLY. The Exact location of same has NOT been determined by this survey.
5. LEGEND OH - building overhang; D - deck; S - stoop; W - walkway; P - patio; AW - aerial wire(s); P.L. - property line; BW - bay window; CHM - chimney; WW - window well; SW - stairwell; G - gas meter

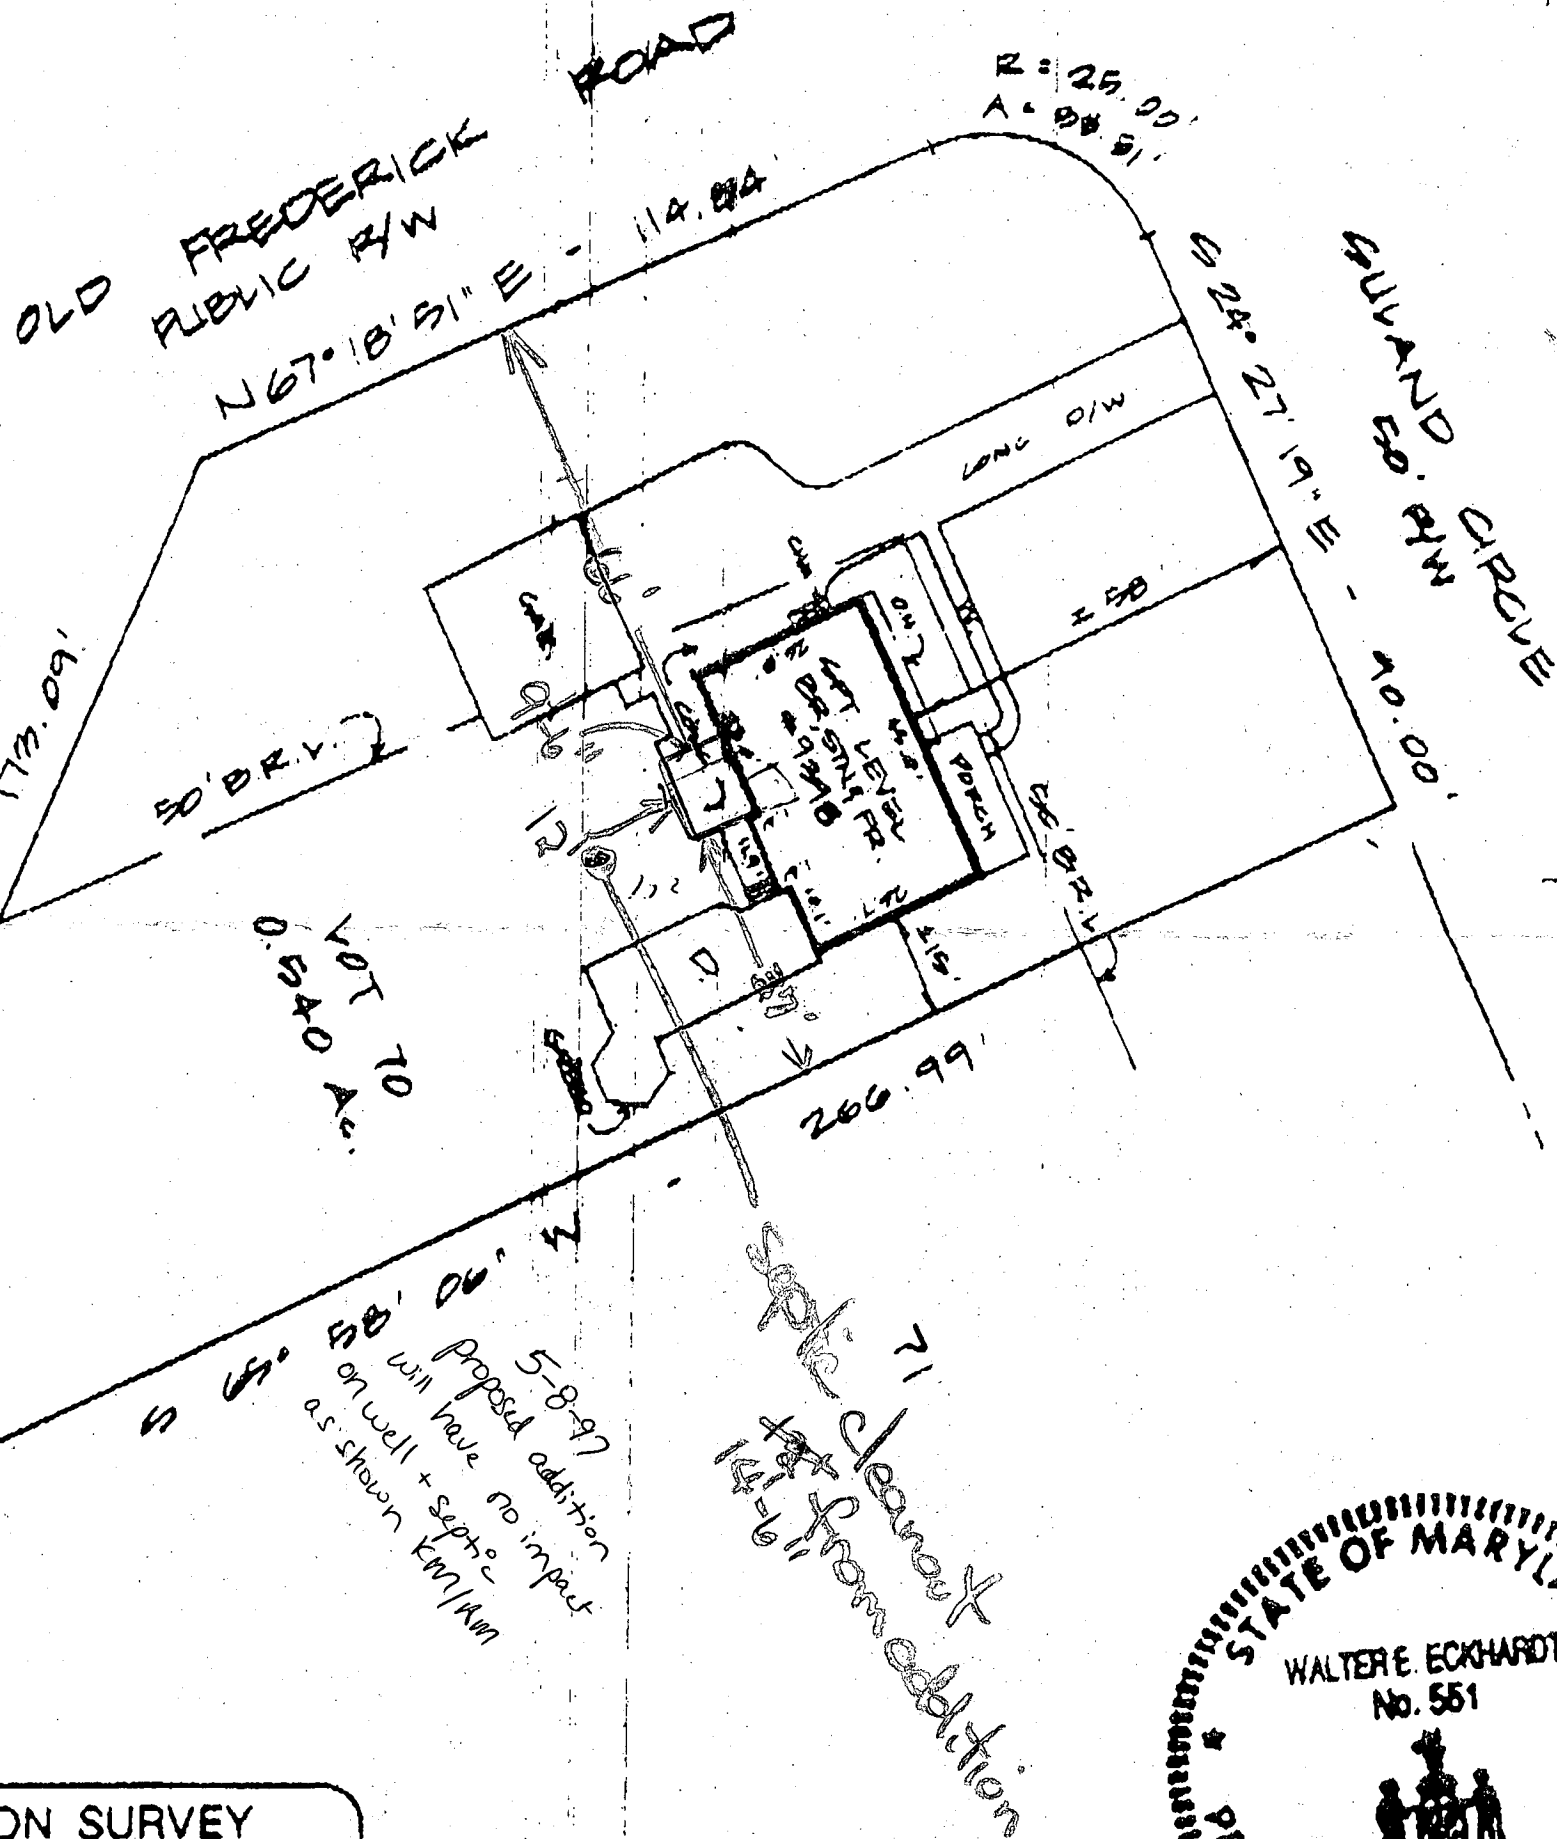

HOUSE LOCATION SURVEY


9398 SYLVANIA CIRCLE
LOT 70
MAP OF
BRINKLEIGH
SECTION FOUR
LOTS No. 28, 29, 44 TO 49
OF SECTION TWO AS NOW
REVISED
2ND District
Howard County, Maryland

Note: This property lies within Flood Zone C,
an area of Minimal Flooding, as established by
the National Flood Insurance Program, (F.E.M.A.)

CERTIFICATION:

I certify, to the best of my knowledge and belief, that the
existing visible improvements shown hereon have been
established by accepted land surveying practices and that
unless otherwise shown there are no visible encroachments

Walter E. Eckhardt
Walter E. Eckhardt
Property Line Surveyor, Md. Reg. No. 551

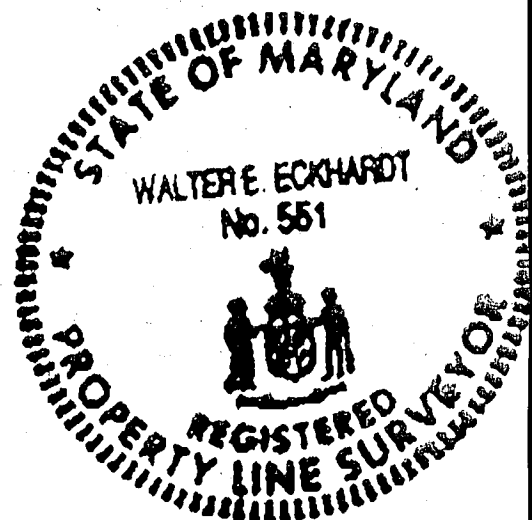

MSI METROPROFESSIONAL SURVEYING

11262 Georgia Ave. • Suite 102
Wheaton, MD 20902
(301) 929-8195
FAX: (301) 929-8197

Case: H94-03-035

File: 4-173-94

Ck: *VE*Dm: *SK*

Scale: 1" = 40'

Date: 4-22-94