

7/15/86
10 AM

05-364264

PERMIT

SEWAGE DISPOSAL SYSTEM

MARYLAND STATE DEPARTMENT OF HEALTH*

APPROVED
7/15/86
RH
P-37366

A REPAIR

HOWARD COUNTY
BUREAU OF ENVIRONMENTAL HEALTH

X992X233A
461-9933

ELLICOTT CITY

DISTRICT _____

DATE 7/15/86

INDEXED

Jack Fyock

IS PERMITTED TO INSTALL _____ ALTER X

ADDRESS _____ PHONE 988-9270

SUBDIVISION MONESFIELD ROAD 11713 Wayne Ridge Court

PROPERTY OWNER Raus (ORIGINAL OWNER)

ADDRESS _____

IF GARBAGE GRINDER IS USED INCREASE SEPTIC TANK CAPACITY BY 50% AND ABSORPTION AREA BY 22%.

GARBAGE GRINDER? YES _____ NO ✓

SEPTIC TANK CAPACITY _____ GALLONS NUMBER OF BEDROOMS 3

REPAIR - CALL FOR INSPECTION WHEN GROUND IS OPENED UP SO SANITARIAN CAN RECOMMEND REPAIR.

7/15/86-Trench 11 FT DEEP WITH 7 FT STONE
INLET 4 FT DEEP 125 SQ FT SIDE WALL AREA
PER BED ROOM

PLANS APPROVED BY C. Williams DATE 7/14/86

COVER NO WORK UNTIL INSPECTED AND APPROVED.

NEITHER THE HOWARD COUNTY COUNCIL NOR THE HEALTH DEPARTMENT IS RESPONSIBLE FOR THE SUCCESSFUL OPERATION OF ANY SYSTEM.

NOTE: IF TRENCH IS USED CALL FOR INSPECTION BEFORE AND AFTER PLACING GRAVEL IN TRENCH.

NOTE: NO DRY WELL SHALL EXCEED 15 FOOT IN DIAMETER. NO ABSORPTION TRENCH TO EXCEED 100 FEET IN LENGTH.

NOTE: ALL PIPE FROM HOUSE TO SEPTIC TANK MUST BE CAST IRON OR SCHEDULE 40 PVC OR ABS.

PERMIT VOID AFTER THREE YEARS.

NOTE: INSTALL STAND PIPE ON SEPTIC TANK AND DRY WELL. STAND PIPES MUST BE 6 INCHES IN DIAMETER. CAST IRON, CONCRETE OR TERRA COTTA, OR PVC OR ABS ACCEPTED. IF TOP OF SEPTIC TANK IS DEEPER THAN 3 FEET MANHOLE TO GRADE REQUIRED.

*INSTALLER IS RESPONSIBLE FOR OBTAINING FINAL APROVAL ON THIS PERMIT


*CALL 992-2330 FOR INSPECTION OF SEPTIC SYSTEMS.

EH - 2-1082

A
Repair
37366

SOIL PROFILE

①
BROWN CLAY
PINKISH BROWN SAND LOAM

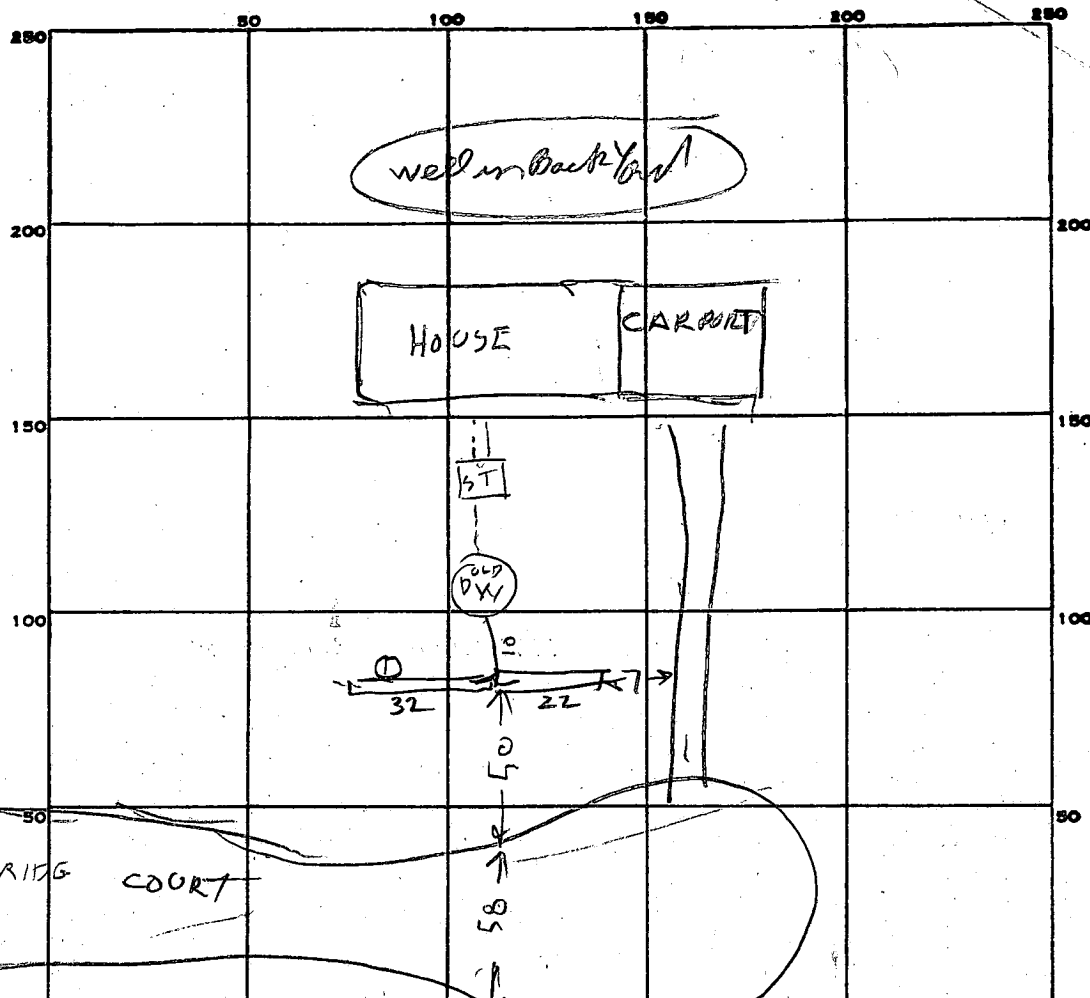

INDICATE NORTH. - NAME ADJOINING ROADWAY AS BASE LINE.

WELL ON LOT ACROSS STREET

PERMIT CARD _____

SEPTIC TANK, LEVEL _____

CLEANOUTS _____

DISTRIBUTION BOX, LEVEL _____

TILE FIELD, DEPTH 11 FT. TRENCH WIDTH 2 FT.

GRAVEL DEPTH 7 1/2 IN. TOTAL LENGTH 54 FT.

NUMBER OF TRENCHES 1 TOTAL BOTTOM AREA 405 ^{ONE SIDE}

SEEPAGE PITS, INSIDE DIAMETER _____ FT. DEPTH BELOW INLET _____ FT.

ABSORBENT AREA _____ SQ. FT.

REMARKS 7/15/86 ^{1015 PM} OLD SYSTEM IN USE 23 YEARS OLD DW
12 FT DEEP SOIL VERY GOOD TRENCH DUG & SOME STONE ALREADY ADDED RA
7/15/86 ^{1115 AM} ALL STONE & PIPE ADDED RH

DATE SYSTEM APPROVED 7/15/86

INSPECTOR Raymond Hodge

54
75
270
378
1050