

Tax ID - 04335775

36324

PERMIT

SEWAGE DISPOSAL SYSTEM

MARYLAND STATE DEPARTMENT OF HEALTH

HOWARD COUNTY
BUREAU OF ENVIRONMENTAL HEALTH

401-9933

INDEXED

ELLCOTT CITY

DISTRICT 4th

DATE 12/13/85

T. M. Moylan REINDEXED

CHARLES A. Stein & Sons, Inc.

IS PERMITTED TO INSTALL ☒ ALTER

ADDRESS 1603 Edmondson Ave. - 31227 10614 Harrisonville Road, Randallstown, MD 21122 FROM 312-4640

SUBDIVISION Glenwood Estates 3340 2307 Saddle Horse Court LOT 4, Section 2 Saddle Horse Court

PROPERTY OWNER ~~CHARLES A. STEIN & SONS, INC.~~ John Wiser

ADDRESS

* GARBAGE GRINDER IS USED INCREASE SEPTIC TANK CAPACITY BY 50% AND ABSORPTION AREA BY 25%

GARBAGE GRINDER? YES NO ☒

SEPTIC TANK CAPACITY 1250 1000 GALLONS NUMBER OF BEDROOMS 1

TRENCHES - 100 sq. ft. per bedroom. Trench to be 2 feet wide. Inlet 4.5 feet below original grade. Bottom maximum depth 1.5 feet below original grade. Effective area begins at 4.5 feet below original grade. 4 feet of slope below distribution pipe.
LOCATION: Start the trench 20 feet from the left 327.47 ft. lot line and 155 feet from the rear 125.00 ft. lot line as seen when facing the lot from Saddle Horse Court.
Run Trench(es) on contour toward the right 155.10 ft. lot line as seen from Saddle Horse Court. NOTE: No trench to exceed 100 feet in length. If more than one trench used, a distribution box is required. Call for inspection of trench(es) before and after grave!


SEW. PERMIT SIGNED

AND RETURNED 10-29-99

Serial # BR12 0900

propant tank - 1500 gal.

1436326

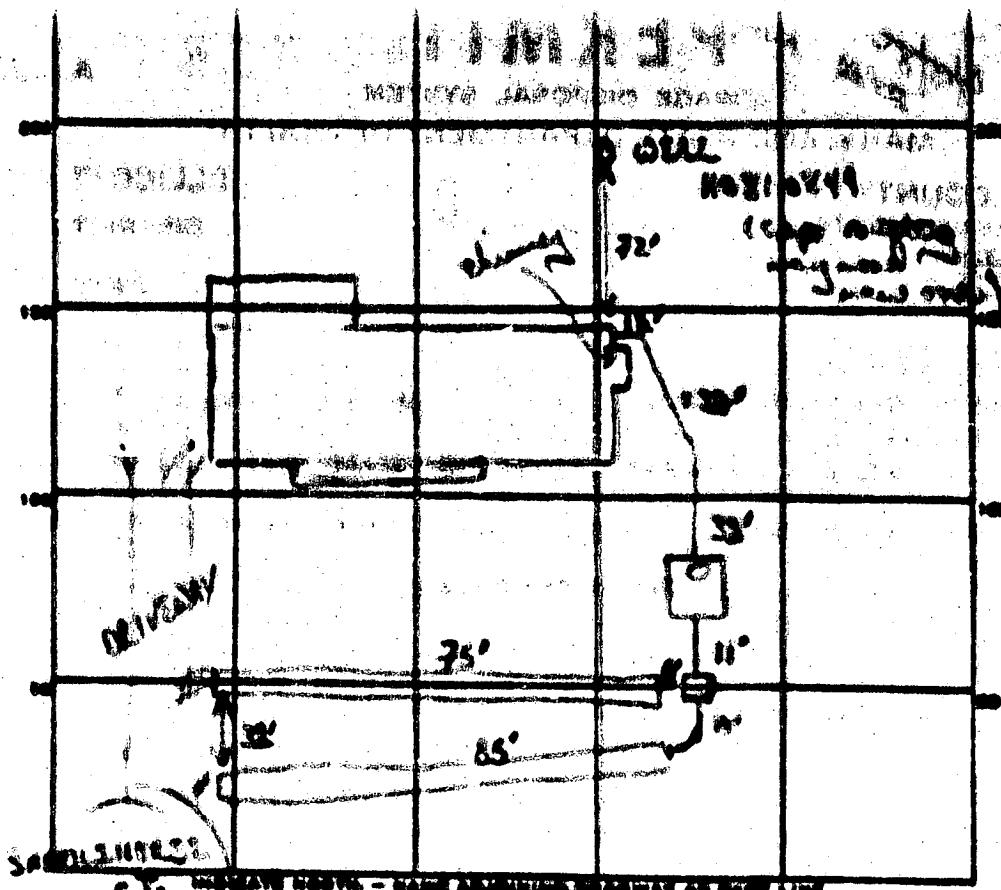


PERMIT CARD _____

SEPTIC TANK, LEVEL 1500 ft

DISTRIBUTION BOX, LEVEL 1500 ft

will allow normal
CLEANOUTS can run w/ grade adj. to get 3' fall

12.0
4
72.0

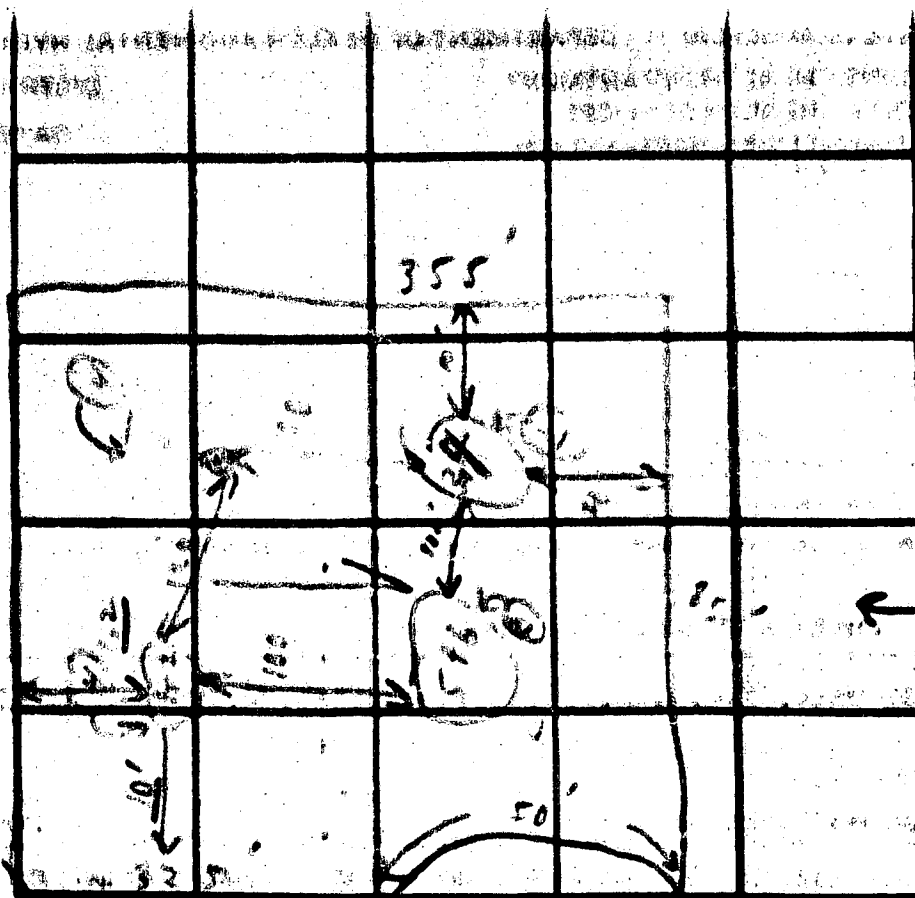

1784

X = 2min
Inner 4.5
Outer 8.5
45 steel

"David" His name for

DATE	TEST NO.	DEPTH	SND-WST		TEST - 1" SROP		TIME
			START	STOP	START	STOP	
7/11/54	1	5'	1:07	1:07	1:07	1:13	4m

✓ *h. l. l.*

OWNER: JAMES H. HILL
 STREET OR RD: 1000 W. 1000 W.
 SUBDIVISION: CLEGG ESTATES

STATE THE KIND OF FORMATION PENETRATED, THE COLOR, DEPTH, THICKNESS AND IF WATER BEARING

DESCRIPTION (See instructions above & record)	FEET	INCHES	WATER BEARING
1000	0	11	
1000	11	45	
1000	45	46	
1000	46	53	
1000	53	55	X
1000	55	83	
1000	83	84	X
1000	84	100	

WELL HAS BEEN DRILLED
 (Circle appropriate box)

TYPE OF CEMENT MATERIAL
 CEMENT: ☒ PORTLAND CEMENT
 TYPE OF CEMENT: ☒ PORTLAND CEMENT

NO. OF FEET
 GALLONS OF WATER
 DEPTH OF GROUT SEAL (in nearest foot)

MAIN CASING TYPE
 Nominal diameter (in nearest inch)
 Total depth (in nearest foot)

OTHER CASING (if used)
 diameter (in) depth (feet)

SCREEN TYPE OF OPEN HOLE
 (insert appropriate code)

SCREEN RECORD
☒ STEEL
☒ WIRE
☒ OPEN HOLE

WATER PUMPED (nearest foot)
 PUMPING RATE (in nearest gpm)
 METHOD USED TO MEASURE PUMPING RATE
 WATER LEVEL (distance from land surface before pumping)
 WHEN PUMPING

TYPE OF PUMP USED (in nearest gpm)
☒ A
☒ B
☒ C
☒ D
☒ E
☒ F
☒ G
☒ H
☒ I
☒ J
☒ K
☒ L
☒ M
☒ N
☒ O
☒ P
☒ Q
☒ R
☒ S
☒ T
☒ U
☒ V
☒ W
☒ X
☒ Y
☒ Z

PUMP INSTALLED
 DRILLER WILL INSTALL PUMP (YES OR NO)
 IF DRILLER INSTALLS PUMP, THIS SECTION MUST BE COMPLETED FOR ALL WELLS EXCEPT HOME USE
 TYPE OF PUMP INSTALLED
 PLACE (A.C., P.R., S.T., O.) IN BOX - SEE ABOVE
 CAPACITY: GALLONS PER MINUTE

19224

DEPARTMENT OF INSPECTIONS, LICENSES AND PERMITS
3430 COURT HOUSE DRIVE
ELLCOTT CITY, MD 21043
PERMITS (410)313-2466 INSPECTIONS (410)313-1810
AUTOMATED INFORMATION (410) 313-3800

HOWARD COUNTY
PERMIT APPLICATION

PERMIT NUMBER
B00120900

Building Address 3307 Saddle Horse Ct.
Glenwood, MD 21738

Suite/Apt. #: SDP/WP/Petition #:

Census Tract 6010 Subdivision Glenwood Ct

Section 2 Area Lot 4

Tax Map 21 Parcel 130 Grid 6

Zoning RA Map Coordinates 9E7 Lot size

Property Owner's Name JOHN W. WISOR

Address 3307 Saddle Horse Ct.

City Glenwood State MD Zip Code 21738

Home Phone 410 442 8019 Work Phone 301 649 8011

Applicant's Name & Mailing Address, (if other than stated hereon):

Phone Fax

Existing Use Single Family Dwelling

Proposed Use Underground Propane Tank

Estimated Construction Cost \$ 2300.00

Description of Work Bury a 500 Gallon U.G
TANK for FURNACE. for Propane

Contractor Company Suburban Propane

Contact Person Michael Dellvincent

Address 31 Derwood Circle P.O. Box 1766

City Rockville State MD Zip Code 20850

License No.

Phone 301 251 0606 Fax 301 251 0608

Occupant or Tenant JOHN W. WISOR

Contact Name Same

Address 3307 Saddle Horse Ct.

City Glenwood State MD Zip Code 21738

Phone 410 442 8019 Fax

Engineer or Architect Company

Contact Person

Address

City State Zip Code

Phone Fax

BUILDING DESCRIPTION - COMMERCIAL		BUILDING DESCRIPTION - RESIDENTIAL	
Building Characteristics	Utilities	Building Characteristics	Utilities
Height:	Water Supply: ☐ Public ☐ Private	SF Dwelling ☒ SF Townhouse ☐ Depth Width	Water Supply: ☐ Public ☒ Private
No. of stories:	Sewage Disposal: ☐ Public ☐ Private	1st floor:	Sewage Disposal: ☐ Public ☒ Private
Gross area, sq. ft. per floor:	Electric Yes ☐ No ☐ Gas Yes ☐ No ☐	2nd floor:	Electric Yes ☒ No ☐ Gas Yes ☐ No ☐
Use group:	Heating System: Electric ☐ Oil ☐ Natural Gas ☐ Propane Gas ☐	Basement:	Heating System: Electric ☐ Oil ☐ Natural Gas ☐ Propane Gas ☒
Construction type: ☐ Reinforced Concrete ☐ Structural Steel ☐ Masonry ☐ Wood Frame ☐ State Certified Modular	Sprinkler system: N/A ☐ ☐ Full ☐ Partial ☐ Other Suppression ☐ # of Heads	Finished Basement ☐ Unfinished Basement ☐ Crawl space ☐ Slab on Grade ☐ No. of Bedrooms	Sprinkler system: N/A ☐ ☐ NFPA #13D ☐ NFPA #13R ☐ Other:
		Multi-family dwellings: No. of efficiency units: No. of 1 BR units: No. of 2 BR units: No. of 3 BR units:	
		Other Structure: Dimensions: Footings: Roof:	
		☐ State Certified Modular ☐ Manufactured Home	

THE UNDERSIGNED HEREBY CERTIFIES AND AGREES AS FOLLOWS: (1) THAT HE/SHE IS AUTHORIZED TO MAKE THIS APPLICATION; (2) THAT THE INFORMATION IS CORRECT; (3) THAT HE/SHE WILL COMPLY WITH ALL REGULATIONS OF HOWARD COUNTY WHICH ARE APPLICABLE THEREBY; (4) THAT HE/SHE WILL PERFORM NO WORK ON THE ABOVE REFERENCED PROPERTY NOT SPECIFICALLY DESCRIBED IN THIS APPLICATION; (5) THAT HE/SHE GRANTS COUNTY OFFICIALS THE RIGHT TO ENTER ONTO THIS PROPERTY FOR THE PURPOSE OF INSPECTING THE WORK PERMITTED AND POSTING NOTICES.

Michael Dellvincent
Applicant's Signature
Residential/Energy Representative
Title/Company

Michael Dellvincent
Print Name
10/12/99
Date

Checks payable to: DIRECTOR OF FINANCE OF HOWARD COUNTY
** PLEASE WRITE NEATLY AND LEGIBLY. **
- FOR OFFICE USE ONLY -

AGENCY	DATE	SIGNATURE APPROVAL	DPZ SETBACK INFORMATION	PROPERTY ID#
☒ Land Development, DPZ			Front:	3105
☐ State Highways			Rear:	Filing fee \$ 100
☒ Building Official			Side:	Permit fee \$
☒ Dev. Engineering, DPZ			Side St.:	Excise tax \$
☒ Health	10/29/99	Steven R. King	All minimum setbacks met?	Sub-total paid \$
☐ Fire Protection			YES ☐ NO ☐	Add'l permit fee \$
Is Sediment Control approval required prior to issuance?			Is Entrance Permit required?	TOTAL FEES \$
YES ☐ NO ☐			YES ☐ NO ☐	Balance due \$
CONTINGENCY CONSTRUCTION START: ☐			Historic District?	Check # 0056
ONE STOP SHOP: ☐			YES ☐ NO ☐	Validation #
			Lot Coverage for New Town Zone	
			SDP/Red-line approval date	Accepted by

THIS PROPERTY
IS NOT LOCATED
IN A FLOOD
HAZARD ZONE

S 25° 09' 10" W
125.00'

500 Gallon
U.G. TANK



④
43,534 S.F.

WOOD
DECK

WOOD
STEPS

5.5' x 2' BRICK
CHIMNEY

TWO - STORY BRICK
& FRAME DWELLING

COVERED
CONC.
PORCH

Septic

LOCATION SURVEY
#3307 SADDLE HORSE
COURT ~ LOT 4
SECTION TWO
"GLENWOOD ESTATES"
PLAT NO. 3500
4TH ELECTION DISTRICT
HOWARD COUNTY, MD.
SCALE: 1"=40' 4/15/91
DEED: 1631-295

75' BUILDING
RESTRICTION LINE

REVISED: 9/12/92

I HEREBY CERTIFY THAT THE LOT HAS BEEN SURVEYED
FOR THE PURPOSE OF LOCATING THE IMPROVEMENTS
THEREON AND THAT THE IMPROVEMENTS
LOCATED AS SHOWN.

M. & H. DEVELOPMENT ENGINEERS, II
200 EAST JOPPA ROAD
ROOM 101, SHELL BUILDING

SADDLE HORSE
COURT

R=50.00'
L=50.00'

S 25° 09' 10" W

N 64° 50' 50" W

N 64° 50' 50" W

MAC. DRIVE

327.47'

354.10'

218' ±

85.13'

29' ±

24'

17'

12.5'

42'

#3307

47'

37'

19'

3' C.W.

CONC. 49.2
GAR. STY.

18'

22'

29'

17'

1.7' DR.