

05-405114

PERMIT

SEWAGE DISPOSAL SYSTEM

MARYLAND STATE DEPARTMENT OF HEALTH

HOWARD COUNTY
BUREAU OF ENVIRONMENTAL HEALTH
461-9933

INDEXED

TAX ID # 05-405114

P 43144

A 36988

DISTRICT 5th

DATE 11/30/88

DATE SYSTEM APPROVED 11/14/88

INSPECTOR RH

Jack Fyock

IS PERMITTED TO INSTALL ☒ ALTER ☐

ADDRESS

PHONE 988-9270

SUBDIVISION

The Chase

ROAD

11620 Vixen Path

LOT

12

PROPERTY OWNER

Harve &

Eileen Horowitz

ADDRESS

BUILDING PERMIT SIGNED

AND RETURNED

IF GARBAGE GRINDER IS USED INCREASE SEPTIC TANK CAPACITY BY 50% AND ABSORPTION AREA BY 22%

GARBAGE GRINDER?

YES ☒NO ☐

11-404 BOD 150805 - FINISH BRENNAN

SEPTIC TANK CAPACITY 2000

GALLONS

NUMBER OF BEDROOMS

4

TRENCHES - 220 sq. ft. per bedroom with garbage disposal. Trench to be 3 feet wide. Inlet 3.5 feet below original grade. Bottom maximum depth 5.0 feet below original grade. Effective area begins at 3.5 feet below original grade. 1.5 feet of stone below distribution pipe.

LOCATION - Beginning from the intersect of the rear 471.46' lot line and the 300.0' lot line place the trench 110 feet along the 471.46' lot line moving to the left and 100 feet off the same line as seen when facing the lot from Vixen Path. Run trenches on contour toward the left lot line.

NOTE - No trench to exceed 100 feet in length. Provide 6" - 8" diameter cleanout and cap to grade or above on septic tank. ok/cw

PLANS APPROVED BY

Sid Abel

DATE Updated - 2/23/88

COVER NO WORK UNTIL INSPECTED AND APPROVED

NEITHER THE HOWARD COUNTY COUNCIL NOR THE HEALTH DEPARTMENT IS RESPONSIBLE FOR THE SUCCESSFUL OPERATION OF ANY SYSTEM.

NOTE: CLEANOUT REQUIRED EVERY 70 FEET OF SEWER LINE AND/OR AT 90° SWEEPS IN LINES FROM HOUSE TO DRAIN FIELDS

NOTE: ALL PARTS OF SEPTIC SYSTEMS (I.E. TANK, DISTRIBUTION BOX, TRENCHES) TO BE 100 FEET FROM WELL (UNLESS OTHERWISE SPECIFICALLY AUTHORIZED)

NOTE: IF DEEP TRENCH(IES) ARE USED CALL FOR INSPECTION BEFORE AND AFTER PLACING GRAVEL IN TRENCH(IES)

NOTE: NO DRY WELL SHALL EXCEED 15 FOOT IN DIAMETER. NO ABSORPTION TRENCH TO EXCEED 100 FEET IN LENGTH.

NOTE: ALL PIPE FROM HOUSE TO SEPTIC TANK MUST BE CAST IRON OR SCHEDULE 40 PVC OR ABS

PERMIT VOID AFTER TWO YEARS

NOTE: INSTALL STAND PIPE ON SEPTIC TANK AND DRY WELL. STAND PIPES MUST BE 6 INCHES IN DIAMETER. CAST IRON, CONCRETE OR TERRA COTTA OR PVC OR ABS ACCEPTED. IF TOP OF SEPTIC TANK IS DEEPER THAN 3 FEET, MANHOLE TO GRADE REQUIRED

NOTE: DISTRIBUTION BOXES MUST HAVE BAFFLES

BUDG. PERMIT SIGNED


AND RETURNED 8/27/90

Serial # 34323 - Pord

*INSTALLER IS RESPONSIBLE FOR OBTAINING FINAL APPROVAL ON THIS PERMIT

*CALL 461-9933 FOR INSPECTION OF SEPTIC SYSTEMS.

A 36988

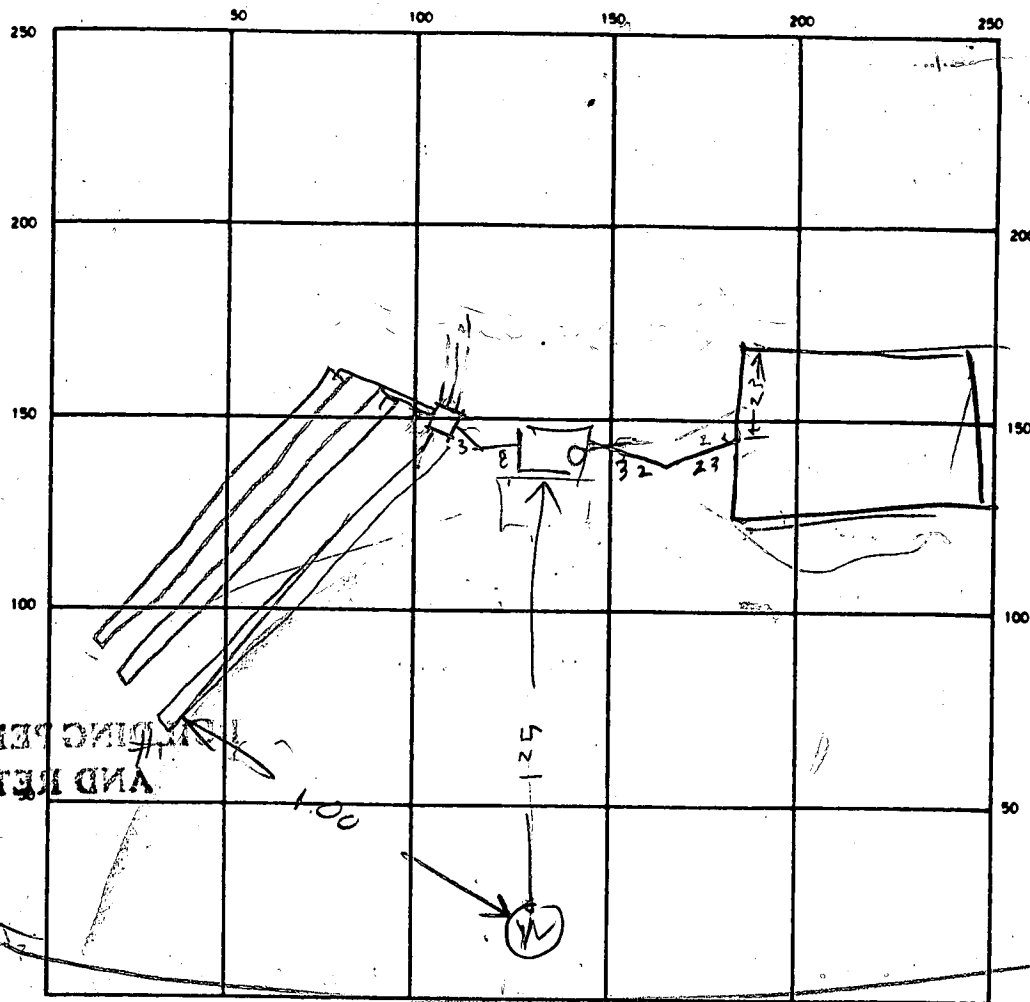

INDICATE NORTH - NAME ADJOINING ROADWAY AS BASE LINE

VIXEN ROAD

SEPTIC TANK LEVEL 2000

CLEANOUTS ST
OK

DISTRIBUTION BOX LEVEL

1/2/3
DRAIN FIELD/TILE FIELD DEPTH 5.5/5 FT.

TRENCH WIDTH 3/3/3 FT.

INLET DEPTH 3/3.5/2.5 FT.

1/2/3
EFFECTIVE GRAVEL DEPTH 2/2/2 FT.

FT.

TOTAL LENGTH 100/100/100 FT. 300

NUMBER OF TRENCHES 3

ONE SIDEWALL/BOTTOM AREA 900 8860 FT. INSTALL REQUIRED

DRYWELL INSIDE DIAMETER

FT.

EFFECTIVE DEPTH BELOW INLET

FT.

ABSORBENT AREA

SQ. FT.

REMARKS 10/14/88^{AN} LOCATION OK SHIFTED HIGHER THAN SHOWN ON
PLANS TO AVOID STREAM BED.

DATE SYSTEM APPROVED

11/14/88

INSPECTOR

Raymond Hodger

PERCOLATION TESTING

A. 36988

P _____

DISTRICT 5

DATE 5/15/86

I. HEREBY, APPLY FOR THE NECESSARY TEST IN ORDER TO CONSTRUCT (OR RECONSTRUCT) A SEWAGE DISPOSAL SYSTEM

PROPERTY OWNER ~~Wayback Corporation~~ Eileen Horowitz

ADDRESS P.O. Box 1018, Columbia, MD. 21044 PHONE 997-8800

PROSPECTIVE BUYER NONE

ADDRESS _____ PHONE _____

PROPERTY LOCATION:

SUBDIVISION The Chase - formerly The Paddock LOT NO. 12

ROAD AND DESCRIPTION ~~Homewood Road~~ 11620 Vixen PATH

TAX MAP 29 PARCEL # 24

SIZE OF LOT 3 acres TYPE BLDG. S.F.D.
(SINGLE FAMILY DWELLING OR COMMERCIAL)

THE SYSTEM INSTALLED UNDER THIS APPLICATION IS ACCEPTABLE ONLY UNTIL PUBLIC FACILITIES BECOME AVAILABLE. I FULLY UNDERSTAND THE FEE CONNECTED WITH THE FILING OF THIS PERC TEST APPLICATION IS NON-REFUNDABLE UNDER ANY CIRCUMSTANCES. I ALSO AGREE TO COMPLY WITH ALL M.O.S.H.A. REQUIREMENTS IN TESTING THIS LOT. _____

(SIGNATURE OF APPLICANT)

APPROVED BY Johnny Abel FOR Shallow tile holes DATE 1-6-87

REJECTED BY _____ FOR _____ DATE _____

HOLD PENDING FURTHER TESTS _____ **DATE** _____

REASONS FOR REJECTION OR HOLDING: 6/24/82 REAR: SATISFACTORY HOLD FOR SUBDIVISION PLAT STAY

Shallow, Spsr. only



~~BLDG. PERMIT SIGNED~~
~~AND RETURNED 2-23-88~~

BP/6850 SAC—

THIS IS NOT A PERMIT

③ ④
① ②

SOIL PROFILE

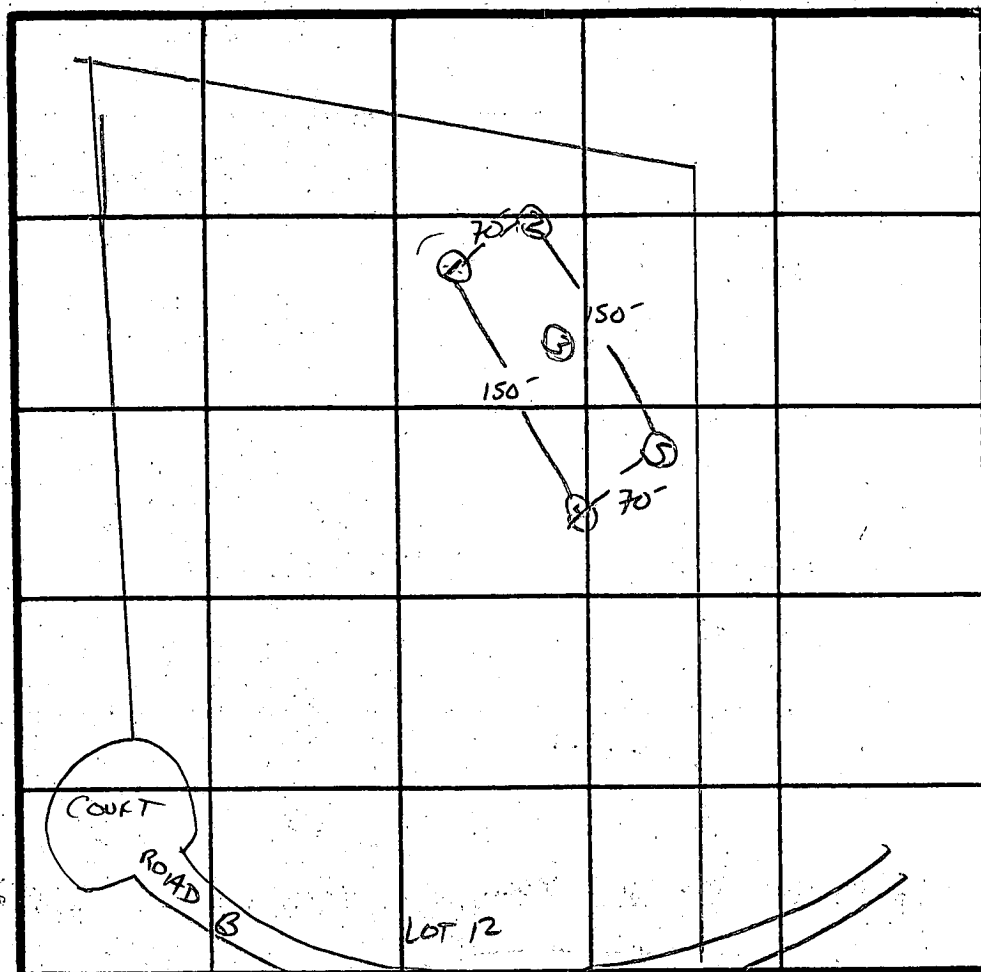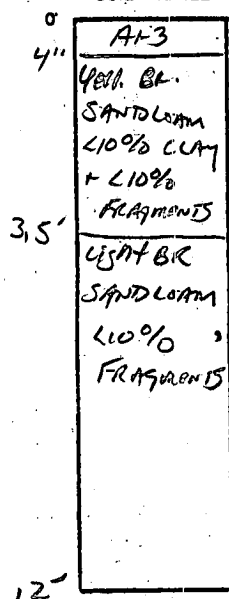

PERC
7min
INLET
3.5'
BOTTOM
5.0'
180°/BR

⑤
A-3
STRONG BROWN
SAND LOAM
10-20%
FRAGMENTS
49% CLAY
STRONG BR
SAND LOAM
<10%
FRAGMENTS

INDICATE NORTH - NAME ADJOINING ROADWAY AS BASE LINE.

1/1 HAMEWOOD Rd.

DATE	TEST NO.	DEPTH	PRE-WET		TEST - 1" DROP		TIME
			START	STOP	START	STOP	
6/24/96	1 S	4'	2:51	2:52	2:52	2:54	2min
	1 V	12'	UNIFORM soil below 3.5'				
	2 S	3.5'	2:56	3:07	3:07	3:30	23min
	2 V	12'	SAME AS HOLE #1				
	3 V	12'	SAME AS HOLE #1				
	4 S	4'	3:07	3:08	3:08	3:10	2min
	4 V	4'	3:15	3:16	3:16	3:17	1min
	4 V	12'	SAME AS HOLE #1				
	5 S	4'	3:08	3:10	3:10	3:13	3min
	5 V	12'	UNIFORM soil below 4'				

REMARKS

PERC'D AS PER PLAT. / Shallow System only, SA

TYPE OF SOIL

MAJOR LOAM

S. MBL

Jeff BDB

APPLICATION

PERCOLATION TESTING

A 369PP

P _____

HOWARD COUNTY HEALTH DEPARTMENT
BUREAU OF ENVIRONMENTAL HEALTH

P.O. BOX 476 ELLICOTT CITY, MARYLAND 21043
TELEPHONE: 461-9933

DISTRICT 5

DATE 5/15/86

TO: THE COUNTY HEALTH OFFICER
ELLICOTT CITY, MARYLAND

I, HEREBY, APPLY FOR THE NECESSARY TEST IN ORDER TO CONSTRUCT (OR RECONSTRUCT) A SEWAGE DISPOSAL SYSTEM.

PROPERTY OWNER Wayback Corporation

ADDRESS P.O. Box 1018, Columbia, MD. 21044 PHONE 997-8800

PROSPECTIVE BUYER NONE

ADDRESS _____ PHONE _____

PROPERTY LOCATION:

SUBDIVISION The Chase - formerly The Paddock LOT NO. 12

ROAD AND DESCRIPTION Homewood Road

TAX MAP 29 PARCEL # 24

SIZE OF LOT 3 acres TYPE BLDG. S.F.D.
(SINGLE FAMILY DWELLING OR COMMERCIAL)

THE SYSTEM INSTALLED UNDER THIS APPLICATION IS ACCEPTABLE ONLY UNTIL PUBLIC FACILITIES BECOME AVAILABLE. I FULLY UNDERSTAND THE FEE CONNECTED WITH THE FILING OF THIS PERC TEST APPLICATION IS NON-REFUNDABLE UNDER ANY CIRCUMSTANCES. I ALSO AGREE TO COMPLY WITH ALL M.O.S.H.A. REQUIREMENTS IN TESTING THIS LOT.


(SIGNATURE OF APPLICANT)

APPROVED BY _____ FOR _____ DATE _____

REJECTED BY _____ FOR _____ DATE _____

HOLD PENDING FURTHER TESTS _____ DATE _____

REASONS FOR REJECTION OR HOLDING: _____

THIS IS NOT A PERMIT

SOIL PROFILE

0


INDICATE NORTH - NAME ADJOINING ROADWAY AS BASE LINE.

DATE	TEST NO.	DEPTH	PRE-WET		TEST - 1" DROP		TIME
			START	STOP	START	STOP	

REMARKS

TYPE OF SOIL

EH-12-1079

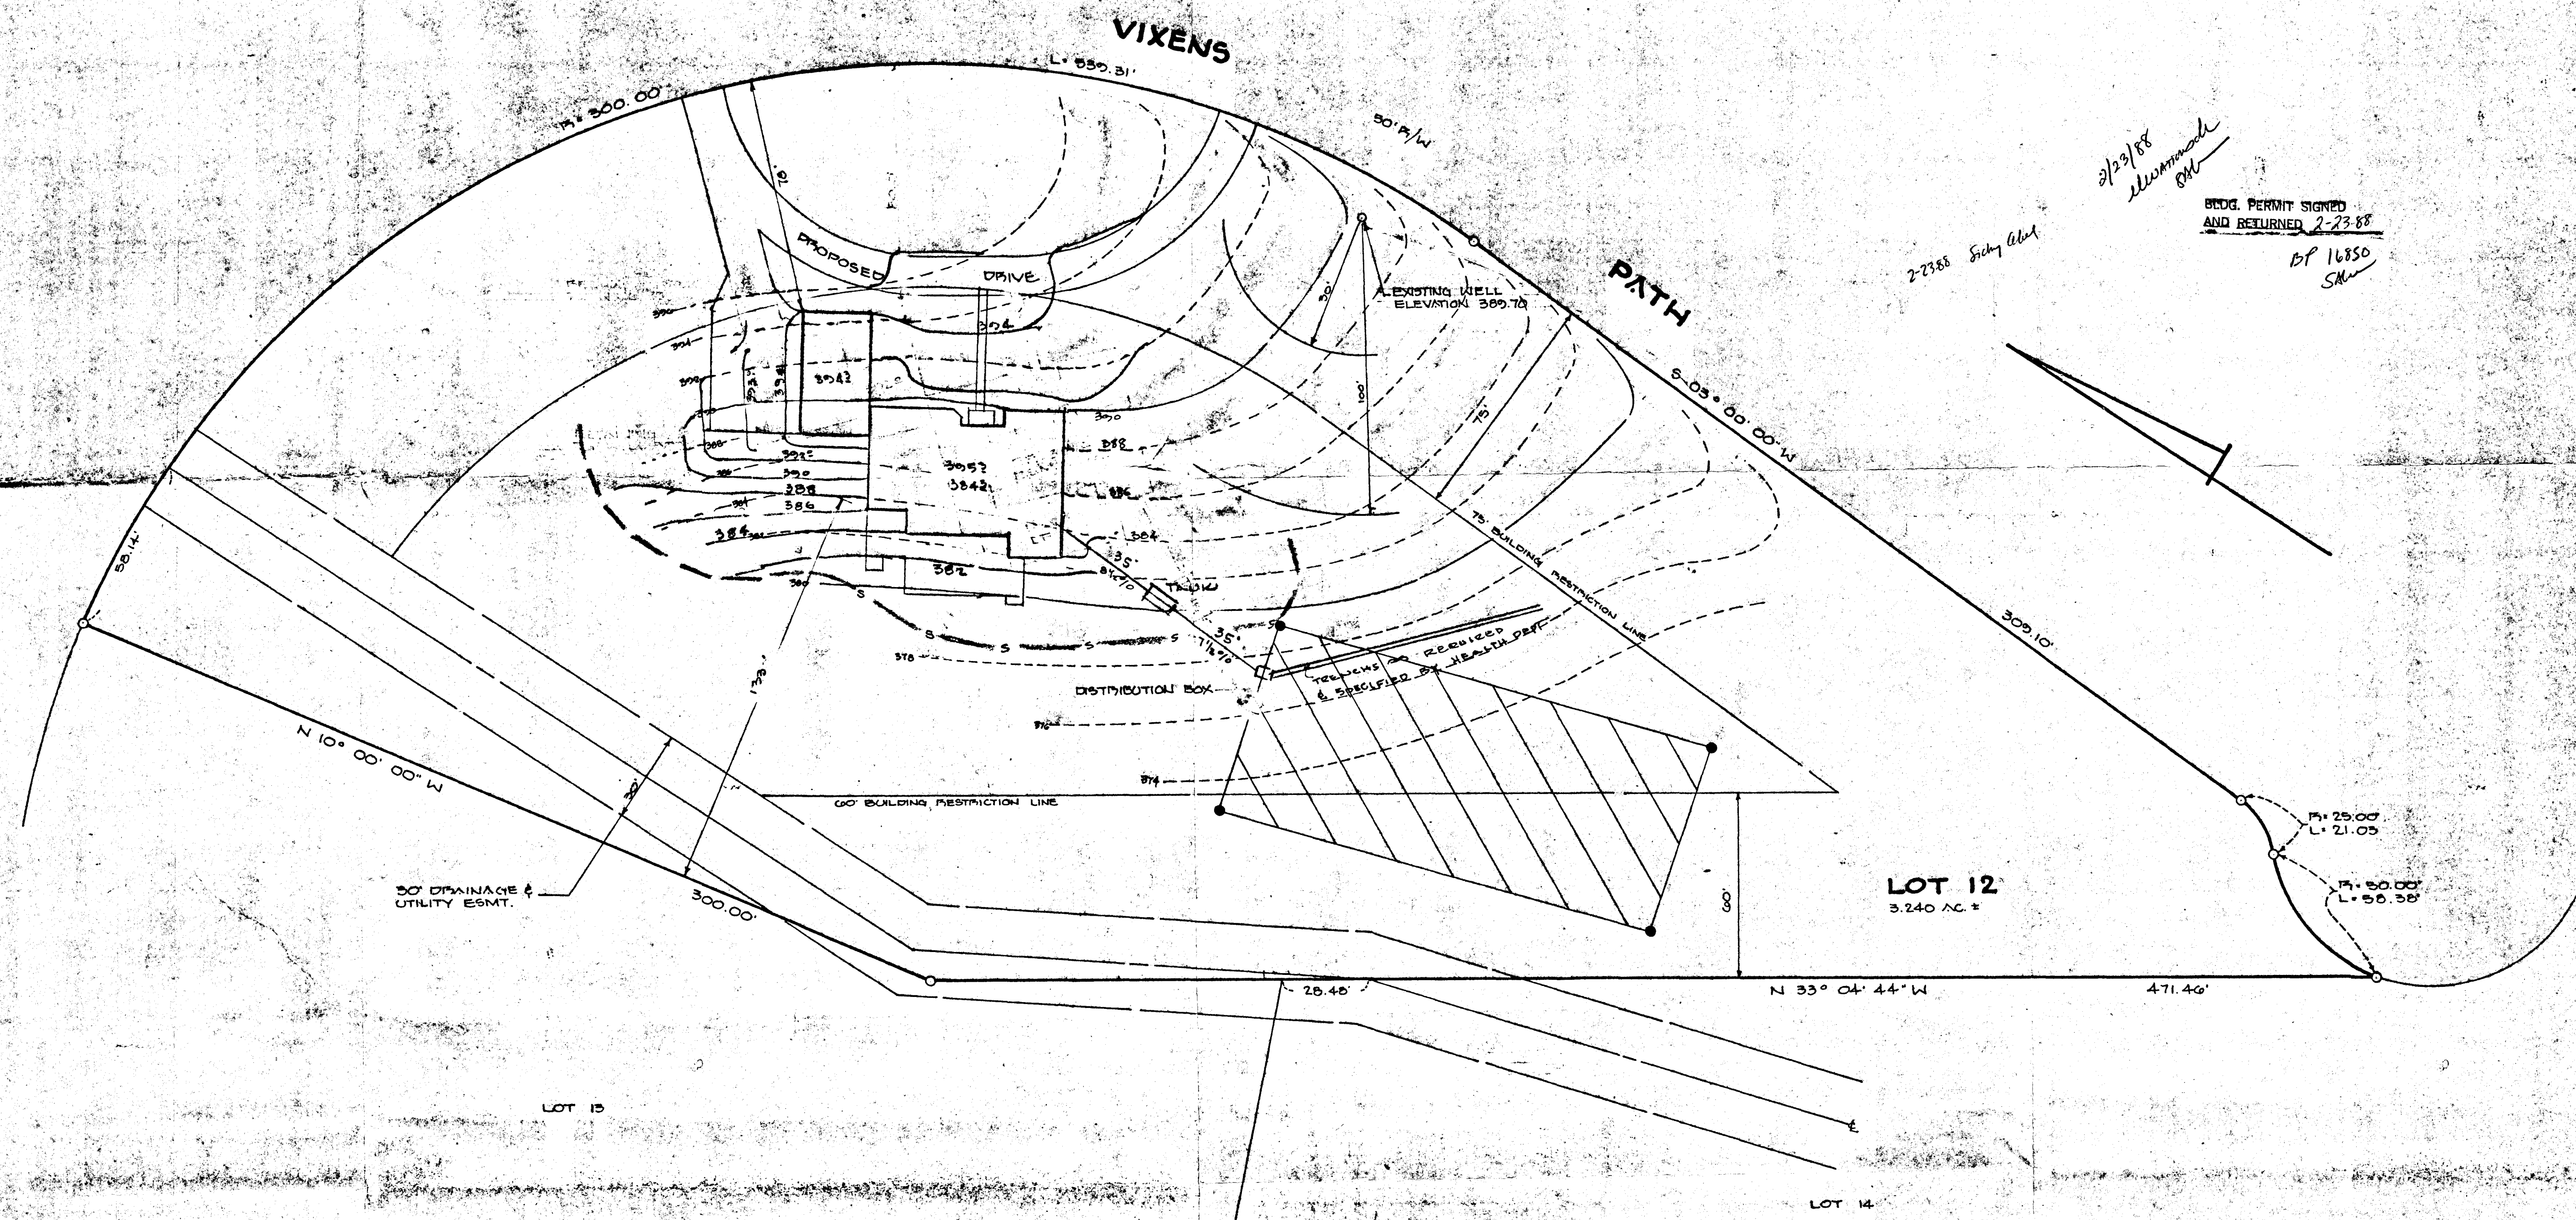

- NOTES:
1. ● INDICATES A PERCOLATION TEST HOLE.
 2. [Hatched Area] THIS AREA DESIGNATES A PRIVATE SEWAGE EASEMENT OF 10,000 G.P.D. AS REQUIRED BY THE MARYLAND STATE DEPARTMENT OF MENTAL HEALTH AND HYGIENE FOR INDIVIDUAL SEWAGE DISPOSAL. IMPROVEMENTS OF ANY NATURE IN THIS AREA ARE RESTRICTED UNTIL PUBLIC SEWERAGE IS AVAILABLE. THIS EASEMENT SHALL BECOME NULL AND VOID UPON CONNECTION TO A PUBLIC SEWERAGE SYSTEM. THE COUNTY HEALTH OFFICER SHALL HAVE THE AUTHORITY TO GRANT VARIANCES FOR ENCROACHMENTS INTO THE PRIVATE SEWAGE EASEMENT. RECONSTRUCTION OF A MODIFIED SEWAGE EASEMENT SHALL NOT BE NECESSARY.
 3. THE LOT SHOWN HEREON COMPLIES WITH THE MINIMUM LOT WIDTH AND AREA AS REQUIRED BY THE MARYLAND STATE DEPARTMENT OF MENTAL HEALTH AND HYGIENE.
 4. F.F. ELEVATION 303.2 ✓
D.S.M.T. ELEVATION 304.3 ✓
G.A.S. ELEVATION 302.2 ✓
DISTRIBUTION BOX:
EXISTING ELEVATION 377.2 ✓
INVERT 374.2 ✓
TANK:
EXISTING ELEVATION 301.2 ✓
INVERT OUT 370.0 ✓
INVERT IN 377.2 ✓
INVERT AT HOUSE 300.2 ✓ X B.S.M.T.

2-23-88 Sickly Allet
2/23/88 Muhammad
B.D.G. PERMIT SIGNED
AND RETURNED 2-23-88
B.P. 16850
S.M.

M. H. DEVELOPMENT ENGINEERS, INC.

SUITE 231, HARPERS CHOICE VIL. CT.
2485 HARPERS FARM ROAD
BETHESDA, MARYLAND 20814
PHONE 330-7000

SITE DEVELOPMENT PLAN

LOT 12
VIXENS PATH
THE COUNTRY PLACE
TAX MAP 20, PARCEL 24
PLAT REF 72.00
5TH ELECTION DISTRICT
HOWARD COUNTY MARYLAND

SCALE: 1" = 50'
DATE: 1/5/88

5/3/88

HOWARD COUNTY HEALTH DEPARTMENT
Bureau of Environmental Health
3525-H Ellicott Mills Drive
Ellicott City, MD 21043
461-9933

APPLICATION FOR PITLESS ADAPTER, WELL PUMP AND PRESSURE TANK INSTALLATION

New Installation X
Replacement _____

Receipt # 41474
Date 4/11/88

Name of Installer Mechanical Systems Co

Telephone 442-1718

License Number MD 6681

Certified Well Pump Installer _____ Well Driller _____ Registered Plumber MD 6681

Name of Property Owner Byron Builders

Telephone 740 4488

Subdivision The Chase Lot # 12

Well Tag # HO-81-3276

Site Address 11620 Vixen Path

Pump

1. Type
 - a. Deep well jet _____
 - b. Shallow well jet _____
 - c. Submersible X _____
2. Make _____
3. Model # _____
4. Capacity _____ GPM

Motor

1. Horsepower _____
2. RPM _____
3. Voltage _____
 - a. 110 _____
 - b. 220 _____

Pitless Adapter

1. Make _____
2. Model # _____
3. Depth _____

5. Pump exceeds well capacity Yes _____ No _____
6. If Yes, is low pressure cutoff switch installed? Yes X No _____
7. What methods are used to protect the pump and electrical wiring from vibrations? Torque arrestors X Cable guards X Other _____

Tank

1. Capacity _____
2. Pressure relief valve? _____

Piping

1. Type Copper
2. Size 1"
3. NSF and/or BOCA Code approved _____
4. Depth of supply line 42"

Well data

1. Depth 285 ft.
2. Yield 12 GPM
3. Static water level 36 ft.
4. Will water supply be disinfected by installer? yes

I understand that it is my responsibility to notify the Howard County Health Department when the installation is ready for inspection (otherwise this permit is null and void).


All information given above is true to the best of my knowledge.

Signature of Applicant: _____

Date: 4-11-88

Note: A sticker indicating approval/status of the installation will be placed on the well casing at the time of the inspection.

35
 20
 23 4
 12
 134
 20
 154

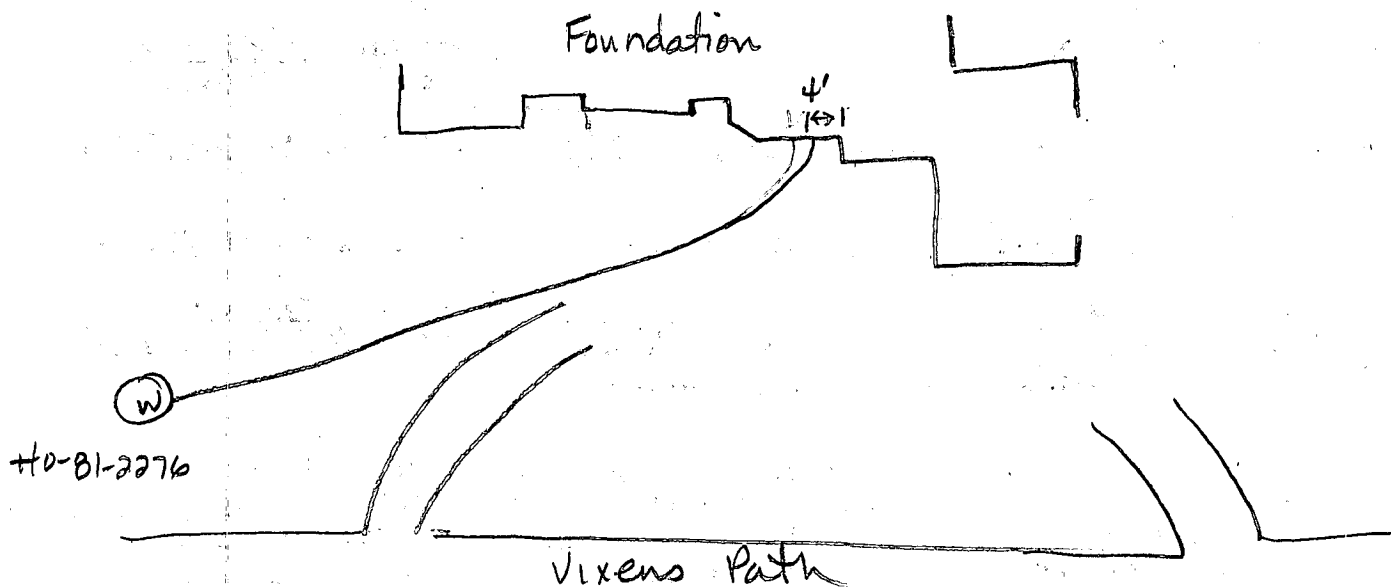

5-3-88

Atlas adapter at 42 inches, well line at 54 inches in
 the trench. Connection to foundation cemented. Ground line
 supplied but not connected to casing, JE Nadeau

C1	6081	SEQUENCE NO. (OEP USE ONLY)	STATE OF MARYLAND WELL COMPLETION REPORT		THIS REPORT MUST BE SUBMITTED WITHIN 45 DAYS AFTER WELL IS COMPLETED.	
		(THIS NUMBER IS TO BE PUNCHED IN COLS. 3-6 ON ALL CARDS)	FILL IN THIS FORM COMPLETELY PLEASE PRINT OR TYPE		COUNTY NUMBER	A-38988
DATE Received		DATE WELL COMPLETED		Depth of Well	PERMIT NO.	
8 9 10 11 12 13		15 16 17 18 19 20		22 23 24 25 26 (TO NEAREST FOOT)	FROM "PERMIT TO DRILL WELL"	
		101487		285	40-81-2276	

OWNER	BYRON BUKIENS		first name	TOWN	
STREET OR RFD	last name		VIXENS PATH	CLARKSVILLE	
SUBDIVISION	THE CHASE		SECTION	LOT 12	

WELL LOG		
Not required for driven wells		
STATE THE KIND OF FORMATIONS PENETRATED, THEIR COLOR, DEPTH, THICKNESS AND IF WATER BEARING		
DESCRIPTION (Use additional sheets if needed)	FEET	Check if water bearing
	FROM TO	
SAND	0 31	
GRAY Ditch Rock	31 285	
Dry Wells - 400, 460, 460, 400, 340		
Filled in with cement + Drilling materials		

GROUTING RECORD	
WELL HAS BEEN GROUTED (Circle Appropriate Box)	
yes	no
Y	N
TYPE OF GROUTING MATERIAL	
CEMENT	BENTONITE CLAY
CM	BC
NO. OF BAGS 8 NO. OF POUNDS 752	
GALLONS OF WATER 48	
DEPTH OF GROUT SEAL (to nearest foot)	
from 0 ft. to 32 ft.	
(enter 0 if from surface)	

CASING RECORD		
casing types insert appropriate code below	ST	CO
	STEEL	CONCRETE
	PL	OT
	PLASTIC	OTHER
MAIN CASING TYPE		
Nominal diameter top (main) casing (nearest inch)		
Total depth of main casing (nearest foot)		
54 61 63 64 36 70		

OTHER CASING (if used)	
diameter inch	depth (feet) from to

SCREEN RECORD		
screen type or open hole		
insert appropriate code below		
ST	BR	HO
STEEL	BRASS	OPEN HOLE
PL	OT	
PLASTIC	OTHER	

C2	
DEPTH (nearest ft.)	
H O 35 285	
EACH SCREEN	
1 8 9 11 15 17 21	
2 23 24 26 30 32 36	
3 38 39 41 45 47 51	
SLOT SIZE 1 2 3	
DIAMETER OF SCREEN (NEAREST INCH)	
56 60	

GRAVEL PACK	
IF WELL DRILLED WAS FLOWING WELL INSERT F IN BOX 68	
OEP USE ONLY (NOT TO BE FILLED IN BY DRILLER)	
T (E.R.O.S.) W.Q.	
70 72 74 75 76	

TELESCOPE CASING	
LOG INDICATOR	
OTHER DATA	

C3		
PUMPING TEST		
HOURS PUMPED (nearest hour)		
3		
PUMPING RATE (gal. per min. to nearest gal.)		
53		
METHOD USED TO MEASURE PUMPING RATE		
WATER LEVEL (distance from land surface)		
BEFORE PUMPING		
36		
WHEN PUMPING		
78		
TYPE OF PUMP USED (for test)		
A air	P piston	T turbine
C centrifugal	R rotary	O other (describe below)
J jet	S submersible	

PUMP INSTALLED	
DRILLER WILL INSTALL PUMP YES NO	
(CIRCLE) (YES or NO)	
IF DRILLER INSTALLS PUMP, THIS SECTION MUST BE COMPLETED FOR ALL WELLS EXCEPT HOME USE	
TYPE OF PUMP INSTALLED	
PLACE (A,C,J,P,R,S,T,O)	
IN BOX - SEE ABOVE:	
CAPACITY: GALLONS PER MINUTE (to nearest gallon)	
PUMP HORSE POWER	
PUMP COLUMN LENGTH (nearest ft.)	
CASING HEIGHT (circle appropriate box and enter casing height)	
LAND SURFACE	
(nearest foot)	

LOCATION OF WELL ON LOT	
SHOW PERMANENT STRUCTURE SUCH AS BUILDING, SEPTIC TANKS, AND/OR LANDMARKS AND INDICATE NOT LESS THAN TWO DISTANCES (MEASUREMENTS TO WELL)	
VIXENS PATH	
5 1/2 gal. well is 10 ft. from	

HD-224

Well Permit No. HO - 81-2276
Location of property (road) VIXENS PATH
Subdivision THE CHASE Lot 12 Block Plat Sec.
Well Driller JOE MAYNE Owner BYRON BUILDERS

Depth of well 285 ft
Distance of measuring point (M.P.) above ground 1 ft
Static water level (S.W.L.) below M.P. 36 ft

Time pump started 7:30 Pumping rate 12 gal
Total time 30 min to reach pumping water level 77 ft. below M.P.

II. Recovery pump test data - observations to be recorded every 15 minutes

[illegible]

B 1 9305	SEQUENCE NO. (OEP USE ONLY)	STATE OF MARYLAND PERMIT TO DRILL WELL please print or type	OEP PERMIT NUMBER 40-81-2276
THIS NUMBER IS TO BE PUNCHED IN COLS. 3-6 ON ALL CARDS		fill in this form completely	

Date Received

090287

OWNER INFORMATION

BYRON BUILDERS

5397 Twin Knolls Rd.

Columbia Md 21045

DRILLER INFORMATION

Joseph L. Wayne 238

Joseph L. Wayne WELL DRILLING

5512 Ridge Rd. Mt. Airy, Md 21771

Joseph L. Wayne 8/27/87

B 3

LOCATION OF WELL

HOWARD

THE CHASE


SECTION 44 46 LOT 48 50

CLARKSVILLE

MILES FROM TOWN (enter 0 if in town) 3 MI

B 4

DIRECTION OF WELL FROM TOWN (CIRCLE BOX)

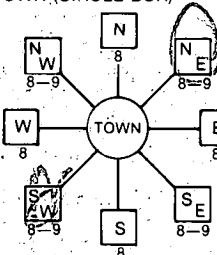

Videns path

ON WHICH SIDE OF ROAD (CIRCLE APPROPRIATE BOX)



DISTANCE FROM ROAD 65 FT

WELL INFORMATION

APPROX. PUMPING RATE (GAL. PER MIN.) 5

AVERAGE DAILY QUANTITY NEEDED 500

USE FOR WATER (CIRCLE APPROPRIATE BOX)

- ☒ HOME (SINGLE OR DOUBLE HOUSEHOLD UNIT ONLY)
- ☐ FARMING (LIVESTOCK WATERING & AGRICULTURAL IRRIGATION)
- ☐ INDUSTRIAL, COMMERCIAL, STATE AND FEDERAL GOV. OTHER (REQUIRES APPROPRIATION PERMIT)
- ☐ PUBLIC OR PRIVATE WATER COMPANY (REQUIRES APPROPRIATION PERMIT AND STATE HEALTH DEPARTMENT APPROVAL)
- ☐ TEST, OBSERVATION, MONITORING (MAY REQUIRE APPROPRIATION PERMIT)

APPROXIMATE DEPTH OF WELL 300 FEET

APPROXIMATE DIAMETER OF WELL 6 INCH

METHOD OF DRILLING (circle one)

 BORED (or Augered) JETTED Jetted & DRIVEN
 AIR-ROTARY AIR-PERCussion ROTARY (Hydraulic Rotary)
 CABLE REVERSE-ROTARY DRIVE-POINT

REPLACEMENT OR DEEPEMED WELLS (CIRCLE APPROPRIATE BOX)

- ☒ THIS WELL WILL NOT REPLACE AN EXISTING WELL
- ☐ THIS WELL WILL REPLACE A WELL THAT WILL BE ABANDONED AND SEALED
- ☐ THIS WELL WILL REPLACE A WELL THAT WILL BE USED AS A STANDBY
- ☐ THIS WELL WILL DEEPEN AN EXISTING WELL
- PERMIT NUMBER OF WELL TO BE REPLACED OR DEEPEMED (IF AVAILABLE)

Not to be filled in by driller (OEP USE ONLY)

APPROP. PERMIT NUMBER GAP

FORCE SA INITIALS PERMIT NO. 40-81-2276

SPECIAL CONDITIONS

NOT TO BE FILLED IN BY DRILLER HEALTH DEPARTMENT APPROVAL

 COUNTY NAME HOWARD COUNTY NO. A-36988
 OEP SIGNATURE DATE ISSUED 090887
 NORTH GRID 513000 EAST GRID 0824000
 STATE HEALTH INSERT S

SHOW MAJOR FEATURES OF BOX & LOCATE WELL WITH AN X


SOURCES OF DRILLING WATER


- WELL
-
-

WRITE THE BOX NUMBER FROM THE MAP HERE

 E 8204
 N 5103

DRAW A SKETCH BELOW SHOWING LOCATION OF WELL IN RELATION TO NEARBY TOWNS AND ROADS AND GIVE DISTANCE FROM WELL TO NEAREST ROAD JUNCTION

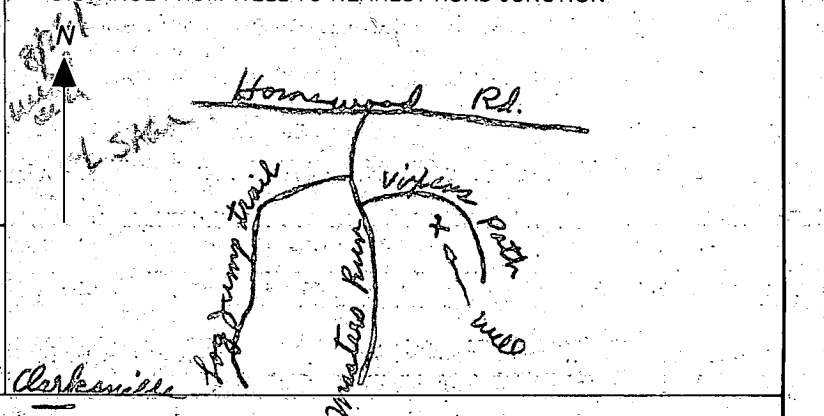

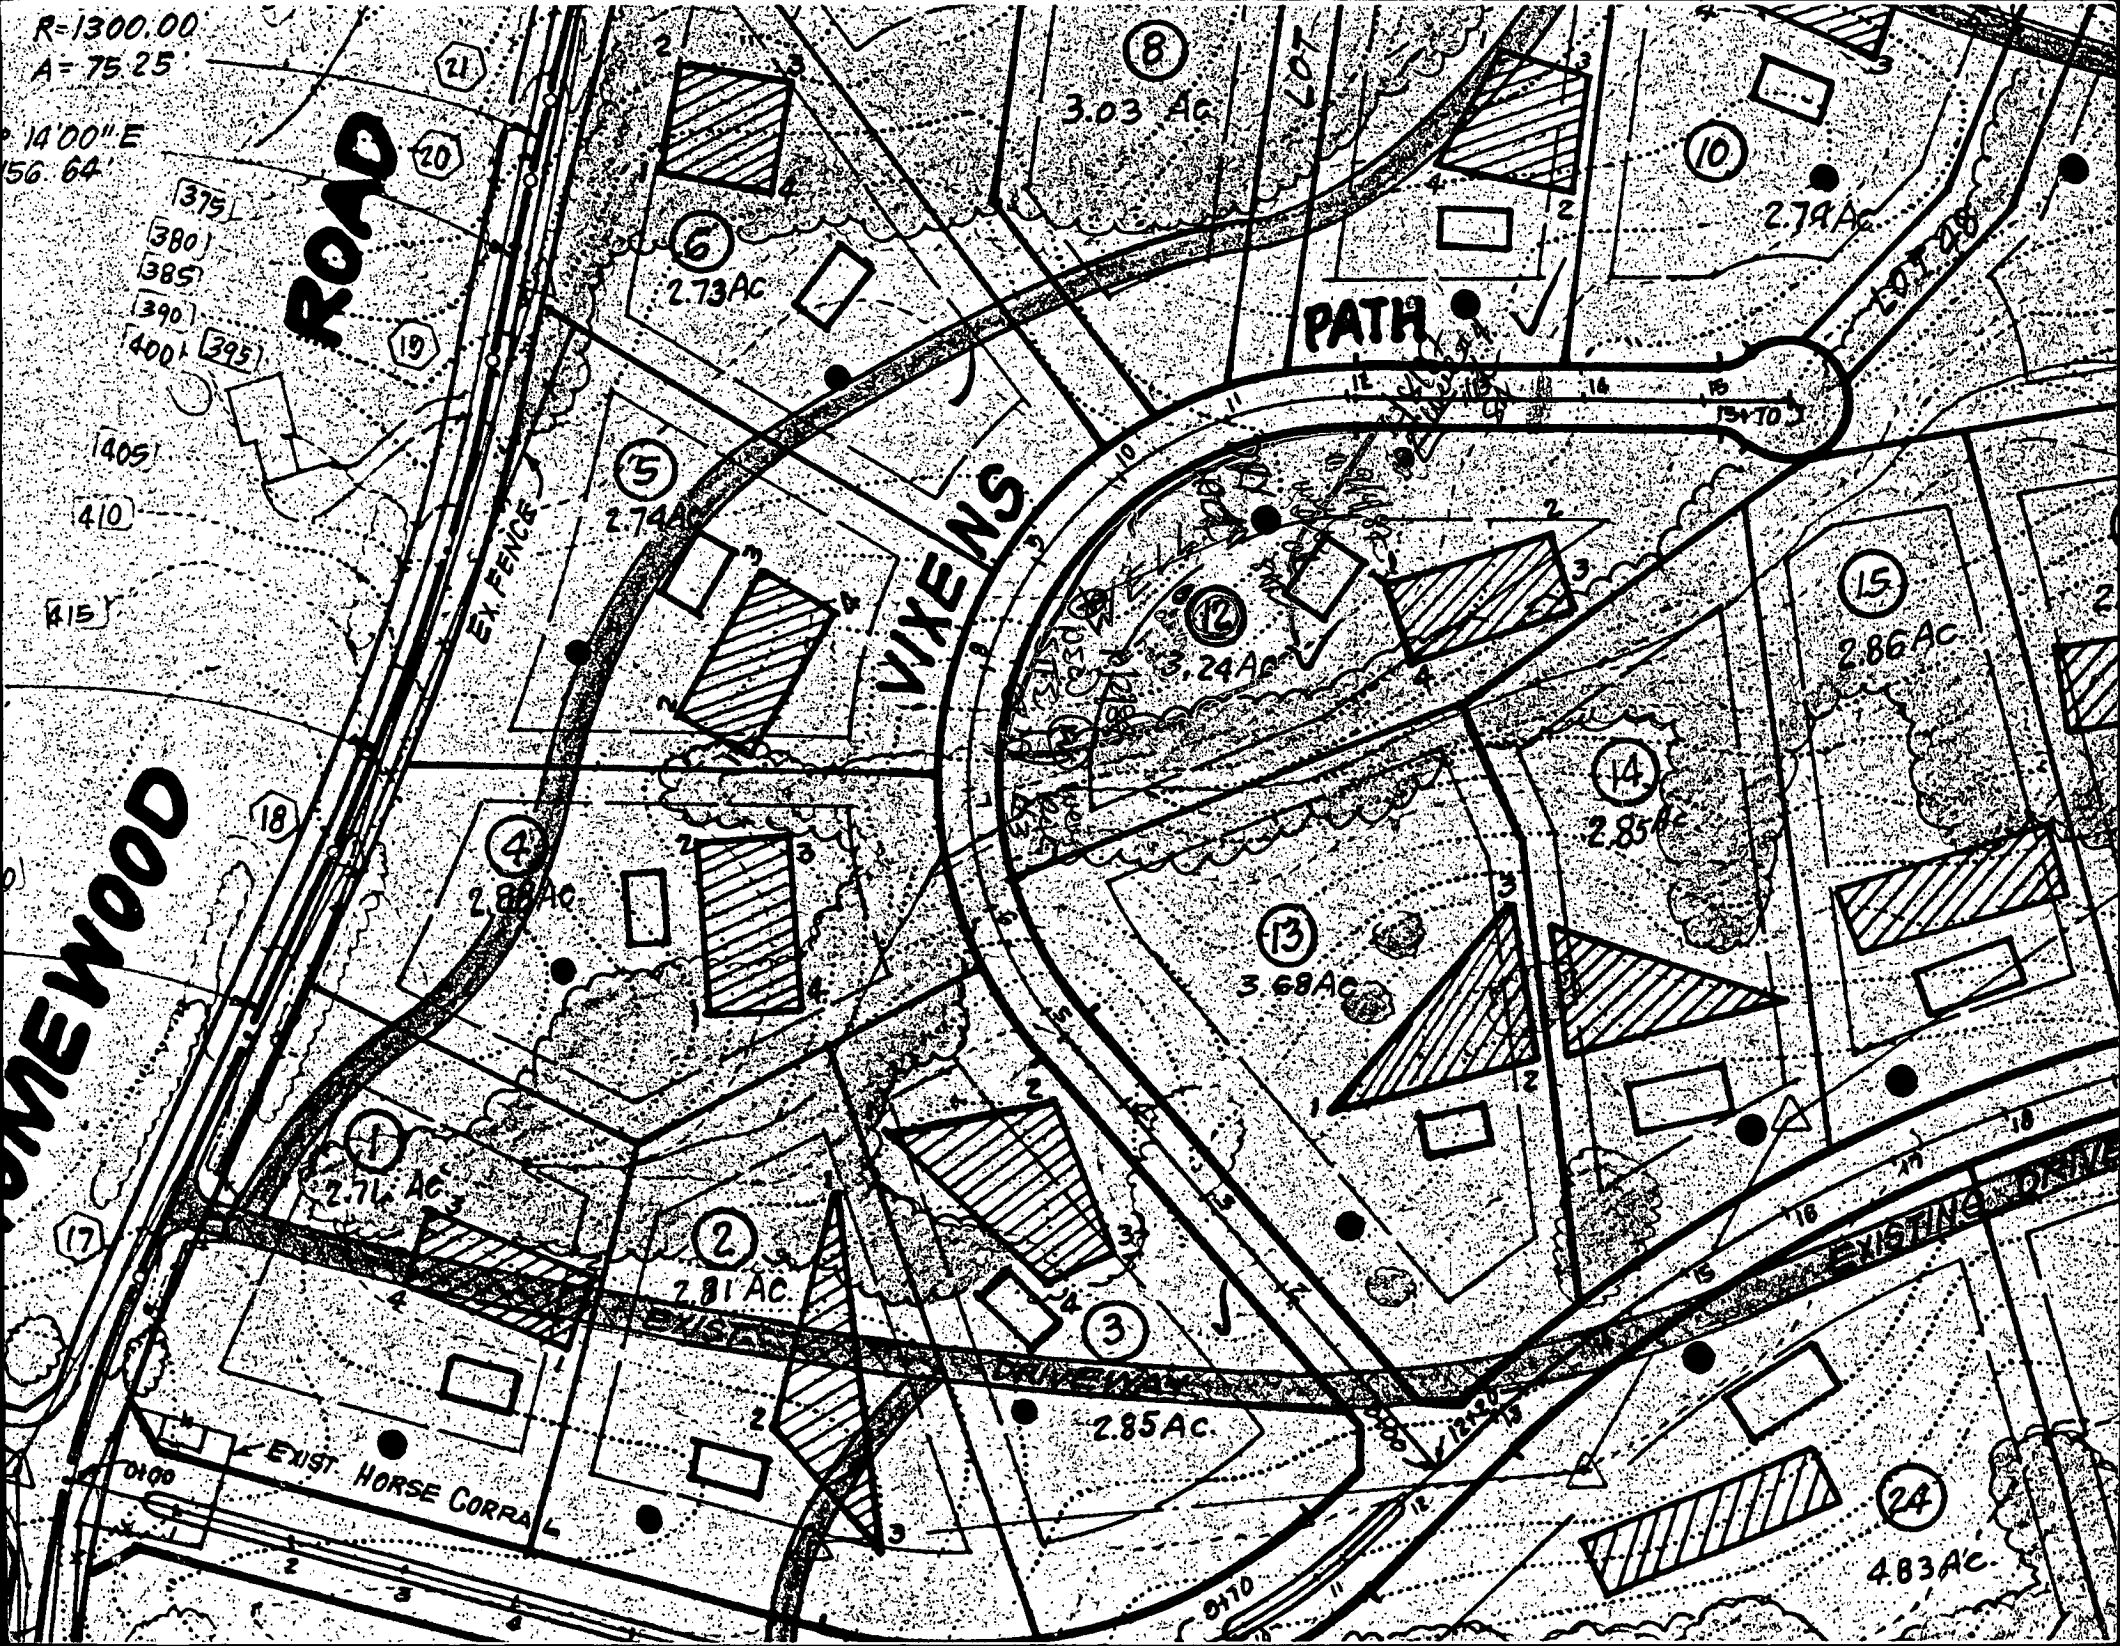

ANY GRADING IF REQUIRED OVER _____ HOURS TO BE PAID AT
THE RATE OF \$86.00 PER HOUR. GRADING TO BE ROUGH GRADING
ONLY.

CONSTRUCTION OFFICE HOURS
MON-FRI 9-5
(703) 451-9454

FLOOR SYSTEM	PLUMBING	SET BACKS
FLOOR HEADS 3	SKIMMER 2" 63 FT.	HOUSE 10 FT.
STEP HEADS 2	RETURNS 2" 23 FT.	SIDE 10 FT.
BENCH HEADS 1	RETURNS 1 1/2" 5 FT.	REAR 10 FT.
LOVE SEAT 1	AUTO CLR. 1 1/2" 37 FT.	STREET - FT.
SPA HEADS 1	SPA SUCT. 1" 20 FT.	SEPTIC 20 FT.
Heads may vary due to shape, size and depth.	SPA RET. 1" 1 FT.	WELL 20 FT.
	AIR LINE 1" 4 FT.	FENCE 5' MIN. FT.
	RET. 1" 4 FT.	PUB. WATER No
	Floor 2" 36 FT.	PUB. SEWER No

22

GENERAL SPECIFICATIONS *

SIZE 19' X 40' DEPTH 3' TO 8'6" PERIM. 107 FT.
SHAPE ARCHADIA AREA 650 SQ. FT.
COPING TYPE BROWN BRICK TILE
MOTOR H.P. 2 GPM FILTER 52 SQ. FT.
SKIMMER # 2 BACKWASH TO AREA

POOL EQUIPMENT *

HEATER MODEL PROPANE SIZE 380,000 BTU
TIME CLOCK TYPE STANDARD 1 DELAY 1
POOL CLEANING SYSTEM: POLARIS
SPA - SQ. FT. - AIR INJECTORS # - BLOWER -
SPA LIGHT # - VOLT - WATT
POOL LIGHT # 1 110 VOLT 300 WATT
BOARD MODEL FLYTE DECK SIZE 8 FT. TILE
LADDER MODEL - TILE LOVESEAT 6 FT.
CLEANING TOOLS YES VACUUM WITH 35 FT. HOSE
POOL BENCH 12 FT. ROPE RINGS & FLOATS YES

SITE CONDITIONS *

PRE SITE GRADING NR. DIRT WALK - FT.
DIRT MAUL - DIRT STAY YES
CONCRETE REMOVAL - SQ. FT.
STUMPS # - PUSH OVER ONLY - MAUL
TREES TO BE CUT BY: -

SPECIAL NOTES *

1) ANTI-HO - FLOW FLOOR RETURNS

PERMIT OFFICE HOWARD COUNTY
LOT 12 BLOCK SUB. DIV. THE CHASE
SALESMAN J. KAGEN MANAGER J. KAGEN
SALES OFFICE BALTIMORE PH. # 422-8301
CONSTRUCTION OFFICE PH. # 703-451-9454
JOB # CONTRACT DATE 7/31/90
CASH YES LOAN -


SWIMMING POOL

NAME HARVEY & EILEEN HORWITZ
ADDRESS 11620 VIVENS PATH
ELICOTT CITY, MD 21043

CROSS STREETS
RES. PHONE 997-3080 BUS. PHONE



ANTHONY POOLS

A Division of Anthony Industries, Inc.

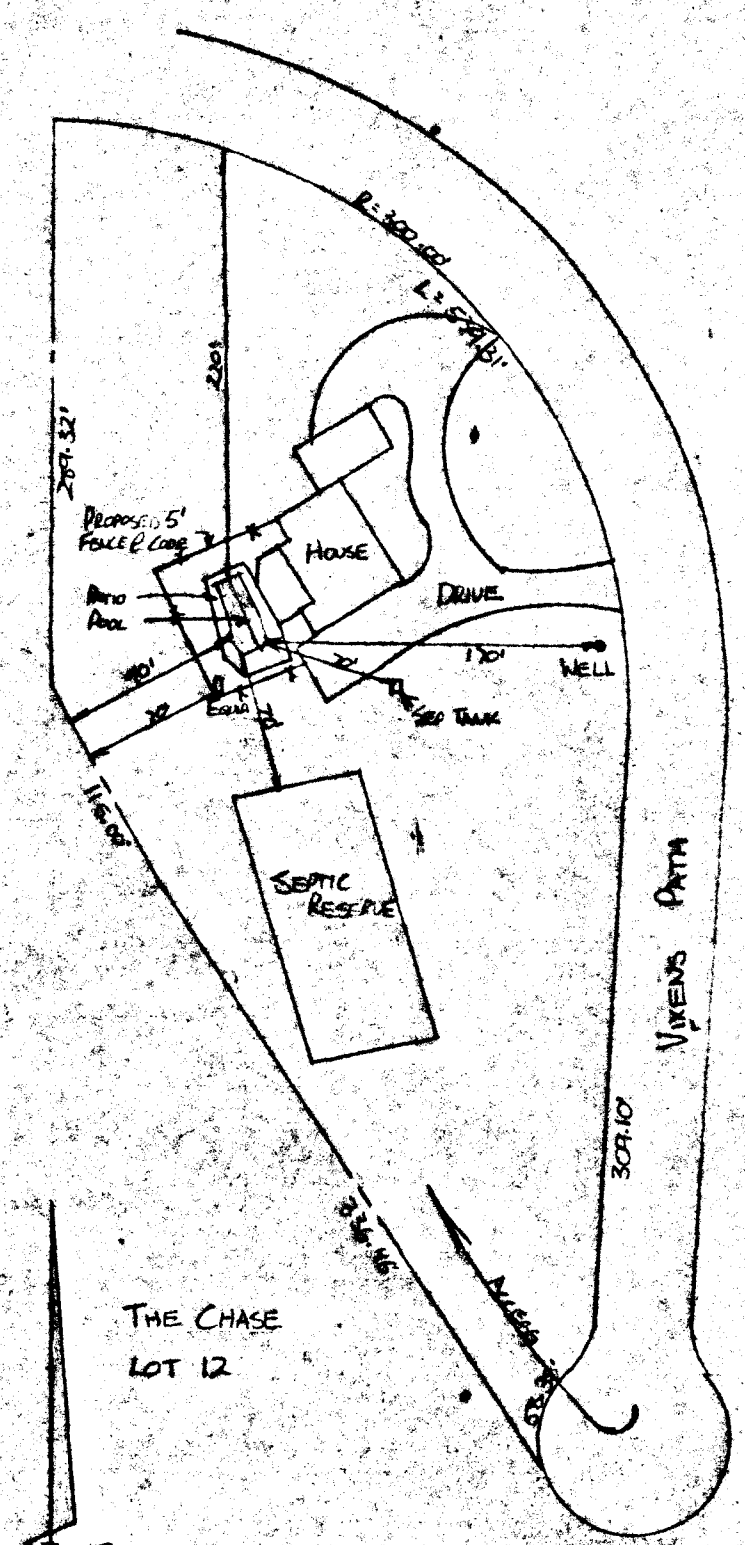


THE CHASE
LOT 12

SCALE 1"=100'

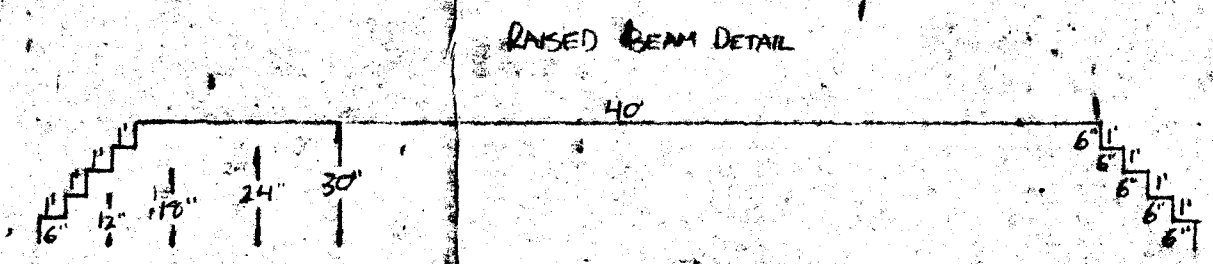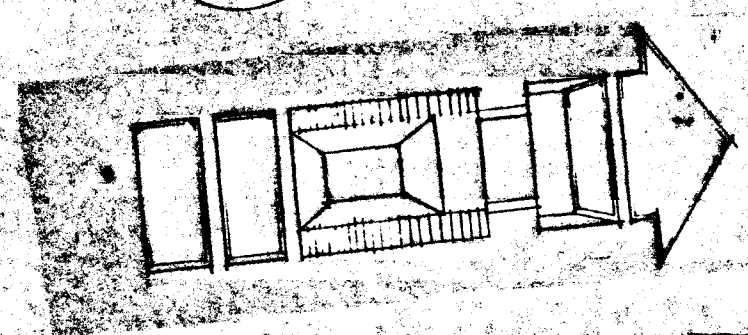

POOL & PLUMBING LAYOUT
SCALE: 1/8" = 1'-0"

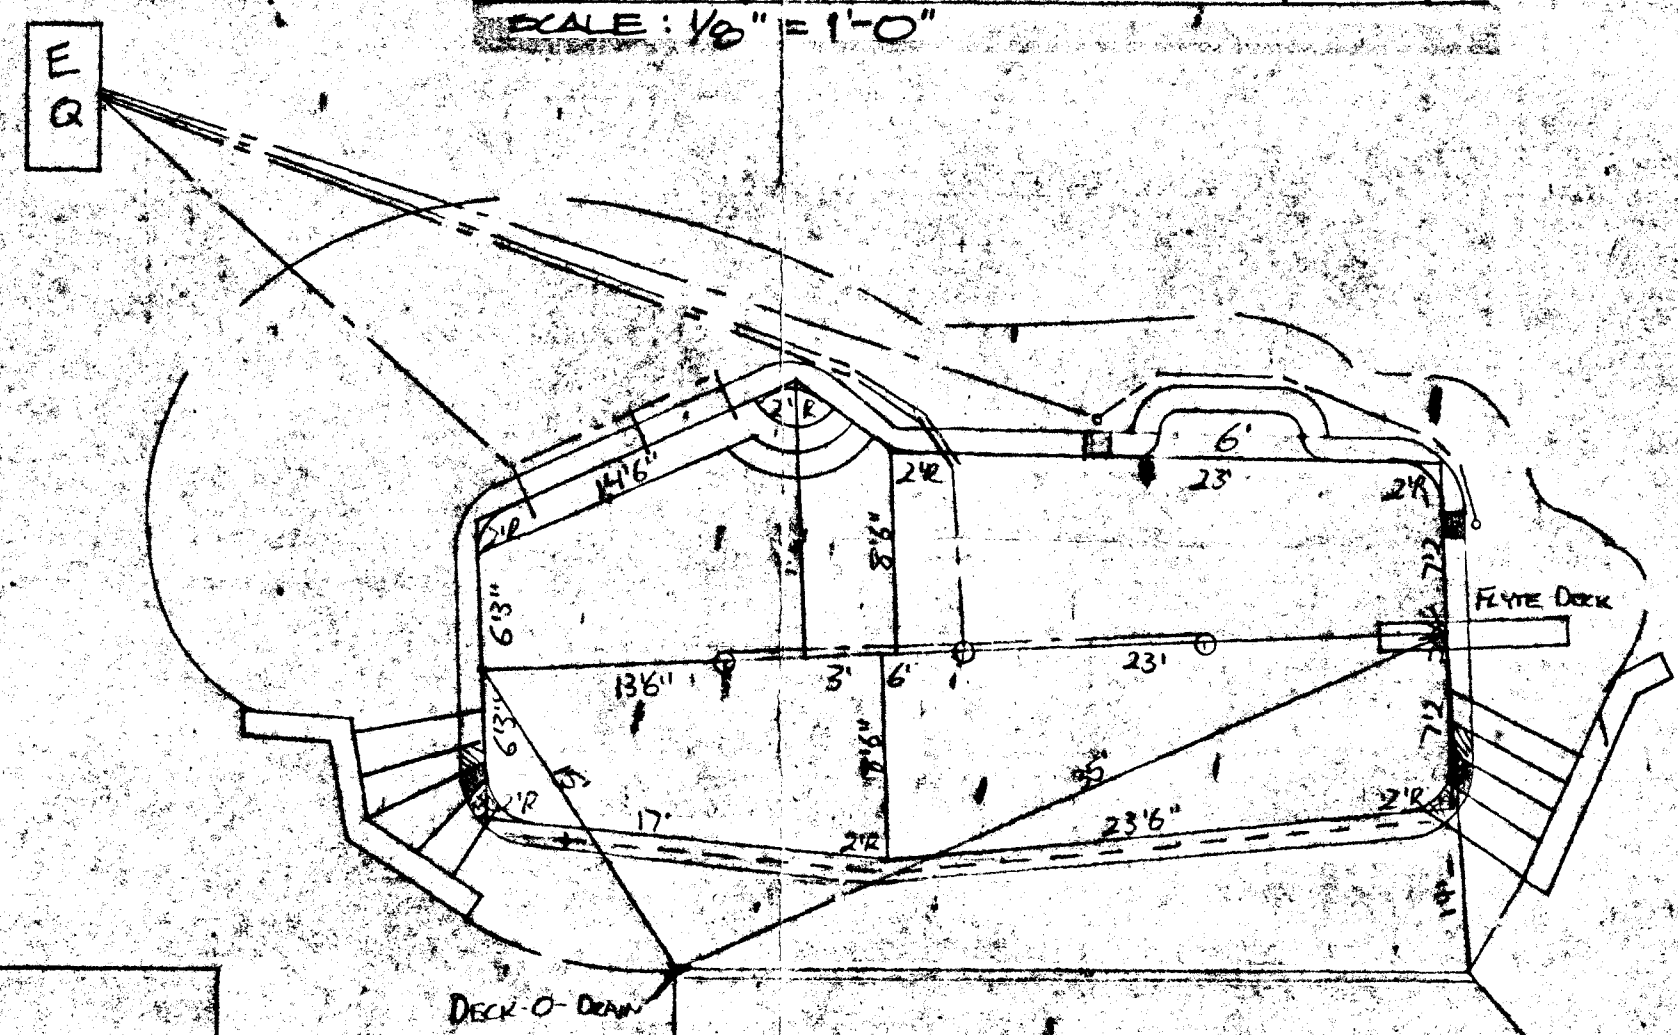

EXISTING DECK

8/7/90 PLANS OK
A. Hodges

BUYER:
TO DETERMINE APPROXIMATE ELEVATION
OF POOL ON DAY OF EXCAVATION.


BUYER:
POOL AREA TO BE FENCED, PER COUNTY
OR CITY ORDINANCE. GATES TO BE SELF
CLOSING AND SELF LATCHING.
BY BUYER

BUYER:
WET DOWN CONCRETE SHELL AT LEAST
TWICE DAILY FOR 7 DAYS.
DO NOT TURN ON POOL LIGHT WHEN
POOL IS EMPTY.

Buyer to Finalize Deck Size with Deck Contractor and
Understands Additional Footage Above Amount Quoted on
Appurtenance will be Charged at \$ Per Sq. Foot.

NOTE SCALE 1/8" = 1'-0"

29(W) TO RIE 108(W) TO
R) ON HOMEWOOD RD TO (L)
ON MISTERS RUN TO (L) ON
VIVENS PATH TO SITE ON (R)

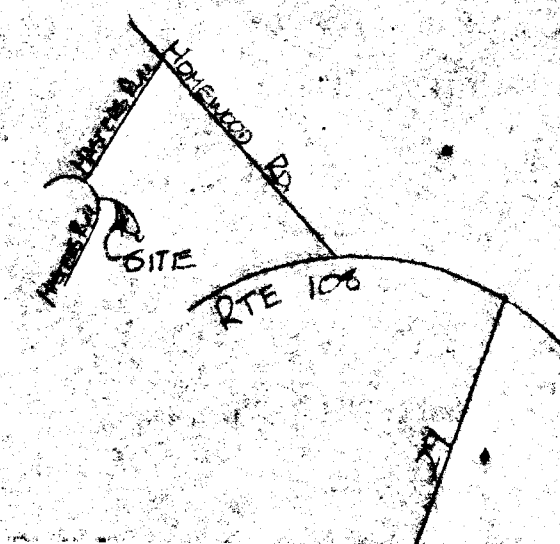



DEPARTMENT OF INSPECTIONS, LICENSES & PERMITS

J. Michael Evans, Director

CANCELLATION NOTICE

DATE: May 20, 2003

- (X) Department of Planning and Zoning
- (X) Bureau of Engineering
- (X) Health Department (Environmental)
- () Inspectors: (Building)
- () (Plumbing)
- () (Electrical)
- () (Fire)
- (X) Licenses & Permit Division: (Building)
- () (Plumbing)
- () Tax Assessment Office
- (X) Owner
- (X) Division of Plan Review
- () Construction Inspection Division
- (X) Other Architect - Stewart McCready

RE: Cancellation and/or Expired Permit/Application

Permit Number Building #B00133170

Date of Issue Not Issued

Owner Harvey Horowitz

Location 11620 Vixens Path, Ellicott City, MD 21043

Description of Work For 2 story addition.

Reason International Building Code, 2000 Edition - Suspensions of Permit


NOTE: Construction drawings will be held for ten (10) days at the Front Counter.
If they are not picked up by then, they will be destroyed.

FROM: *Ann Carl*

Chief, Licenses and Permit Division
Department of Inspections, Licenses and Permits
Phone Number (410) 313-2455

cancel/cwc

VIXENS PATH

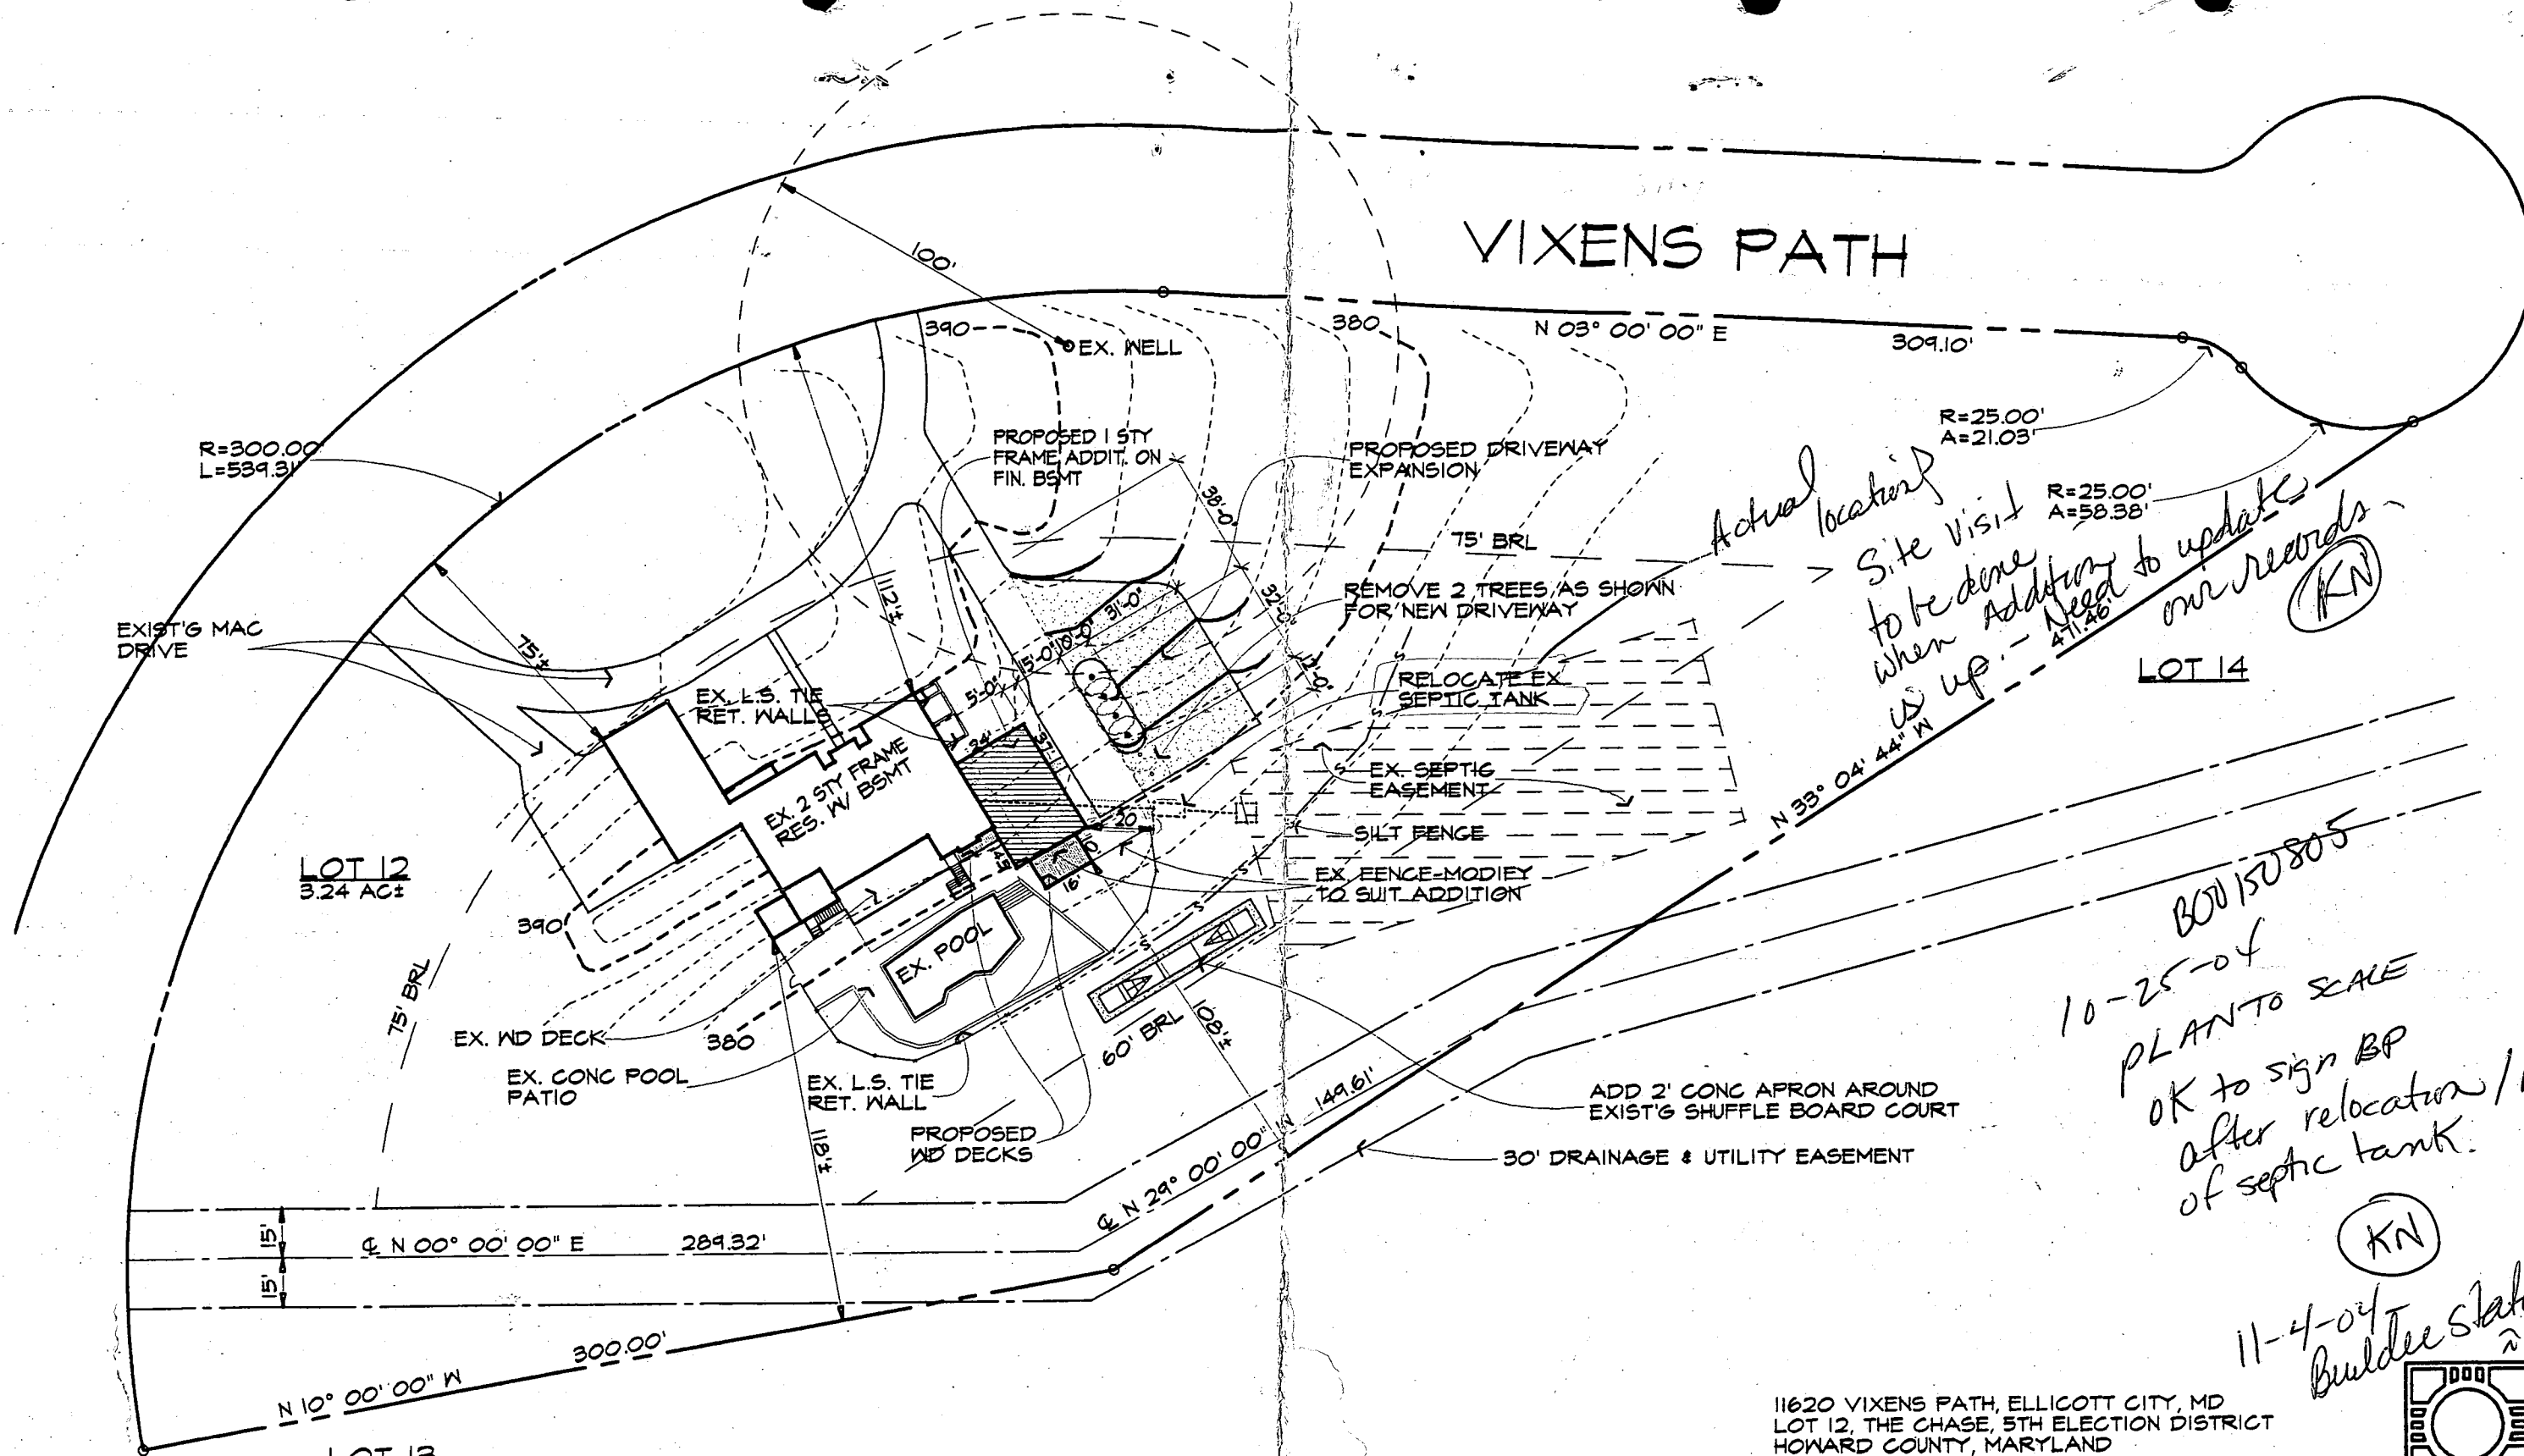


Actual locating
 > Site visit
 to be done
 when adding
 is up - Need to update
 our records - (KN)

10-25-04
 PLAN TO SCALE
 OK to sign BP
 after relocation / replacement
 of septic tank.
 (KN)

11-4-04
 Buldee States S.T.
 ~250' from
 House
 well
 calls
 for new
 version
 when
 address
 is on

11620 VIXENS PATH, ELlicOTT CITY, MD
 LOT 12, THE CHASE, 5TH ELECTION DISTRICT
 HOWARD COUNTY, MARYLAND

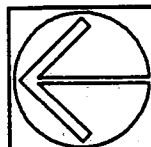

SITE PLAN

HOROWITZ RESIDENCE

1"=50'

17 OCT 01

