

9/23/85 9/25/85
anytime 11:10 AM
9/24/85 - final

approved
9/26/85
NIXON/WILLIAMS
P-36018
Repair

PERMIT

SEWAGE DISPOSAL SYSTEM

MARYLAND STATE DEPARTMENT OF HEALTH

HOWARD COUNTY
BUREAU OF ENVIRONMENTAL HEALTH
992-2330

04-311817
INDEXED


ELLICOTT CITY
DISTRICT 4
DATE 9/23/85

James Cogswell / HERMAN SIKK IS PERMITTED TO INSTALL _____ ALTER x
ADDRESS 16717 Route #144 PHONE 854-6928
SUBDIVISION Cogswell residence ROAD 16717 Route 144 LOT _____
PROPERTY OWNER James Cogswell
ADDRESS same

IF GARBAGE GRINDER IS USED INCREASE SEPTIC TANK CAPACITY BY 50% AND ABSORPTION AREA BY 22%.

GARBAGE GRINDER? YES _____ NO _____

SEPTIC TANK CAPACITY _____ GALLONS NUMBER OF BEDROOMS _____

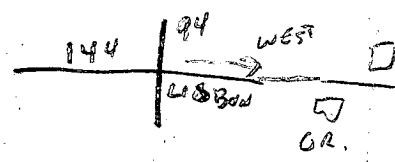

Call for inspection when ground is opened up so Sanitarian can
recommend repair.

PLANS APPROVED BY _____ DATE _____

COVER NO WORK UNTIL INSPECTED AND APPROVED.

NEITHER THE HOWARD COUNTY COUNCIL NOR THE HEALTH DEPARTMENT IS RESPONSIBLE FOR THE SUCCESSFUL OPERATION OF ANY SYSTEM.

NOTE: IF TRENCH IS USED CALL FOR INSPECTION BEFORE AND AFTER PLACING GRAVEL IN TRENCH.

NOTE: NO DRY WELL SHALL EXCEED 15 FOOT IN DIAMETER. NO ABSORPTION TRENCH TO EXCEED 100 FEET IN LENGTH.

NOTE: ALL PIPE FROM HOUSE TO SEPTIC TANK MUST BE CAST IRON OR SCHEDULE 40 PVC OR ABS.

PERMIT VOID AFTER THREE YEARS.


NOTE: INSTALL STAND PIPE ON SEPTIC TANK AND DRY WELL. STAND PIPES MUST BE 6 INCHES IN DIAMETER. CAST IRON, CONCRETE OR TERRA COTTA, OR PVC OR ABS ACCEPTED. IF TOP OF SEPTIC TANK IS DEEPER THAN 3 FEET MANHOLE TO-GRADE REQUIRED.

***INSTALLER IS RESPONSIBLE FOR OBTAINING FINAL APROVAL ON THIS PERMIT**

*CALL 992-2330 FOR INSPECTION OF SEPTIC SYSTEMS.

EH-2-1082

P-36018

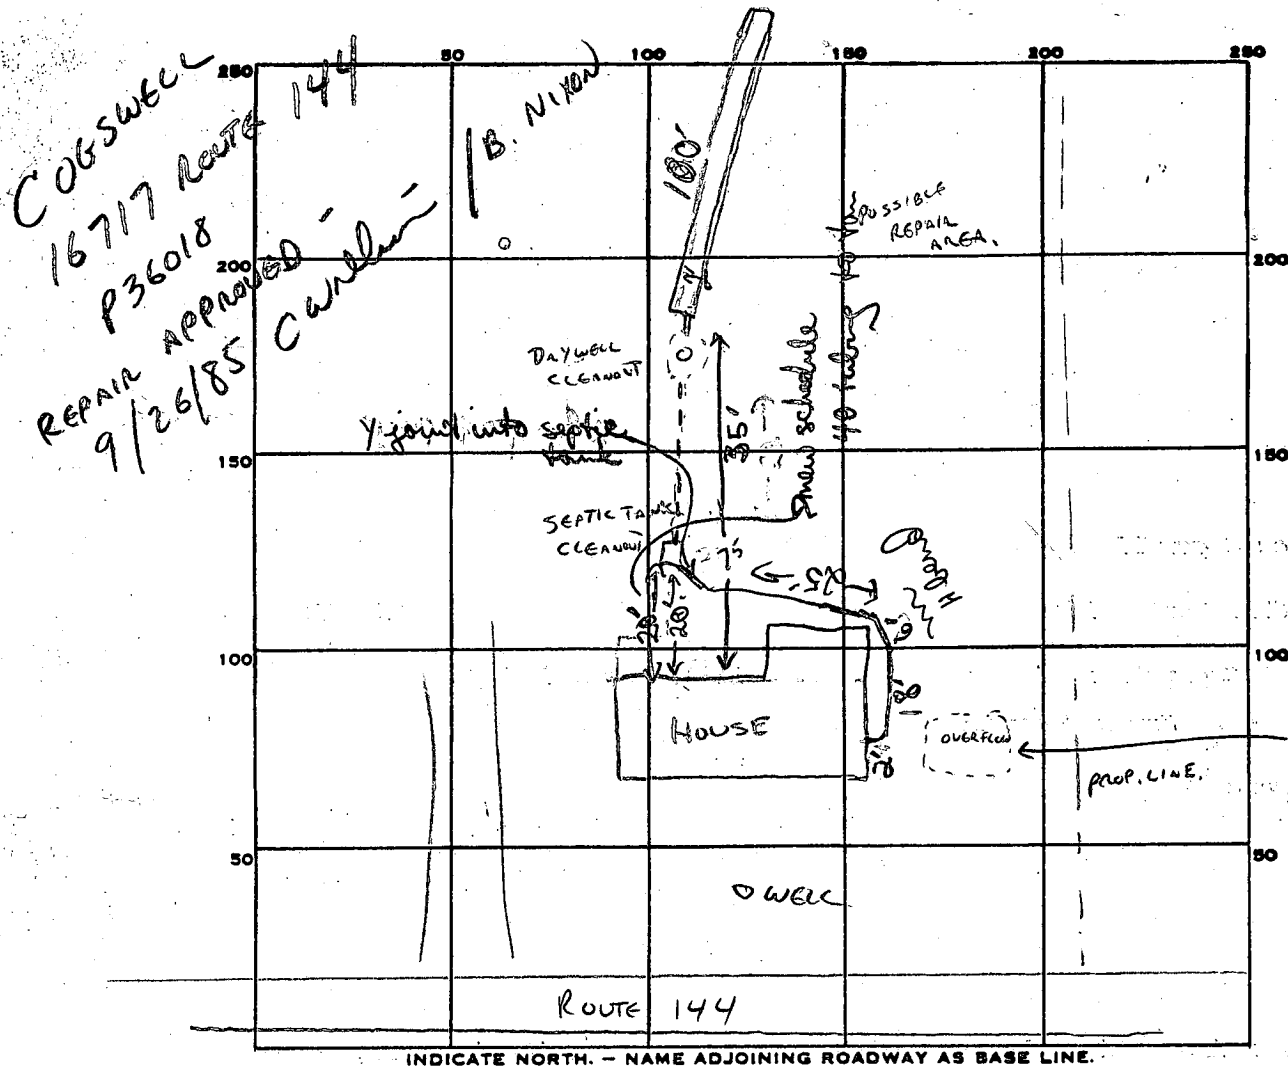

PERMIT CARD _____

SEPTIC TANK, LEVEL EXISTING

CLEANOUTS ST-EXISTING

DISTRIBUTION BOX, LEVEL N/A

TILE FIELD, DEPTH 1 1/2 FT. TRENCH WIDTH 2 FT.

GRAVEL DEPTH 6' IN. TOTAL LENGTH 100 FT.

NUMBER OF TRENCHES 1 ONE SIDEWALL- TOTAL BOTTOM AREA ~600

SEEPAGE PITS, INSIDE DIAMETER _____ FT. DEPTH BELOW INLET _____ FT.

ABSORBENT AREA 600 SQ. FT. + EXISTING.

REMARKS 9/23/85 INSPECTED SITE WITH OWNER. DISCUSSED RE-ROUTING WASH WATER DISCHARGE INTO SEPTIC TANK, AND LIKELIHOOD OF OVERLOADING DAYWELL. OWNER IS TO CONTACT NEWMAN SIRC TO ARRANGE FOR REPAIR, ASAP. Craig Wilson

9/25/85 VIS INSP - MICA-SAND SOIL - 90' TRENCH DUG

9/26/85 piping in place from house (for washer outlet); in place + hooked up to septic tank; piping + gravel in place in trench (ready to cover); installed new piping (20') from tank to house to replace old worn tubing (B).

9/26/85
DATE SYSTEM APPROVED

INSPECTOR

C. Wilson / Bert Nixon