

3-4-86  
9:30  
3/10/86  
Noni phone

APPROVED  
3/17/86  
P 36353  
RJ  
A REPAIR

# PERMIT

SEWAGE DISPOSAL SYSTEM

MARYLAND STATE DEPARTMENT OF HEALTH

HOWARD COUNTY  
BUREAU OF ENVIRONMENTAL HEALTH  
992-2330  
461-9933

ELLICOTT CITY  
DISTRICT \_\_\_\_\_

DATE 12/30/85

INDEXED

Ten Oaks Construction, Inc.

IS PERMITTED TO INSTALL \_\_\_\_\_ ALTER ☒

ADDRESS 7604 Wigley Avenue, Jessup, Maryland 20794

PHONE \_\_\_\_\_

SUBDIVISION \_\_\_\_\_ ROAD 1830 Woodstock Road LOT \_\_\_\_\_

PROPERTY OWNER Bracciale

1830 Woodstock Road

ADDRESS \_\_\_\_\_

IF GARBAGE GRINDER IS USED INCREASE SEPTIC TANK CAPACITY BY 50% AND ABSORPTION AREA BY 22%.

GARBAGE GRINDER? YES \_\_\_\_\_ NO ☒

SEPTIC TANK CAPACITY 1350 GALLONS

NUMBER OF BEDROOMS 4

REPAIR - CALL FOR INSPECTION WHEN GROUND IS OPENED UP SO SANITARIAN CAN RECOMMEND

REPAIR. 3/4/86 - TRENCH 133 FT LONG, 6 FT DEEP  
2 FT WIDE 4 FT STONE INLET 2 FT BELOW ORIGINAL  
GRADE PLACE THE TRENCH BETWEEN PERC  
HOLES ① & ②. LOCATED IN FRONT OF THE HOUSE KEEP  
THE TANK & TRENCHES AT LEAST 40 FT FROM  
THE FRONT OF THE HOUSE SO THAT THEY WILL NOT  
BE TOO CLOSE TO THE WELL RH

PLANS APPROVED BY C. Williams

DATE 12/30/85

COVER NO WORK UNTIL INSPECTED AND APPROVED.

150 SQ FT PER BED ROOM

NEITHER THE HOWARD COUNTY COUNCIL NOR THE HEALTH DEPARTMENT IS RESPONSIBLE FOR THE SUCCESSFUL OPERATION OF ANY SYSTEM.

NOTE: IF TRENCH IS USED CALL FOR INSPECTION BEFORE AND AFTER PLACING GRAVEL IN TRENCH.

NOTE: NO DRY WELL SHALL EXCEED 15 FOOT IN DIAMETER. NO ABSORPTION TRENCH TO EXCEED 100 FEET IN LENGTH.

NOTE: ALL PIPE FROM HOUSE TO SEPTIC TANK MUST BE CAST IRON OR SCHEDULE 40 PVC OR ABS.

PERMIT VOID AFTER THREE YEARS.

NOTE: INSTALL STAND PIPE ON SEPTIC TANK AND DRY WELL. STAND PIPES MUST BE 6 INCHES IN DIAMETER. CAST IRON, CONCRETE OR TERRA COTTA, OR  
PVC OR ABS ACCEPTED. IF TOP OF SEPTIC TANK IS DEEPER THAN 3 FEET MANHOLE TO GRADE REQUIRED.

BOB. PERMIT SIGNED

AND RETURNED 3/6/86

Serial # 18155


Jim

\*INSTALLER IS RESPONSIBLE FOR OBTAINING FINAL APPROVAL ON THIS PERMIT

CALL 992-2330 FOR INSPECTION OF SEPTIC SYSTEMS.

EH - 2-1082

36353  
A REPAIR

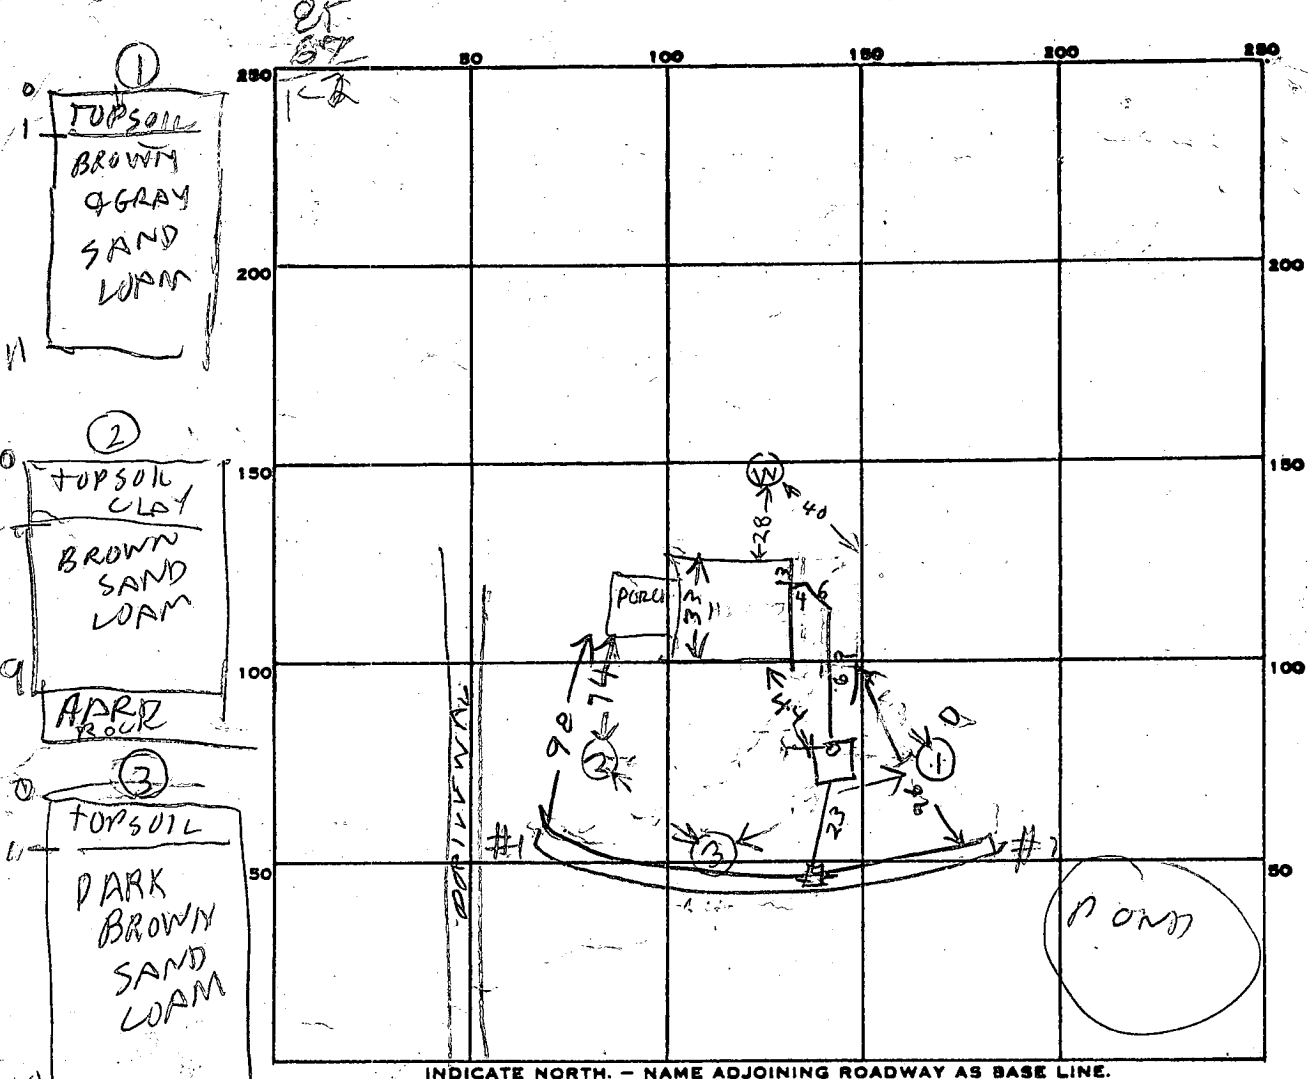

PERMIT CARD \_\_\_\_\_

SEPTIC TANK, LEVEL 1500 CLEANOUTS 3/10/86 OK 3/17/86

DISTRIBUTION BOX, LEVEL \_\_\_\_\_

TILE FIELD, DEPTH 5.5/5.5 FT. TRENCH WIDTH 2/2 FT.

GRAVEL DEPTH 4 IN. TOTAL LENGTH 67/88 FT. 152

NUMBER OF TRENCHES 2 TOTAL BOTTOM AREA 608 Both Trenches 152

SEEPAGE PITS, INSIDE DIAMETER \_\_\_\_\_ FT. DEPTH BELOW INLET \_\_\_\_\_ FT.

ABSORBENT AREA \_\_\_\_\_ SQ. FT.

REMARKS 3/4/86 - SOIL OK SEE OTHER SIDE FOR SPEC.

3/10/86 - TRENCH DUG. TANK SET. FINISH JOB & CALL RH

3/17/86 - NEED 532 SQ FT SIDEWALL AREA ONE SIDE

INSTALLED 608 SQ FT

DATE SYSTEM APPROVED 3/17/86 INSPECTOR Raymond Hodge

