

Tax ID 05 371589

APPROVED
22 DEC 85
R HOPES
P 36396

PERMIT

SEWAGE DISPOSAL SYSTEM

MARYLAND STATE DEPARTMENT OF HEALTH

A REPAIR

HOWARD COUNTY

BUREAU OF ENVIRONMENTAL HEALTH

XXXXXX

461-9933

ELLICOTT CITY

DISTRICT

DATE

INDEXED

360012

1/3/86

Jack Fyock

IS PERMITTED TO INSTALL ☒ ALTER

ADDRESS

PHONE 988-9270

SUBDIVISION

ROAD 4952 Ten Oaks Road

LOT

PROPERTY OWNER

Mr. & Mrs. Wellington

1st DRIVEWAY BEFORE

ADDRESS

Morning Star Drive

3 BR

IF GARBAGE GRINDER IS USED INCREASE SEPTIC TANK CAPACITY BY 50% AND ABSORPTION AREA BY 22%.

GARBAGE GRINDER?

YES

NO

SEPTIC TANK CAPACITY

GALLONS

NUMBER OF BEDROOMS

3

REPAIR - CALL FOR INSPECTION WHEN GROUND IS OPENED UP SO SANITARIAN CAN RECOMMEND

REPAIR.

12/20/85 TRENCH 3 FT - OLD

DRY WELL RUNNING TOWARD THE FRONT
LOT LINE - INSET OF TRENCH TO BE 4 FT
BOG. BOTTOM OF TRENCH TO BE 12 FT BELOW
ORIGINAL GRADE 8 FT OF STONE 375
SQ FT ONE SIDE WALL AREA NEEDED
KEEP TRENCH AT LEAST 75 FT FROM THE WELL

PLANS APPROVED BY

C. Williams

DATE

12/23/85

RH

COVER NO WORK UNTIL INSPECTED AND APPROVED.

NEITHER THE HOWARD COUNTY COUNCIL NOR THE HEALTH DEPARTMENT IS RESPONSIBLE FOR THE SUCCESSFUL OPERATION OF ANY SYSTEM.

NOTE: IF TRENCH IS USED CALL FOR INSPECTION BEFORE AND AFTER PLACING GRAVEL IN TRENCH.

NOTE: NO DRY WELL SHALL EXCEED 15 FOOT IN DIAMETER. NO ABSORPTION TRENCH TO EXCEED 100 FEET IN LENGTH.

NOTE: ALL PIPE FROM HOUSE TO SEPTIC TANK MUST BE CAST IRON OR SCHEDULE 40 PVC OR ABS.

PERMIT VOID AFTER THREE YEARS.


NOTE: INSTALL STAND PIPE ON SEPTIC TANK AND DRY WELL. STAND PIPES MUST BE 6 INCHES IN DIAMETER. CAST IRON, CONCRETE OR TERRA COTTA, OR
PVC OR ABS ACCEPTED. IF TOP OF SEPTIC TANK IS DEEPER THAN 3 FEET MANHOLE TO GRADE REQUIRED.

*INSTALLER IS RESPONSIBLE FOR OBTAINING FINAL APPROVAL ON THIS PERMIT

CALL 992-2330 FOR INSPECTION OF SEPTIC SYSTEMS.

EH - 2-1082

R 36396

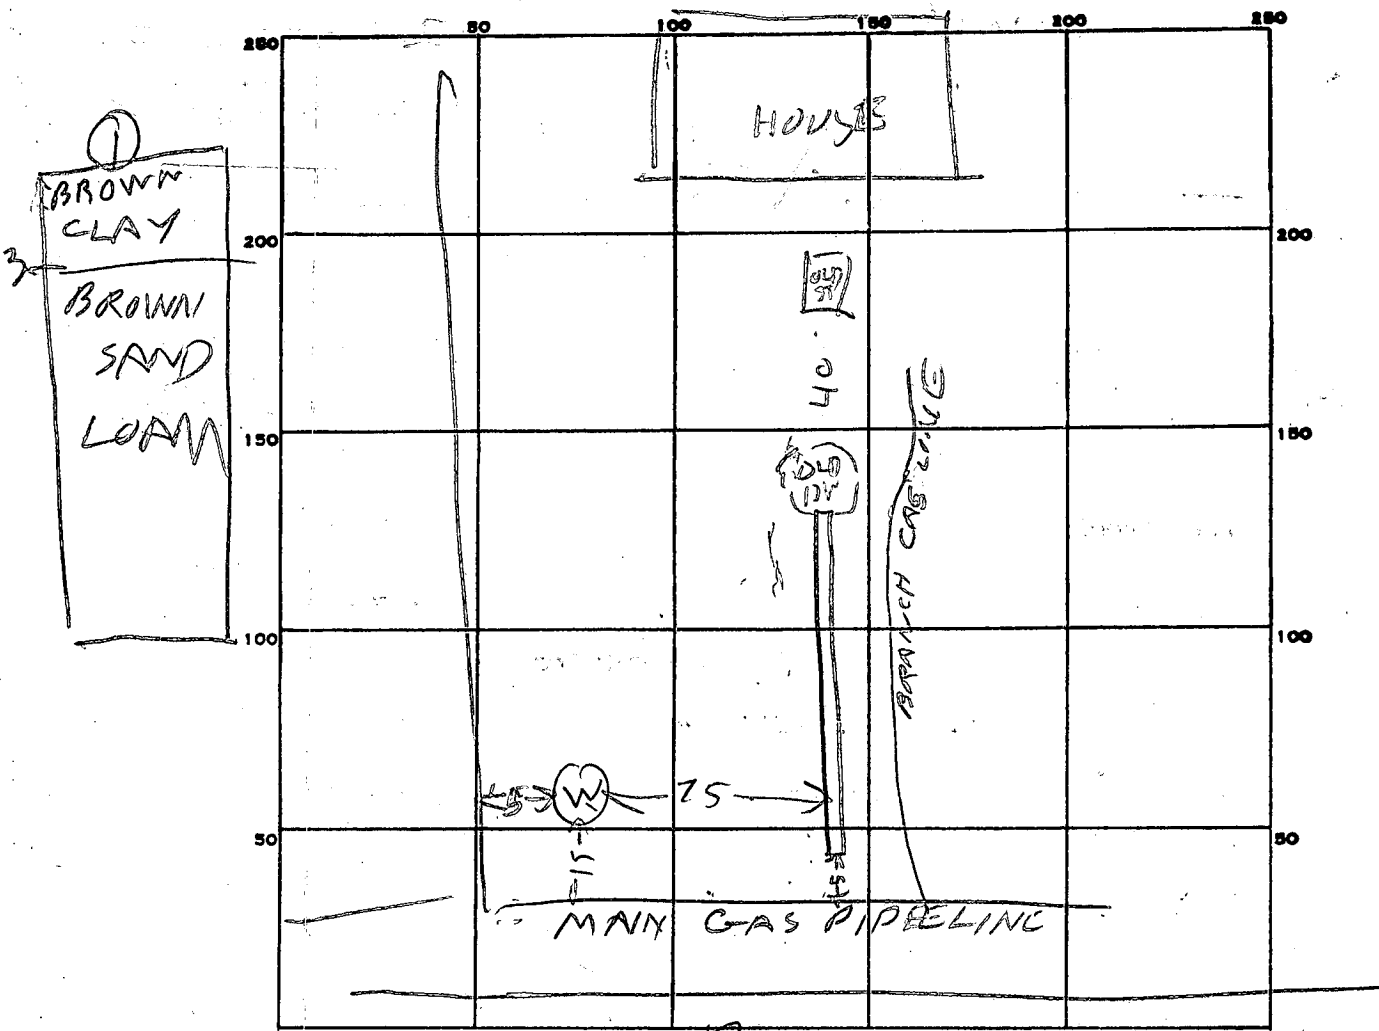

TEN ONK BOND

PERMIT CARD 0

SEPTIC TANK, LEVEL _____ CLEANOUTS _____

DISTRIBUTION BOX, LEVEL _____

TILE FIELD, DEPTH 12 FT. TRENCH WIDTH 2 FT.

GRAVEL DEPTH 8 FT IN. TOTAL LENGTH 65 FT.

NUMBER OF TRENCHES 1 TOTAL BOTTOM AREA 520

SEEPAGE PITS, INSIDE DIAMETER _____ FT. DEPTH BELOW INLET _____ FT.

ABSORBENT AREA _____ SQ. FT.

REMARKS 12/20/85 10:30 AM TRENCH OK ADD

REST OF STONE, 1200

12/20/85 - REST OF STONE PIPE & PAPER
ADDED

OLD DRY WELL IN USE FOR 13 YEARS

DATE SYSTEM APPROVED 12/20/85 INSPECTOR Raymond Hodges