

5-1-86
Repair
9:30

approved
5/2/86
Cullinan

PERMIT

P 3678
A Repair

SEWAGE DISPOSAL SYSTEM

MARYLAND STATE DEPARTMENT OF HEALTH

HOWARD COUNTY
BUREAU OF ENVIRONMENTAL HEALTH
~~984-2330~~
461-9933

03-285-294
INDEXED

ELLICOTT CITY
DISTRICT 3rd
DATE 4/11/86

Pat Lendrim

IS PERMITTED TO INSTALL _____ ALTER X

ADDRESS 14010 Forsythe Road, Sykesville, Md. PHONE 442-2416

SUBDIVISION _____ ROAD 525 199 Route 32 LOT _____

PROPERTY OWNER James Measmer

ADDRESS 525 Route 32, Sykesville, Maryland 21784 Phone: 795-2445 tax map 4, parcel 47

IF GARBAGE GRINDER IS USED INCREASE SEPTIC TANK CAPACITY BY 50% AND ABSORPTION AREA BY 22%.

GARBAGE GRINDER? YES _____ NO _____

SEPTIC TANK CAPACITY _____ GALLONS NUMBER OF BEDROOMS _____

REPAIR - Call for inspection of observation holes.

5-1-86 - SHALLOW SYSTEM- INLET 4'-5' below GRADE; BOTTOM S.S-
6.5' below GRADE; 12"-18" STONE below PIPE; NEED MINIMUM 88 FE
TRENCH 5' WIDE; RUN TRENCH FROM BEHIND SPRING HOUSE (R) TOWARD
HOLE #1 between LARGE TREES. IF UNABLE TO MEET MAX INLET DEPTHS
will require PUMP SYSTEM. S. Add

SPRING NEAR TANK NOT CONNECTED TO ANY WATER SUPPLY. YARD CONTAINS
SEVERAL SPRINGS. C.W.

PLANS APPROVED BY Frank A. Skinner DATE 4/11/86

COVER NO WORK UNTIL INSPECTED AND APPROVED.

NEITHER THE HOWARD COUNTY COUNCIL NOR THE HEALTH DEPARTMENT IS RESPONSIBLE FOR THE SUCCESSFUL OPERATION OF ANY SYSTEM.

NOTE: IF TRENCH IS USED CALL FOR INSPECTION BEFORE AND AFTER PLACING GRAVEL IN TRENCH.

NOTE: NO DRY WELL SHALL EXCEED 15 FOOT IN DIAMETER. NO ABSORPTION TRENCH TO EXCEED 100 FEET IN LENGTH.

NOTE: ALL PIPE FROM HOUSE TO SEPTIC TANK MUST BE CAST IRON OR SCHEDULE 40 PVC OR ABS.

PERMIT VOID AFTER THREE YEARS.


NOTE: INSTALL STAND PIPE ON SEPTIC TANK AND DRY WELL. STAND PIPES MUST BE 6 INCHES IN DIAMETER. CAST IRON, CONCRETE OR TERRA COTTA. OR
PVC OR ABS ACCEPTED. IF TOP OF SEPTIC TANK IS DEEPER THAN 3 FEET MANHOLE TO GRADE REQUIRED

BLDG. PERMIT SIGNED
AND RETURNED 4/12/86
Seal #37077
Gauger Family m
4115103 B00141113 BARN

*INSTALLER IS RESPONSIBLE FOR OBTAINING FINAL APROVAL ON THIS PERMIT

CALL ~~984-2330~~ FOR INSPECTION OF SEPTIC SYSTEMS.

36788
REPAIR

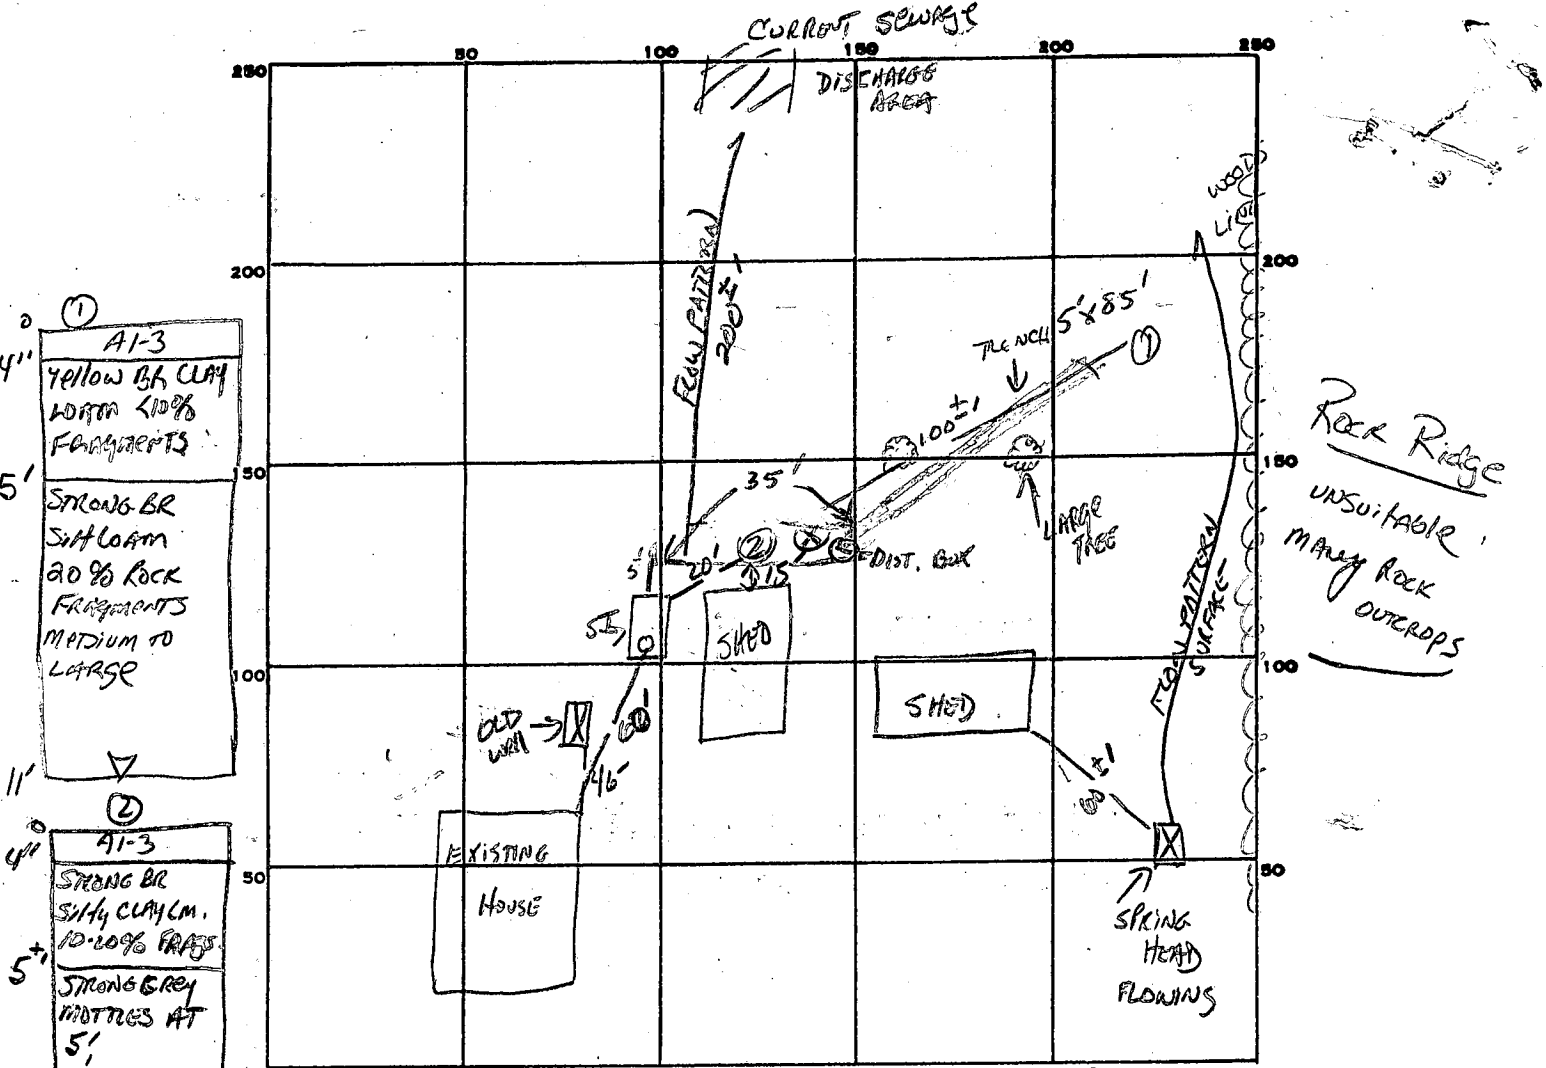

INDICATE NORTH. - NAME ADJOINING ROADWAY AS BASE LINE.

Rt 32

3BR / 1 OCCUPANT

PERMIT CARD

SEPTIC TANK, LEVEL

CLEANOUTS

DISTRIBUTION BOX, LEVEL

TILE FIELD, DEPTH 5 FT. TRENCH WIDTH 5 FT.

GRAVEL DEPTH 1 1/2 FT. IN. TOTAL LENGTH 85 FT.

NUMBER OF TRENCHES 1 TOTAL BOTTOM AREA 425

SEEPAGE PITS, INSIDE DIAMETER FT. DEPTH BELOW INLET FT.

ABSORBENT AREA 425 SQ. FT.

REMARKS NO EXISTING SYSTEM - STRAIGHT PIPE DISCHARGE TO REAR OF PROPERTY, CW

	START	STOP	START	STOP	TIME	
#1	5'	9:58	10:12	10:40	28 min	WATER AT 11"

5/2/86 TANK CONNECTED

DATE SYSTEM APPROVED

INSPECTOR

SHED CLOSEST 4-11-03
TO SEPTIC TANK
IS NOW GONE,
SAYS Mr. Measmer.
THE SITED CLOSEST
TO SPRING still
exists
KN

October 25, 1996

Mr. Christopher Hayes
2555 Sand Hill Road
Marriottsville, MD 21104

RE: Water Sample Results

Dear Mr. Hayes:

Enclosed are the results of the most recent volatile organic compound (VOC) sample analysis of your well water supply. Testing was performed on October 18, 1996.

The VOC sample submitted to CT&E Environmental Services, Inc. was free of all tested compounds to the limit of detection for the test method employed. With respect to these compounds, your well water supply remains safe for all uses.

If questions arise, contact Bert Nixon or myself at (410) 313-2644.

Sincerely,

Dave Schroeder, Sanitarian
Community Env. Health Program

DS/vf

Enclosure

cc: Evelyn Tomlin, Waste Management

SYKESVILLE

CARROLL COUNTY

STATE OF MARYLAND
277.90A. - W/R
HUGO THOMAS WILDLIFE FARM
P. 1


REGINA M. GARRATT
407/645
61.47 A.
P. 45


STATE OF MARYLAND
DEPT. OF FORESTS & PARKS
315/446
123/49
121.74 A.
P. 27

JAMES
FROTHINGHAM
776 /
1588
60

MAP 9 - P.36

MAP 9 - P.94

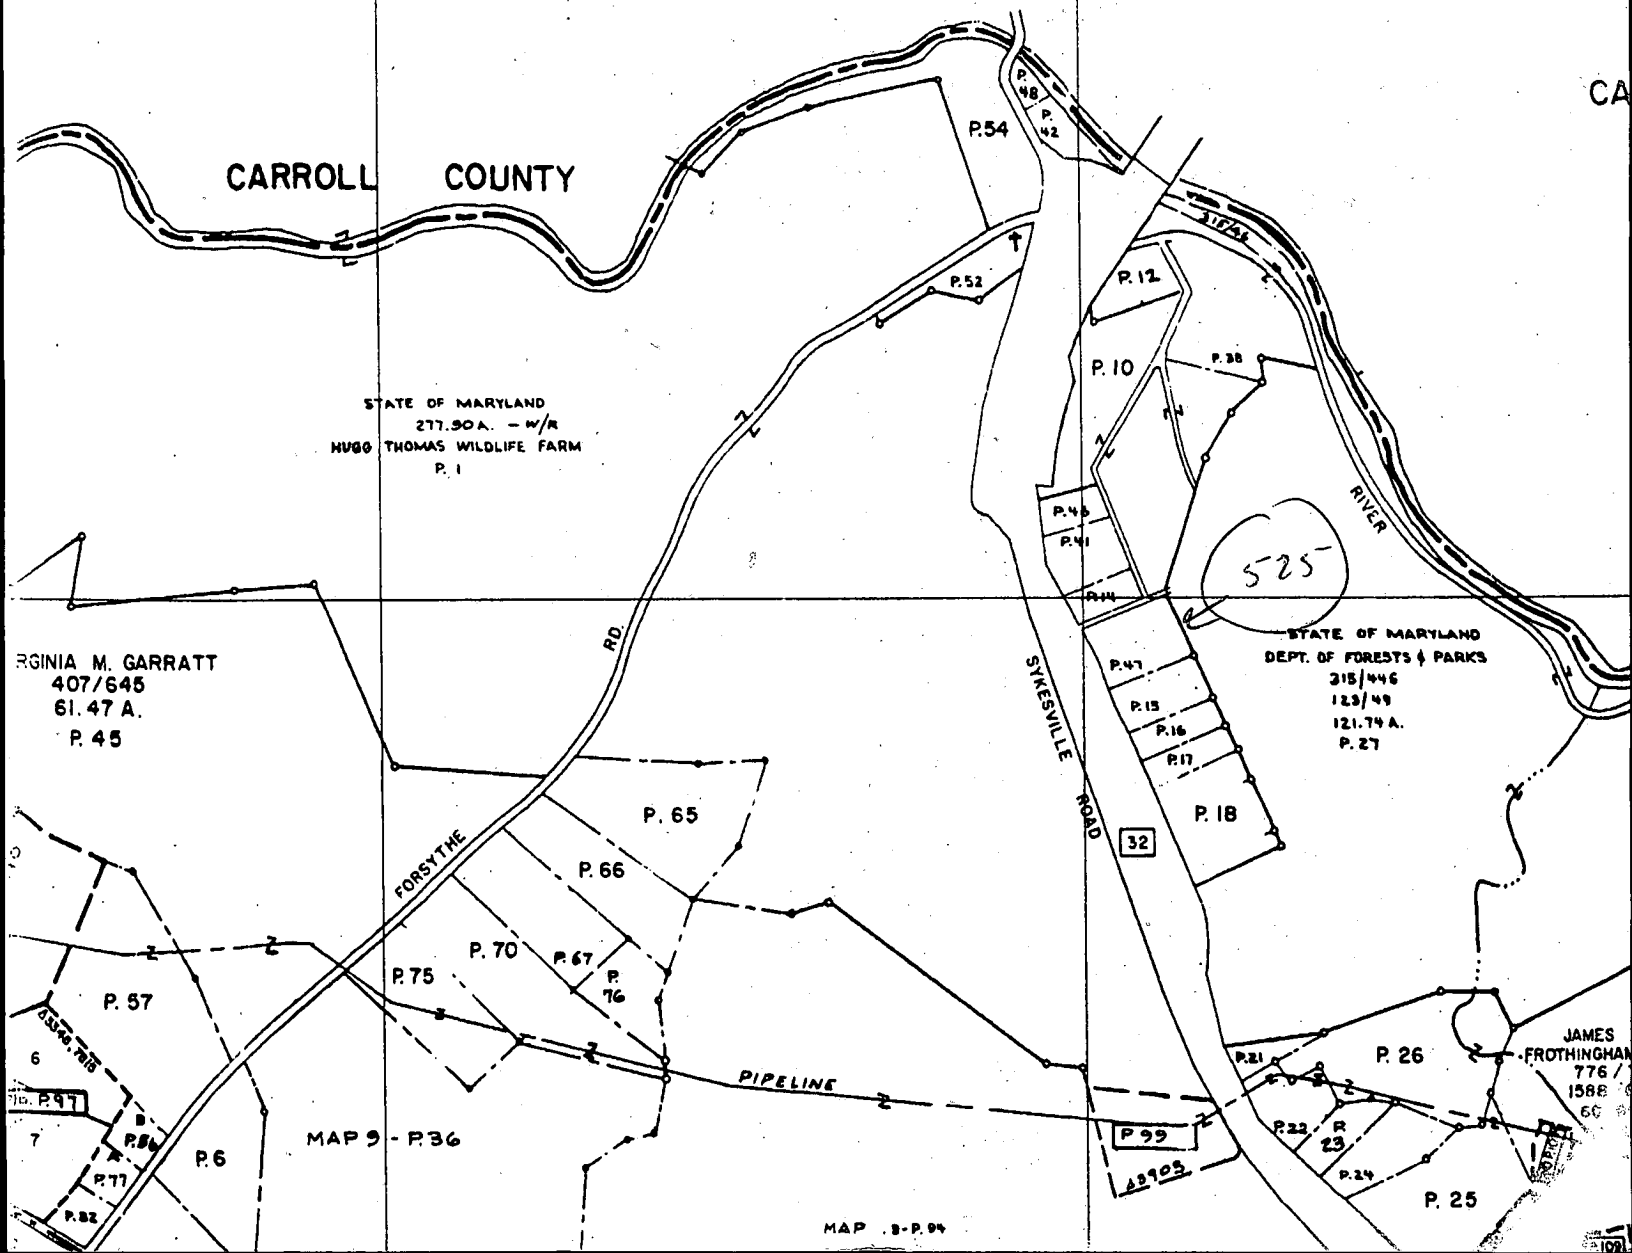

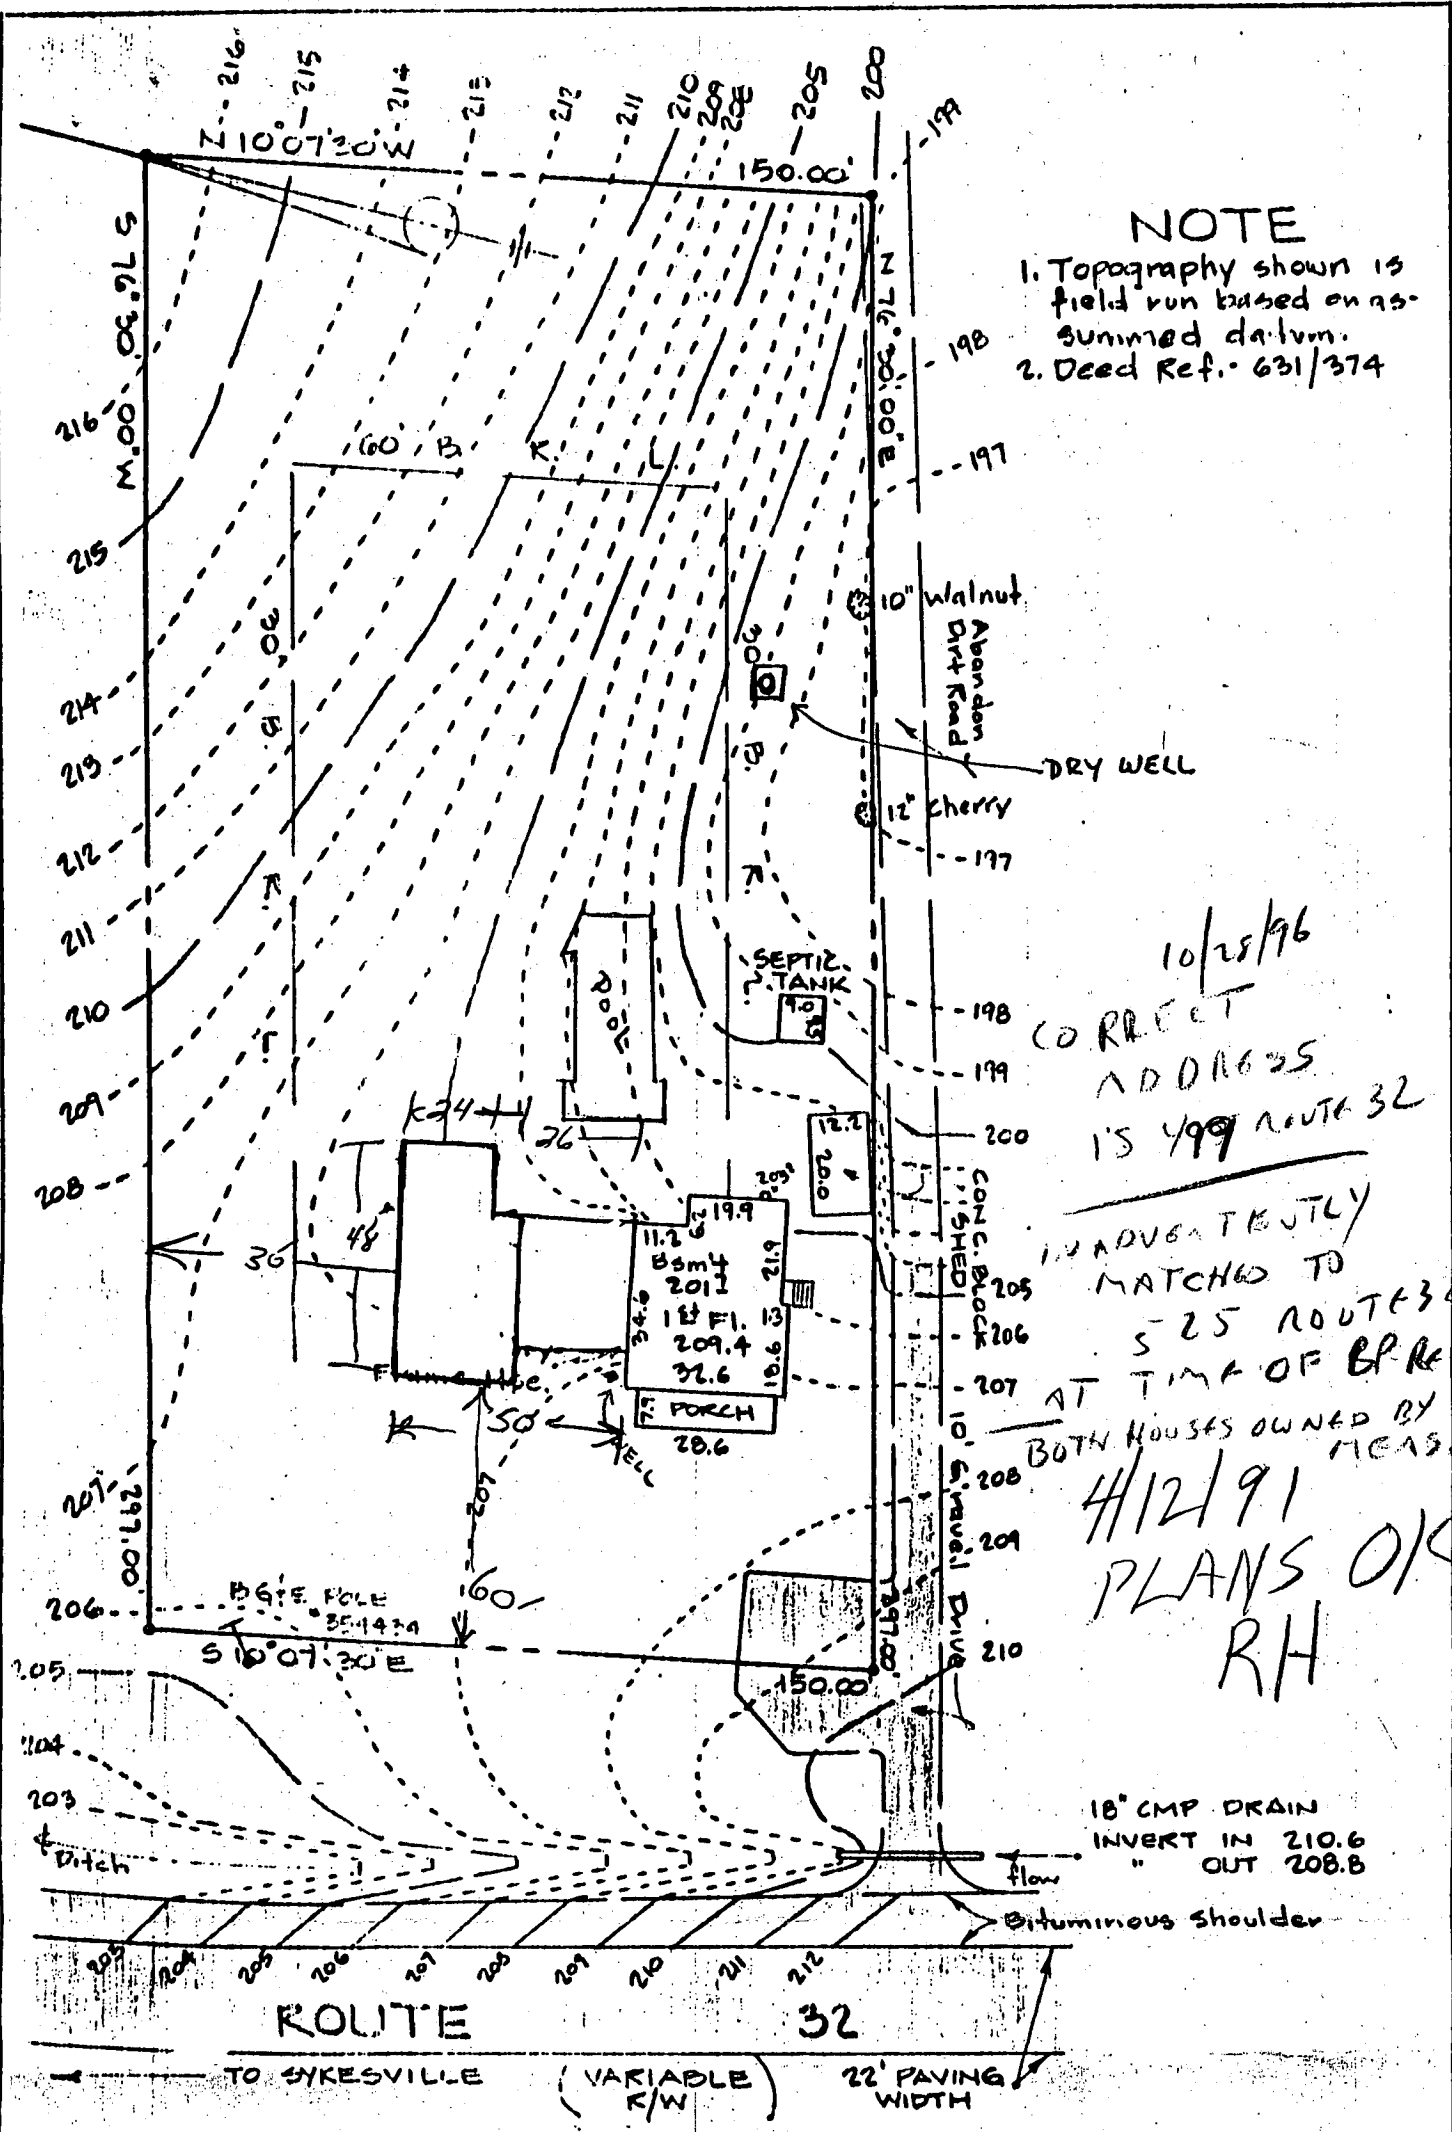

GRADING STUDY PLAT

CONNIE M'GINN PROPERTY

ELECTION DISTRICT
HOWARD COUNTY - MARYLAND

1"=40'

6-27-83

DRN: TGH

CKD: JLS

