

PERMIT

SEWAGE DISPOSAL SYSTEM

MARYLAND STATE DEPARTMENT OF HEALTH

P. 36808
A. Repair**HOWARD COUNTY**

BUREAU OF ENVIRONMENTAL HEALTH

982-2330

INDEXED

ELLICOTT CITY

DISTRICT _____

DATE 4/14/86JACK FYOCKIS PERMITTED TO INSTALL _____ ALTER X

ADDRESS _____

PHONE _____

SUBDIVISION WOODMARKROAD MT ALBERT Rd.LOT 5 BLK D Sec. 1PROPERTY OWNER ~~12119 ME~~DAN BLAKE - BuilderADDRESS 12119 ME ALBERT Rd.

IF GARBAGE GRINDER IS USED INCREASE SEPTIC TANK CAPACITY BY 50% AND ABSORPTION AREA BY 22%.

GARBAGE GRINDER? YES _____ NO _____

SEPTIC TANK CAPACITY _____ GALLONS

NUMBER OF BEDROOMS _____

Repair of System: 16 Ft TEST/OBSERVATION HOLE DRY; SYSTEM 12 Ft
DEEP; INLET 5'; 2" STONE BELOW PIPE; LENGTH 52 Ft; PLACED
OFF OF TRENCH #2 EXISTING; TRENCH #1 CLOSED OFF (TRENCH FAILING);
DB HAD SETTLED WHERE ALL EFFLUENT WAS ENTERING #1 TRENCH; HOUSE
FIXURES - SHOWER STALL CONTINUOUSLY RUNNING AND BOTH UPSTAIRS
TOILETS CONTINUING TO RUN AFTER FLUSH HAD BEEN REPAIRED S. Aul
SUB ATTACHED STREET. S. Aul 3-31-86

PLANS APPROVED BY _____

DATE _____

COVER NO WORK UNTIL INSPECTED AND APPROVED.

NEITHER THE HOWARD COUNTY COUNCIL NOR THE HEALTH DEPARTMENT IS RESPONSIBLE FOR THE SUCCESSFUL OPERATION OF ANY SYSTEM.

NOTE: IF TRENCH IS USED CALL FOR INSPECTION BEFORE AND AFTER PLACING GRAVEL IN TRENCH.

NOTE: NO DRY WELL SHALL EXCEED 15 FOOT IN DIAMETER. NO ABSORPTION TRENCH TO EXCEED 100 FEET IN LENGTH.

NOTE: ALL PIPE FROM HOUSE TO SEPTIC TANK MUST BE CAST IRON OR SCHEDULE 40 PVC OR ABS.


PERMIT VOID AFTER THREE YEARS.

NOTE: INSTALL STAND PIPE ON SEPTIC TANK AND DRY WELL. STAND PIPES MUST BE 6 INCHES IN DIAMETER. CAST IRON, CONCRETE OR TERRA COTTA, OR PVC OR ABS ACCEPTED. IF TOP OF SEPTIC TANK IS DEEPER THAN 3 FEET MANHOLE TO GRADE REQUIRED.

INSTALLER IS RESPONSIBLE FOR OBTAINING FINAL APPROVAL ON THIS PERMITCALL 982-2330 FOR INSPECTION OF SEPTIC SYSTEMS.

EH - 2-1082

A. Repair
36808

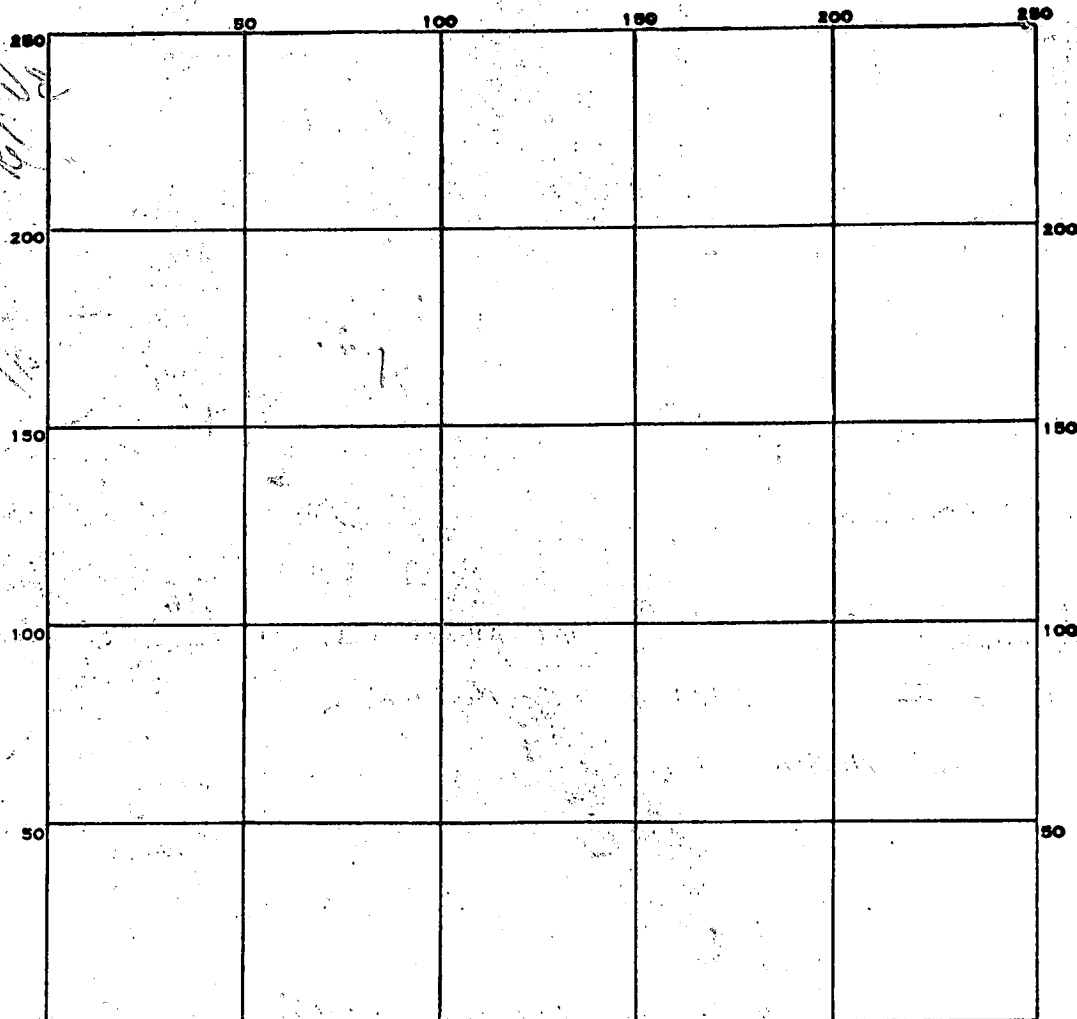

INDICATE NORTH. — NAME ADJOINING ROADWAY AS BASE LINE.

PERMIT CARD _____

SEPTIC TANK, LEVEL _____

CLEANOUTS _____

DISTRIBUTION BOX, LEVEL _____

TILE FIELD, DEPTH _____ FT. TRENCH WIDTH _____ FT.

GRAVEL DEPTH _____ IN. TOTAL LENGTH _____ FT.


NUMBER OF TRENCHES _____ TOTAL BOTTOM AREA _____

SEEPAGE PITS, INSIDE DIAMETER _____ FT. DEPTH BELOW INLET _____ FT.

ABSORBENT AREA _____ SQ. FT.

REMARKS _____

DATE SYSTEM APPROVED _____ INSPECTOR _____

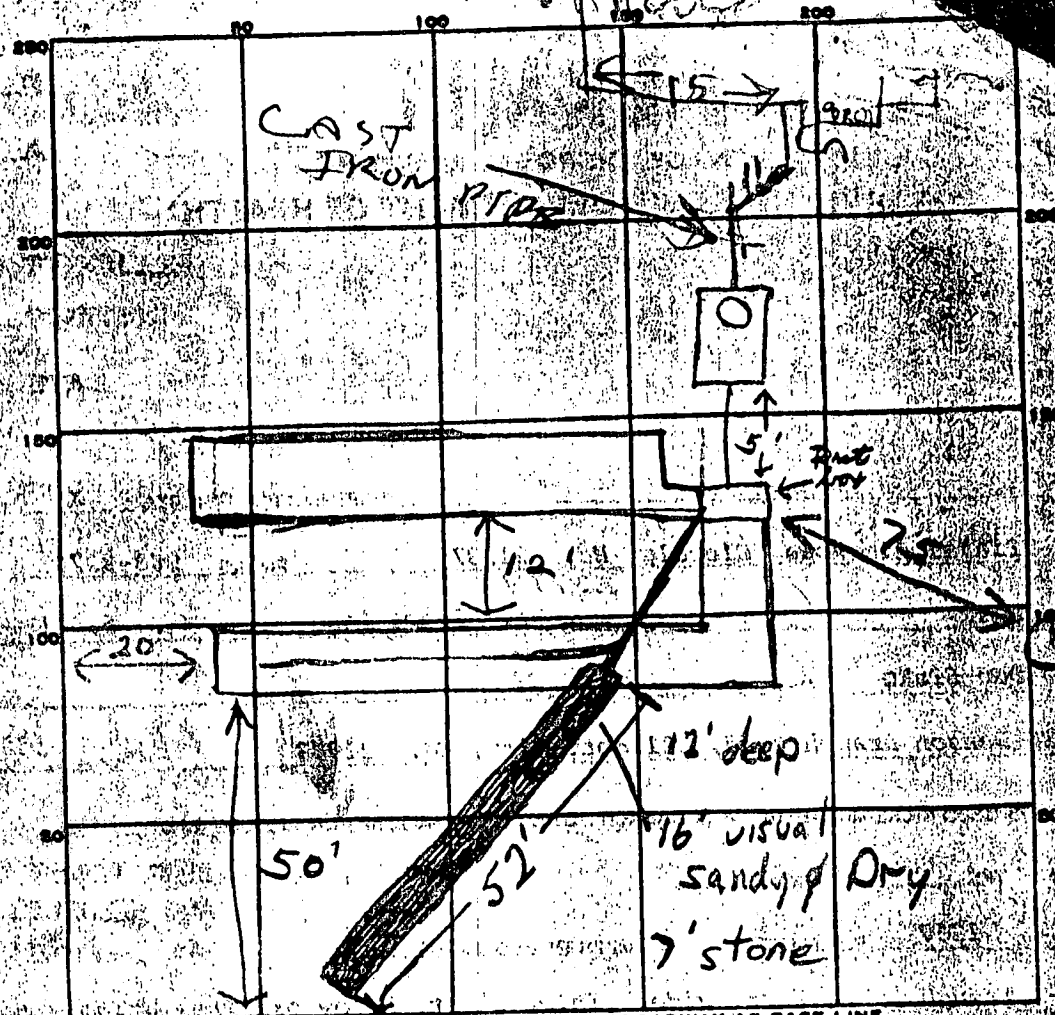

INDICATE NORTH - NAME ADJOINING ROADWAY AS BASE LINE.

Mt. Albert Rd.

PERMIT CARD ☒

SEPTIC TANK, LEVEL ☒

1500

CLEANOUTS *ST*

DISTRIBUTION BOX, LEVEL ☒

Man hole

TILE FIELD, DEPTH *4* FT.

TRENCH WIDTH *7'* FT.

GRAVEL DEPTH *1 1/2'* IN.

TOTAL LENGTH *100* FT.

NUMBER OF TRENCHES *2*

TOTAL BOTTOM AREA

SEEPAGE PITS, INSIDE DIAMETER

FT.

DEPTH BELOW INLET

FT.

ABSORBENT AREA

SQ. FT.

REMARKS

5/10/83 OK to cover all work. Must see

house connection - call when ready. Jd

8/31/83

HOUSE HOOKUP

OK

RJH

DATE SYSTEM APPROVED

8/31/83

INSPECTOR

Raymond J. Hodge

5/10/83
8/31/83
After house connection

APPROVED
8/31/83 RH
P 32738
A 12933

PERMIT

SEWAGE DISPOSAL SYSTEM

MARYLAND STATE DEPARTMENT OF HEALTH

HOWARD COUNTY

BUREAU OF ENVIRONMENTAL HEALTH
992-2330

INDEX

ELLICOTT CITY

DISTRICT 3rd

DATE 5/5/83

Jack Fyock

IS PERMITTED TO INSTALL ☒ ALTER

ADDRESS 13785 Triadelphia Road, Glenelg, Md. 21737

PHONE 988-9270

SUBDIVISION Woodmark

ROAD Mt. Albert Road

LOT 5, Blk. D, Sec. 1

PROPERTY OWNER ~~Don Blake~~ Lawrence Truitt

ADDRESS 12218 Benson Branch Road, Ellicott City, Md. 21043

Phone: 531-5500

IF GARBAGE GRINDER IS USED INCREASE SEPTIC TANK CAPACITY BY 50% AND ABSORPTION AREA BY 22%.

GARBAGE GRINDER? YES ☐ NO ☐

BLDG. PERMIT SIGNED
AND RETURNED 5/11/83
Serial No. 53750

SEPTIC TANK CAPACITY 1250 GALLONS

NUMBER OF BEDROOMS 4

TRENCHES - Trench to be 7 ft. wide. Inlet 2 1/2 ft. below original grade. Bottom maximum depth 4 ft. below original grade. Effective area begins at 2 1/2 ft. below original grade. 1 1/2 ft. of stone under distribution pipe. Start first trench parallel to and 45 ft. away from ~~front~~ front lot line and 10 feet off of left side line. Place second trench downhill of and parallel to the first trench. Each trench to be at least 50 feet long.

PLANS APPROVED BY Frank Skinner

DATE 5/5/83

COVER NO WORK UNTIL INSPECTED AND APPROVED.

NEITHER THE HOWARD COUNTY COUNCIL NOR THE HEALTH DEPARTMENT IS RESPONSIBLE FOR THE SUCCESSFUL OPERATION OF ANY SYSTEM.

NOTE: IF TRENCH IS USED CALL FOR INSPECTION BEFORE AND AFTER PLACING GRAVEL IN TRENCH.

NOTE: NO DRY WELL SHALL EXCEED 15 FOOT IN DIAMETER. NO ABSORPTION TRENCH TO EXCEED 100 FEET IN LENGTH.

NOTE: ALL PIPE FROM HOUSE TO SEPTIC TANK MUST BE CAST IRON OR SCHEDULE 40 PVC OR ABS.

PERMIT VOID AFTER THREE YEARS.

NOTE: INSTALL STAND PIPE ON SEPTIC TANK AND DRY WELL. STAND PIPES MUST BE 6 INCHES IN DIAMETER. CAST IRON, CONCRETE OR TERRA COTTA, OR PVC OR ABS ACCEPTED. IF TOP OF SEPTIC TANK IS DEEPER THAN 3 FEET MANHOLE TO GRADE REQUIRED.


BLDG. PERMIT SIGNED
AND RETURNED 6/24/85
Serial # 45589 Pool.

*INSTALLER IS RESPONSIBLE FOR OBTAINING FINAL APROVAL ON THIS PERMIT

*CALL 992-2330 FOR INSPECTION OF SEPTIC SYSTEMS.

EH - 2-1082

A 12933

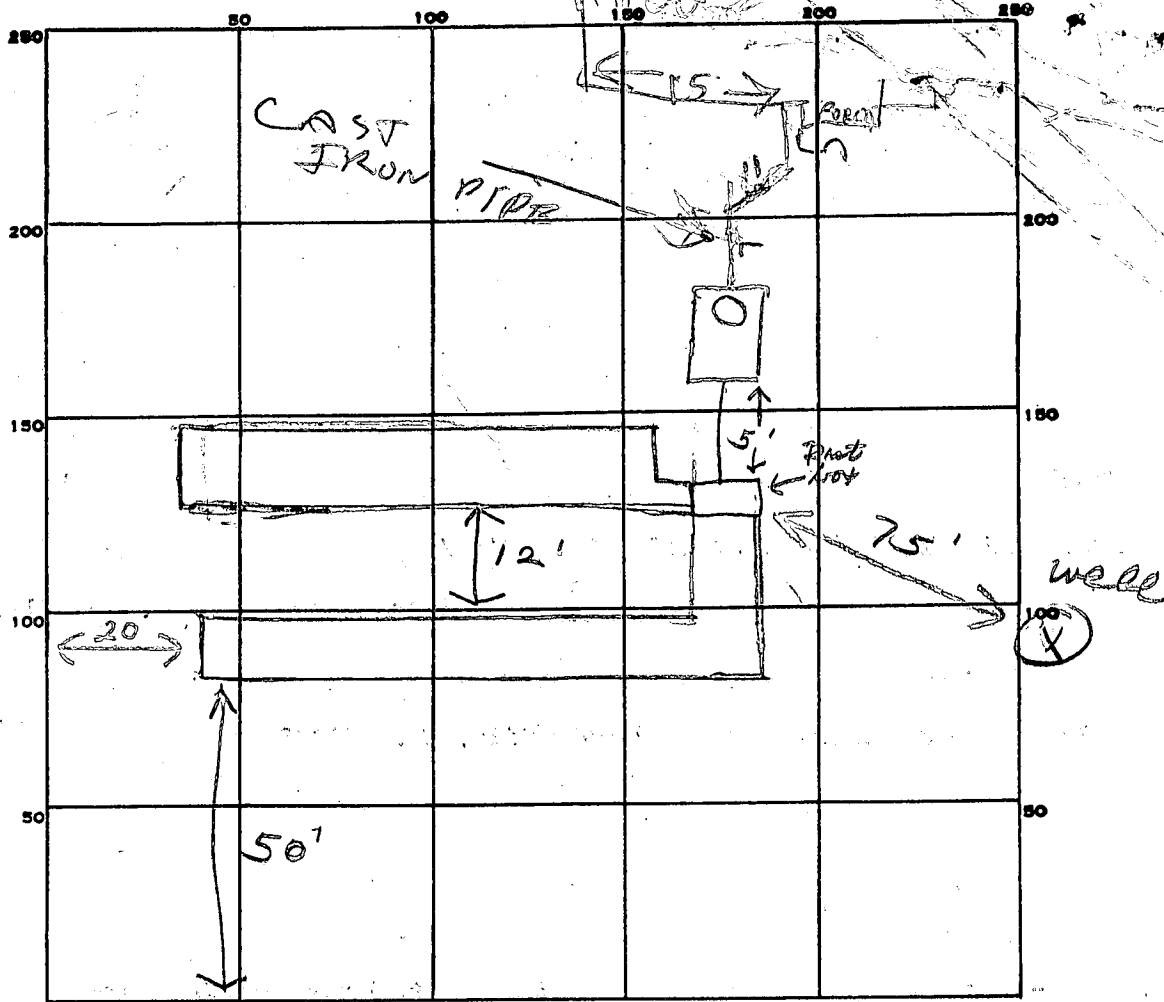

INDICATE NORTH. - NAME ADJOINING ROADWAY AS BASE LINE.

Mt. Albert Rd.

PERMIT CARD ☒

SEPTIC TANK, LEVEL ☒

1500

CLEANOUTS *ST*

DISTRIBUTION BOX, LEVEL ☒

Man hole

TILE FIELD, DEPTH *4* FT.

FT.

TRENCH WIDTH *7'* FT.

7'

GRAVEL DEPTH *1 1/2'* IN.

1 1/2'

TOTAL LENGTH *100* FT.

100

NUMBER OF TRENCHES *2*

2

TOTAL BOTTOM AREA _____

SEEPAGE PITS, INSIDE DIAMETER _____ FT.

FT.

DEPTH BELOW INLET _____ FT.

FT.

ABSORBENT AREA _____ SQ. FT.

_____ SQ. FT.

REMARKS *5/10/83 OK to cover all work. Must see*

house connections - call when ready. If

8/31/83 HOUSE HOOKUP OK R12

8/31/83

HOUSE HOOKUP OK R12

OK R12


DATE SYSTEM APPROVED *8/31/83*

8/31/83

INSPECTOR *Raymond J. Hodge*

Raymond J. Hodge

Woodmark lot 5 Bldg. D, Sec. 1

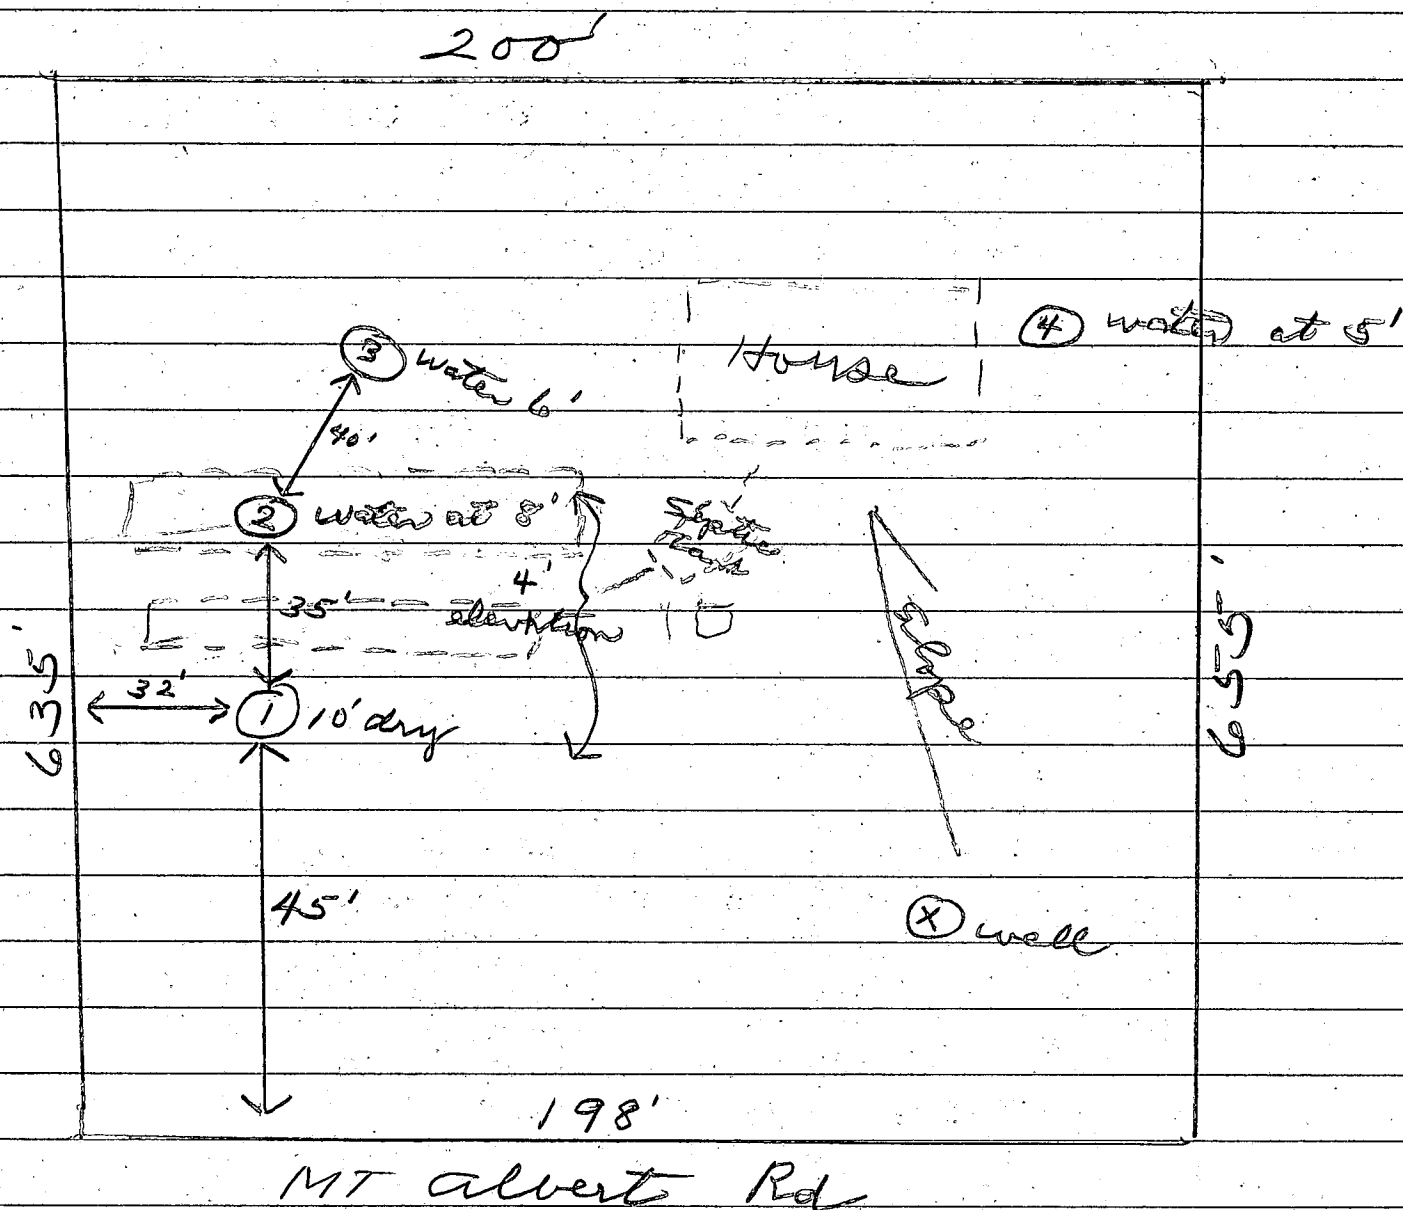

Recommend system first. House will be 4' to 6' above gr. (4 bedroom)

Two trenches 4ft deep, 7ft. wide with 1 1/2' of stone

Pending your approval. J. Fyock will be in to discuss. JF

5/3/08

3/15/79 - 13 or 14 ft. Vertical Hole Needed.

APPLICATION

A 12933

P

SEWAGE DISPOSAL TESTING

MARYLAND STATE DEPARTMENT OF HEALTH

HOWARD COUNTY

ELLICOTT CITY

Septic Tank - 3 bedroom - 750 gal 1000
1000 gal 1250

DISTRICT 3

DATE 7/21/67

Dry Well - 120 sq ft absorbent sidewalk area per bedroom
to begin below inlet pipe. Inlet pipe 2 ft below original grade. Max Depth
permitted for Dry Well below original grade is 6 ft. Eff. area starts at 2 1/2

Place Dry Well about 150 ft from front lot line and about 25 ft
from right sideline as seen when facing lot from Mt Albert Rd.

TO: THE COUNTY HEALTH OFFICER
ELLICOTT CITY, MARYLAND

I, HEREBY, APPLY FOR THE NECESSARY TESTS IN ORDER TO CONSTRUCT (OR RECONSTRUCT) A SEWAGE
DISPOSAL SYSTEM.

PROPERTY OWNER Woodmark, Inc. *Jan Blake*

ADDRESS 231 Chatham Rd., Ellicott City, Md. PHONE HO 5-1345

PROPERTY LOCATION:

SUBDIVISION Woodmark, Inc. LOT NO. 5, Blk. D, Sec. 2

ROAD AND DESCRIPTION Road "A"

OCCUPANT PHONE

PERSON TO CONSTRUCT SYSTEM

ADDRESS PHONE

SIZE OF LOT 198' x 635' x 200' x 655' TYPE BLDG. 3 or 4
NUMBER OF BEDROOMS

IF NOT SINGLE RESIDENCE DESCRIBE

SIGNATURE OF APPLICANT /s/ Mark A. Wakefield


✓ APPROVED BY *MM* FOR *Dry Well* (KIND OF SYSTEM) DATE 3-7-68

REJECTED BY FOR (KIND OF SYSTEM) DATE

HOLD PENDING FURTHER TESTS DATE

REASONS FOR REJECTION OR HOLDING

THIS IS NOT A PERMIT

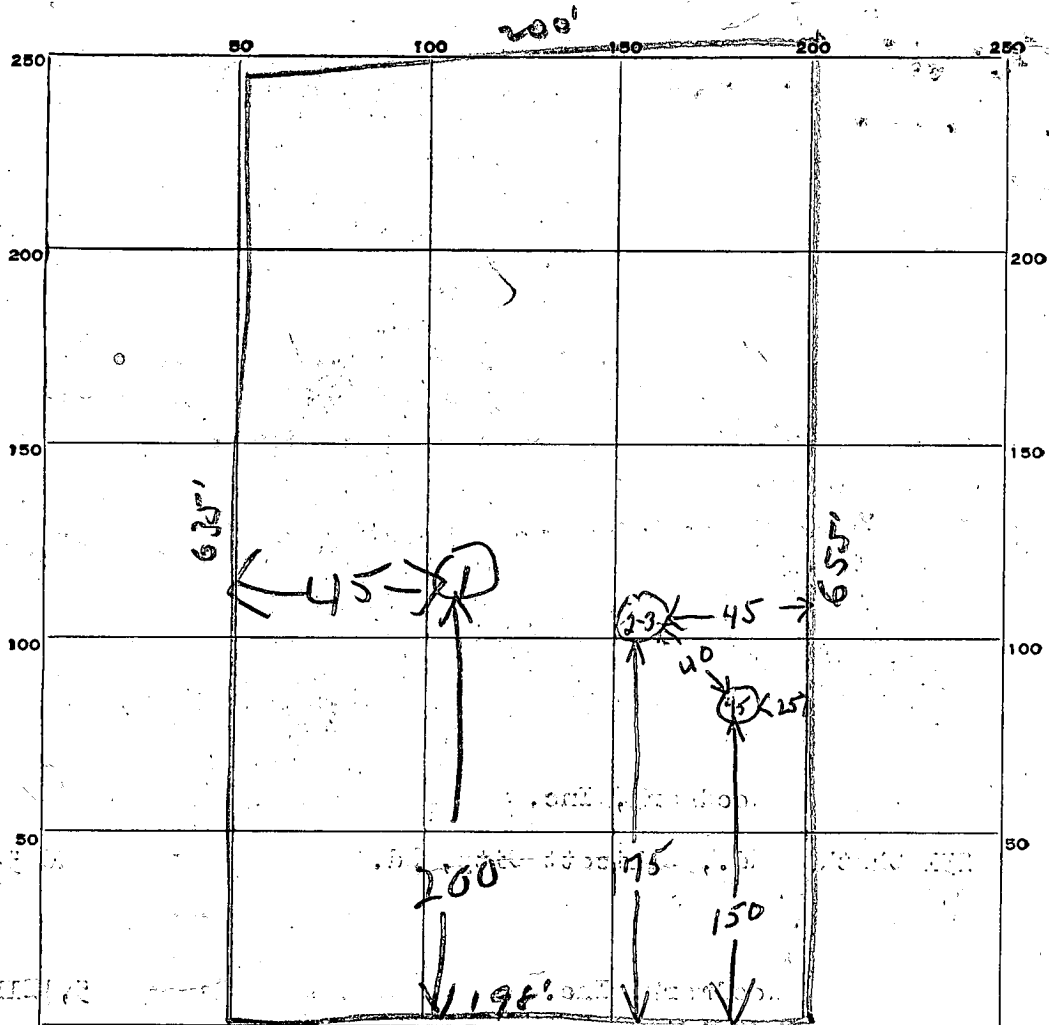

INDICATE NORTH. - NAME ADJOINING ROADWAY AS BASE LINE.

Road A

DATE	TEST NO.	DEPTH	PRE-WET		TEST - 1" DROP		TIME
			START	STOP	START	STOP	
7/12/57	1	water at 9 1/2 ft					
7/12/57	2	3 ft	3 02	3 03	3 03	3 05	2 min
	3	11 ft	3 02	3 05	3 05	3 15	10 min
	4	4 ft	3 07	3 08	3 08	3 11	3 min
	5	10 ft	3 08	3 10	3 10	3 17	7 min

SOIL AUGER FINDING all same

TESTED BY Dum

REMARKS Outlet 2 ft below grade - which 5 ft below all - use pit (2-3)

50

B 1 5669 1 2 3 (SEQ. NO.) 6 (THIS NUMBER IS TO BE PUNCHED IN C.P.L.S. 3-6 ON ALL CARDS)		STATE OF MARYLAND WATER RESOURCES ADMINISTRATION TAWES STATE OFFICE BLDG., ANNAPOLIS, MARYLAND 21401 APPLICATION FOR PERMIT TO DRILL WELL			WRA PERMIT NUMBER 40 73 3291 FILL IN THIS FORM COMPLETELY	
DATE RECEIVED (WRA USE ONLY) 6/13/79 9:30 A.M. 105		OWNER <u>Donna Prince, Don</u> COL 15 LAST NAME FIRST NAME COL. 34 STREET OR RFD <u>12007 Pleasant Branch Road</u> COL 36 COL. 55 POST OFFICE <u>Frederick, Md. 21701</u> COL 57 COL. 76				
B 1 CONTINUED 1 2 3 (SEQ. NO.) 6		DRILLER INFORMATION		B 3 4 LOCATION OF WELL		
DATE <u>5/12/79</u> LICENSE NUMBER <u>0140</u> 77 80 FIRST NAME <u>Donna F. Prince</u> DRILLER LAST NAME <u>Prince</u> SIGNATURE <u>Donna F. Prince</u>		COUNTY <u>St. Mary's</u> (DO NOT ABBREVIATE COUNTY NAME) 21 SUBDIVISION <u>23</u> 42 SECTION <u>44</u> <u>46</u> LOT <u>48</u> <u>50</u> NEAREST TOWN <u>Marriottsville</u> 71 MILES FROM TOWN (ENTER 0 IF IN TOWN) <u>2</u> 73 76 77 78		B 4 4 DIRECTION FROM TOWN (CIRCLE APPROPRIATE BOX) N NORTH E EAST NE NORTHEAST SE SOUTHEAST S SOUTH W WEST NW NORTHWEST SW SOUTHWEST NEAR WHAT ROAD <u>Chesapeake Beach Rd</u> ON WHICH SIDE OF ROAD (CIRCLE APPROPRIATE BOX) N 32 S 32 E 32 W 32 DISTANCE FROM ROAD (ENTER DISTANCE AND CIRCLE APPROPRIATE BOX) <u>34</u> 37 38 39		
B 2 2 WELL INFORMATION MAXIMUM PUMPING RATE (GALLONS PER MINUTE) <u>8</u> 12 AVERAGE DAILY QUANTITY NEEDED (GALLONS PER DAY) <u>14</u> 20 USE FOR WATER (CIRCLE APPROPRIATE BOX) ☐ HOME (SINGLE OR DOUBLE HOUSEHOLD UNIT ONLY) ☐ FARMING, AGRICULTURE, IRRIGATION ☐ INDUSTRIAL, COMMERCIAL, STATE AND FEDERAL GOVERNMENT. ☐ MUNICIPAL WATER SUPPLY ☐ PRIVATE WATER COMPANY ☐ TEST MUST HAVE STATE HEALTH DEPT. APPROVAL		DRAW A SKETCH BELOW SHOWING LOCATION OF WELL IN RELATION TO NEARBY TOWNS, ROADS AND STREAMS WITH NORTH IN THE DIRECTION OF THE ARROW, AND GIVE DISTANCE FROM WELL TO NEAREST ROAD JUNCTION OR STREAM CROSSING SHOWN ON THE SKETCH. ALSO SHOW, BY MEANS OF AN "X", THE WELL LOCATION IN THE BOX BELOW AND THE BOX NUMBER FROM THE WELL LOCATION MAP. N ↑ 27 - CASING 2' ABOVE GR 22 - OPEN 5 - BAGS CEMENT 6/13/79 No plat with permit - location looks OK				
APPROXIMATE DEPTH OF WELL <u>24</u> <u>100</u> FEET APPROXIMATE DIAMETER OF WELL <u>10</u> (NEAREST INCH)		METHOD OF DRILLING USED (CIRCLE APPROPRIATE METHOD) BORED (OR AUGERED) JETTED DRIVEN 30-37 AIR-ROTARY AIR-PERCUSSION ROTARY (HYDRAULIC ROTARY) CABLE REVERSE-ROTARY DRIVE-POINT OTHER (DESCRIBE) _____				
REPLACEMENT OR DEEPEINED WELLS (CIRCLE APPROPRIATE BOX) ☐ THIS WELL WILL NOT REPLACE AN EXISTING WELL ☐ THIS WELL WILL REPLACE A WELL THAT WILL BE ABANDONED AND SEALED ☐ THIS WELL WILL REPLACE A WELL THAT WILL BE USED AS A STANDBY ☐ THIS WELL WILL DEEPEIN AN EXISTING WELL PERMIT NUMBER OF WELL TO BE REPLACED OR DEEPEINED (IF AVAILABLE) _____		NOT TO BE FILLED IN BY DRILLER (WRA USE ONLY) APPROPRIATION PERMIT NUMBER <u>54</u> <u>63</u> <u>65</u> FORCE <u>67</u> <u>68</u> WRITE INITIALS IN BOX CONDITIONS <u>70</u> <u>71</u> <u>72</u> <u>73</u> <u>74</u> <u>75</u> <u>76</u> <u>77</u> <u>78</u> <u>79</u>				
B 4 CONTINUED 1 2 3 (SEQ. NO.) 6		HEALTH DEPARTMENT APPROVAL		NORTH COORDINATE <u>50</u> <u>51</u> <u>52</u> <u>53</u> <u>54</u> <u>55</u> EAST COORDINATE <u>57</u> <u>58</u> <u>59</u> <u>60</u> <u>61</u> <u>62</u> <u>63</u> ELEVATION AT WELL HEAD (FEET) <u>65</u> <u>66</u> <u>67</u> <u>68</u>		
B 5 5 1 2 3 (SEQ. NO.) 6		SPECIAL CONDITIONS 8-63 (WRA USE ONLY)				

Preliminary

APPLICATION

SEWAGE DISPOSAL TESTING

MARYLAND STATE DEPARTMENT OF HEALTH

HOWARD COUNTY

ELLICOTT CITY

DISTRICT 3

DATE 7/21/67

*I - 2
off. 2 1/2
not 6 1/2*

TO: THE COUNTY HEALTH OFFICER
ELLICOTT CITY, MARYLAND

I, HEREBY, APPLY FOR THE NECESSARY TESTS IN ORDER TO CONSTRUCT (OR RECONSTRUCT) A SEWAGE DISPOSAL SYSTEM.

PROPERTY OWNER Woodmark, Inc.

ADDRESS 231 Chatham Rd., Ellicott City, Md. PHONE HO 5-1345

PROPERTY LOCATION:

SUBDIVISION Woodmark, Inc. LOT NO. 5, Blk. D, Sec. 2

ROAD AND DESCRIPTION Road "A"

OCCUPANT _____ PHONE _____

PERSON TO CONSTRUCT SYSTEM _____

ADDRESS _____ PHONE _____

SIZE OF LOT 198' x 635' x 200' x 655' TYPE BLDG. 3 or 4
NUMBER OF BEDROOMS

IF NOT SINGLE RESIDENCE DESCRIBE _____

SIGNATURE OF APPLICANT /s/ Mark A. Wakefield

APPROVED BY *MM* FOR *Dywell* DATE 3-7-68
(KIND OF SYSTEM)


REJECTED BY _____ FOR _____ DATE _____
(KIND OF SYSTEM)

HOLD PENDING FURTHER TESTS _____ DATE _____

REASONS FOR REJECTION OR HOLDING _____

THIS IS NOT A PERMIT

158
4
632

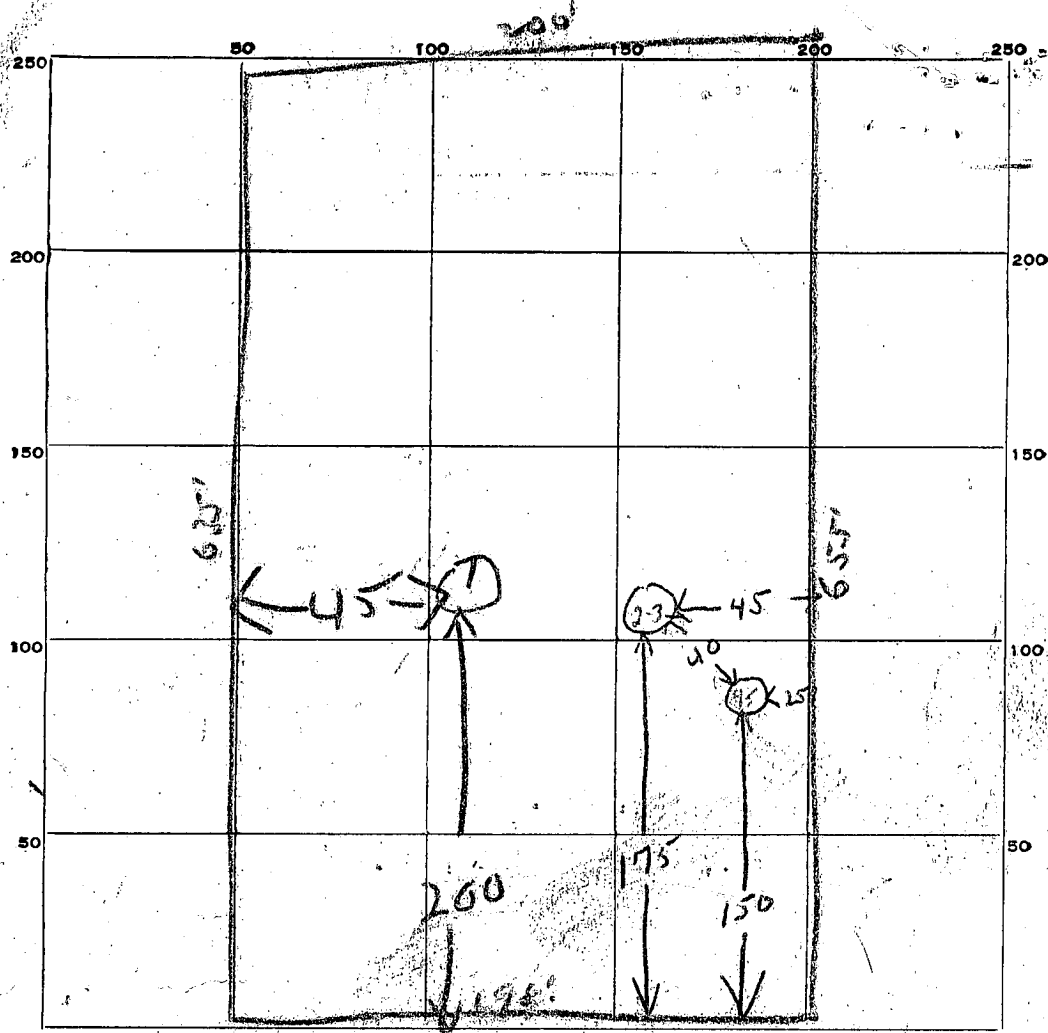

INDICATE NORTH. - NAME ADJOINING ROADWAY AS BASE LINE.

Road A

DATE	TEST NO.	DEPTH	PRE-WET		TEST - 1" DROP		TIME
			START	STOP	START	STOP	
7/1/57	1	water at 9 1/2 ft	3 02	3 03	3 03	3 03	
7/1/57	2	3 ft	3 02	3 03	3 03	3 03	2 min
	3	11 ft	3 03	3 03	3 03	3 15	10 min
	4	4 ft	3 07	3 08	3 08	3 11	3 min
	5	10 ft	3 08	3 10	3 10	3 17	7 min

SOIL AUGER FINDING all same

TESTED BY Dum

REMARKS Drill 2 ft below grade - which is below all - use pit (2.3)

50

FILE

DATE REPORTED 5-10-83

PROPERTY OWNER GWEN CHANEY

P. O. ADDRESS MT ALBERT RD - WOODMARK

DIRECTIONS TO PROPERTY LOT 4

INFORMANT MRS CHANEY -

CONCERNED THAT SEPTIC SYSTEM ON LOT 4 BEING
INSTALLED IMPROPERLY AND CONSTITUTED A HEALTH HAZARD
TO HER WELL. (1) INADEQUATE DISTANCE (2) INCORRECT ELEVATION
(3) INSTALLED IN FILL

CONDITION FOUND: MET WITH MRS CHANEY AT THE SITE. 100' SYSTEM TO WELL,
SYSTEM WAS HIGHER THAN HER WELL BUT UNAVIDABLE UNLESS SHE CHOSE
TO DRILL NEW WELL AT HIGHER LOCATION. THERE WAS SOME FILL ON SITE,
BUT NO MORE THAN 6" OVER ONE END OF THE HIGHEST TRENCH. MOST OF THE
TRENCH SYSTEM HAS NO FILL OVER IT; THE TRENCHES THEMSELVES ARE
INSTALLED ENTIRELY IN ORIGINAL GROUND. THE BASE OF THE SEPTIC TANK
IS ON ORIGINAL GROUND ALTHOUGH FILL WILL BE NECESSARY TO COVER IT.

ACTION TAKEN: I ADVISED HER THAT SYSTEM APPEARED TO BE
INSTALLED ACCORDING TO SPECS. SUGGESTED SHE MONITOR HER
WELL REGULARLY FOR CONTAMINATION, REFERRED HER TO
FRANK SKINNER IF SHE HAD FURTHER CONCERNS.

C. Williams

FINAL DISPOSITION:

D. G. B., Inc.

12218 BENSON BRANCH ROAD, WOODMARK - ELLICOTT CITY, MD. 21043 - PHONE 531-5500

201.22'

LOT 5

SECTION 1

BLOCK D "PART A"

124267 S.F.

PLAT 13

Folio 61

5/11/83

System has been installed
OK J.S.

635.27'

679.53'

Building Line

SEWER SYSTEM
PER CTY. Regs.
INSTALLED BEFORE
CONSTRUCTION.

SLOPE

SLOPE

SEWER
SUS

WELL

12119

MT. ALBERT RD

May 12, 1983

Mr. Daniel Blake
D.G.B., Inc.
12218 Benson Branch Road
Ellicott City, Maryland 21043

RE: Building Permit Serial #53750

Dear Mr. Blake:

This office has signed off on the above referenced building permit application.

This is to advise you that you are responsible for arranging for an inspection of the final house sewer connection, before that work is covered.

Very truly yours,



Frank A. Skinner, Director
Water and Sewerage Program

FAS:hs

