

6/25/85
A.S.A.P.

6-25-85
copy now of
State

PERMIT

SEWAGE DISPOSAL SYSTEM

MARYLAND STATE DEPARTMENT OF HEALTH*

P 35669

A REPAIR

HOWARD COUNTY
BUREAU OF ENVIRONMENTAL HEALTH
992-2330

03-291731

ELLICOTT CITY
DISTRICT _____

INDEXED

DATE 6/19/85

Jack Fyock IS PERMITTED TO INSTALL _____ ALTER X

ADDRESS _____ PHONE 988-9270

SUBDIVISION ROMAN RIDGE ESTATES ROAD 14134 14184 Rover Mill Road LOT 8

PROPERTY OWNER Dell Morseberger

ADDRESS 14184 Rover Mill Road

West Friendship, Maryland

IF GARBAGE GRINDER IS USED INCREASE SEPTIC TANK CAPACITY BY 50% AND ABSORPTION AREA BY 22%.

GARBAGE GRINDER? YES _____ NO _____

SEPTIC TANK CAPACITY _____ GALLONS NUMBER OF BEDROOMS _____

REPAIR - CALL FOR INSPECTION WHEN GROUND IS OPENED UP SO SANITARIAN CAN RECOMMEND REPAIR.

PLANS APPROVED BY C. Williams DATE 6/19/85

COVER NO WORK UNTIL INSPECTED AND APPROVED.

NEITHER THE HOWARD COUNTY COUNCIL NOR THE HEALTH DEPARTMENT IS RESPONSIBLE FOR THE SUCCESSFUL OPERATION OF ANY SYSTEM.

NOTE: IF TRENCH IS USED CALL FOR INSPECTION BEFORE AND AFTER PLACING GRAVEL IN TRENCH.

NOTE: NO DRY WELL SHALL EXCEED 15 FOOT IN DIAMETER. NO ABSORPTION TRENCH TO EXCEED 100 FEET IN LENGTH.

NOTE: ALL PIPE FROM HOUSE TO SEPTIC TANK MUST BE CAST IRON OR SCHEDULE 40 PVC OR ABS.

PERMIT VOID AFTER THREE YEARS.


NOTE: INSTALL STAND PIPE ON SEPTIC TANK AND DRY WELL. STAND PIPES MUST BE 6 INCHES IN DIAMETER. CAST IRON, CONCRETE OR TERRA COTTA, OR PVC OR ABS ACCEPTED. IF TOP OF SEPTIC TANK IS DEEPER THAN 3 FEET MANHOLE TO GRADE REQUIRED.

*INSTALLER IS RESPONSIBLE FOR OBTAINING FINAL APROVAL ON THIS PERMIT

*CALL 992-2330 FOR INSPECTION OF SEPTIC SYSTEMS.

EH - 2-1082

A 35669

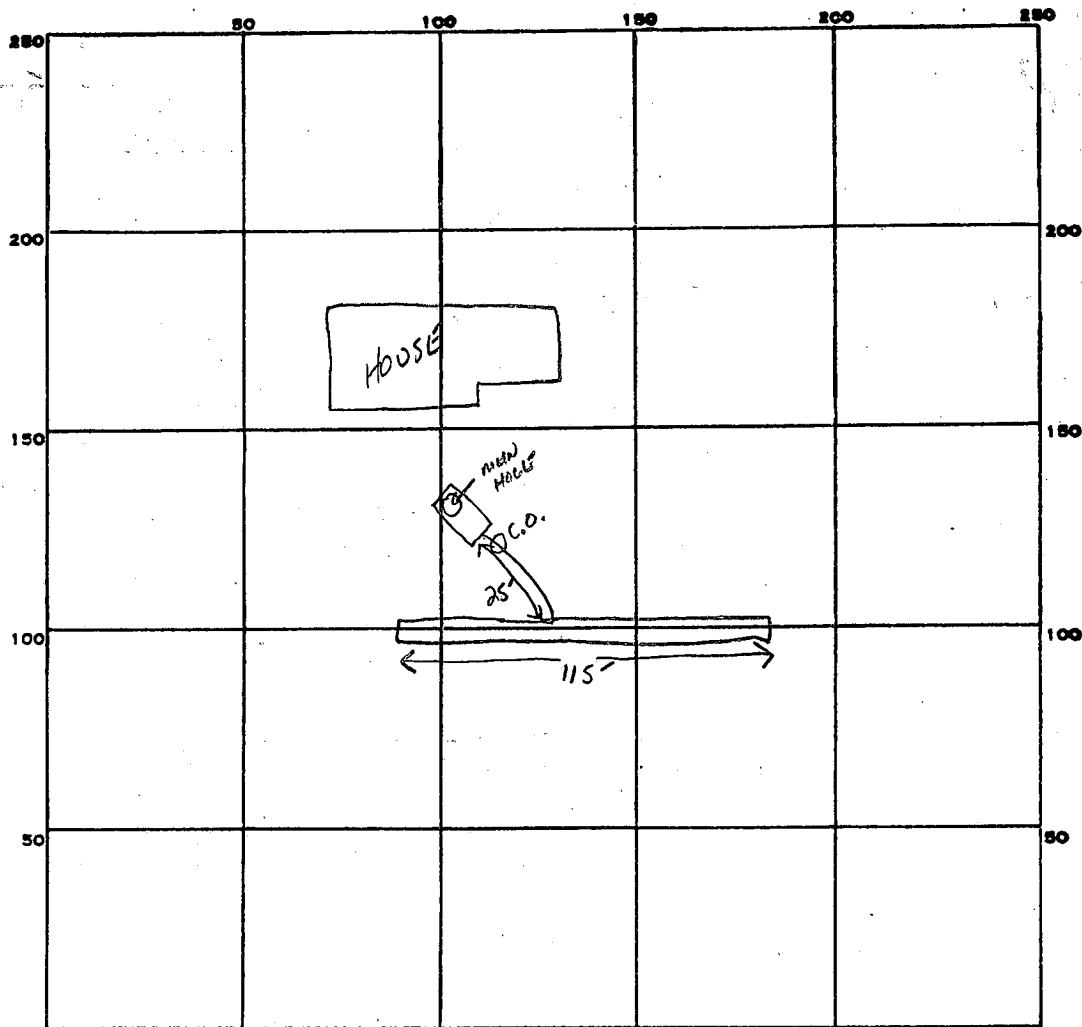

INDICATE NORTH. - NAME ADJOINING ROADWAY AS BASE LINE.

Rover Mill Rd.

PERMIT CARD ✓

SEPTIC TANK, LEVEL EXISTING

CLEANOUTS OUT FROM TANK ✓

DISTRIBUTION BOX, LEVEL N/A

TILE FIELD, DEPTH 11.5' FT. TRENCH WIDTH 2 FT. INLET 4'-5"

GRAVEL DEPTH 7 FEET NG ~~OK~~ TOTAL LENGTH 115' FT.

NUMBER OF TRENCHES 1 TOTAL BOTTOM AREA 8.05 $\square$

SEEPAGE PITS, INSIDE DIAMETER — FT. DEPTH BELOW INLET — FT.

ABSORBENT AREA 805 SQ. FT.

REMARKS 6-25-85 SLIGHT SLOPE 1-2% TOWARD EAST DEPTH 11.5 FEET TRENCH
ANG STONE DEPTH 7 FEET. OK TO ADD STONE TO REST OF TRENCH AND COVER
ALL WORK.

DATE SYSTEM APPROVED 6-25-85

INSPECTOR

S Abel

7/2/76 if possible
a.m.

PERMIT

P 23476
A 22923

SEWAGE DISPOSAL SYSTEM

MARYLAND STATE DEPARTMENT OF HEALTH

HOWARD COUNTY

ELLICOTT CITY

Approved
July 2 1976
HB

INDEXED

DISTRICT 3rd & 4th

DATE 6/23/76

Jack Pyock

IS PERMITTED TO INSTALL X ALTER

ADDRESS 13775 Trindelpia Road, Glenelg, Md. 21737 PHONE 988-9720

A SEWAGE DISPOSAL SYSTEM LOCATED AT

SUBDIVISION 14134 ROAD Rover Mill Road LOT 8

PROPERTY OWNER Mr. & Mrs. Charles Morsberger

ADDRESS 10 Hunting Creek Court, Baltimore, Md. 21228 Phone: 747-0578

~~REQUIREMENTS~~ 4 bedrooms

DRAIN FIELD DEPTH FEET, BOTTOM AREA SQ. FT.

SEEPAGE PITS ABSORBENT SIDE-WALL AREA SQ. FT.

SEPTIC TANK CAPACITY 1250 GALLONS

FOR GARBAGE GRINDER, INCREASE DISPOSAL AREA 25% & TANK CAPACITY 50%.

OTHER DRY WELL - To have 125 sq. ft. effective sidewall absorption area per bedroom to begin below the first 4 1/2 ft. of non-porous soil. Maximum depth permitted for dry well is 11 1/2 ft. below original grade. Dry well inlet to be no deeper than 4 1/2 ft. below original grade. Place the dry well 200 ft. from the rear lot line and 103 ft. from the right side line, as seen when facing the property from Rover Mill Road.

NOTE: ALL PIPE FROM HOUSE TO DISPOSAL AREA MUST BE CAST IRON.

PERMIT VOID AFTER THREE YEARS.

NOTE: INSTALL STAND PIPE ON SEPTIC TANK AND DRY WELL. STAND PIPES MUST BE 6 INCHES IN DIAMETER. CAST IRON, CONCRETE OR TERRA COTTA ACCEPTED.

PLANS APPROVED BY Frank Skinner DATE 4/1/76

FILL SEPTIC TANK AND DISTRIBUTION BOX WITH WATER BEFORE CALLING FOR AN INSPECTION. COVER NO WORK UNTIL INSPECTED AND APPROVED.


NEITHER THE HOWARD COUNTY COMMISSIONERS NOR THE HEALTH DEPARTMENT IS RESPONSIBLE FOR THE SUCCESSFUL OPERATION OF ANY SYSTEM.

BLDG. PERMIT SIGNED
AND RETURNED 7/28/76
Serial # 20277
Angeles Pove

BLDG. PERMIT SIGNED
AND RETURNED 6/28/76
Serial # 59688

22923

30
2
210

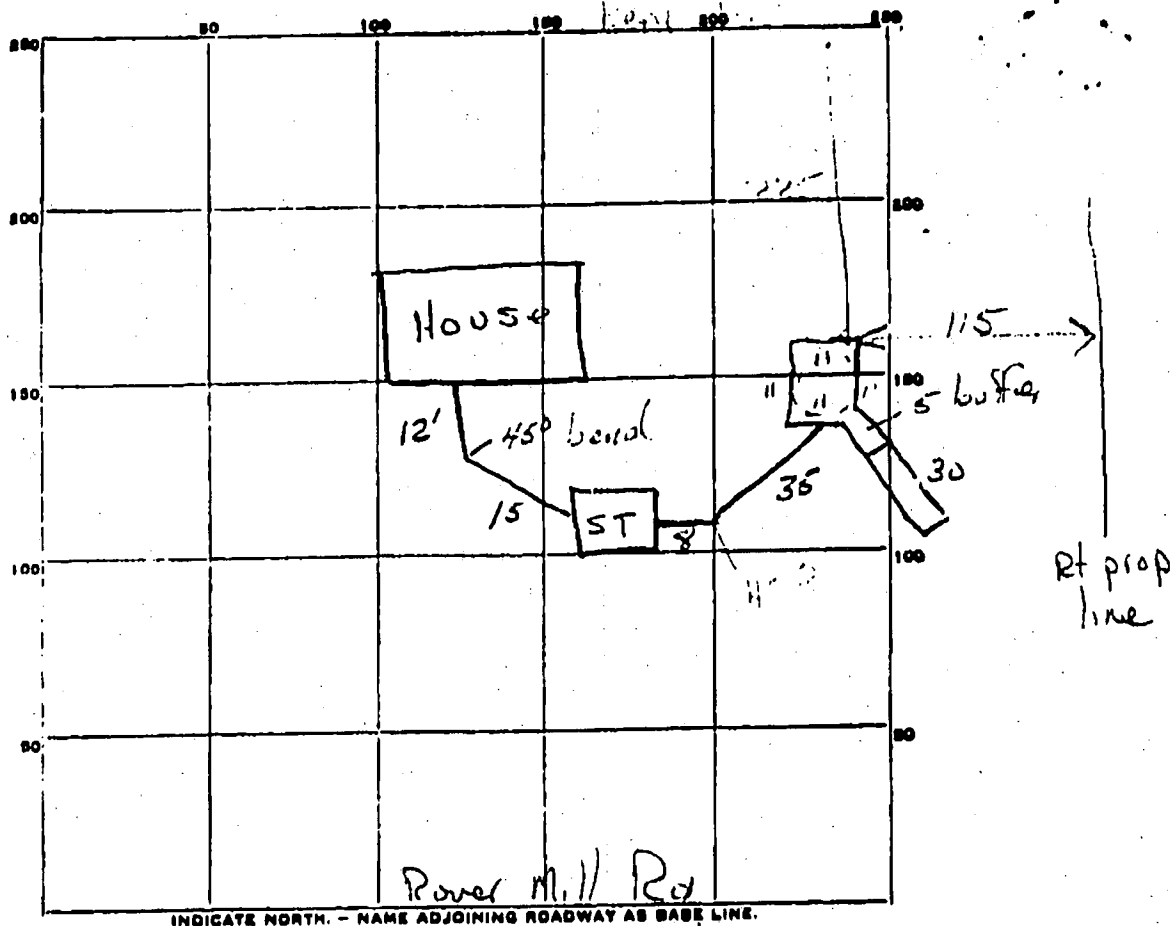

PERMIT CARD NOT Available

SEPTIC TANK, LEVEL 1250

ST	DW
✓	✓
MAN	
note	

DISTRIBUTION BOX, LEVEL

TILE FIELD, DEPTH 11 1/2 FT. TRENCH WIDTH 2 FT.

GRAVEL DEPTH 7 1/2 IN. TOTAL LENGTH 30 FT.

NUMBER OF TRENCHES 1

absorb area in trench 210
TOTAL BOTTOM AREA

SEEPAGE PITS, INSIDE DIAMETER 44 1/2 FT. DEPTH BELOW INLET 7 FT. = 308
210

total ABSORBENT AREA 518 SQ. FT.

REMARKS July 2 1926 at noon - HIB - installer filled over line
(from house to 45° bend) due to crave-in -
water poured into sewer line enter S.T.

DATE SYSTEM APPROVED July 2 1926 INSPECTOR hal Benson

Retest

4-13'
Lodes
22 10, 00-10

APPLICATION

A 22923

SEWAGE DISPOSAL TESTING

P _____

STATE OF MARYLAND - DEPARTMENT OF HEALTH AND MENTAL HYGIENE

HOWARD COUNTY HEALTH DEPARTMENT
ENVIRONMENTAL HEALTH SERVICES

DISTRICT 3rd & 4th

DATE 3/9/76

PO BOX 476, ELLICOTT CITY, MARYLAND 21043
TELEPHONE: 845-5000, EXT. 356 3 B.R.

4/1/76

1:30

Drywell to have 125 gal. 52/54 inch diam. 1250 gal. 52/54 inch diam. 4 B.R.
begin below the first 4 1/2 ft. of non-porous soil. Maximum depth permitted
for drywell is 11 1/2 ft. below original grade. Drywell inlet to be no
deeper than 4 1/2 ft. below original grade. Place the drywell 200 ft
from the rear lot line and 103 ft. from the right side line, as
seen when facing the property from Rover Mill Rd.

TO: THE COUNTY HEALTH OFFICER
ELLICOTT CITY, MARYLAND

I, HEREBY, APPLY FOR THE NECESSARY TEST IN ORDER TO CONSTRUCT (OR RECONSTRUCT) A SEWAGE
DISPOSAL SYSTEM.

PROPERTY OWNER Ruth Thompson property

Mr. & Mrs. Charles Monberger

ADDRESS 10 Hunting Creek Court,
Baltimore, Md. 21228

PHONE 747-0578

PROPERTY LOCATION:

SUBDIVISION (Roman Ridge Estates)

LOT NO. 8

ROAD AND DESCRIPTION Rover Mill and McKendree Roads

SIZE OF LOT 5.006 acres ±

TYPE BLDG. 3 or 4 bedrooms

NUMBER OF BEDROOMS

IF NOT SINGLE RESIDENCE DESCRIBE _____

THE SYSTEM INSTALLED UNDER THIS APPLICATION IS ACCEPTABLE ONLY UNTIL PUBLIC
FACILITIES BECOME AVAILABLE.

BLDG. PERMIT SIGNED
AND RETURNED 5/4/76

SIGNATURE OF APPLICANT /s/ Jack Fyock


APPROVED BY Frank Sheiner FOR Drywell DATE 4/1/76
(KIND OF SYSTEM)

REJECTED BY _____ FOR _____ DATE _____
(KIND OF SYSTEM)

HOLD PENDING FURTHER TESTS _____ DATE _____

REASONS FOR REJECTION OR HOLDING _____

THIS IS NOT A PERMIT

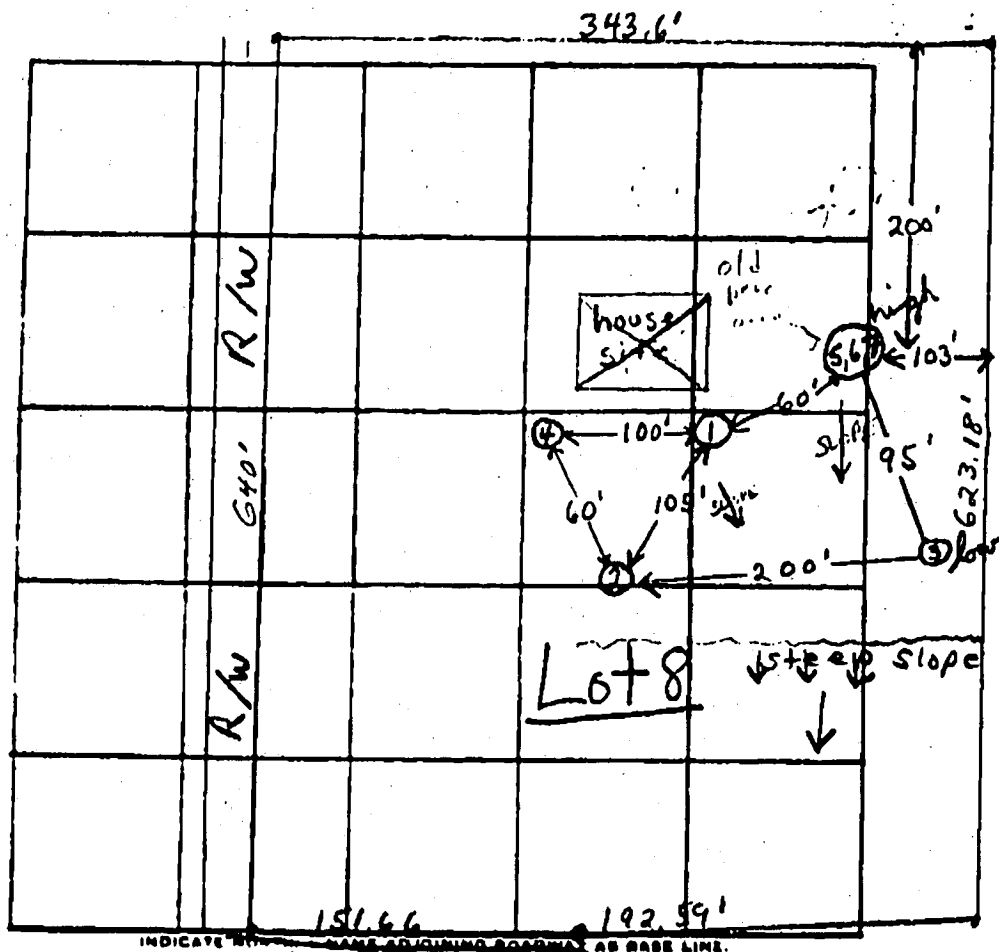

Rover Mill Rd.

DATE	TEST NO.	DEPTH	PRE-WET		TEST - 1" DROP		TIME
			START	STOP	START	STOP	
4/1/76	1	5 1/2'	1:29	1:31	1:31	1:35	4 min
	1A	13'	1:29	1:30	1:30	1:34	4 min
	2	4'	1:31	1:34	1:34	1:38	4 min
	2A	12 1/2'	1:32	1:35	1:35	1:43	8 min
	3 low	3'	1:38	1:42	1:42	1:50	8 min
	3A	11 1/2'	1:40	1:44	1:44	1:52	8 min
	4	9 1/2'	Clay to sandy loam & boulders below				
	5, 6, 7 high	12 1/2'	3 tested by R.H. on 7/31/76				
							2 min
							2 min

REMARKS use (5, 6, 7) for original system

TYPE OF SOIL sandy loam below top 3-5' clay

TESTED BY F.S.

ALSO PRESENT: J.F. York