

8/24/84
9:35 A.M.

9/5/84
P.M.

9/6/84
P.M.

PERMIT

Hair Salon

P 34119

SEWAGE DISPOSAL SYSTEM

MARYLAND STATE DEPARTMENT OF HEALTH

COMPLETE, NOT APPROVED

9/6/84 RH/CW

HOWARD COUNTY

BUREAU OF ENVIRONMENTAL HEALTH

992-2330

03-297637

INDEXED

ELLICOTT CITY

DISTRICT 3rd

DATE 7/18/84

Richard E. Myrtue

IS PERMITTED TO INSTALL ALTER X

ADDRESS 1795 Woodstock Road, Woodstock, Md. 21163

PHONE 465-8551

SUBDIVISION ROAD 1691 Woodstock Road LOT

PROPERTY OWNER Stephen Dunn

W358-4343

ADDRESS 1691 Woodstock Road, Woodstock, Md. 21163

Phone: 465-6058

IF GARBAGE GRINDER IS USED INCREASE SEPTIC TANK CAPACITY BY 50% AND ABSORPTION AREA BY 22%.

GARBAGE GRINDER? YES NO

SEPTIC TANK CAPACITY GALLONS NUMBER OF BEDROOMS

REPAIR - Call for an appointment when ground is opened up and Sanitarian will

recommend the repair system.

GROUND OK. RESERVE REPAIR AREA DOWN IN BACK LOWER PART OF LOT. 1 MORE

INSTALL 1000g TANK. TRENCHES - 150 SQFT/BEDROOM

VISUAL HOLE REQUIRED IN THAT VICINITY.

INLET 3', BOTTOM 8' w/5 FT STONE.

RUN TRENCH ALONG LEVEL GROUND BETWEEN EXISTING DRYWELL AND

THE FIRST PEACH HOLE DUG ALONG LEFT LOT LINE. TRENCH TO BE

PARALLEL TO HOUSE AND AT LEAST 40 FROM REAR OF HOUSE. CW

PLANS APPROVED BY Frank A. Skinner

DATE 7/18/84

COVER NO WORK UNTIL INSPECTED AND APPROVED.

NEITHER THE HOWARD COUNTY COUNCIL NOR THE HEALTH DEPARTMENT IS RESPONSIBLE FOR THE SUCCESSFUL OPERATION OF ANY SYSTEM.

NOTE: IF TRENCH IS USED CALL FOR INSPECTION BEFORE AND AFTER PLACING GRAVEL IN TRENCH.

BLDG. PERMIT SIGNED
AND RETURNED 9-19-84

NOTE: NO DRY WELL SHALL EXCEED 15 FOOT IN DIAMETER. NO ABSORPTION TRENCH TO EXCEED 100 FEET IN LENGTH.

NOTE: ALL PIPE FROM HOUSE TO SEPTIC TANK MUST BE CAST IRON OR SCHEDULE 40 PVC OR ABS.

PERMIT VOID AFTER THREE YEARS.

House addition
by R. Dwyer, S.R., & others

NOTE: INSTALL STAND PIPE ON SEPTIC TANK AND DRY WELL. STAND PIPES MUST BE 6 INCHES IN DIAMETER. CAST IRON, CONCRETE OR TERRA COTTA, OR PVC OR ABS ACCEPTED. IF TOP OF SEPTIC TANK IS DEEPER THAN 3 FEET MANHOLE TO GRADE REQUIRED.

*INSTALLER IS RESPONSIBLE FOR OBTAINING FINAL APPROVAL ON THIS PERMIT

*CALL 992-2330 FOR INSPECTION OF SEPTIC SYSTEMS.


EH - 2-1082

34119

HOLE 1
3' LOAM
12' SAND
3' PERC 2MIN

HOLE 2 & 3
3' LOAM
3-6' SAND
6' ROCK

HOLE 4
SAND
1' TO 10'

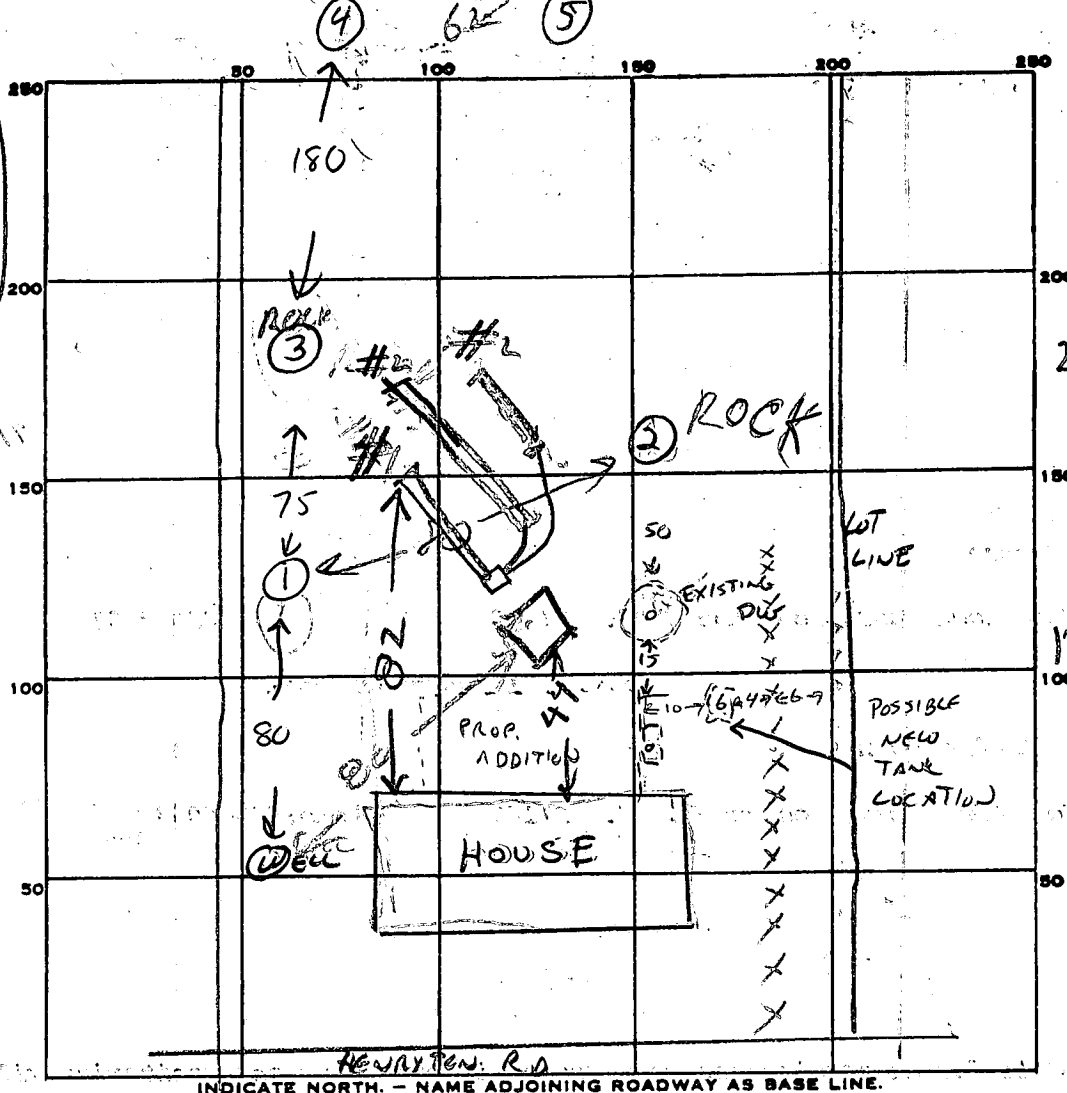

PERMIT CARD _____

SEPTIC TANK, LEVEL ☒ CLEANOUTS _____

DISTRIBUTION BOX, LEVEL _____

#1	#2	#3	FT.	TRENCH WIDTH	#1	#2	#3	TOTAL
2	2	3			42	52	29	123

TILE FIELD, DEPTH _____

GRAVEL DEPTH 5 5 5 FT. TOTAL LENGTH 42 52 29 FT. 123

NUMBER OF TRENCHES 3 TOTAL BOTTOM AREA 615

SEEPAGE PITS, INSIDE DIAMETER _____ FT. DEPTH BELOW INLET _____ FT.

INSTALL ABSORBENT AREA _____ SQ. FT.

REMARKS 1000G TANK INLET 3' BOTTOM 8' 150 SQ FT BED ROOM 5' STONE.

START TRENCH BELOW DRYWELL TOWARD LEFT LOT LINE, 8-24-84

9-5-84 TRENCHES DUG 8-9 FT DEEP. OK TO ADD GRAVEL, CURED


9/6/84 - OK TO COVER TRENCHES. VISUAL HOLE (5) IS OK

FINISH TANK HOOK UP & FILL IN OLD SYSTEM & CALL RH

NO RECORD OF FINAL INSPECTION REQUEST AS OF 7/17/95 INDEX AS NOT APPROVED (CW)

DATE SYSTEM APPROVED _____ INSPECTOR _____

Down Residence
1691 Woodstock Rd.
21163

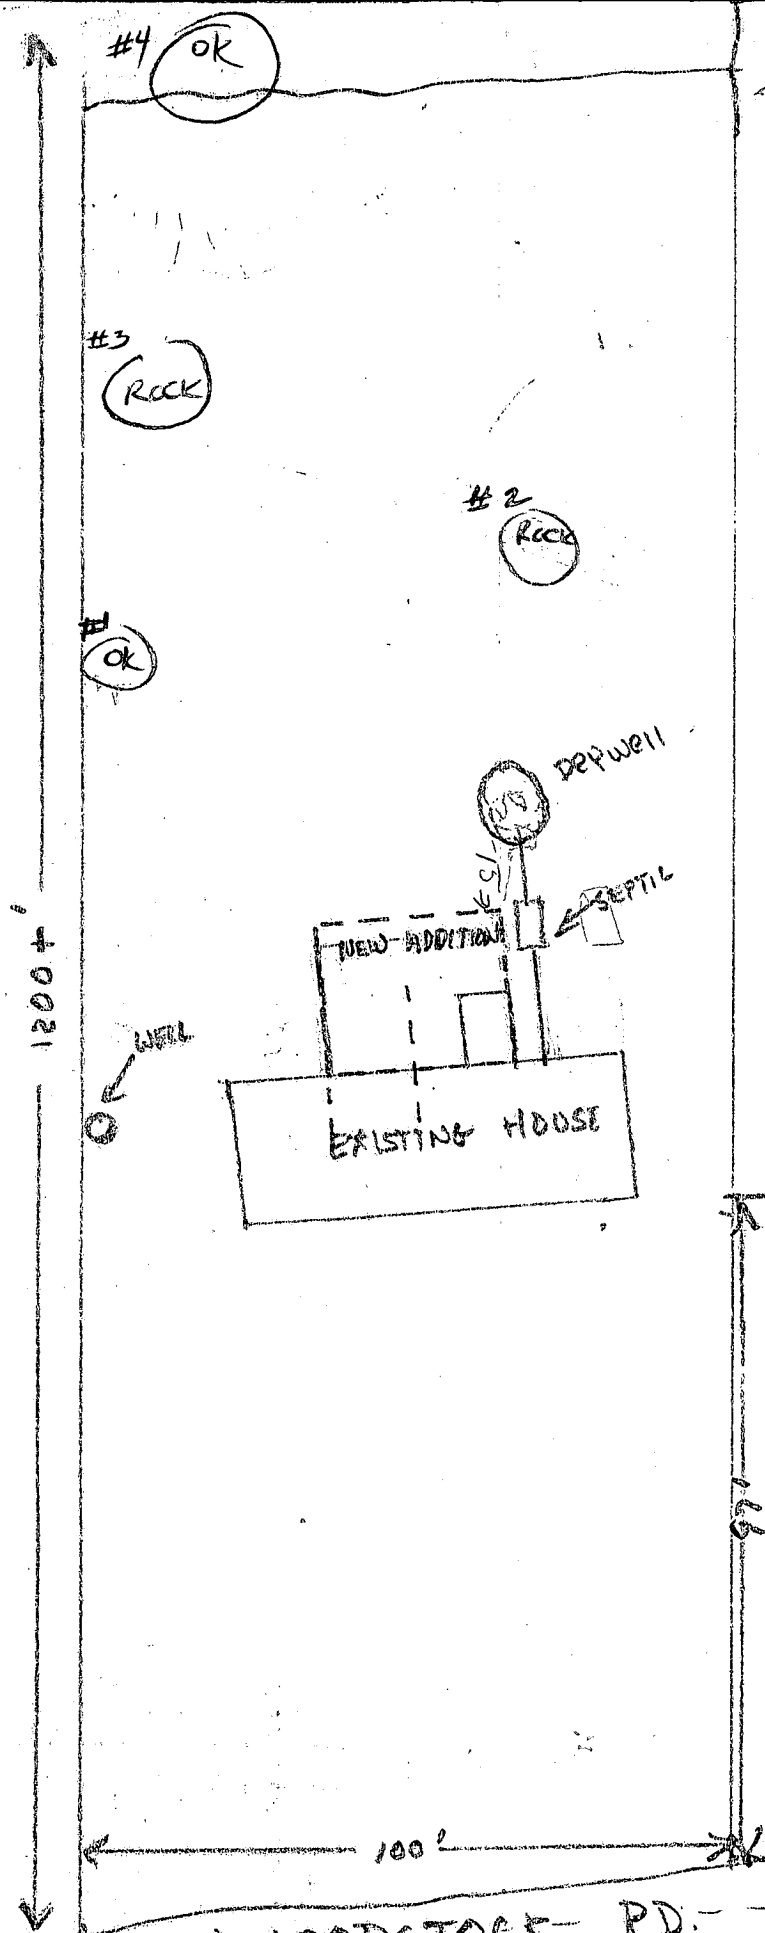

1. BASEMENT UNDER
NEW ADDITION


DICK MYRTUE
1795 WOODSTOCK RD
21163
465-8551

BLDG. PERMIT SIGNED
AND RETURNED 9-19-84

WOODSTOCK RD.

Mrs. Smith

4/11/84
Site Construction Planning

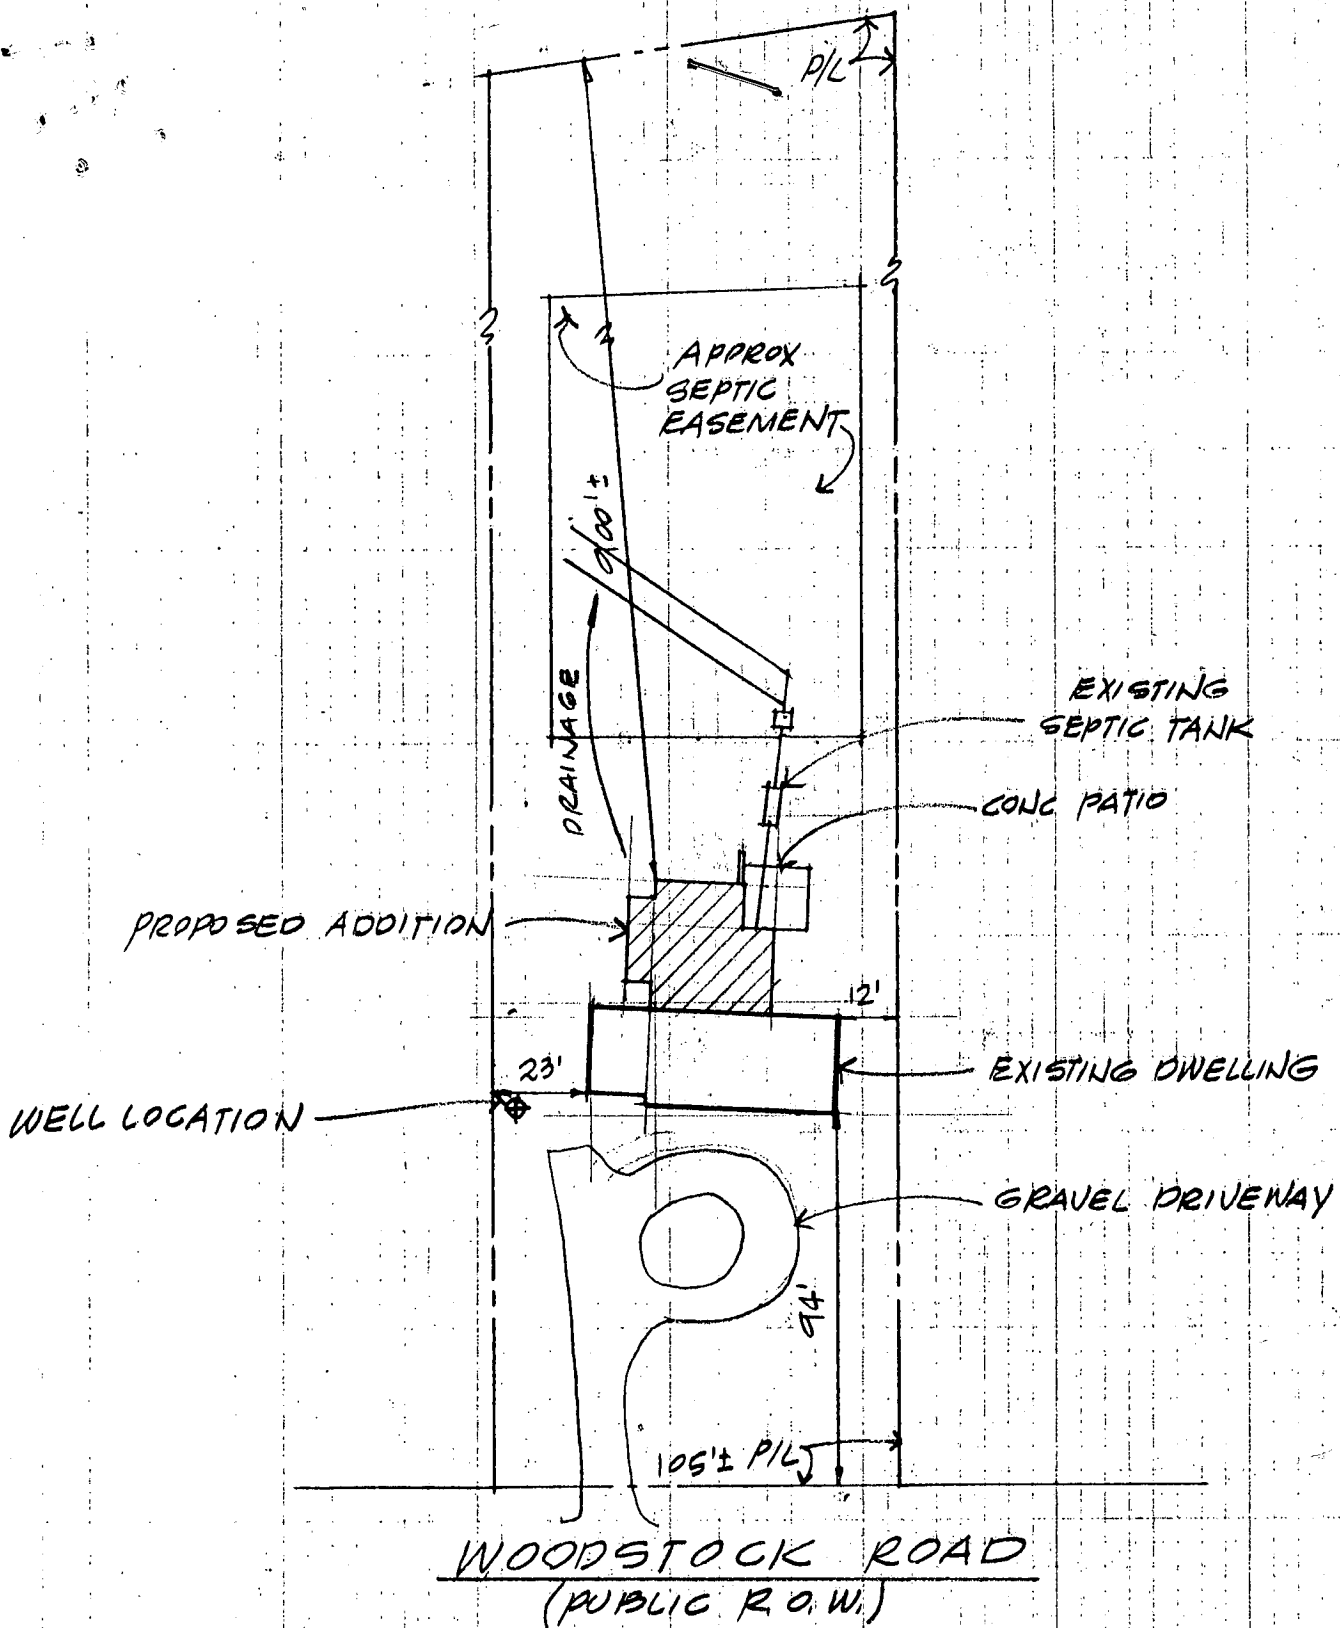

PARTIAL SITE PLAN 1"=50'
1691 WOODSTOCK RD, WOODSTOCK MD

CRAIG L STEWART
ARCHITECT PA
6209 MAIN STREET SECOND FLOOR
ELLICOTT CITY, MARYLAND 21043 (301) 461-2666



30 AUG 84

July 8, 1999

SUBJECT: Beauty Salon at 1691 Woodstock Rd.


TO: The Members of the Howard County Board of Appeals

FROM: Kenneth R. Wilzer Jr. and Susan G. Wilzer


Dear Sirs:

We own the home at 1695 Woodstock Rd., adjacent to the property in question. We have discussed the proposed Beauty Salon to be located in the residence at 1691 Woodstock Rd. with Mrs. Julieanne Dunn. We have no reservations or objections to this use of the property. We urge you to give the proposal your approval.

Sincerely,

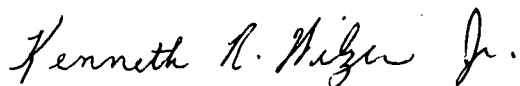

Kenneth R. Wilzer Jr.

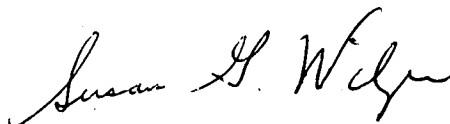

Susan G. Wilzer

1695 Woodstock Rd.
Woodstock, MD 21163
Phone: 410-465-7627

July 2, 1999

To Whom it MAY CONCERN:

Julie Dunn has my
best wishes in her endeavor
to open a beauty shop in her
home at 1691 Woodstock Rd.

We own the property at
1695 Woodstock Road next
door to The Dunes and
would love to see a Beauty
Shop out here in Woodstock
and would very likely use
the facility ourselves.

Sincerely,

Richard + Paula Myrtue

6. SPECIAL EXCEPTION REQUEST.

The undersigned hereby petition the Board of Appeals for approval of a special exception under section(s) 131.N.7 of the Zoning Regulations for the following use: SINGLE STATION HAIR SALON

7. DESCRIPTION OF PROPOSED USE:

The following items are intended to be answered by summary statements; the answers may be given below or attached to this petition form if additional space is needed:

A) The present use of the subject property: _____

SINGLE FAMILY DWELLING

B) The specific proposed use of the subject property: _____

380 SQ. FT. OF DWELLING TO BE USED AS A HAIR SALON

C) A detailed description of the proposed use, including, where applicable: types of activities; hours of operation; number of employees, occupants, and customers; quantity and types of vehicles: ACTIVITIES - HAIRCUTS, PERMS ETC.

APPROX 20-30 HRS, PER WEEK, BETWEEN 9:00 AM - 8:00 PM. MONDAY - SATURDAY. ① LICENCED HAIRPRESSER (OWNER) +

POSSIBALLY 1 ASSISTANT, CUSTOMERS: NO MORE THAN 2 AT ANY GIVEN TIME. VEHICLES: MAX 3 CARS AT ANY ONE TIME.

D) Additional information which will be needed to determine whether the special exception complies with the specific requirements of the applicable subsection within section 131.N.

of the Zoning Regulations: 1. PICTURE'S ENCLOSED WITH PROPOSAL.

2. The salon is for the convenience of an established clientele I have built over a 16 year period.

Go to page 4.