

LAYOUT 11/8/02 11:30-12 INSP 4 _____

INSP 2 _____ INSP 5 _____

INSP 3 _____ INSP 6 _____

ISSUE DATE: 10/25/02

APPROVAL DATE: 11/8/02

PERMIT

P P517973

A 34135

**ON-SITE SEWAGE DISPOSAL SYSTEM
HOWARD COUNTY HEALTH DEPARTMENT
BUREAU OF ENVIRONMENTAL HEALTH**

J. Joseph Gartland IS PERMITTED TO INSTALL ☒ ALTER ☐

ADDRESS: 1835 West Old Liberty Road PHONE NUMBER: 410-875-2400

SUBDIVISION: Lichendale Farm LOT NUMBER: 3

ADDRESS: 13775 Rover Mill Road PROPERTY OWNER: Carrigan Homes

SEPTIC TANK CAPACITY (GALLONS): 1250 OUTLET BAFFLE FILTER REQUIRED ☐

PUMP CHAMBER CAPACITY (GALLONS): N/A COMPARTMENTED TANK REQUIRED ☐

NUMBER OF BEDROOMS: 4

SQUARE FEET PER BEDROOM: 180

LINEAR FEET OF TRENCH REQUIRED: 240 HOUSE SERVED BY PUBLIC WATER ☐

TRENCHES:	Trench to be 3.0 feet wide. Inlet 3.0 feet below original grade. Bottom maximum depth 5.0 feet below original grade. Effective area begins at 3.0 feet below original grade. 2.0 feet of stone below distribution pipe.
LOCATION:	Place the distribution box 70' from the intersection of the 298.39' and 255.05' lot lines and 110' from the lot corner nearest the well. Run (3) trenches on contour toward driveway.
NOTES:	

PLANS APPROVED: MER OK 8/6/02 (50) DATE: 7/2/02

NOTES: PERMIT VOID AFTER 2 YEARS
CONTRACTOR IS RESPONSIBLE FOR SCHEDULING A PRE-CONSTRUCTION INSPECTION FOR ALL INSTALLATIONS
WATERTIGHT SEPTIC TANKS REQUIRED
ALL PARTS OF SEPTIC SYSTEM SHALL BE 100 FEET FROM ANY WATER WELL UNLESS SPECIFICALLY AUTHORIZED
MANHOLE RISERS REQUIRED ON ALL SEPTIC TANKS AND PUMP CHAMBERS UNLESS SPECIFICALLY AUTHORIZED
CONTRACTOR RESPONSIBLE FOR COMPLIANCE WITH APPLICABLE REGULATIONS, GUIDELINES AND THE TERMS OF THIS PERMIT


**NEITHER THE HOWARD COUNTY COUNCIL NOR THE HEALTH DEPARTMENT IS
RESPONSIBLE FOR THE SUCCESSFUL OPERATION OF ANY SYSTEM
PERMITTEE RESPONSIBLE FOR OBTAINING FINAL APPROVAL ON THIS PERMIT
ALL 410-313-2640 FOR INSPECTION OF SEPTIC SYSTEM**

**BUILDING PERMIT SIGNED
AND RETURNED**

10-16-02 800 138 8666 - PROPOSED TANK
12-12-02 800 139 6916 - ALG POOL

A34135

NOT TO SCALE

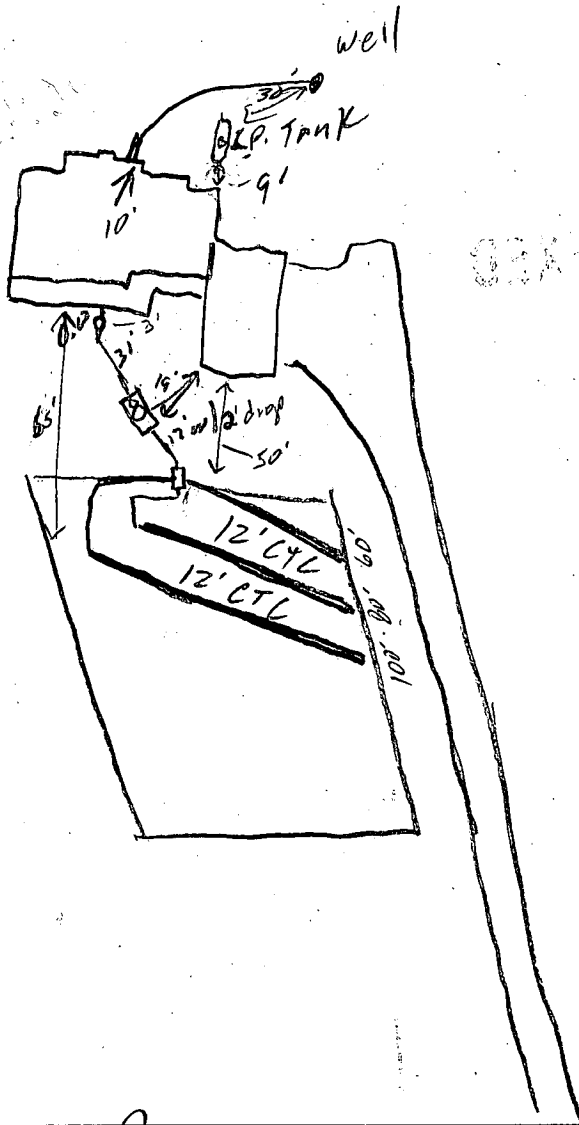

River M. H.

ROAD

TRENCH/DRAINFIELD DATA		
WIDTH	INLET	BOTTOM
3'	3'	5'
NUMBER OF TRENCHES		3
TOTAL LENGTH		240'
ABSORPTION AREA		720 sq
DISTRIBUTION BOX LEVEL		✓
DISTRIBUTION BOX BAFFLE		✓
DISTRIBUTION BOX PORT		—

SEPTIC TANK DATA	
SEPTIC TANK 1 LEVEL ✓	
CAPACITY	1250 GAL
SEAM LOC	Top
TANK LID DEPTH	10 1/2'
BAFFLES	✓
BAFFLE FILTER	✓
MANHOLE LOC	Center
6" PORT LOC	Front
WATERTIGHT TEST	
SEPTIC TANK 2 LEVEL	
CAPACITY	_____ GAL
SEAM LOC	_____
TANK LID DEPTH	_____
BAFFLES	_____
BAFFLE FILTER	_____
MANHOLE LOC	_____
6" PORT LOC	_____
WATERTIGHT TEST	

PRE-CONSTRUCTION 11/8/02 Lot stake, contours accurate, house corr changed.
 Trench layout per B.P. Tank set (SO) 11/8/02 OK to cover
 INSTALLATION all work (SO)

FINAL INSPECTOR

[Signature]


DATE OF APPROVAL

11/8/02

BUILDING PERMIT SIGNED
 APPROVED BY
 11/8/02

GENERAL NOTES:

- 1) THIS LOCATION DRAWING IS PREPARED FOR THE BENEFIT OF THE CLIENT SIGNING THE HOUSE LOCATION SURVEY APPROVAL FORM INSOFAR AS IT IS REQUIRED BY A LENDER OR TITLE INSURANCE COMPANY OR ITS AGENTS IN HEREON. UNLESS INDICATED AS BEING A BOUNDARY SURVEY, THIS LOCATION DRAWING IS NOT INTENDED FOR USE IN THE ESTABLISHMENT OF PROPERTY LINES AND IS NOT TO BE RELIED UPON FOR THE ESTABLISHMENT OR LOCATIONS OF FENCES, GARAGES, BUILDINGS OR OTHER EXISTING OR FUTURE IMPROVEMENTS. AS A RESULT, THIS LOCATION DRAWING DOES NOT PROVIDE FOR ACCURATE IDENTIFICATION OF PROPERTY LINES, BUT SUCH IDENTIFICATION MAY NOT BE REQUIRED FOR THE TRANSFER OF TITLE OR SECURING FINANCING FOR RE-FINANCING.
- 2) SUBJECT PROPERTY IS SHOWN IN ZONE C ON THE NATIONAL FLOOD INSURANCE PROGRAM FLOOD INSURANCE RATE MAP OF HOWARD COUNTY, MARYLAND, COMMUNITY PANEL No. 2400440014 B EFFECTIVE DEC. 4, 1986.
- 3) THE OFFSETS FROM BUILDING LINE TO PROPERTY LINE AS SHOWN ON THE PLAT HEREON ARE TO AN ACCURACY OF PLUS OR MINUS 1' (±)
- 4) NO TITLE REPORT FURNISHED. SUBJECT TO ALL EASEMENTS, RIGHTS OF WAY AND CONDITIONS OF RECORD.

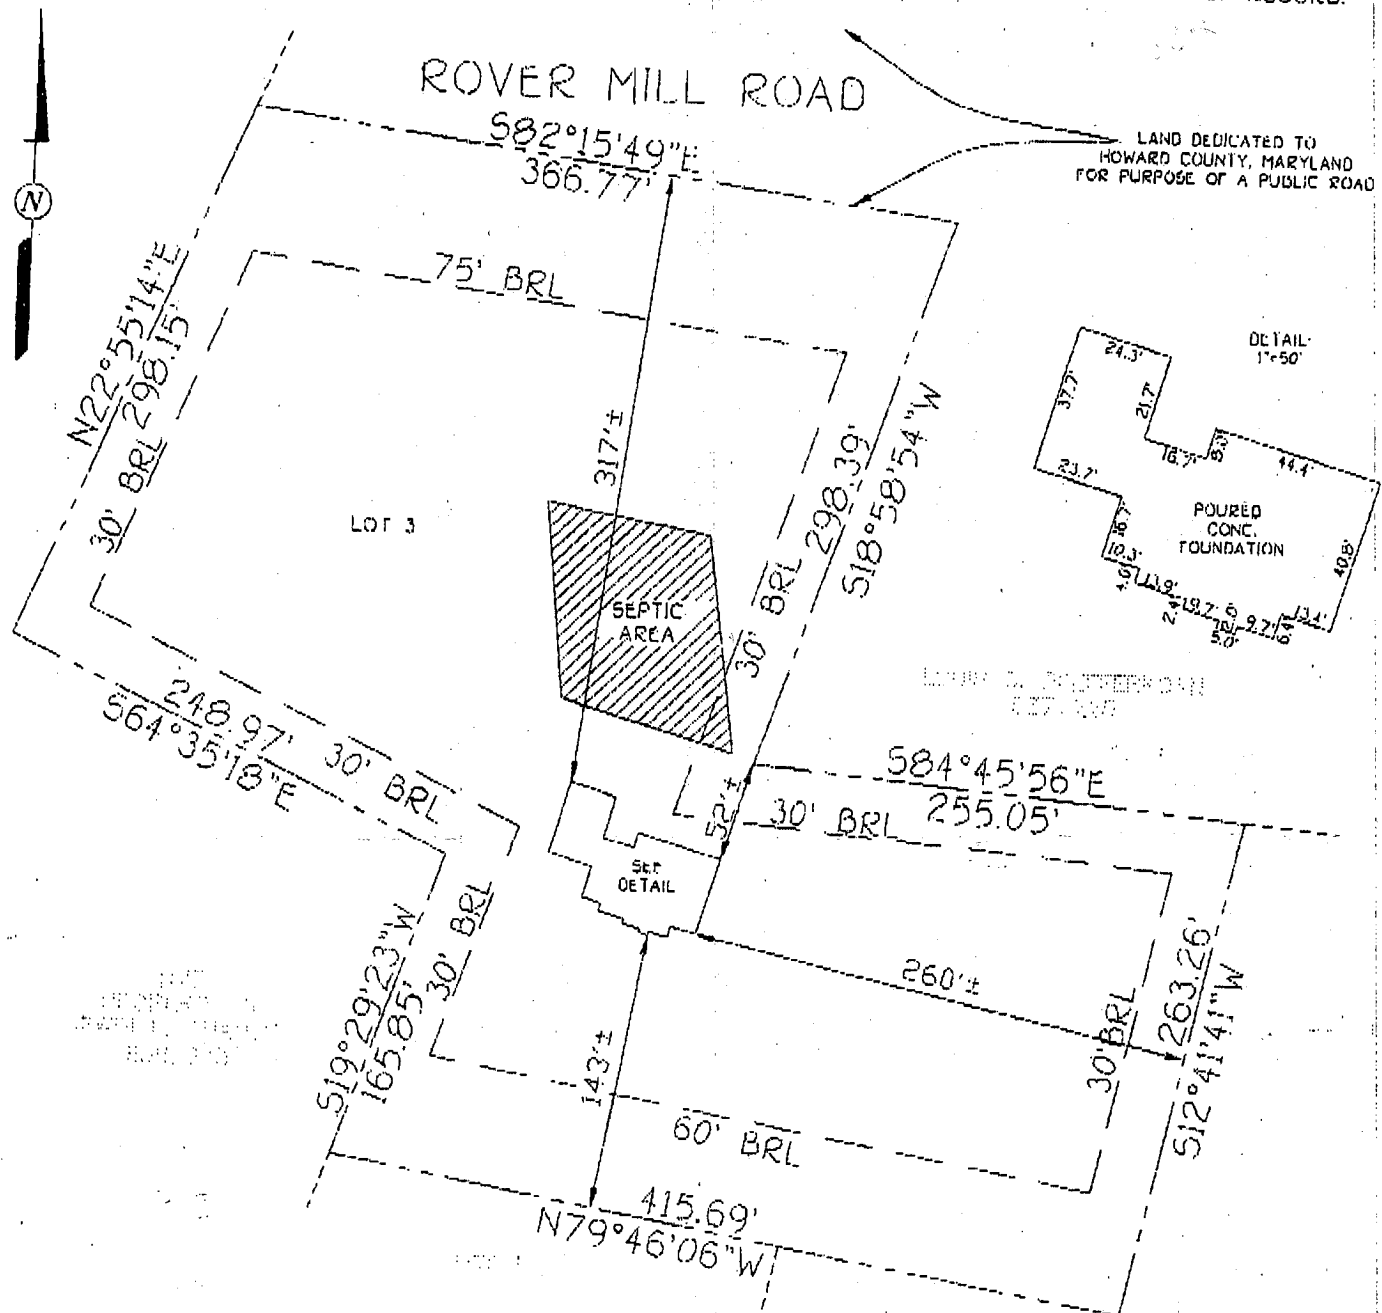


LOT 3
LICHENDALE FARM
LOTS 1-4
THIRD-ELECTION DISTRICT
HOWARD COUNTY, MARYLAND
PLAT No. 6071
B.R.L.-BUILDING RESTRICTION LINE
TOP OF FOUNDATION ELEV. 535.9±

8/28/02
JB Wall check O.K.

13775
Rover Mill Rd.
Permit # 136464

FISHER, COLLINS & CARTER, INC.
CIVIL ENGINEERING CONSULTANTS & LAND SURVEYORS
CENTENNIAL SQUARE OFFICE PARK - 10272 BALTIMORE NATIONAL PIKE
ELLCOTT CITY, MARYLAND 21042
(410) 461-2855

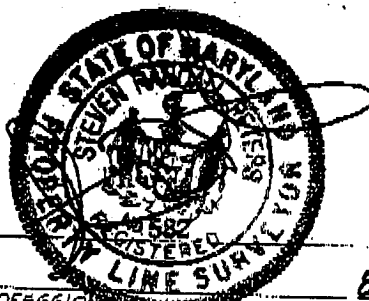


PROFESSIONAL SURVEYOR DATE 8/5/02
REG. 302

HOUSE LOCATION DRAWING

FOUNDATION LOCATION: 7/31/02
FINAL LOCATION:
BOUNDARY SURVEY:

SCALE: 1"=100'
DATE: 8/5/02
DRAWN BY: D.B.
CHECKED BY:
PROJECT No.: 61772

J. Joseph
(Seal) David Land Planning

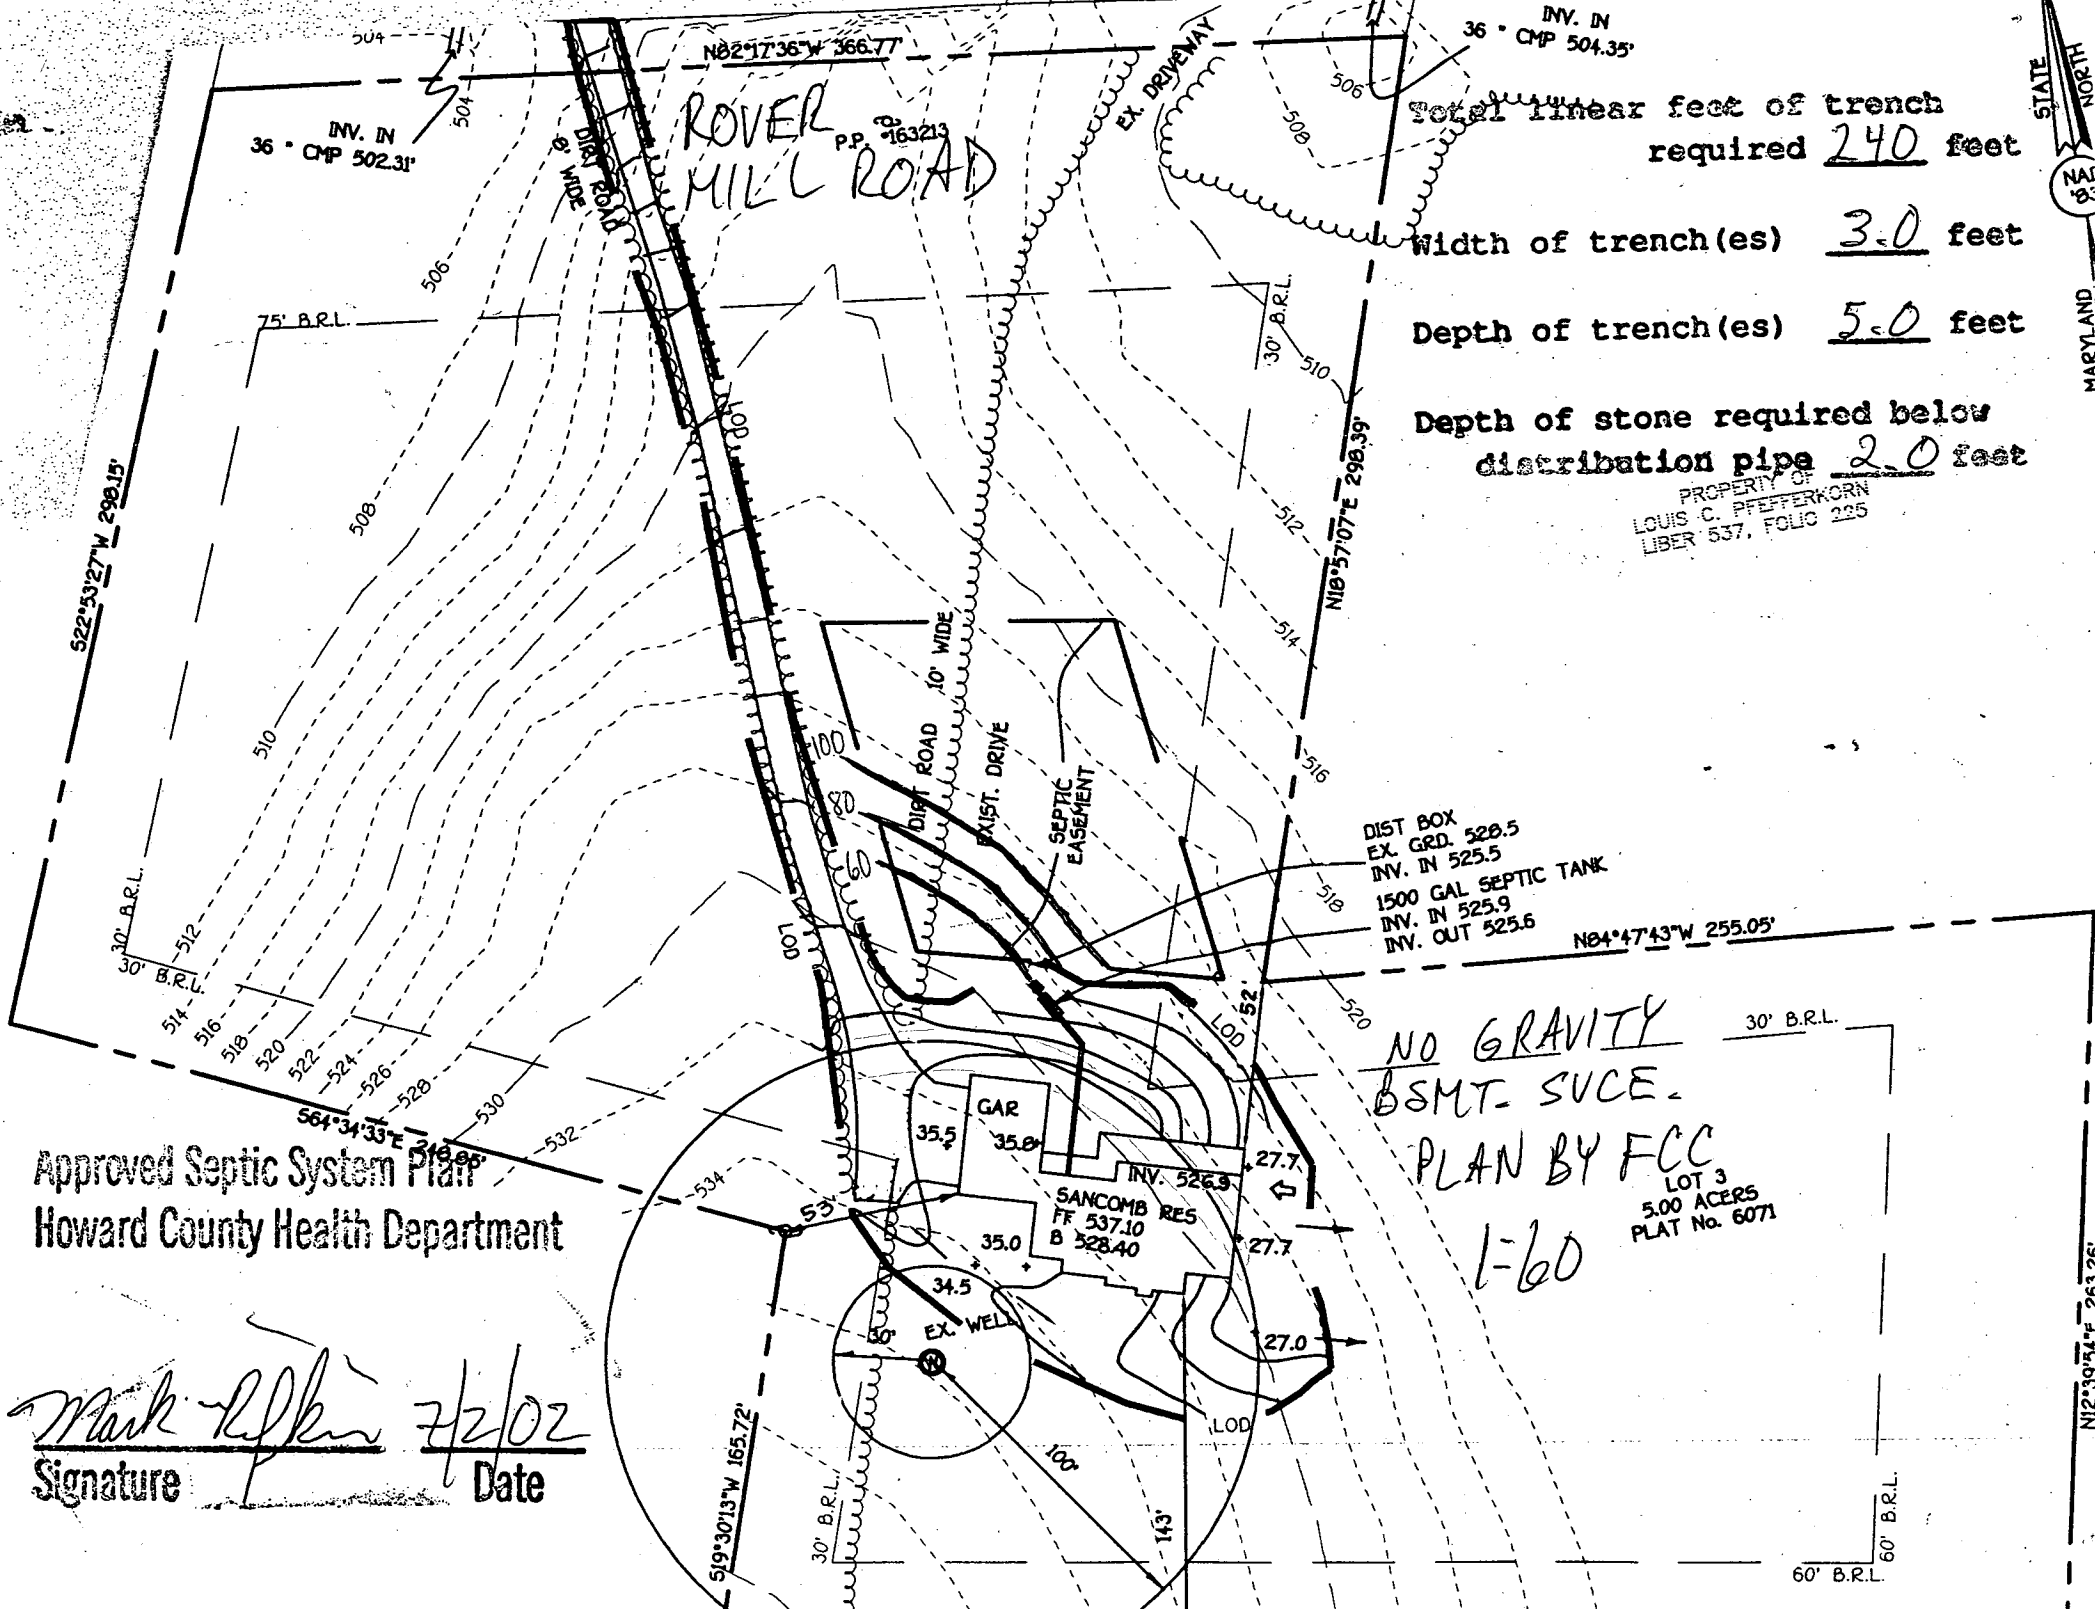

INV. IN
36" CMP 502.31"

N82°17'36"W 366.77'

ROVER
MILL ROAD

PP. 163213

INV. IN
36" CMP 504.35"

Total linear feet of trench
required 240 feet

Width of trench(es) 3.0 feet

Depth of trench(es) 5.0 feet

Depth of stone required below
distribution pipe 2.0 feet

PROPERTY OF
LOUIS C. PFEFFERKORN
LIBER 537, FOLIO 225

DIST BOX
EX. GRD. 528.5
INV. IN 525.5
1500 GAL SEPTIC TANK
INV. IN 525.9
INV. OUT 525.6

NO GRAVITY
BSMT. SUCE.
PLAN BY FCC
1-60

LOT 3
5.00 ACERS
PLAT No. 6071

Approved Septic System Plan
Howard County Health Department

Signature Mark L. Lippin Date 7/2/02

STATE NORTH
MARYLAND

N12°39'54"W 261.26'

HOWARD COUNTY
PERMIT APPLICATION

PERMIT NUMBER

000136464

Building Address 13775 RIVER ROAD
UPPER FRIENDLY, MD 21744

Suite/Apt. #: _____ SDP/WP/Petition #: _____

Census Tract 6030 Subdivision LICHENDALE

Section _____ Area _____ Lot 3 Farm

Tax Map 15 Parcel 168 Grid 13

Zoning RR Map Coordinates 964 Lot size 5.0 A

Existing Use Single lot

Proposed Use to build 4 BR 3 Bath

Estimated Construction Cost \$ 200,000

Description of Work Attached 3 car garage

Attached 3 car garage

Occupant or Tenant _____

Contact Name _____

Address _____

City _____ State _____ Zip Code _____

Phone _____ Fax _____

Property Owner's Name Carrigan Homes Inc

Address 992 Co. Rd. 1

City ELLICOTT CITY State MD Zip Code 21042

Home Phone 465-7755 Work Phone _____

Applicant's Name & Mailing Address, (if other than stated hereon):

Phone _____ Fax _____

Contractor Company Same

Contact Person _____

Address _____

City _____ State _____ Zip Code _____

License No. _____

Phone _____ Fax _____

Engineer or Architect Company _____

Contact Person _____

Address _____

City _____ State _____ Zip Code _____

Phone _____ Fax _____

BUILDING DESCRIPTION - COMMERCIAL

Building Characteristics

Height: _____

No. of stories: _____

Gross area, sq. ft. per floor: _____

Use group: _____

Construction type:

_____ Reinforced Concrete

_____ Structural Steel

_____ Masonry

_____ Wood Frame

_____ State Certified Modular

Utilities

Water Supply:

_____ Public

_____ Private

Sewage Disposal:

_____ Public

_____ Private

Electric Yes ☐ No ☐

Gas Yes ☐ No ☐

Heating System:

Electric ☐ Oil ☐

Natural Gas ☐

Propane Gas ☐

Sprinkler system: N/A ☐

_____ Full

_____ Partial

_____ Other Suppression

of Heads _____

BUILDING DESCRIPTION - RESIDENTIAL

Building Characteristics

SF Dwelling ☒ SF Townhouse ☐

Depth Width

1st floor: _____

2nd floor: _____

Basement: _____

Finished Basement ☐ Unfinished Basement ☒

Crawl space ☐ Slab on Grade ☐

No. of Bedrooms 4

Multi-family dwellings:

No. of efficiency units: _____

No. of 1 BR units: _____

No. of 2 BR units: _____

No. of 3 BR units: 4

Other Structure: _____

Dimensions: _____

Footings: _____

Roof: _____

_____ State Certified Modular

_____ Manufactured Home

Utilities

Water Supply:

_____ Public

☒ Private

Sewage Disposal:

_____ Public

☒ Private

Electric Yes ☒ No ☐

Gas Yes ☐ No ☐

Heating System:

Electric ☐ Oil ☐

Natural Gas ☐

Propane Gas ☐

Sprinkler system: N/A ☐

_____ NFPA #13D

_____ NFPA #13R

_____ Other: _____

THE UNDERSIGNED HEREBY CERTIFIES AND AGREES AS FOLLOWS: (1) THAT HE/SHE IS AUTHORIZED TO MAKE THIS APPLICATION; (2) THAT THE INFORMATION IS CORRECT; (3) THAT HE/SHE WILL COMPLY WITH ALL REGULATIONS OF HOWARD COUNTY WHICH ARE APPLICABLE THERETO; (4) THAT HE/SHE WILL PERFORM NO WORK ON THE ABOVE REFERENCED PROPERTY NOT SPECIFICALLY DESCRIBED IN THIS APPLICATION; (5) THAT HE/SHE GRANTS COUNTY OFFICIALS THE RIGHT TO ENTER ONTO THIS PROPERTY FOR THE PURPOSE OF INSPECTING THE WORK PERMITTED AND POSTING NOTICES.

Dan Kelly
Applicant's Signature

Carrigan Homes Inc.
Title/Company

7/2/02
Date

Dan Kelly
Print Name

6-24-02
Date

Checks payable to: DIRECTOR OF FINANCE OF HOWARD COUNTY
** PLEASE WRITE NEATLY AND LEGIBLY. **

FOR OFFICE USE ONLY

AGENCY

DATE

SIGNATURE APPROVAL

DPZ SETBACK INFORMATION

PROPERTY ID#

54895

**HOWARD COUNTY HEALTH DEPARTMENT
BUREAU OF ENVIRONMENTAL HEALTH
WATER AND SEWERAGE PROGRAM
TEL: (410)313-2640 FAX: (410)313-2648**

Information Form for the Installation of the Well Pump, Pitless Adapter, and Supply Piping

NOTE: The installer is responsible for requesting an inspection prior to 9 am on the day of the desired inspection. No work is to be covered until approved by the Health Department. All installations must comply with the National Standard Plumbing Code (NSPC, as amended locally) and COMAR 26.04.04 (MD Well Construction Regulations). Submission of a complete form is required prior to Use and Occupancy approval.

Company Name: J. Joseph Gartland Inc Telephone #: 410-875-2400
Address: 1435 W. Old Liberty Rd
Westminster Md 21157

(Must circle one) Licensed Plumber Licensed Well Driller Licensed Well Pump Installer
License # and name of individual responsible for the field installation:

Name (Print): Eric Gartland License# 1713

*A licensed individual must perform the actual installation. Apprentices must be under the direct supervision of a licensed journeyman or master plumber, pump installer or well driller. Licenses may be subjected to field verification.

Name of Property Owner: Garrison Homes Telephone #: 410-465-7755
Subdivision: Lichenhite farm Lot #: 3 Well Tag #: HO-94-2760
Site Address: 13775 Rye-mill Rd
West Friendship Md

Submersible Pump Data

Make: Goulds
Model #: 25805422
Pump Capacity 7 GPM
Well Yield: 15 GPM

Pitless Adapter

Make: Howard
Model#: PT 80
Depth: 42 (36" min)
NSF approved: ✓

Well Cap and Electric Conduit

Two piece watertight cap: ✓
Screened, vented well cap: ✓
Cap secured to casing: ✓
Conduit min 1 1/2" B.G.: ✓
Conduit secured to well cap: ✓

Depth of well encountered at time of pump installation: _____ (feet)
If pump capacity exceeds well yield, a low water cut off switch is required by NSPC 1990 Section 17.8.4

Torque arrestors or Cable guards are required - Must circle one

Safety rope, if used, attached to inside of well casing with eye bolt _____

Piping to house

Type: Plastic
PSI: 160 (160 psi min)
Depth of supply line: 42 (36" min)

House Connection

PVC sleeved to undisturbed soil at wall penetration: ✓
Approximate length of sleeve: 6
Sleeve caulked and sealed properly: yes

The water supply line is required to be at least ten feet from the septic tank, pump chamber, sewage piping, distribution box, drainfields, and sewage reserve area. If this cannot be accomplished, contact this office for approval prior to installation.

[Signature]
Signature of company representative responsible for installation

1-3-03
date

For Health Department Use Only - Not to be completed by Installer

Date Insp. Requested: 11/12/02 Date Insp. Approved: 11/12/02 (50) SRK
Inspection Data: Pitless adapter and water supply line at least 36" below grade ✓
Two piece cap installed and attached to casing securely ✓
Elec. conduit extends at least 18" below grade/attached to cap properly ✓
Safety rope installed inside of well casing ✓
Correct well tag attached properly and casing 8" above finished grade ✓
Water supply line sleeved adequately at house connection ✓
Adequate grout observed below pitless adapter ✓

C 1 07849		SEQUENCE NO. (MDE USE ONLY)		STATE OF MARYLAND WELL COMPLETION REPORT FILL IN THIS FORM COMPLETELY. PLEASE TYPE		THIS REPORT MUST BE SUBMITTED AFTER WELL IS COMPLETED. OKSRK 9/27/00	
1 2 3 6						COUNTY NUMBER A 34135	
ST/CO USE ONLY DATE Received MM DD YY 8 11 00		DATE WELL COMPLETED 8 11 00		Depth of Well 22 250 26 (TO NEAREST FOOT)		PERMIT NO. FROM "PERMIT TO DRILL WELL" HO-04-2700 28 29 30 31 32 33 34 35 36 37	
OWNER last name sharp		first name Gue		STREET OR RFD ROVER MILL ROAD		TOWN West Friendship	
SUBDIVISION Lichendale Farm		SECTION		LOT 3			
WELL LOG Not required for driven wells		GROUTING RECORD WELL HAS BEEN GROUTED (Circle Appropriate Box) YES NO (Y) (N) TYPE OF GROUTING MATERIAL (Circle one) CEMENT (CM) BENTONITE CLAY (BC) NO. OF BAGS 22 NO. OF POUNDS 2668 GALLONS OF WATER 132 DEPTH OF GROUT SEAL (to nearest foot) from 0 ft. to 37 ft. (enter 0 if from surface)		C 3 PUMPING TEST HOURS PUMPED (nearest hour) 03 PUMPING RATE (gal. per min.) 15. METHOD USED TO MEASURE PUMPING RATE 5 gcl WATER LEVEL (distance from land surface) BEFORE PUMPING 31 ft. WHEN PUMPING 51 ft. TYPE OF PUMP USED (for test) A air P piston T turbine C centrifugal R rotary O other (describe below) J jet S submersible			
STATE THE KIND OF FORMATIONS PENETRATED, THEIR COLOR, DEPTH, THICKNESS AND IF WATER BEARING		Casing types insert appropriate code below MAIN CASING TYPE ST Nominal diameter top (main) casing (nearest inch) 06 Total depth of main casing (nearest foot) 70		Casing RECORD (ST) (CO) (PL) (OT) STEEL CONCRETE PLASTIC OTHER			
DESCRIPTION (Use additional sheets if needed)		FEET FROM TO		check if water bearing			
Brown shale		0 64					
Gray		64 80					
Brown		80 81		✓			
Gray		81 90					
White		90 91		✓			
Gray		91 190					
White		190 191		✓			
Gray		191 250					
OTHER CASING (if used) diameter inch depth (feet) from to		EACH CASING					
screen type or open hole insert appropriate code below (ST) (BR) (HO) STEEL BRASS OPEN (PL) (OT) PLASTIC HOLE OTHER		C 2 DEPTH (nearest ft.) 1 2 3 4 5 6 7 8 9 11 15 17 21 23 24 26 30 32 36 38 39 41 45 47 51 SLOT SIZE 1 2 3 DIAMETER OF SCREEN (NEAREST INCH) 56 60 from to		PUMP INSTALLED DRILLER INSTALLED PUMP YES NO IF DRILLER INSTALLS PUMP, THIS SECTION MUST BE COMPLETED FOR ALL WELLS. TYPE OF PUMP INSTALLED PLACE (A,C,J,P,R,S,T,O) IN BOX 29 CAPACITY: GALLONS PER MINUTE (to nearest gallon) 31 35 PUMP HORSE POWER 37 41 PUMP COLUMN LENGTH (nearest ft.) 43 47 CASING HEIGHT (circle appropriate box and enter casing height) (+) above LAND SURFACE (-) below 02 (nearest foot) 50 51			
NUMBER OF UNSUCCESSFUL WELLS:		WELL HYDROFRACTURED YES NO (Y) (N)		CIRCLE APPROPRIATE LETTER A A WELL WAS ABANDONED AND SEALED WHEN THIS WELL WAS COMPLETED E ELECTRIC LOG OBTAINED P TEST WELL CONVERTED TO PRODUCTION WELL			
I HEREBY CERTIFY THAT THIS WELL HAS BEEN CONSTRUCTED IN ACCORDANCE WITH COMAR 26.04.04 "WELL CONSTRUCTION" AND IN CONFORMANCE WITH ALL CONDITIONS STATED IN THE ABOVE CAPTIONED PERMIT, AND THAT THE INFORMATION PRESENTED HEREIN IS ACCURATE AND COMPLETE TO THE BEST OF MY KNOWLEDGE.		DRILLERS LIC. NO. MS D 009 DRILLERS SIGNATURE (MUST MATCH SIGNATURE ON APPLICATION) LIC. NO. D		MDE USE ONLY (NOT TO BE FILLED IN BY DRILLER) T (E.R.O.S.) W Q 70 72 74 75 76 TELESCOPE CASING LOG INDICATOR OTHER DATA			
SITE SUPERVISOR (sign. of driller or journeyman responsible for sitework if different from permittee)				LOCATION OF WELL ON LOT SHOW PERMANENT STRUCTURES AND INDICATE NOT LESS THAN TWO DISTANCES (MEASUREMENTS TO WELL) NO Survey Stakes			

Well Permit No. HO - 94-2760
Location of property (road) Power mill Road
Subdivision Lichendale farm Lot 3 Block Plat Sec.
Well Driller Compton Owner Sharp

Depth of well 250'
Distance of measuring point (M.P.) above ground 2'
Static water level (S.W.L.) below M.P. 31'

Time pump started 9:00 Pumping rate 20
Total time 15 min to reach pumping water level 51 ft. below M.P.

[illegible]

13635

SEQUENCE NO.
(MDE USE ONLY)STATE OF MARYLAND
PERMIT TO DRILL WELL

STATE PERMIT NUMBER

HO-94-2760

fill in this form completely

#313694 please print or type

Date Received (APA)

07 20 00

8 MM DD YY 13

OWNER INFORMATION

15 Last Name SHARP Owner First Name SUE 34

36 Street or RFD 13750 TRIDELPHIA RD 55

57 Town ELLICOTT CITY MD 21042 70 State 72 Zip 76

DRILLER INFORMATION

Driller's Name Allen Compton 76 License No. M S D 009 81

Firm Name Fogle's Well Drilling

Address 580 Obrecht rd Sykesville

Signature Allen Compton 720-00 Date

B 2 WELL INFORMATION 1 2 APPROX. PUMPING RATE 5 GAL. PER MIN. 8 12

AVERAGE DAILY QUANTITY NEEDED 500 GAL. PER DAY 14 20

USE FOR WATER (CIRCLE APPROPRIATE BOX)

- ☒ DOMESTIC POTABLE SUPPLY & RESIDENTIAL IRRIGATION
- ☐ FARMING (LIVESTOCK WATERING & AGRICULTURAL IRRIGATION)
- ☐ INDUSTRIAL, COMMERCIAL, DEWATERING
- ☐ PUBLIC WATER SUPPLY WELL
- ☐ TEST, OBSERVATION, MONITORING
- ☐ GEO-THERMAL

APPROXIMATE DEPTH OF WELL 300 FEET 24 28

APPROXIMATE DIAMETER OF WELL 6 INCH NEAREST

METHOD OF DRILLING (circle one)

BORED (or Augered) JETTED Jetted & DRIVEN

30 AIR-ROTARY AIR-PERCussion ROTARY (Hydraulic Rotary)

37 GABLE REVERSE-ROTARY Drive-POINT

other

REPLACEMENT OR DEEPEMED WELLS
(CIRCLE APPROPRIATE BOX)

- ☒ THIS WELL WILL NOT REPLACE AN EXISTING WELL
- ☐ THIS WELL WILL REPLACE A WELL THAT WILL BE ABANDONED AND SEALED
- 39 ☐ THIS WELL WILL REPLACE A WELL THAT WILL BE USED AS A STANDBY-CONTACT LOCAL APPROVING AUTHORITY FOR POLICY ON STANDBY WELLS
- ☐ THIS WELL WILL DEEPEN AN EXISTING WELL

PERMIT NUMBER OF WELL TO BE REPLACED OR DEEPEMED (IF AVAILABLE) 41 52

Not to be filled in by driller (MDE OR COUNTY USE ONLY)

APPROP. PERMIT NUMBER 54 G A P 63

PERMIT No. HO-94-2760 70 71 72 73 74 75 76 77 78 79

SPECIAL CONDITIONS

NOTE - APPROVING AUTHORITIES SHOULD USE SEPARATE SHEET IF NEEDED -

B 3

LOCATION OF WELL

8 COUNTY Howard 21

23 SUBDIVISION Lichendale Farm 42


SECTION 44 46 LOT 3 48 50

52 NEAREST TOWN West Friendship 71

MILES FROM TOWN (enter 0 if in town) 4 M I 73 76 77 78


B 4

1 2 DIRECTION OF WELL FROM TOWN (CIRCLE BOX)

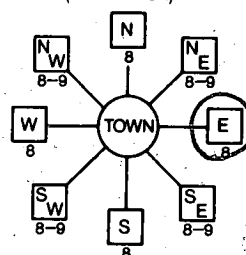

11 NEAR WHAT ROAD ROVER mill rd. 30

ON WHICH SIDE OF ROAD (CIRCLE APPROPRIATE BOX)

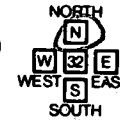

34 440 37 DISTANCE FROM ROAD 440 FT 38 39 ENTER FT OR MI

TAX MAP: BLK: PARCEL

NOT TO BE FILLED IN BY DRILLER
HEALTH DEPARTMENT APPROVAL

COUNTY NAME HOWARD COUNTY NO. A 34135

STATE SIGNATURE INSERT S 41

DATE ISSUED 07 25 00 Steven R. King 07 25 01 43 MM DD YY 48 CO SIGNATURE EXP. DATE

NORTH GRID 532 0 0 0 EAST GRID 0802 0 0 0 50 55 57 63

SHOW MAJOR FEATURES OF BOX & LOCATE WELL WITH AN X

SOURCES OF DRILLING WATER


- 1.
- 2.
- 3.

WRITE THE BOX NUMBER FROM THE MAP HERE

E 800 N 530


DRAW A SKETCH BELOW SHOWING LOCATION OF WELL IN RELATION TO NEARBY TOWNS AND ROADS AND GIVE DISTANCE FROM WELL TO NEAREST ROAD JUNCTION

N

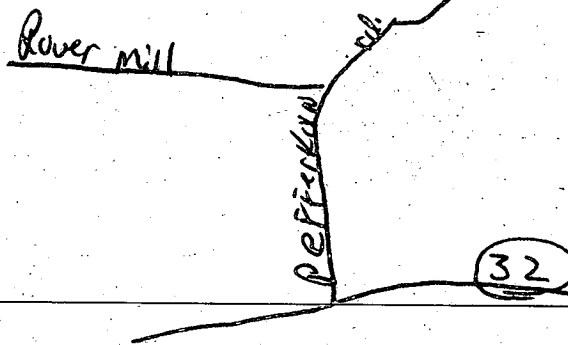

ROVER MILL RD.

7/25/00
Proposed
Well site
on as SRU
staked

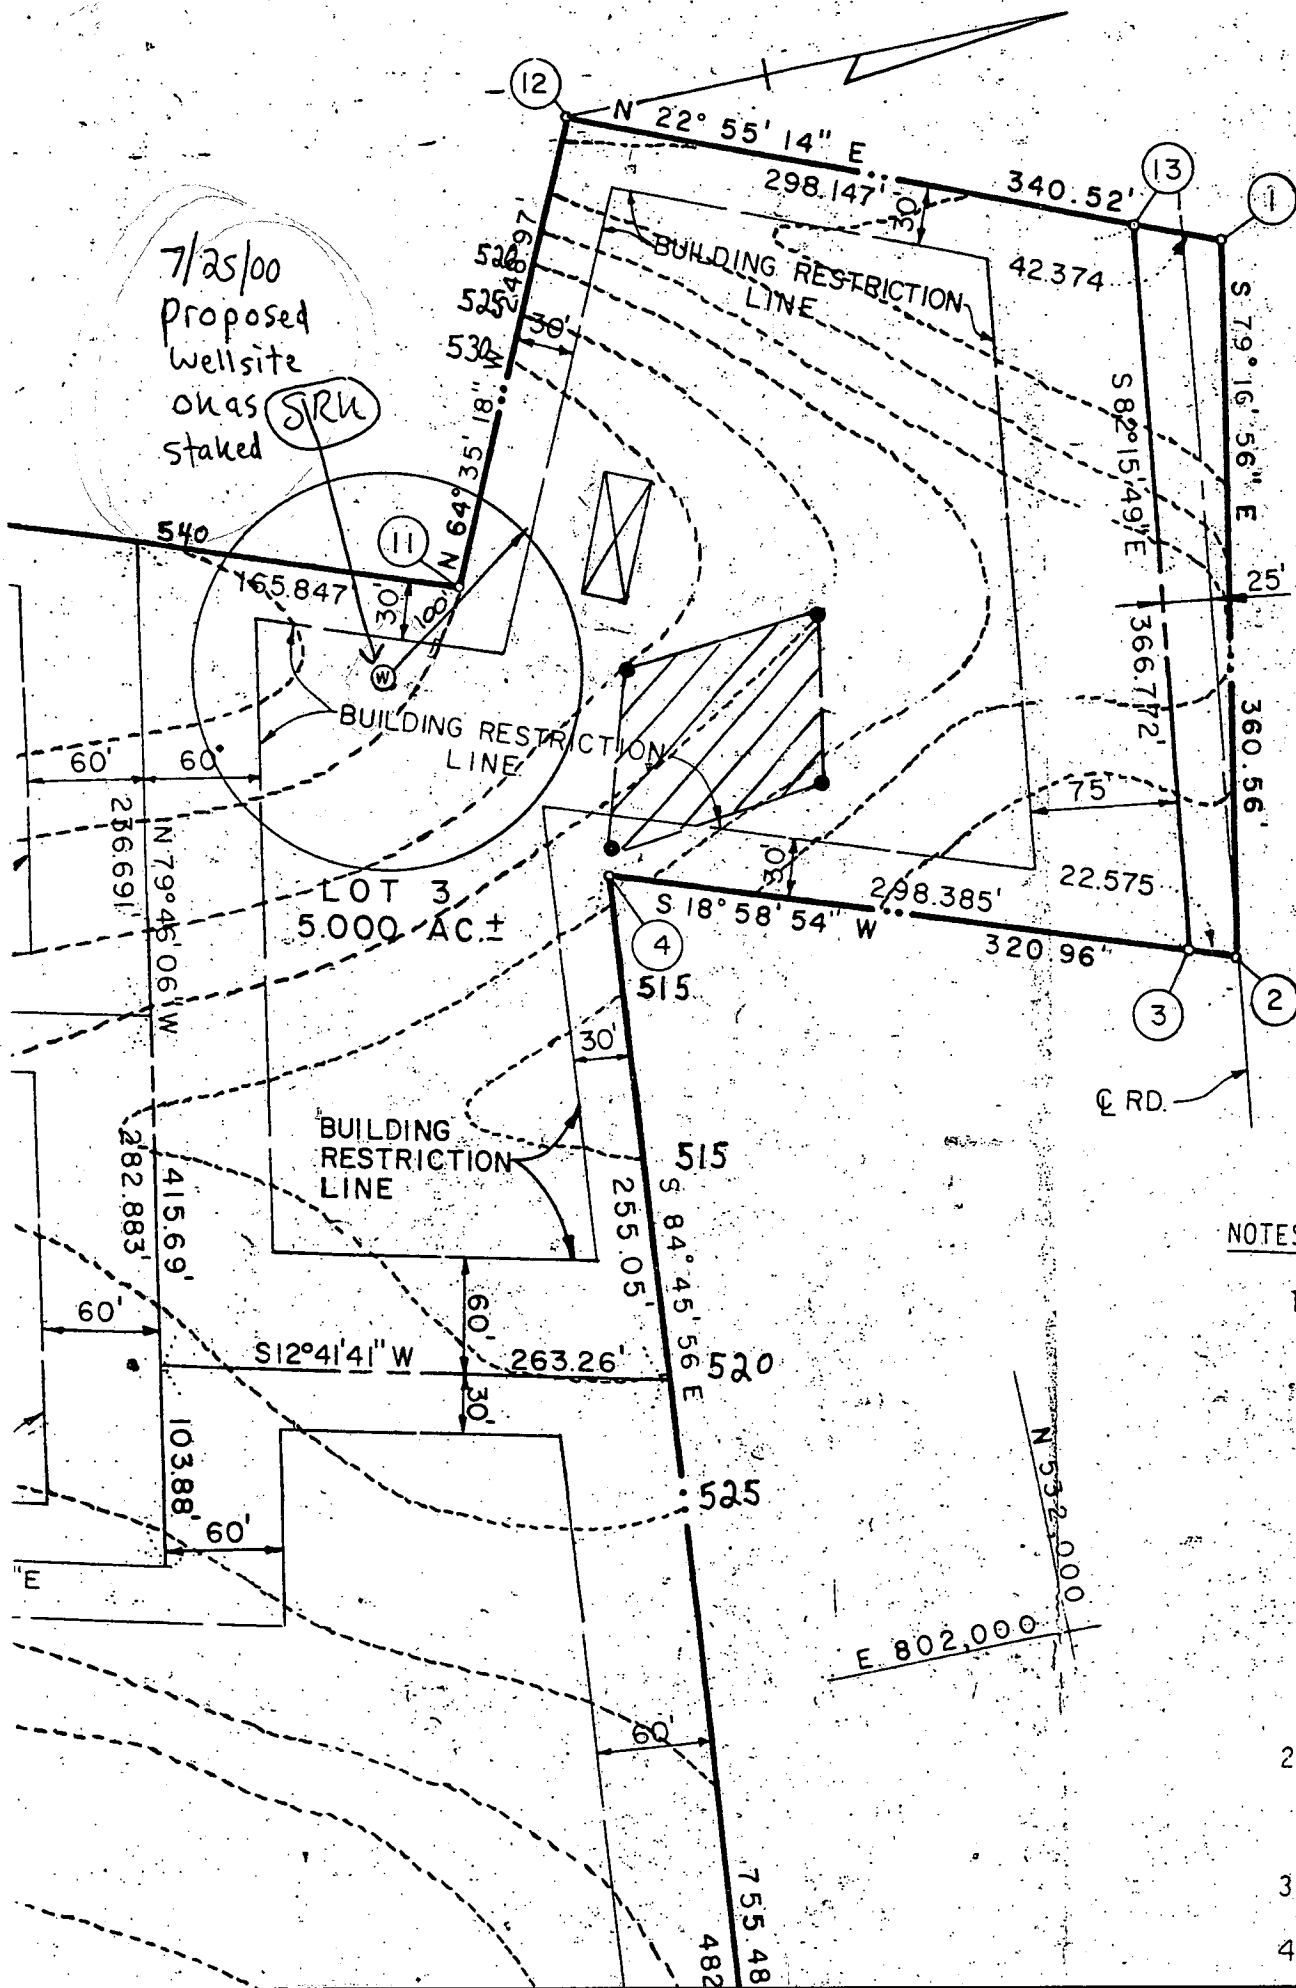

NOTES:

1. THIS AREA OF EASEMENT OF 10,0 BY THE MARYLAND AND MENTAL HYGIE DISPOSAL. IMPRO THIS AREA ARE RE SEWAGE IS AVAILA SHALL BECOME NULL TO A PUBLIC SEWA HEALTH OFFICER SH TO GRANT VARIANCE INTO THE PRIVATE ATION OF A MODIFI NOT BE NECESSARY.
2. THE LOTS SHOWN HE MINIMUM OWNERSHIP REQUIRED BY THE M OF HEALTH AND MEN
3. SUBJECT PROPERTY COMPREHENSIVE ZON
4. EXISTING SOIL T MIC, MCC, AND

APPLICATION

SEWAGE DISPOSAL TESTING

STATE OF MARYLAND - DEPARTMENT OF HEALTH AND MENTAL HYGIENE

HOWARD COUNTY HEALTH DEPARTMENT
ENVIRONMENTAL HEALTH SERVICES

P. O. BOX 473, ELLICOTT CITY, MARYLAND 21043
TELEPHONE: 992-2330

DISTRICT

DATE

A 34/35

P _____

3

7-23-84

TO: THE COUNTY HEALTH OFFICER
ELLICOTT CITY, MARYLAND

I, HEREBY, APPLY FOR THE NECESSARY TEST IN ORDER TO CONSTRUCT (OR RECONSTRUCT) A SEWAGE DISPOSAL SYSTEM.

PROPERTY OWNER

HERBERT A. STREAKER

ADDRESS

13300 FREDERICK RD.

PHONE

442-2180

PROPERTY LOCATION:

SUBDIVISION

STREAKER PROPERTY

LOT NO.

3

ROAD AND DESCRIPTION

ROVER MILL RD. 737.06' WEST OF INTERSECTION OF

PFEFFERKORN RD.

SIZE OF LOT

5.000 AC.

TYPE BLDG.

SINGLE FAMILY

(NUMBER OF BEDROOMS)

THE SYSTEM INSTALLED UNDER THIS APPLICATION IS ACCEPTABLE ONLY UNTIL PUBLIC FACILITIES BECOME AVAILABLE. I FULLY UNDERSTAND THE FEE CONNECTED WITH THE FILING OF THIS PERC TEST APPLICATION IS NON-REFUNDABLE UNDER ANY CIRCUMSTANCES. I ALSO AGREE TO COMPLY WITH ALL M.O.S.H.A. REQUIREMENTS IN TESTING THIS LOT.

(SIGNATURE OF APPLICANT)

APPROVED BY

FOR

DATE

REJECTED BY

FOR

DATE

HOLD PENDING FURTHER TESTS

DATE

REASONS FOR REJECTION OR HOLDING

THIS IS NOT A PERMIT

ROVER MILL RD.

IRWIN L. CHATLIN
635 / 243

*Signed
Record Plot*

LOT 3
5.000 AC.±

LAND DEDICATED TO
HOWARD COUNTY, MARYLAND
FOR PURPOSE OF A PUBLIC
ROAD. (TOTAL AREA OF ROVER
MILL RD. - 0.265 AC.±)

LOUIS C. PFEFFERKORN
537 / 225

NOTES:

1. WITH THE EASEMENT BY THE M AND MEN DISPOSAL THIS ARE SEWAGE I SHALL BE TO A PUE HEALTH C TO GRANT INTO THE ATION OF NOT BE M
2. THE LOTS MINIMUM REQUIRED OF HEALT
3. SUBJECT COMPREHE
4. THE COOR MARYLAND


N 532.000
E 802.000

6071

12-10 84

HOWARD COUNTY, MD


ROVER MILL RD.

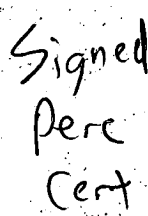

- NOTES:
1. ☒ ☒ ☒ THIS ARE EASEMENT OF 1 BY THE MARYLA AND MENTAL HY DISPOSAL. IN THIS AREA ARE SEWAGE IS AV. SHALL BECOME TO A PUBLIC HEALTH OFFIC TO GRANT VAF INTO THE PR ATION OF A NOT BE NECE
 2. THE LOTS SH MINIMUM OWN REQUIRED BY OF HEALTH A
 3. SUBJECT PRO COMPREHENS
 4. EXISTING MIC₂, MGC₂

3
0 Sq.Ft.
0 Ac.

75' BRL

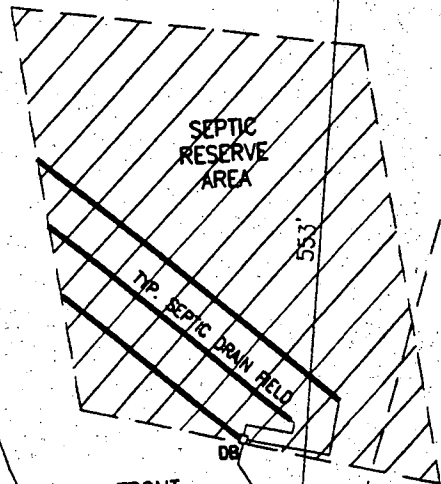

FRONT

EX. DRIVE

ACCESS

EXISTING RESIDENCE

prop. tank
OK'd
By SEC
10/16/02

250 Ln.Ft., 48" HIGH
WOOD FENCE TO CODE
(BY OWNER)

FILTER PAD LOCATION

800 Sq.Ft. BROOM
FINISH CONCRETE
DECK (BY MPI)

POOL

000139696
OK'D BY GM

S84°45'56"E 255.05'

30' BRL

S12°41'41"W 263.26'

30' BRL

313'

R8'-9"

R13'-9"

R7'-9"

R2'-9"

R9'

R4'-3"

LAYOUT DETAIL
1/8" = 1'-0"

ELEVATION

9.01

5

0'-2"