## PERM11

34890

5th


HOWARD COUNTY

BUREAU OF ENVIRONMENTAL HEALTH 461-9933

MARYLAND STATE DEPARTMENT OF HEALTH

**DATE SYSTEM** 

H. G. Ubbo VanderValk	PERMITTED TO INSTALL ALTER
ADDRESS 13150 Deanmar Drive, Highland, MD 21771	PHONE596-9013
SUBDIVISION <u>Greenefields</u> ROAD 6570 Prestwice	ck Dr. LOT18
PROPERTY OWNER	
ADDRESS	
IF GARBAGE GRINDER IS USED INCREASE SEPTIC TANK CAPACITY BY 50% AND ABSOR	PTION AREA BY 22%.
GARBAGE GRINDER? YES NOX	
SEPTIC TANK CAPACITY 1000 GALLONS NUMBER OF BEDROOMS	3
TRENCHES - 168 sq. ft. per bedroom. Trench to be 3 foriginal grade. Bottom maximum depth 4.5 areabbegins at 3.0 feet below original gradistribution pipe.  LOCATION - Place the distribution box 65 feet from the 175 feet from the right (310') lot line as Prestwick Drive. Run trenches on contour Maintain 100 feet from well with septic tanded to grade or above on septic tank.	feet below original grade. Effects de. 1.5 feet of stone below  me rear (300.43') lot line and seen when facing the lot from toward the left rear lot line.  mk.  Provide 6" - 8" diameter cleanout
and cap to grade or above on septic taik.	(Ba)
PLANS APPROVED BY S. Abel	DATE
COVER NO WORK UNTIL INSPECTED AND APPROVED.	
NEITHER THE HOWARD COUNTY COUNCIL NOR THE HEALTH DEPARTMENT IS RESPONSIBLE FOR THE SUCC	
NOTE: CLEANOUT REQUIRED EVERY 70 FEET OF SEWER LINE AND/OR AT 90° SWEEPS IN LINES FROM HO	DUSE TO DRAIN FIELDS.
NOTE: ALL PARTS OF SEPTIC SYSTEMS (I.E., TANK, DISTRIBUTION BOX, TRENCHES) TO BE 100 FEET FROM WE	ELL (UNLESS OTHERWISE SPECIFICALLY AUTHORIZED)
NOTE: IF DEEP TRENCH(ES) ARE USED CALL FOR INSPECTION BEFORE AND AFTER PLACING GRAVEL IN T	TRENCH(ES).
NOTE: NO DRY WELL SHALL EXCEED 15 FOOT IN DIAMETER. NO ABSORPTION TRENCH TO EXCEED 100 F	BLDG. PERMIT SIGNED
NOTE: ALL PIPE FROM HOUSE TO SEPTIC TANK MUST BE CAST IRON OR SCHEDULE 40 PVC OR ABS.	BAND RETURNED ///9/9/
PERMIT VOID AFTER TWO YEARS.	Serial KBAN 10 22 111
NOTE: INSTALL STAND PIPE ON SEPTIC TANK AND DRY WELL. STAND PIPES MUST BE 6 INCHES IN DIAMÉTE ACCEPTED. IF TOP OF SEPTIC TANK IS DEEPER THAN 3 FEET, MANHOLE TO GRADE REQUIRED.	R. CAST IRON CONCRETE OR TERRA COTTA OR PVC OR ABS
NOTE DISTRIBUTION BOXES MUST HAVE BAFFLES.	

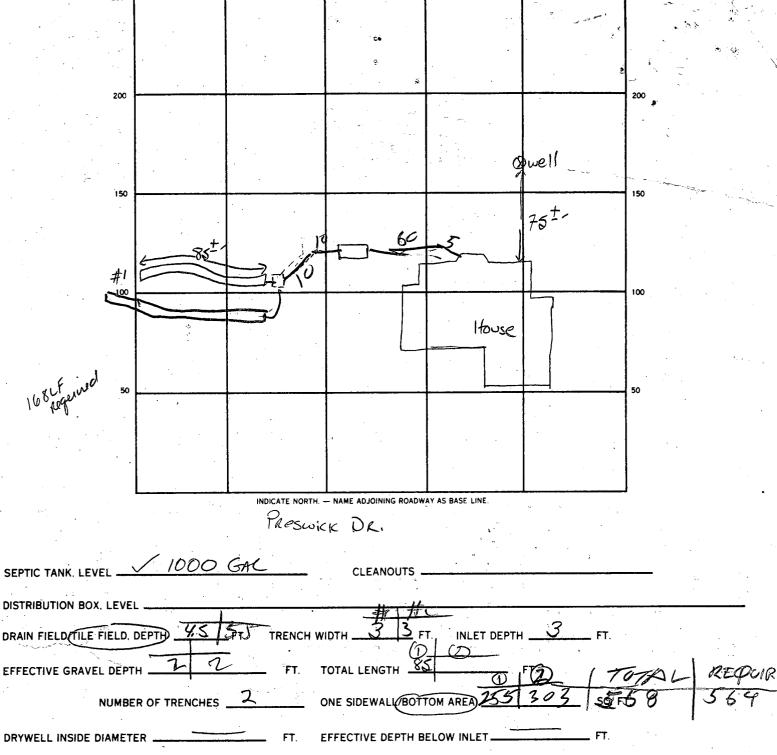

EFFECTIVE GRAVEL DEPTH \_ DRYWELL INSIDE DIAMETER \_ ABSORBENT AREA REMARKS 7/03/87 LOCATION APPROXIMANT OK TO FINISH A / AND COLOR MIDDLE IF NECESSA

INSPECTOR 4

# APPLICATION

SEWAGE DISPOSAL TESTING

STATE OF MARYLAND - DEPARTMENT OF HEALTH AND MENTAL HYGIENE

~	_	_	~	_	 

24291

HOWARD	COUNTY	HEALTH	DEPARTME	ENT
ENVIRON	MENTAL	HEALTH	SERVICES	

P. O. BOX 476 ELLICOTT CITY, MARYLAND 21043 TELEPHONE: 992-2330

		3. "	••
DISTRICT	5		


DATE 3-29-85

TO:	THE COUNTY HEALTH OFFICER
	ELLICOTT CITY, MARYLAND

I HEREBY APPLY FOR THE NECESSARY TEST IN ORDER TO CONSTRUCT (OR RECONSTRUCT) A SEWAGE DISPOSAL SYSTEM

PROPERTY-CHANGE.	DEVELOPER	Prestwick Drive Jo	int Venture	DWNER	BERNARD	JENEWAY
ADDRESS	Box 196, Clark	ksville, Maryland 210	)29	PHONE	854-0498	
PROPERTY LOCATION	N:		<b>.</b>		41.5 <b></b>	- 10
SUBDIVISION	Ralph Greene I	Property Keens Field	eds Sect	LOT NO	X NEW COT	18 ON
	P. 1. C.		<i>\( \)</i>	LOT NO.		FINAL
ROAD AND DESCRIPT	non end of prestw	ick Drive 657	> PAESwir	CR DR.		
0	15e	. 1				
SIZE OF LOT3	acres	<del></del>	TYP	E BLDGS	ingle family	00110
	6				(NUMBER OF BEDR	OOMS)
•	1.A. REQUIREMENTS IN T	S PERC TEST APPLICATION IS NON	(SIGNA	ATURE OF APPL	CANTY S	
APPROVED BY	schey abel	FOR (5)	hallow to	le fild	DATE 2-18-8	7
REJECTED BY		FOR		0	DATE	
HOLD PENDING FURT			, N 9	•	DATE	
REASONS FOR REJEC	TION OR HOLDING 4-11	1-85 feac. SATISTACT	oxy hold ,	ba Review	WATERINO	NE hole,
		Livision PLAT hole				
•	•	1/23/85 Cwilli	· /		G. Permit sig	
				ANE	RETURNED	3/19/86

# THIS IS NOT A PERMIT

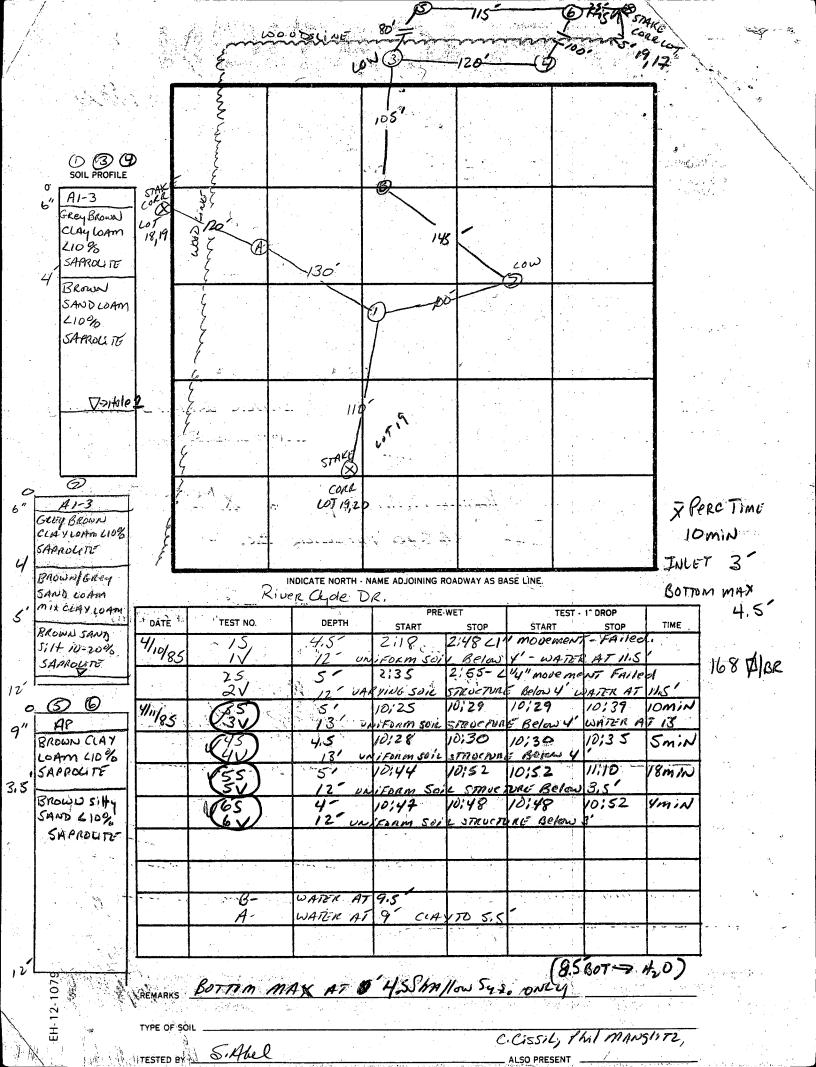

C1-00518 SEQUENCE NO. (OEP USE ONLY)	STATE OF MARYLAND WELL COMPLETION REPORT	THIS REPORT MUST BE SUBMITTED WITHIN 45 DAYS AFTER WELL IS COMPLETED.
THIS NUMBER IS TO BE PUNCHED IN COLS. 3-6 QN ALL CARDS)	FILL IN THIS FORM COMPLETELY PLEASE PRINT OR TYPE	COUNTY NUMBER N-34890
DATE Received DATE WELL COMME	22 1 6 0 26 (TO NEAREST FOOT)	PERMIT NO.  FROM "PERMIT TO DRILL WELL"  28 29 30 31 32 33 34 35 36 37
OWNER SENEWRY	SR. BELNARI) first name	AND PART OF AND
STREET OR RFD PRICE TWICE SUBDIVISION GREEN FILE		HIGHLAND LOT 18
WELL LOG	GROUTING RECORD VES 00	[C 3]
Not required for driven wells  STATE THE KIND OF FORMATIONS	WELL HAS BEEN GROUTED (Circle Appropriate Box)  TYPE OF GROUTING MATERIAL	1 2 PUMPING TEST
PENETRATED, THEIR COLOR, DEPTH, THICKNESS AND IF WATER BEARING	CEMENT CM BENTONITE CLAY BC	HOURS PUMPED (nearest hour)
if the state of th	ter NO. OF BAGS	PUMPING RATE (gal. per min. 15 to nearest gal.)
Top Soil 02	GALLONS OF WATER DEPTH OF GROUT SEAL (to nearest foot)	METHOD USED TO MEASURE PUMPING RATE WATER LEVEL (distance from land surface)
Clay 25	from 6   ft. to 4   ft. to 4   ft. to 4   ft.	BEFORE PUMPING 17 20
Shaley 3 14 28	casing types insert CASING RECORD CO	WHEN PUMPING 22 25
Sand Stone 28 40	appropriate code below PLASTIC OTHER	TYPE OF PUMP USED (for test)  A air P piston T turbine
Doulders	MAIN Nominal diameter Total depth CASING top (main) casing of main casing	C centrifugal Protary O(describe below)
Clay 40 65  Mica 40 65  Sand Stone 65 68  Mica 68 110	TYPE (nearest inch) (nearest foot)	jet Ssubmersible P
11160	60 61 63 64 66 70  E OTHER CASING (if used)	
Sand Stone 63 30	A diameter depth (feet) H inch from to	PUMP INSTALLED
Mica 68 1/0		DRILLER WILL INSTALL PUMP YES (NO) (CIRCLE) (YES or NO)
Ilist 110 115	screen type SCREEN RECORD	IF DRILLER INSTALLS PUMP, THIS SECTION MUST BE COMPLETED FOR ALL WELLS EXCEPT HOME USE
Mica 115 160	or open hole ST BR HO	TYPE OF PUMP INSTALLED PLACE (A,C,J,P,R,S,T,O) IN BOX-SEE ABOVE:
	appropriate code below STEEL BRASS FOPEN BRONZE HOLE	CAPACITY: GALLONS PER MINUTE (to nearest gallon)  31  35
	PLASTIC_ OTHER	PUMP HORSE POWER 37 41
	DEPTH (nearest ft.)	PUMP COLUMN LENGTH (nearest ft.)  CASING HEIGHT (circle appropriate box
	E 17 0 9 9 11 15 17 21 C	+ above LAND SURFACE
CIRCLE APPROPRIATE LETTER	$ s^2 $	below (nearest foot)
A WELL WAS ABANDONED AND SEALE WHEN THIS WELL WAS COMPLETED	C 23 24 26 30 32 36 R 3 3 38 39 41 45 47 51	LOCATION OF WELL ON LOT  SHOW PERMANENT STRUCTURE SUCH AS
E ELECTRIC LOG OBTAINED  TEST WELL CONVERTED TO PRODUCT	SLOT SIZE 1 2 3 (NEAREST	BUILDING, SEPTIC TANKS, AND/OR LANDMARKS AND INDICATE NOT LESS
WELL  I HEREBY CERTIFY THAT THIS WELL HAS BEEN CONSTRUC	OF SCREEN 56 60 INCH)	THAN TWO DISTANCES (MEASUREMENTS TO WELL)
ACCORDANCE WITH COMAR 10.17.13 "WELL CONSTRUCTION OF THE CONSTRUCTION OF THE CAPTION OF THE CAPTION OF THE COMPLETE TO THE OF MY KNOWLEDGE.	HE GRAVEL PACK	well so
DRILLERS IDENT. NO. 40	F IN BOX 68 68  OEP USE ONLY (NOT TO BE EN LEDIN BY DOUG ED)	X
DRILLERS SIGNATURE (MUST MATCH SIGNATURE ON APPLICATION	(NOT TO BE FILLED IN BY DRILLER)	
Market Illian	72 75 76	M S S S S S S S S S S S S S S S S S S S
SITE SUPERVISOR (sign. of driller or journeyr responsible for sitework if different from perm	TELESCOPE LOG OTHER DATA (Pe) CASING INDICATOR	Prestaick DR.


5.30-86

Page

Review G/19/54 oh S.Alex

### FIELD DATA SHEET HOWARD COUNTY WELL YIELD TEST

Well Permit N	о. но - <u>81 14</u>	60		
albdivision _	GREENEF	60 PRESTUICK		
well Driller	GEORGE SI	STERMAN OWN	Plater SENEWRY 3R,	Sec. 1
Depth o	of well /(af	2 30 C	Out of the second	<b>B</b> 2KNAR <u>I</u> )
	wedauling n	mint (M D ) -t-	1	
Static	water level (s.w	L.) below M.P.	19	
. High rate	pumping rese	rvoir drawdown		
Time pum	p started 12	4 <i>6</i>	Dumping -	
Total ti	me 15 Min to	reach pumping water	level 37 ft. 4	Delow M.P.
I. Berovery	pump test data -	Observations to be	recorded every 15 minut	
	The second of the Art of the Second of the S	PUMPING RATE	Prow warman	The second secon
minute in- tervals	below M.P.	time to fill 51	FLOW METER READING (if used)	CALCULATED FLOW
1115	25	gallon bucket		minute)
30	27	6 Sec		10 gpm
45	2-7	65EC	Fump SEC	100 m
J. 100.67	3>	65cc	80/	109PM=
		65ec		10900
11.5	<b></b>			
30	2-	- 650		10 CDM
45	37	6 Sec		129AM
500	32	65=2		10 000
Market State		6 Sec		1000
	2 3			
3,30	3 7	6.50		10 9 3 20
145	37	6500		10900
1100	2	6586		109201
		6SEC		10900
		The second secon		

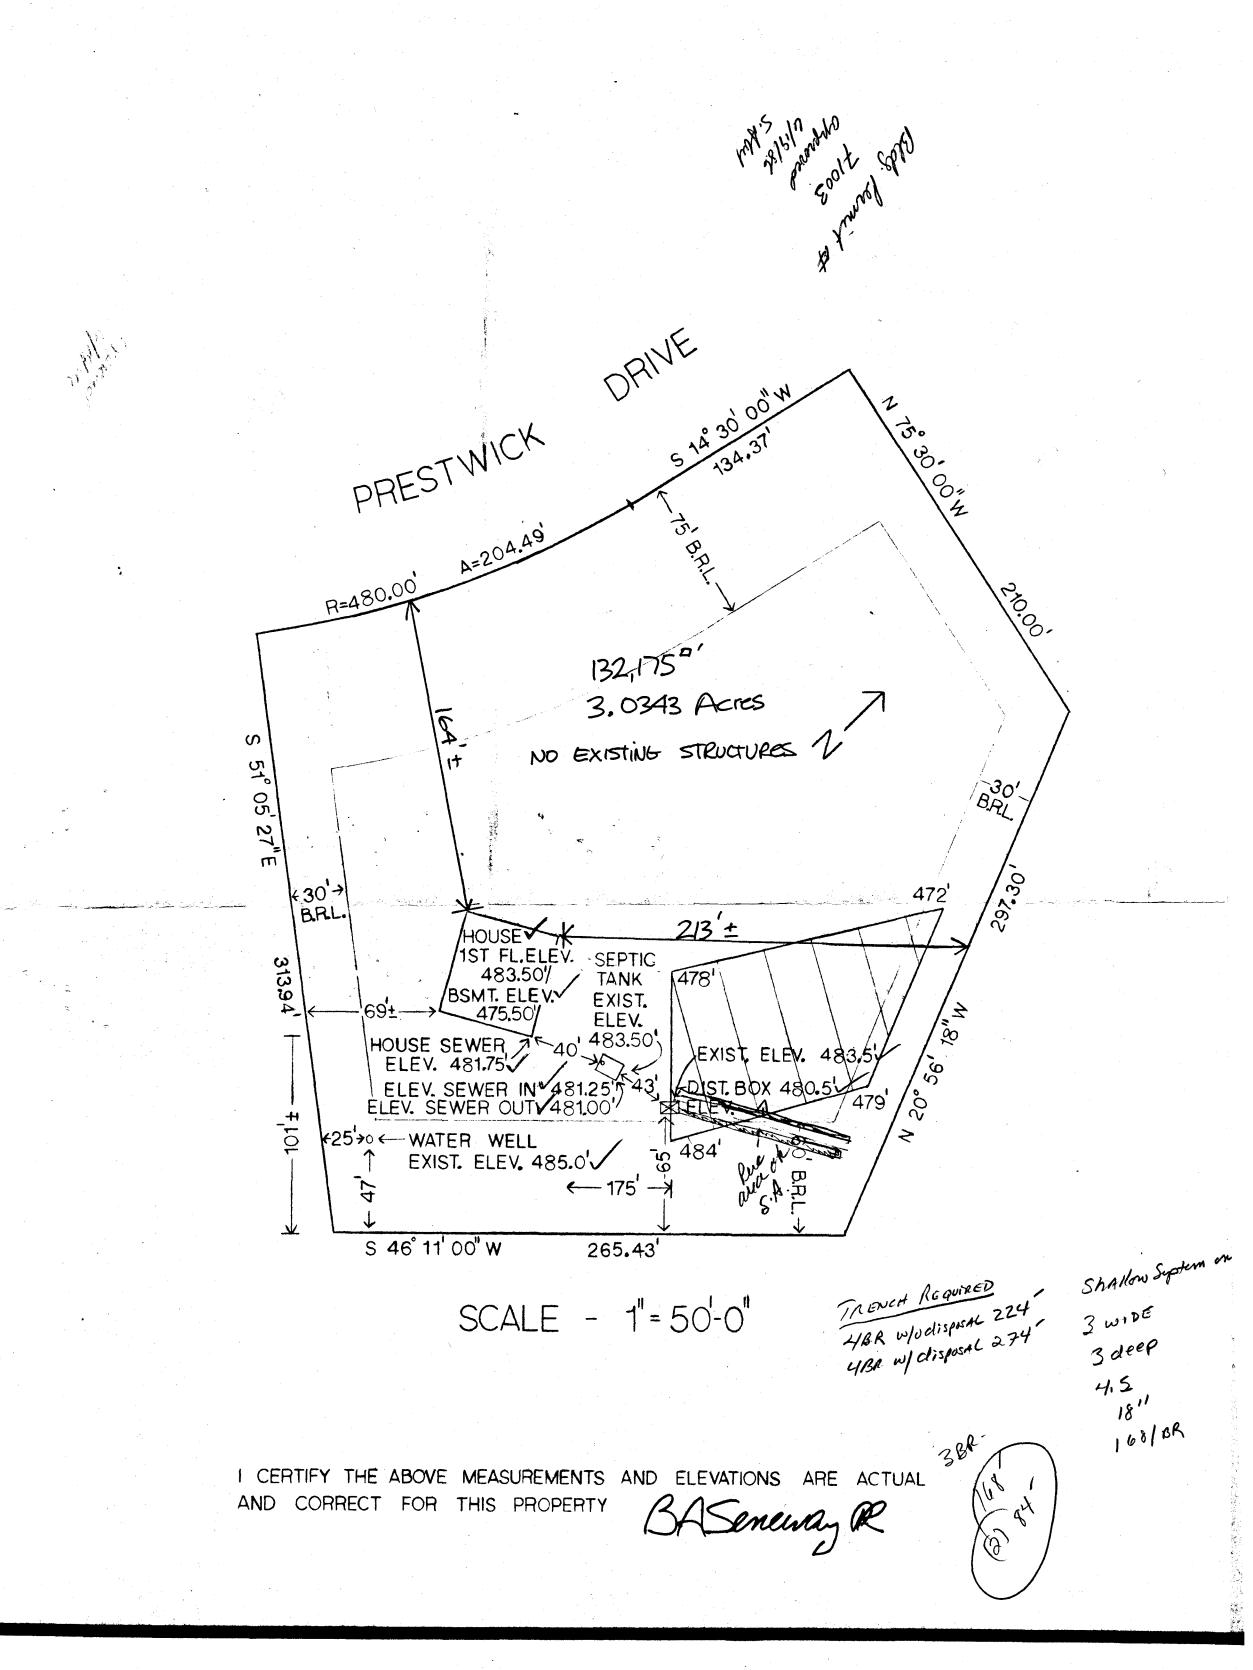

# Lot 18 - Prestwick Drive

9/25/96

APPLICANT/OWNER INTERUS
TO REVISE BLUDING DERMIT
OROPPING THE BEOROWN/KITCHEN



#### HOWARD COUNTY HEALTH DEPARTMENT

Joyce M. Boyd, M.D., County Health Officer

September 23, 1996

Mr. and Mrs. Seneway 6570 Prestwick Drive Highland, Maryland 20777

RE: Building Permit Application

Serial Number: B00102246

6570 Prestwick Drive

One Story Addition On Side Of Home For Office/In-LawSuite(1Bedroom, Bathroom

and Kitchen)

Dear Mr. and Mrs. Seneway:

This office has received the building permit application for an addition at the above referenced address.

We are unable to recommend approval of your building permit application for the following reason:

- The type of addition you are proposing meets the definition of a separate residence, and as such, should have a separate septic system and sewage easement with enough area for the initial septic system and two future repairs. This would be in addition to the future repair area for your existing septic system.


To continue review and to determine whether additional percolation testing is necessary, please submit to this office a revised site plan showing the <u>as-installed</u> location of the existing septic system, septic easement, existing water well, and all structures.


If you have any questions regarding this matter, please contact me at the below address or by calling 313-2640.

Very truly yours,

Glen Savage, Sanitarian Water and Sewerage Program

GS:jr

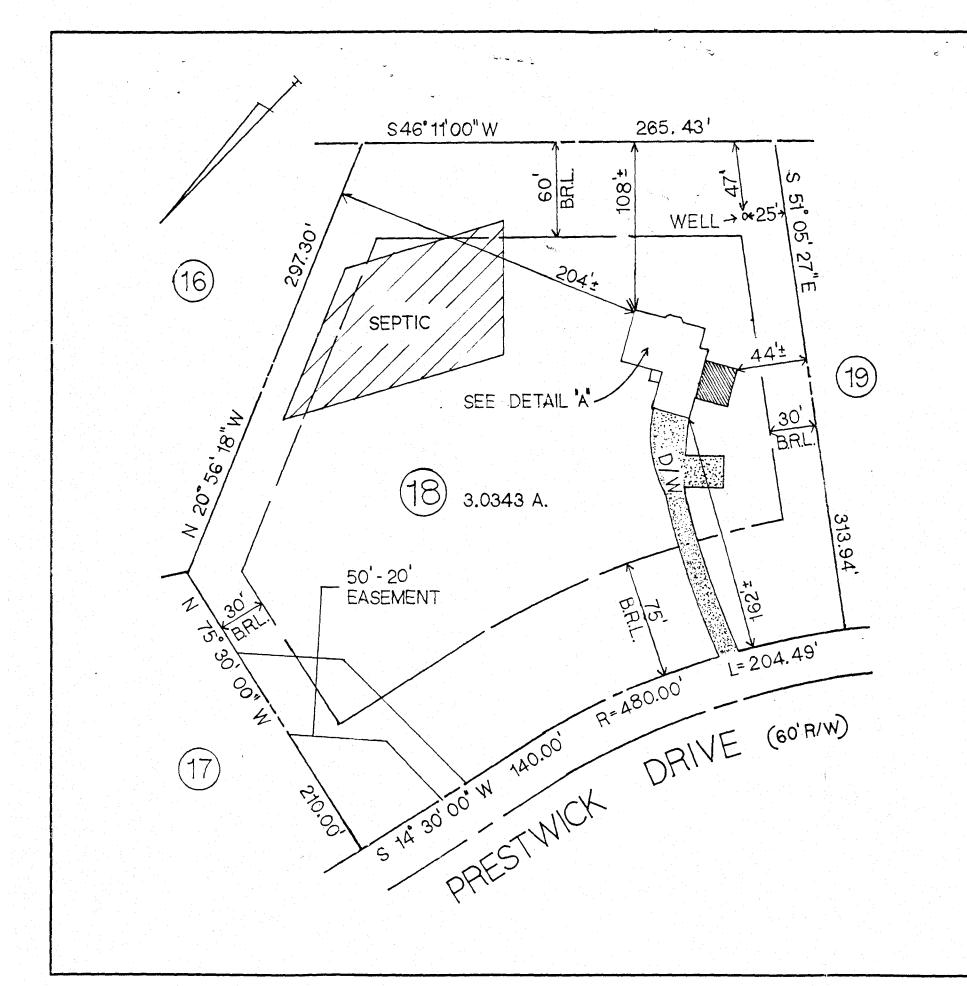

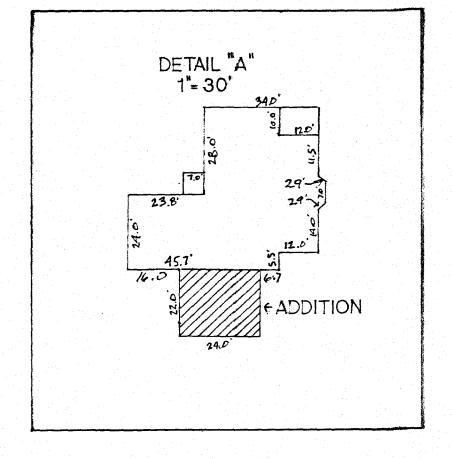

4 600

SENE	EWAY ADDITION	
SCALE 1"= 60' DATE 8-1-96	6570 PRESTWICK DR.	DREAMN ST BAS.
	PLOT PLAN	
LOT 18 SEC	.1 GREENE FIELDS"	DRESING NUMBER