

05-399181

PERMIT

P 39410A 34894

SEWAGE DISPOSAL SYSTEM

MARYLAND STATE DEPARTMENT OF HEALTH DISTRICT 5th

HOWARD COUNTY

BUREAU OF ENVIRONMENTAL HEALTH
461-9933

INDEXED

DATE 6/1/87DATE SYSTEM APPROVED 6-4-87INSPECTOR S. Abel

Dennis Feaga

IS PERMITTED TO INSTALL X ALTERADDRESS 1625 Henryton Road, Marriottsville, Md. 21104 PHONE 442-5623SUBDIVISION Greene Fields ROAD 6564 Preswick Drive LOT 17, Sec. 1PROPERTY OWNER Sam YepADDRESS 2101 Mt. Hebron Drive, Ellicott City, Md. 20043 Phone: Work: 859-6422
Home: 465-7436

IF GARBAGE GRINDER IS USED INCREASE SEPTIC TANK CAPACITY BY 50% AND ABSORPTION AREA BY 22%.

GARBAGE GRINDER? YES _____ NO XSEPTIC TANK CAPACITY 1250 GALLONS NUMBER OF BEDROOMS 4

TRENCHES - 175 sq. ft. per bedroom sidewall area. Trench to be 3 ft. wide. Inlet 2½ ft. below original grade. Bottom maximum depth 4 ft. below original grade. Effective area begins at 2½ ft. below original grade. 1½ ft. of stone below distribution pipe. Place the distribution box 25 ft. from the front (490') lot line and 135 ft. from the left (290') lot line as seen when facing the lot from Preswick Drive. Run trenches on contour toward left lot line. Septic system to be installed prior to house construction. Inspector must see all of sewer line from house to drain field. NOTE: CLEANOUTS WILL BE REQUIRED EVERY 50 FEET FROM SEPTIC TANK TO DRAIN FIELDS.

PLANS APPROVED BY Sid AbelDATE 7/21/86

COVER NO WORK UNTIL INSPECTED AND APPROVED.

NEITHER THE HOWARD COUNTY COUNCIL NOR THE HEALTH DEPARTMENT IS RESPONSIBLE FOR THE SUCCESSFUL OPERATION OF ANY SYSTEM.

NOTE: CLEANOUT REQUIRED EVERY 70 FEET OF SEWER LINE AND/OR AT 90° SWEEPS IN LINES FROM HOUSE TO DRAIN FIELDS.

NOTE: ALL PARTS OF SEPTIC SYSTEMS (I.E., TANK, DISTRIBUTION BOX, TRENCHES) TO BE 100 FEET FROM WELL. (UNLESS OTHERWISE SPECIFICALLY AUTHORIZED)

NOTE: IF DEEP TRENCH(IES) ARE USED CALL FOR INSPECTION BEFORE AND AFTER PLACING GRAVEL IN TRENCH(IES).

NOTE: NO DRY WELL SHALL EXCEED 15 FOOT IN DIAMETER. NO ABSORPTION TRENCH TO EXCEED 100 FEET IN LENGTH.

NOTE: ALL PIPE FROM HOUSE TO SEPTIC TANK MUST BE CAST IRON OR SCHEDULE 40 PVC OR ABS.

PERMIT VOID AFTER TWO YEARS.

NOTE: INSTALL STAND PIPE ON SEPTIC TANK AND DRY WELL. STAND PIPES MUST BE 6 INCHES IN DIAMETER. CAST IRON, CONCRETE OR TERRA COTTA OR PVC OR ABS ACCEPTED. IF TOP OF SEPTIC TANK IS DEEPER THAN 3 FEET, MANHOLE TO GRADE REQUIRED.

NOTE: DISTRIBUTION BOXES MUST HAVE BAFFLES.


*INSTALLER IS RESPONSIBLE FOR OBTAINING FINAL APROVAL ON THIS PERMIT

*CALL 461-9933 FOR INSPECTION OF SEPTIC SYSTEMS.

EH - 2-1186

B00116627
Sunroom/deck

A 34894

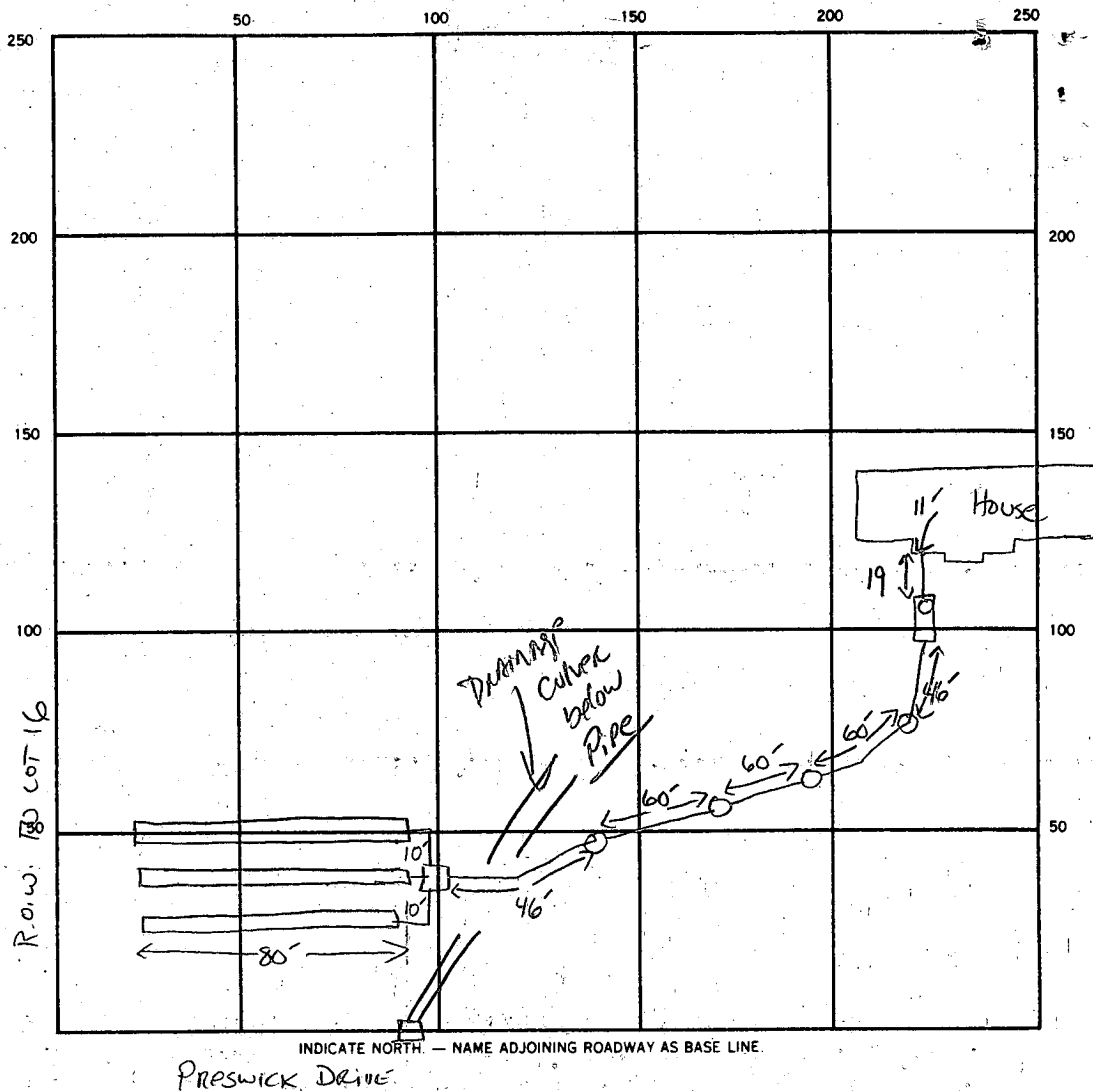

SEPTIC TANK. LEVEL ✓ 1500 GAL CLEANOUTS ✓ ST + 4 INLINE BETWEEN ST & House

DISTRIBUTION BOX. LEVEL ✓

DRAIN FIELD (TILE FIELD) DEPTH 2.5 FT. TRENCH WIDTH 3 FT. INLET DEPTH 4 FT.

EFFECTIVE GRAVEL DEPTH 1.5 FT. TOTAL LENGTH 240 FT.

NUMBER OF TRENCHES 3 ONE SIDEWALL (BOTTOM AREA) 720 SQ. FT.

DRYWELL INSIDE DIAMETER — FT. EFFECTIVE DEPTH BELOW INLET — FT.

ABSORBENT AREA 720 SQ. FT.

REMARKS 6-3-87 Inspection of Pipe from house to ST & ST to DB HAS 1/8-1/4" / 1' FALL
throughout SYST. installed according to plan. 6-4-87 OK TO COVER ALL WORK. SAC

DATE SYSTEM APPROVED 6-4-87 INSPECTOR S. Abel

APPLICATION

SEWAGE DISPOSAL TESTING

STATE OF MARYLAND - DEPARTMENT OF HEALTH AND MENTAL HYGIENE

HOWARD COUNTY HEALTH DEPARTMENT
ENVIRONMENTAL HEALTH SERVICES

P. O. BOX 476 ELLICOTT CITY, MARYLAND 21043
TELEPHONE: 992-2330

DISTRICT 5

DATE 3-29-85

SAM YEP
day 859 6422
pm 465 7436

TO: THE COUNTY HEALTH OFFICER
ELLICOTT CITY, MARYLAND

I, HEREBY, APPLY FOR THE NECESSARY TEST IN ORDER TO CONSTRUCT (OR RECONSTRUCT) A SEWAGE DISPOSAL SYSTEM.

PROPERTY ~~OWNER~~ DEVELOPER Prestwick Drive Joint Venture SAMUEL YEP.

ADDRESS Box 196, Clarksville, Maryland 21029

PHONE 854-0498

PROPERTY LOCATION:

SUBDIVISION Ralph Greene Property BROOKFIELD LOT NO. NEW LOT 17 ON FINAL

ROAD AND DESCRIPTION End Of Prestwick Drive SECTION 1

BLOG. PERMIT SIGNED
AND RETURNED 7/28/86
B.P.H. 71800

SIZE OF LOT 3 acres

TYPE BLDG. single family
(NUMBER OF BEDROOMS)

THE SYSTEM INSTALLED UNDER THIS APPLICATION IS ACCEPTABLE ONLY UNTIL PUBLIC FACILITIES BECOME AVAILABLE. I FULLY UNDERSTAND THE FEE CONNECTED WITH THE FILING OF THIS PERG TEST-APPLICATION IS NON-REFUNDABLE UNDER ANY CIRCUMSTANCES. I ALSO AGREE TO COMPLY WITH ALL M.O.S.H.A. REQUIREMENTS IN TESTING THIS LOT.

Philip M. Smith
(SIGNATURE OF APPLICANT)

APPROVED BY Sidney Abel FOR Shallowale fields DATE 2-18-86

REJECTED BY _____ FOR _____ DATE _____

HOLD PENDING FURTHER TESTS _____ DATE _____


REASONS FOR REJECTION OR HOLDING 4-10-85 perc. SATISFACTORY, HOLD FOR REVIEW WATER IN 4 holes,
hold for Subdivision plat, certified hole location, house and well site. 8/28/86
1-10-86 SYSTEM FIRST. S. Abel B.P. # 71800

THIS IS NOT A PERMIT

AP.
BROWN CLAY
LOAM 60%
SAPROLITE

BROWN SILTY
SAND LOAM
40-20%
SAPROLITE

CLAY
10%
ITE
MICAFOO
AND
LITE

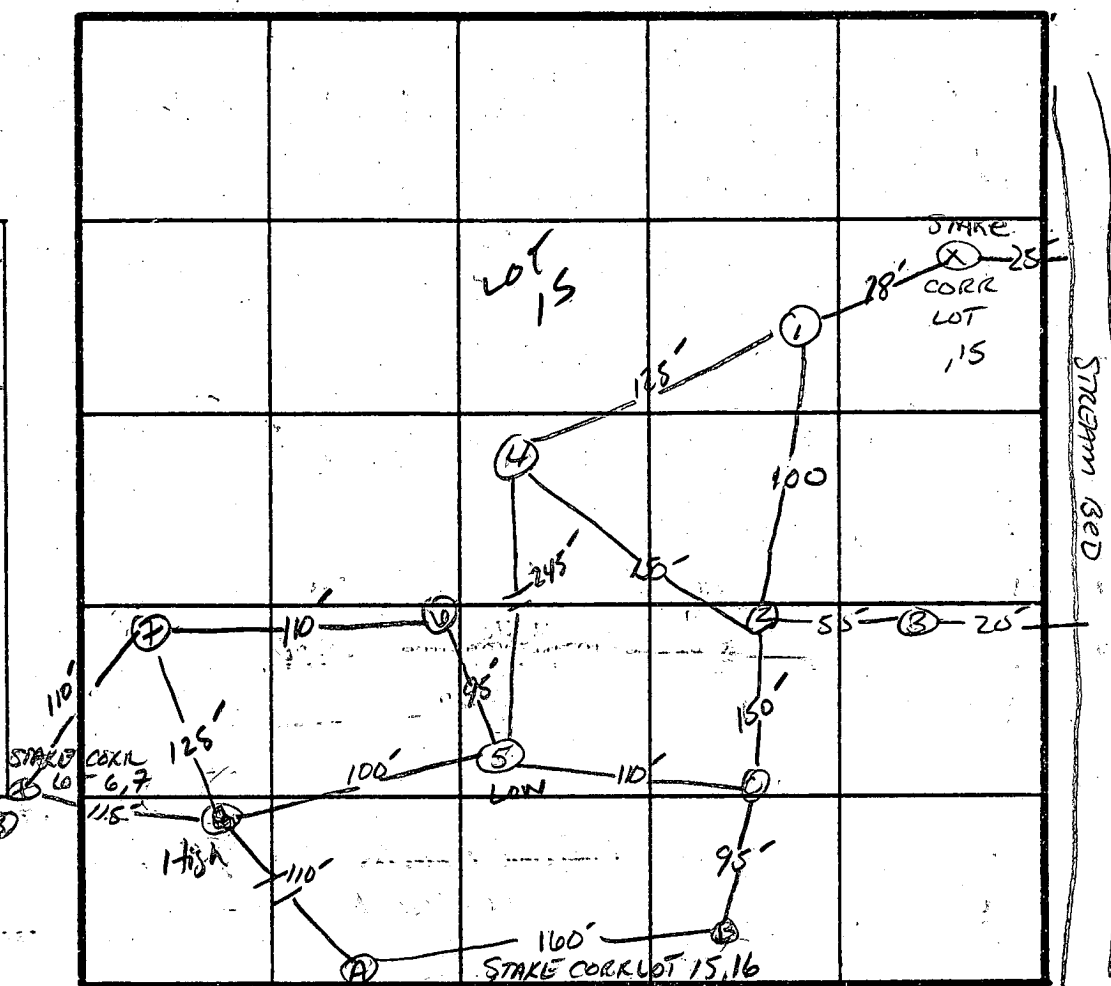

INDICATE NORTH NAME ADJOINING ROADWAY AS BASE LINE.

River Clyde Dr.

DATE	TEST NO.	DEPTH	PRE-WET		TEST - 1" DROP		TIME
			START	STOP	START	STOP	
4/8/85	1S 1V	4.5' 12" UNIFORM SOIL STRUCTURE BELOW 4' WATER AT 8'	2:17	→ ABANDONED			
	2V	11" WATER AT 8' ABANDONED					
	3V	ABANDONED AT 7' WATER AT 5'					
	4V	WATER AT 9'					
4/10/85	5S 5V	4.5' 12" UNIFORM SOIL STRUCTURE BELOW 3' WATER AT 10.5'	11:32	11:33	11:33	11:37	4min
	6S 6V	4.5' 12" UNIFORM SOIL STRUCTURE BELOW 3' WATER AT 11'	11:35	11:36	11:36	11:38	2min
	7S 7V	4' 12" UNIFORM SOIL STRUCTURE BELOW 3' WATER AT 11'	11:42	11:43:30	11:43:30	11:46:30	3min
	8S 8V	3.5' 12" UNIFORM SOIL STRUCTURE BELOW 4' WATER AT 11.5'	11:46	11:48	11:48	11:53	5min
	A	WATER AT 8'					
	B	WATER AT 8'					
	C	WATER AT 7'					

INLET 2.5-3'
BOTTOM MAX
4.0'

$\bar{X}$ PERC TIME
 4 min
 158 Φ /BR
 INCREASE TO
 175 Φ /BR

REMARKS BOTTOM MAX 4' SHALLOW Sys. if PLAT REVIEWED OK
1-10-86 SYSTEM FIRST.


TYPE OF SOIL

TESTED BY

Phil. Mangitz, Ralph Sreen
ALSO PRESENT C. Cissi

ALSO PRESENT

EH-12-1079

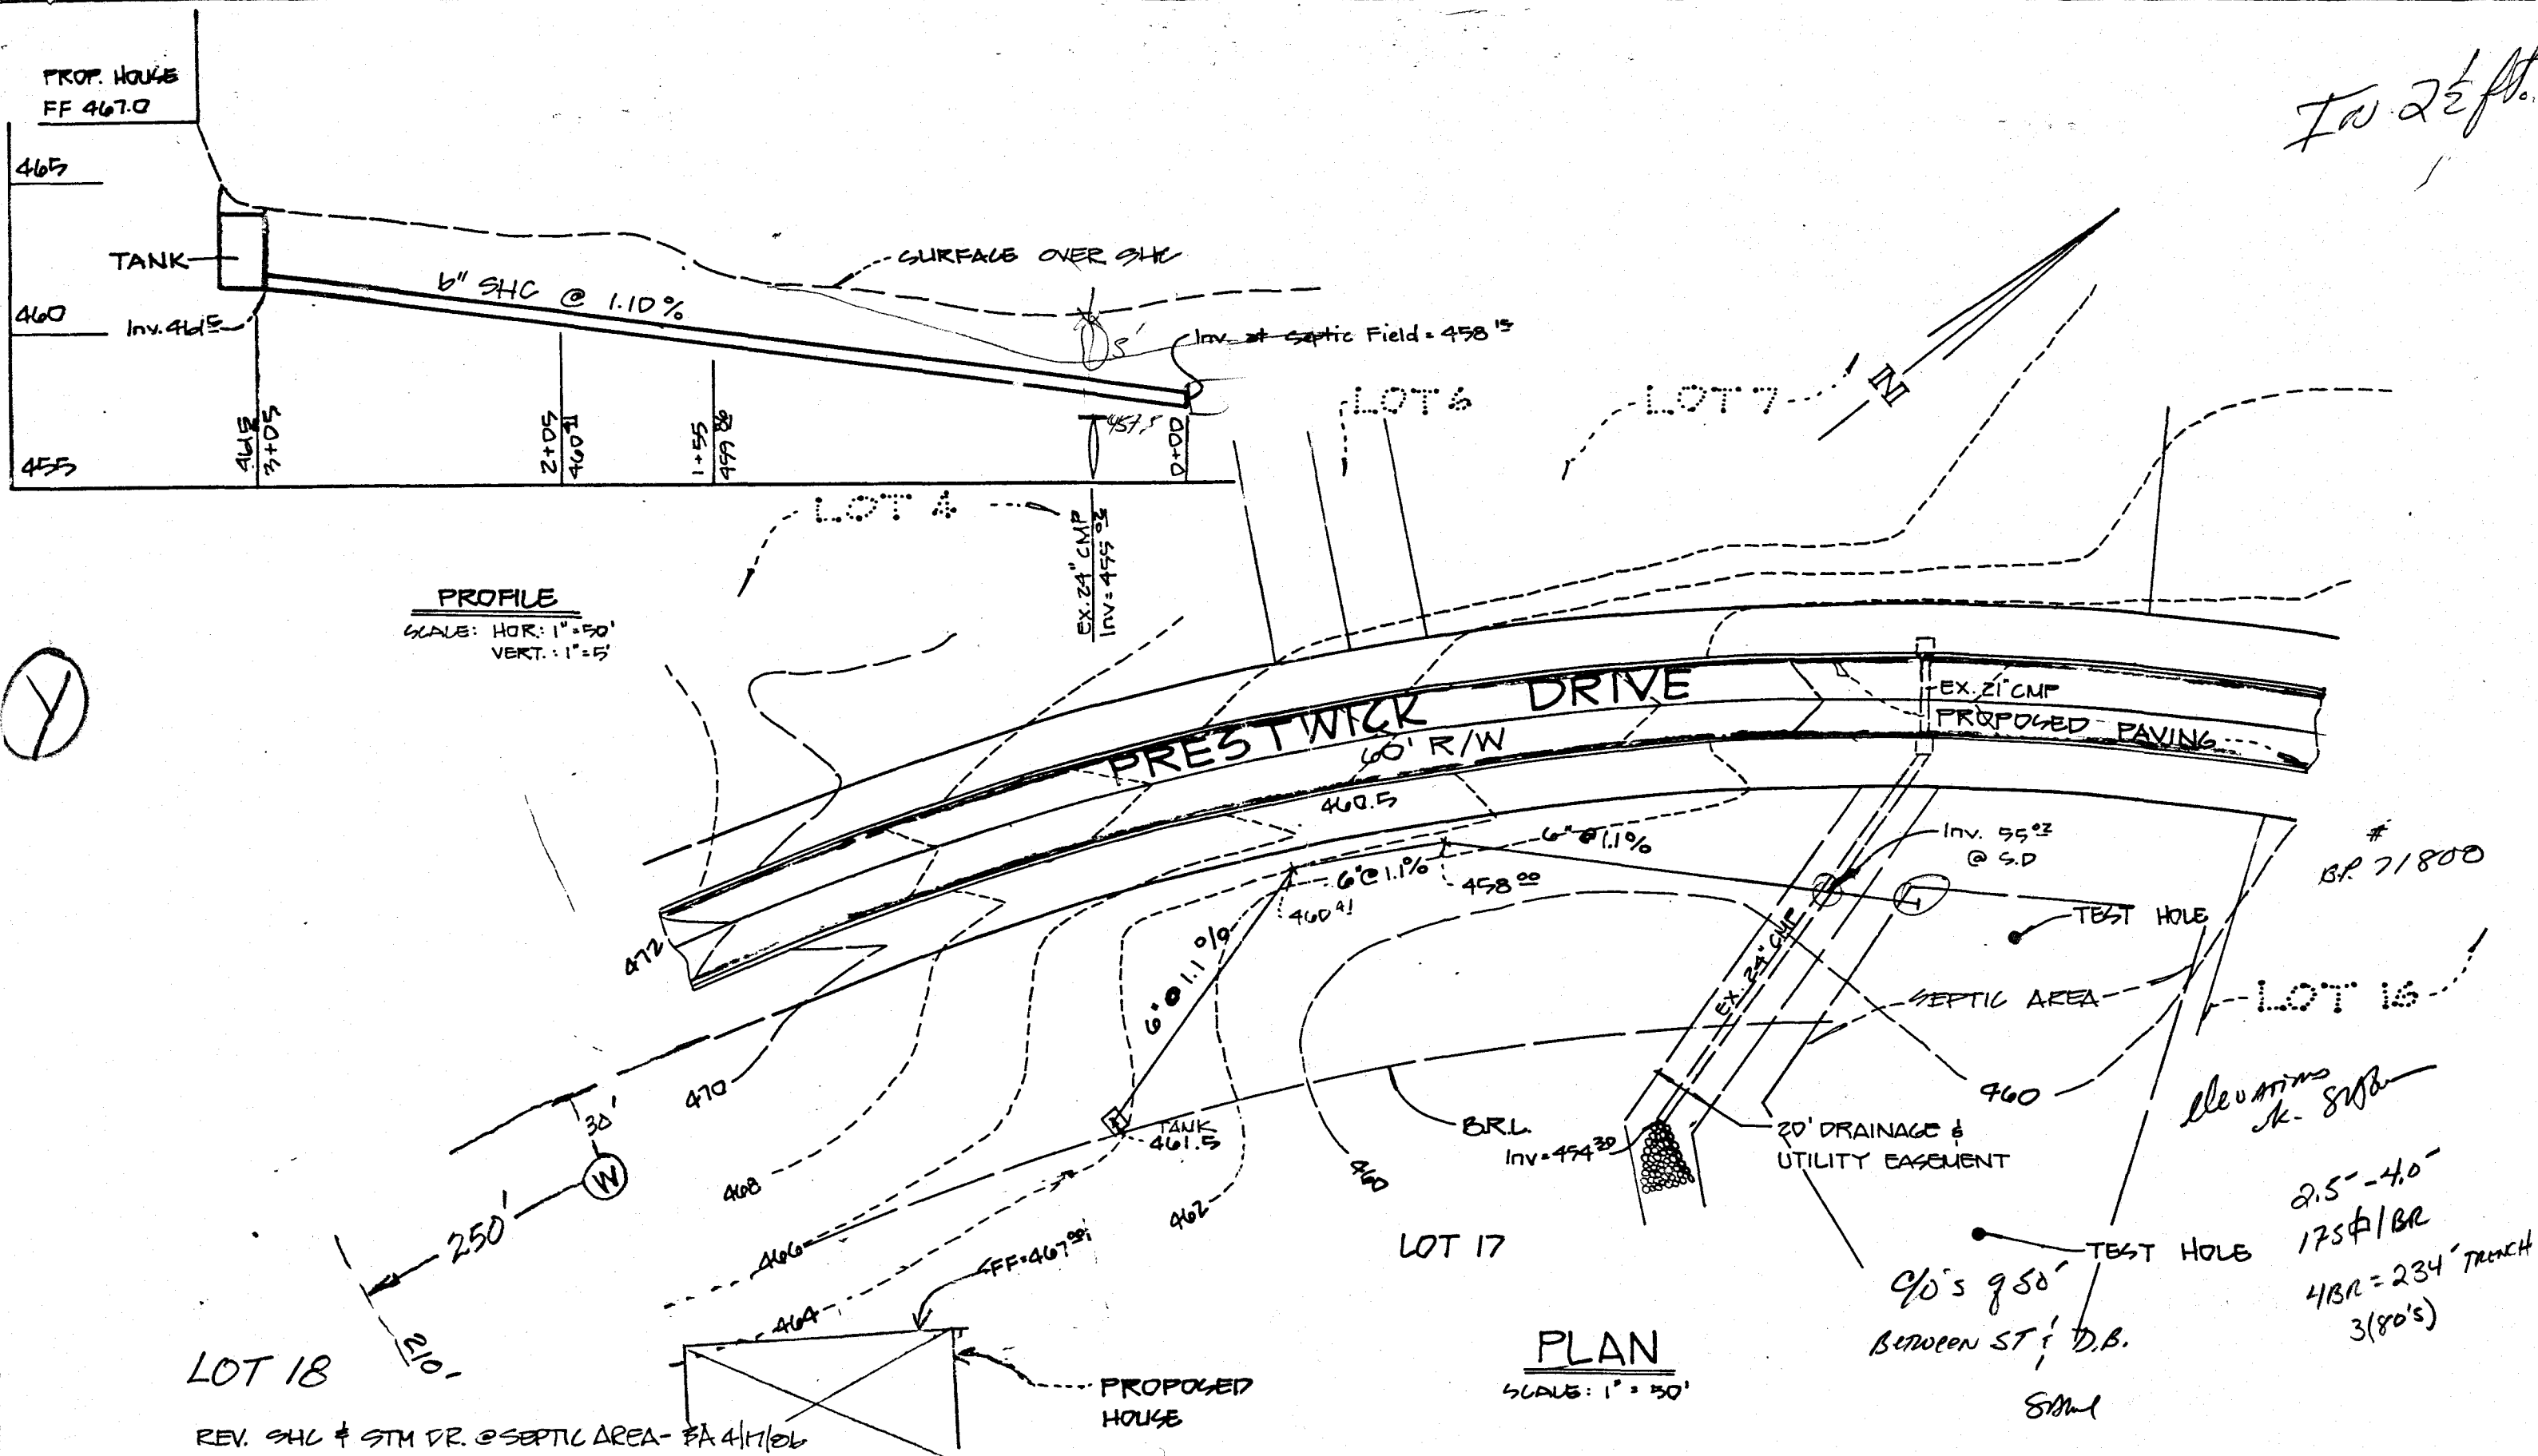

OWNER:
 HIGHLAND ASSOCIATES
 P/O BOX 208
 CLARKSVILLE, MD. 21029
 301-524-5529



DEVELOPMENT
 CONSULTANTS
 GROUP, INC.

17904 GEORGIA AVENUE * 102
 OLNEY, MARYLAND 20832
 301-924-4570

PROPOSED SEPTIC FOR LOT 17
 TAX MAP: 34, PARCEL: 75 & 318
GREENE FIELDS
 CLARKSVILLE (5TH) ELECTION DISTRICT
 HOWARD COUNTY, MARYLAND

DATE JAN. 86	Sheet 1
DRAWN M.A.M.	of 1
CHECKED M.L.G.	PROJECT NO. 136-01
SCALE AS SHOWN	

APPLICATION

SEWAGE DISPOSAL TESTING

STATE OF MARYLAND - DEPARTMENT OF HEALTH AND MENTAL HYGIENE

HOWARD COUNTY HEALTH DEPARTMENT
ENVIRONMENTAL HEALTH SERVICES

P. O. BOX 476 ELLICOTT CITY, MARYLAND 21043
TELEPHONE: 992-2330

A 34891

P _____

DISTRICT 5

DATE 3-29-85

TO: THE COUNTY HEALTH OFFICER
ELLICOTT CITY, MARYLAND

I, HEREBY, APPLY FOR THE NECESSARY TEST IN ORDER TO CONSTRUCT (OR RECONSTRUCT) A SEWAGE DISPOSAL SYSTEM.

PROPERTY OWNER DEVELOPER Prestwick Drive Joint Venture

ADDRESS Box 196, Clarksville, Maryland 21029 PHONE 854-0498

PROPERTY LOCATION:

SUBDIVISION Ralph Greene Property LOT NO. 17

ROAD AND DESCRIPTION End of Prestwick Drive

SIZE OF LOT 3 acres TYPE BLDG. single family
(NUMBER OF BEDROOMS)

THE SYSTEM INSTALLED UNDER THIS APPLICATION IS ACCEPTABLE ONLY UNTIL PUBLIC FACILITIES BECOME AVAILABLE. I FULLY UNDERSTAND THE FEE CONNECTED WITH THE FILING OF THIS PERC TEST APPLICATION IS NON-REFUNDABLE UNDER ANY CIRCUMSTANCES. I ALSO AGREE TO COMPLY WITH ALL M.O.S.H.A. REQUIREMENTS IN TESTING THIS LOT.

Philip Mangif
(SIGNATURE OF APPLICANT)

APPROVED BY _____ FOR _____ DATE _____


REJECTED BY _____ FOR _____ DATE _____

HOLD PENDING FURTHER TESTS _____ DATE _____

REASONS FOR REJECTION OR HOLDING 4-10-85 Peric Satisfactory hold for review water in 3 holes hold
for Certified Subdivision plat, hole locations, house and well site, 8/2/85

THIS IS NOT A PERMIT

SITE PLAN

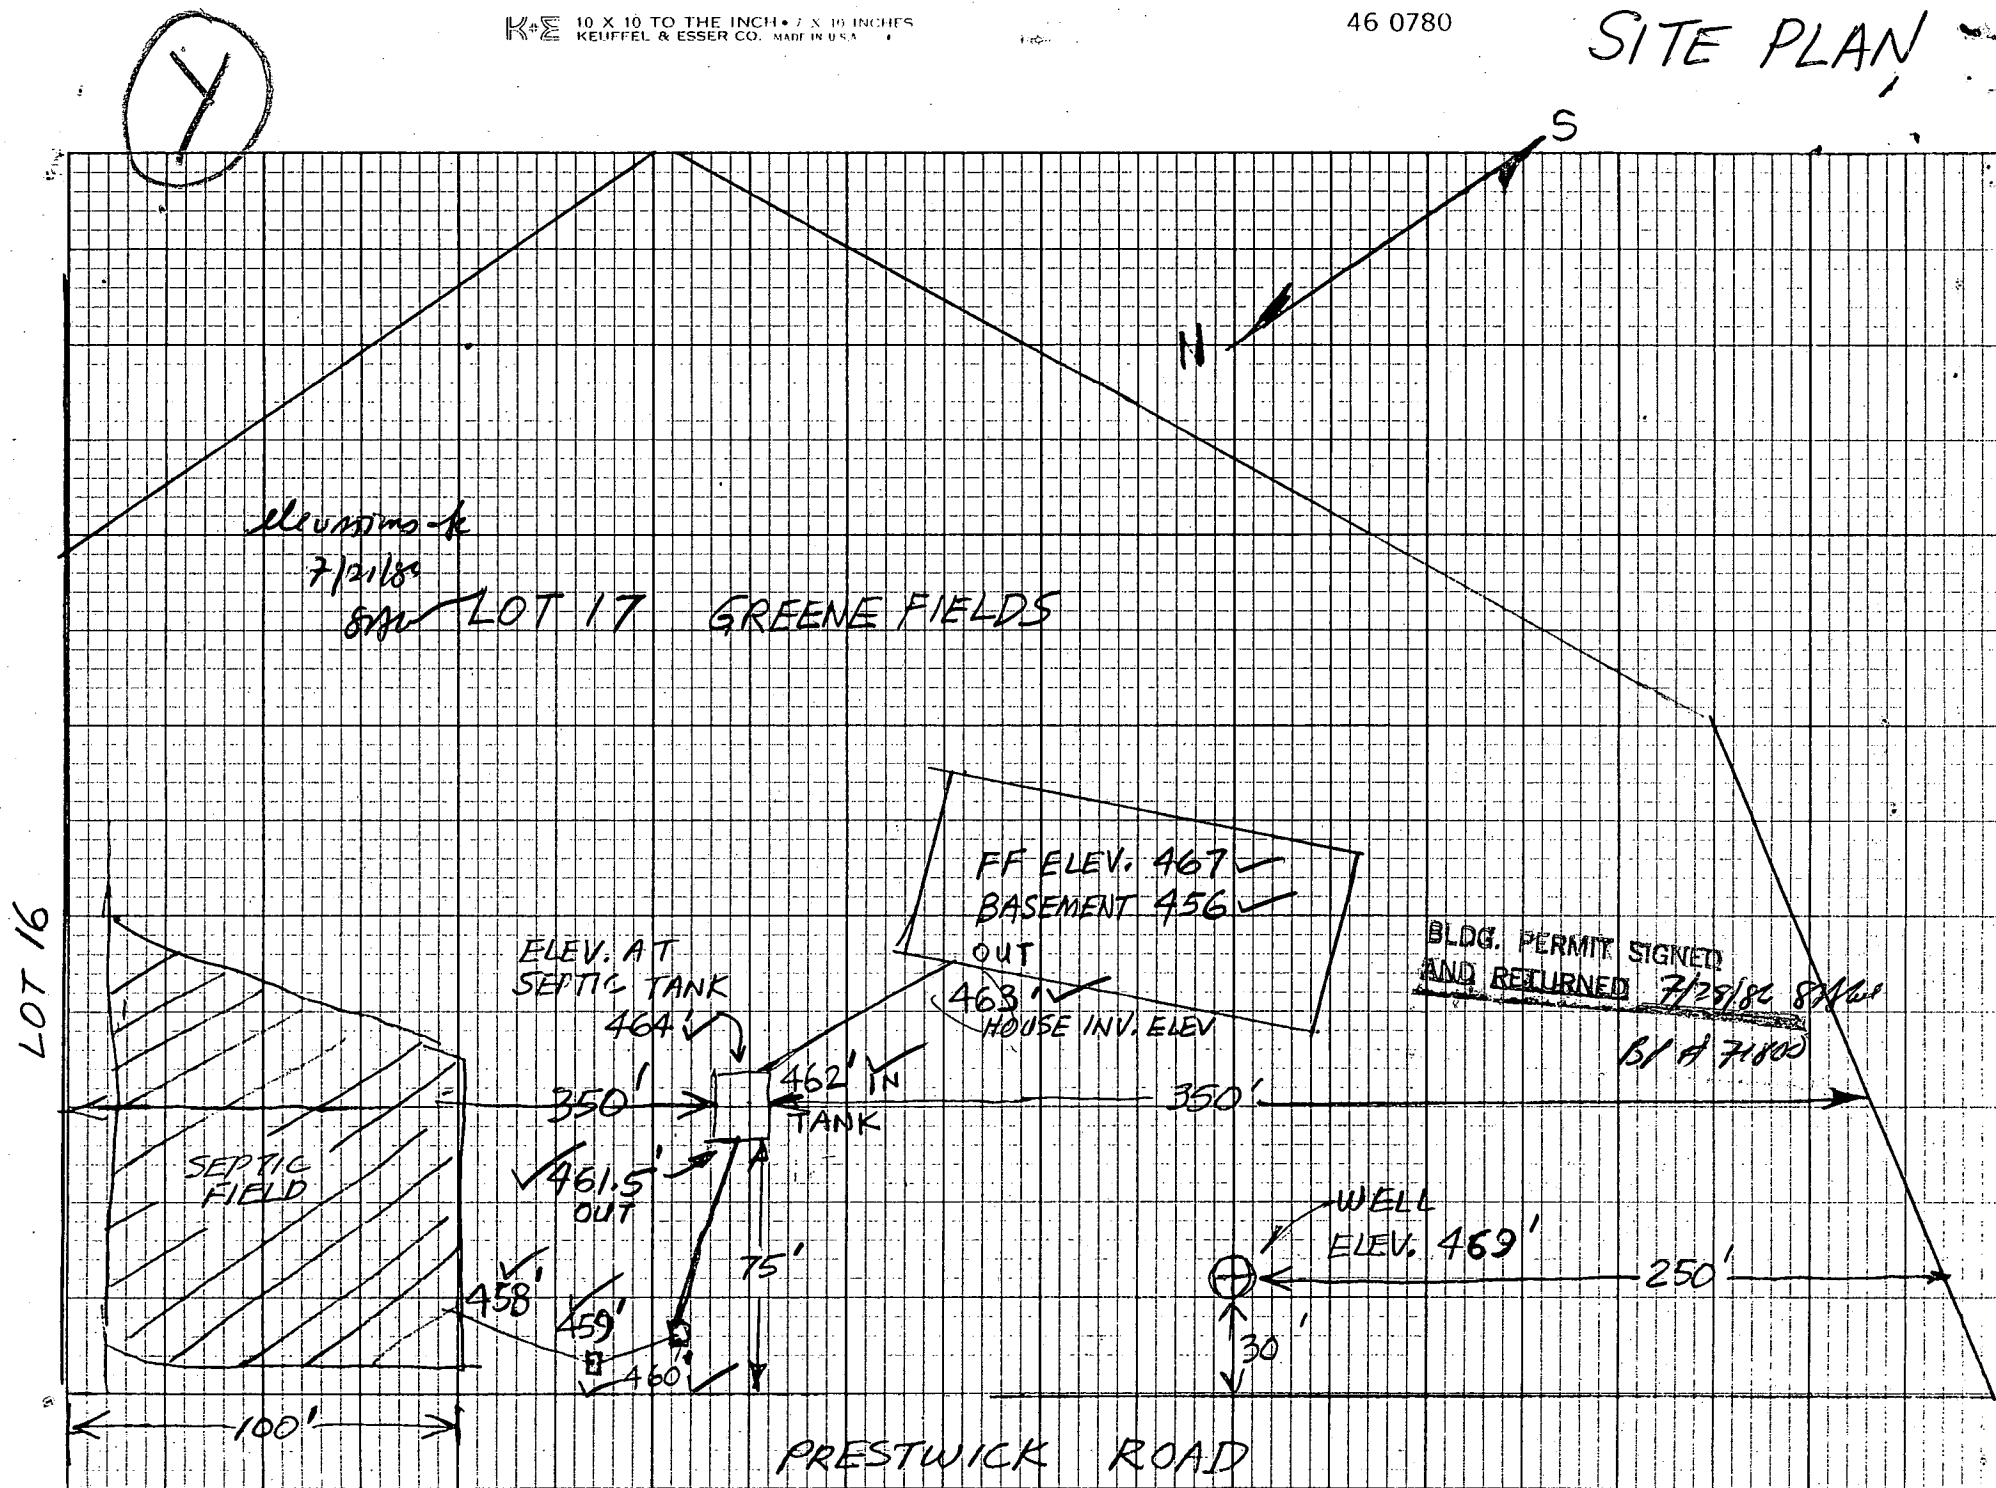

B 1 1093 (THIS NUMBER IS TO BE PUNCHED IN-COLS. 3-6 ON ALL CARDS)	SEQUENCE NO. (OEP USE ONLY)	STATE OF MARYLAND PERMIT TO DRILL WELL please print or type	OEP PERMIT NUMBER 10-81-1532 fill in this form completely
Date Received 7/23/86 OWNER INFORMATION 15 Last Name: V-P Owner: SAM 36 Street or RFD: 2101 Mt. H-ROCK DR. 57 Town: ELLIOTT 70 State: MD Zip: 21047		B 3 LOCATION OF WELL 8 COUNTY: HARRIS 23 SUBDIVISION: CLEVELAND SECTION: 7 LOT: 17 ARCHIE 52 NEAREST TOWN: HARRIS MILES FROM TOWN (enter 0 if in town): 1 MI	
DRILLER INFORMATION Driller's Name: Joseph L. Hargreaves 77 License No. 80: 238 Firm Name: Joseph L. Hargreaves Well Drilling Address: 5512 HEDGE RD. Mt. Airy 21771 Signature: [Signature] Date: 5/27/86		B 4 1 2 DIRECTION OF WELL FROM TOWN (CIRCLE BOX) 11 NEAR WHAT ROAD: Westville Rd. ON WHICH SIDE OF ROAD (CIRCLE APPROPRIATE BOX): WEST 34 37 DISTANCE FROM ROAD: 40 ENTER FT or MI: 40	
B 2 WELL INFORMATION 1 2 APPROX. PUMPING RATE (GAL. PER MIN.): 4 AVERAGE DAILY QUANTITY NEEDED (GAL. PER DAY): 10		NOT TO BE FILLED IN BY DRILLER HEALTH DEPARTMENT APPROVAL COUNTY NAME: HARRIS COUNTY NO. A 34894 OEP SIGNATURE: [Signature] STATE HEALTH INSERT S DATE ISSUED: 8/6/86 43 NORTH GRID: 494000 48 CO SIGNATURE: [Signature] 57 EAST GRID: 081200 63 EXP. DATE: 12/31/86	
USE FOR WATER (CIRCLE APPROPRIATE BOX) ☐ HOME (SINGLE OR DOUBLE HOUSEHOLD UNIT ONLY) ☐ FARMING (LIVESTOCK WATERING & AGRICULTURAL IRRIGATION) ☒ INDUSTRIAL, COMMERCIAL, STATE AND FEDERAL GOV. OTHER (REQUIRES APPROPRIATION PERMIT) ☐ PUBLIC OR PRIVATE WATER COMPANY (REQUIRES APPROPRIATION PERMIT AND STATE HEALTH DEPARTMENT APPROVAL) ☐ TEST, OBSERVATION, MONITORING (MAY REQUIRE APPROPRIATION PERMIT)		SHOW MAJOR FEATURES OF BOX & LOCATE WELL WITH AN X SOURCES OF DRILLING WATER: 1. well 2. well 3. well WRITE THE BOX NUMBER FROM THE MAP HERE: E 2102 N 4904 DRAW A SKETCH BELOW SHOWING LOCATION OF WELL IN RELATION TO NEARBY TOWNS AND ROADS AND GIVE DISTANCE FROM WELL TO NEAREST ROAD JUNCTION: 	
APPROXIMATE DEPTH OF WELL: 20 FEET APPROXIMATE DIAMETER OF WELL: 6 INCH METHOD OF DRILLING (circle one) 30 BORED (or Augered) 37 JETTED Jetted & DRIVEN AIR-ROTARY AIR-PERCussion ROTARY (Hydraulic Rotary) CABLE REVERSE-ROTARY Drive-POINT other:		REPLACEMENT OR DEEPEMED WELLS (CIRCLE APPROPRIATE BOX) ☒ THIS WELL WILL NOT REPLACE AN EXISTING WELL ☐ THIS WELL WILL REPLACE A WELL THAT WILL BE ABANDONED AND SEALED ☐ THIS WELL WILL REPLACE A WELL THAT WILL BE USED AS A STANDBY ☐ THIS WELL WILL DEEPEAN AN EXISTING WELL PERMIT NUMBER OF WELL TO BE REPLACED OR DEEPEMED (IF AVAILABLE): Not to be filled in by driller (OEP USE ONLY) APPROP. PERMIT NUMBER: GAP FORCE: 2 WRITE INITIALS IN BOX: 67 68 PERMIT No. 10-81-1532 SPECIAL CONDITIONS:	

D	719.00'	926.76'	270.90'	32° 59' 04"	N 30° 59' 32"E	593.98'
				32° 59' 04"	S 30° 59' 32"W	919.91'

GREENE FIELDS
SUT 20F3 SEC. II

84,370 ± OR 1.9367 ACRES OF
LAND DEDICATED TO HOWARD
COUNTY, MARYLAND FOR THE
PURPOSE OF A PUBLIC ROAD

LOT 4

DRIVE

LOT 2
130,680 ±
3.0 ACRES


PRESTWICK

LOT 17
178,556 ±
4.0991 ACRES

LOT 18
132,179 ±

LOT 16
169,944 ±

LOT 13

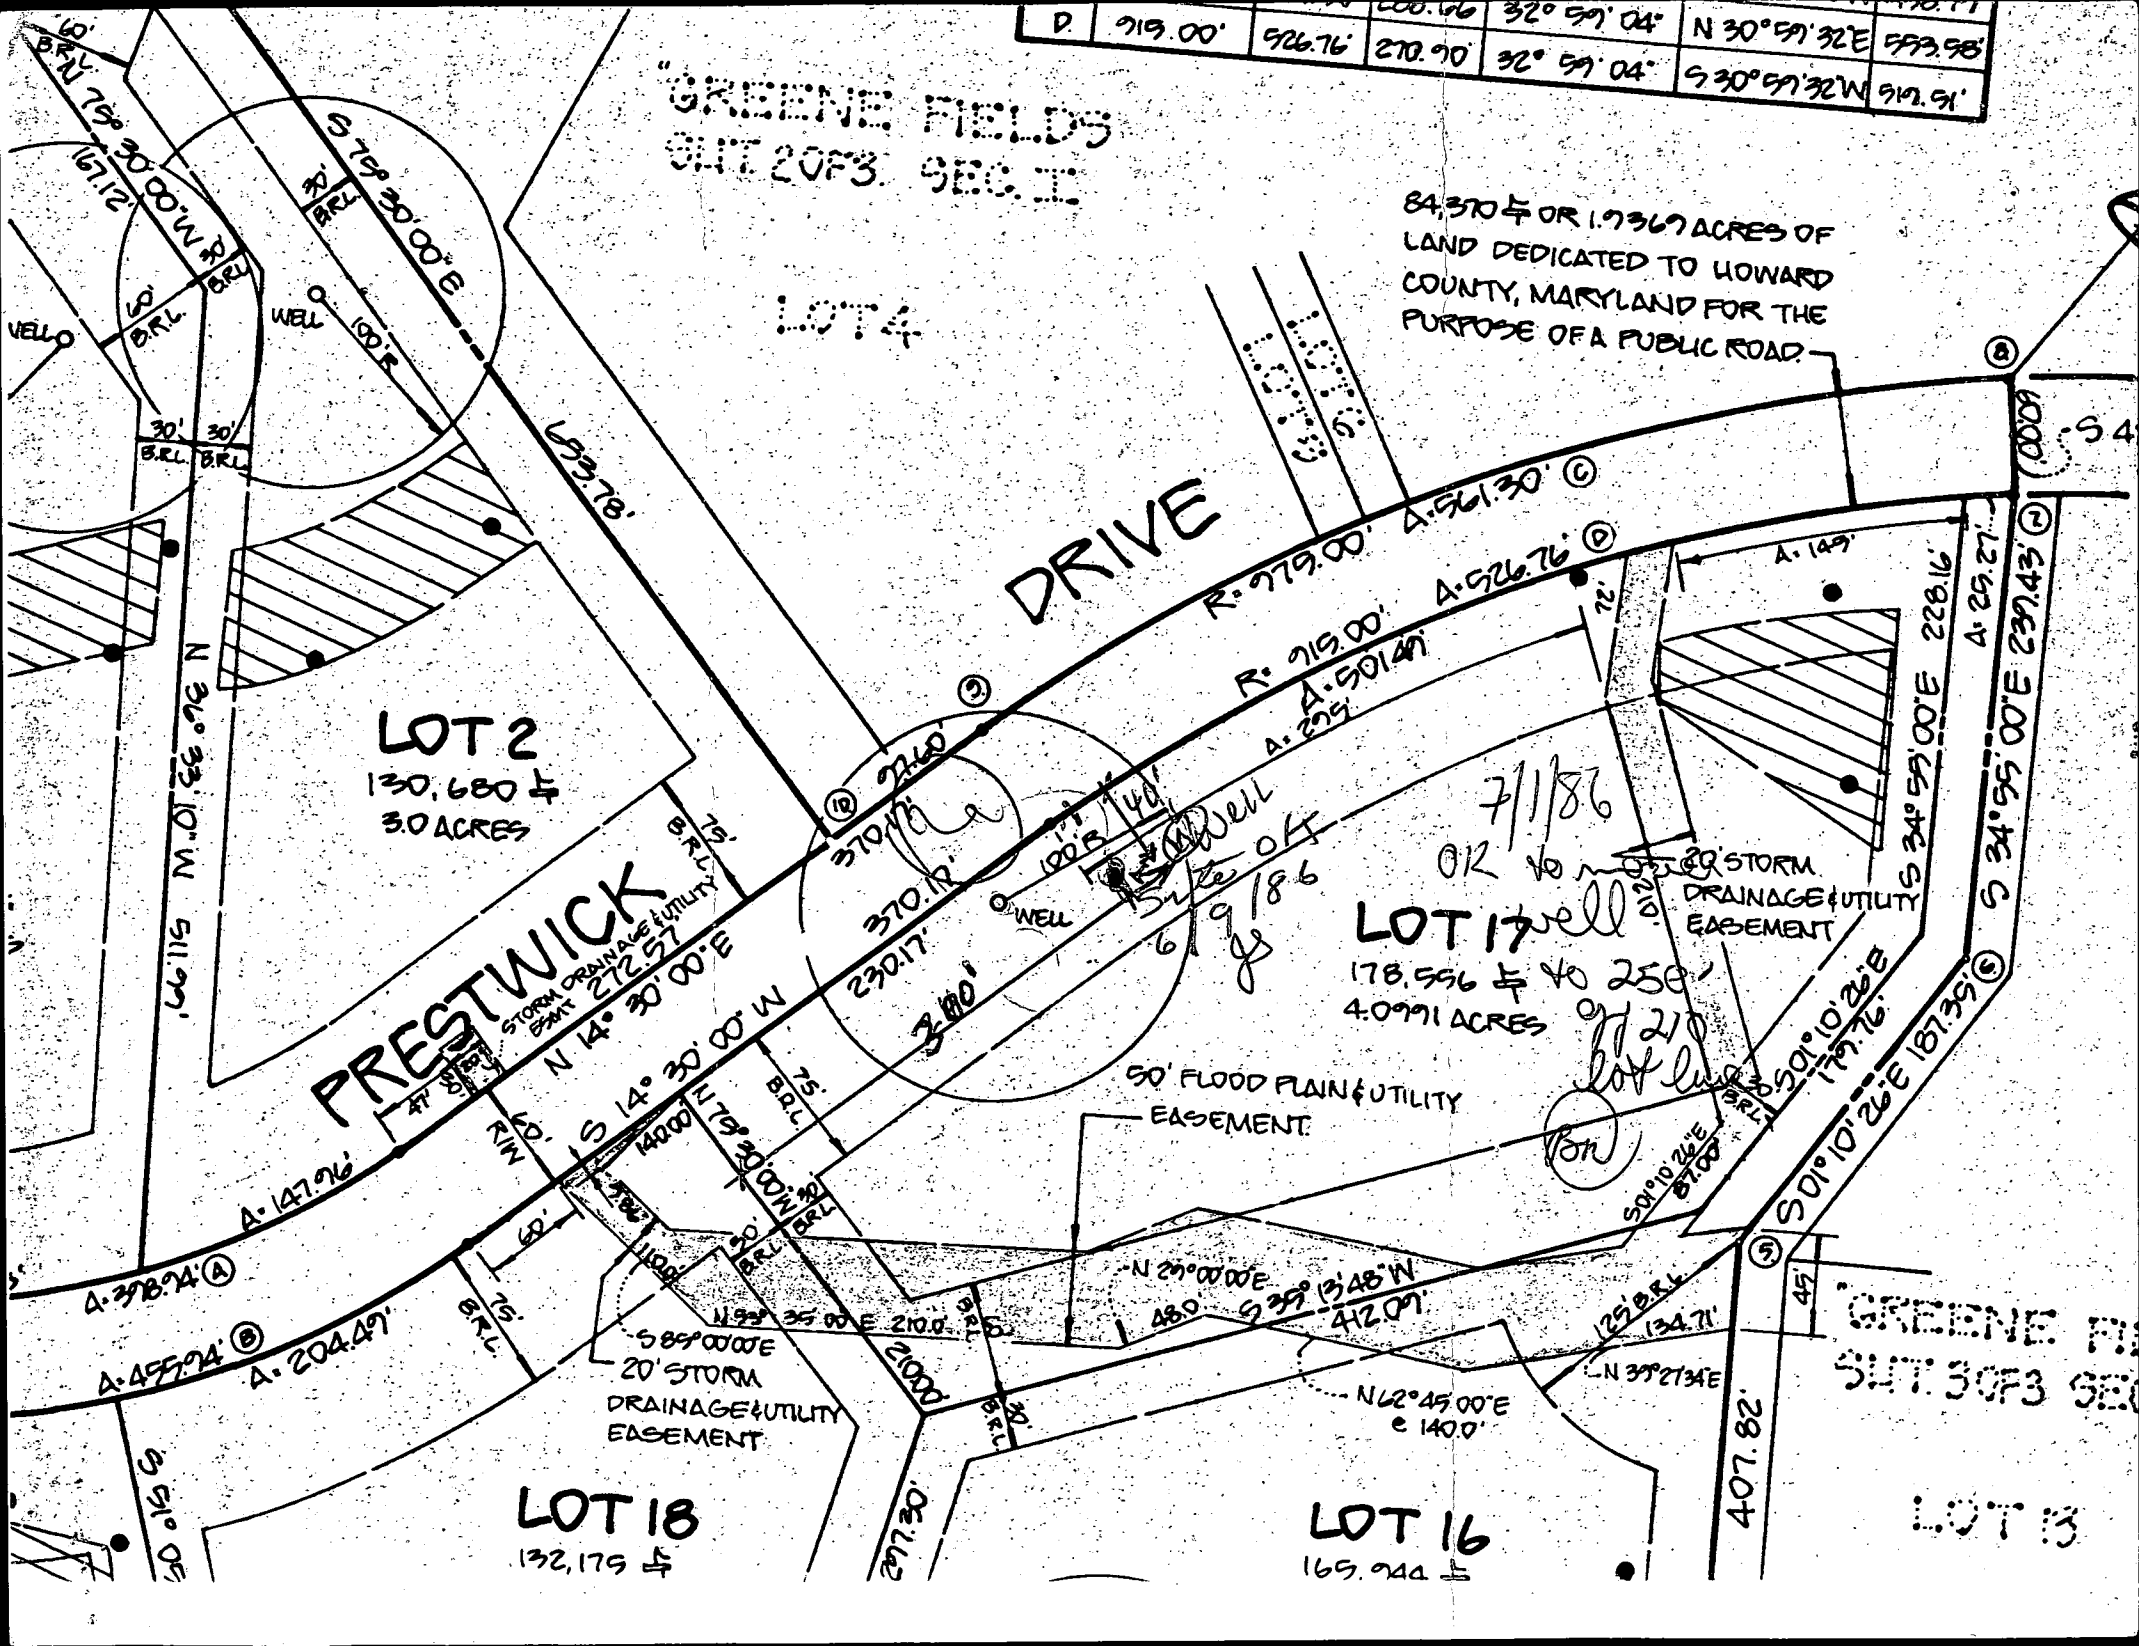

C1	2580	SEQUENCE NO. (OEP USE ONLY)	STATE OF MARYLAND WELL COMPLETION REPORT FILL IN THIS FORM COMPLETELY PLEASE PRINT OR TYPE	THIS REPORT MUST BE SUBMITTED WITHIN 45 DAYS AFTER WELL IS COMPLETED.
1 2 3 4 5 6 (THIS NUMBER IS TO BE PUNCHED IN COLS. 3-6 ON ALL CARDS)		COUNTY NUMBER A 34894		

DATE Received	DATE WELL COMPLETED	Depth of Well	PERMIT NO.
8 13	15 20	22 26 (TO NEAREST FOOT)	FROM "PERMIT TO DRILL WELL"
OWNER <u>YEP</u>		140-81-1532	
STREET OR RFD <u>RESTWICK DR</u>		TOWN <u>HIGHLAND</u>	
SUBDIVISION <u>GREENE FIELDS</u>		SECTION <u>1</u> LOT <u>17</u>	

WELL LOG Not required for driven wells		
STATE THE KIND OF FORMATIONS PENETRATED, THEIR COLOR, DEPTH, THICKNESS AND IF WATER BEARING		
DESCRIPTION (Use additional sheets if needed)	FEET FROM TO	Check if water bearing
SAND Stone	0 34	
GRAY Mich Rock	34 205	✓

GROUTING RECORD	
WELL HAS BEEN GROUTED (Circle Appropriate Box)	
TYPE OF GROUTING MATERIAL	CEMENT <u>CM</u> BENTONITE CLAY <u>BC</u>
NO. OF BAGS <u>14</u>	NO. OF POUNDS <u>1232</u>
GALLONS OF WATER <u>84</u>	
DEPTH OF GROUT SEAL (to nearest foot)	
from <u>0</u> ft.	to <u>33</u> ft.
(enter 0 if from surface)	
CASING RECORD	
casing types insert appropriate code below	<u>ST</u> <u>CO</u> STEEL CONCRETE <u>PL</u> <u>OT</u> PLASTIC OTHER
MAIN Nominal diameter Total depth CASING top (main) casing of main casing TYPE (nearest inch) (nearest foot)	
<u>ST</u> <u>6</u> <u>40</u>	<u>60</u> <u>61</u> <u>63</u> <u>64</u> <u>66</u> <u>70</u>

EACH CASING	OTHER CASING (if used)	
	diameter inch	depth (feet) from to

screen type or open hole insert appropriate code below	SCREEN RECORD
	<u>ST</u> <u>BR</u> <u>HO</u> STEEL BRASS OPEN BRONZE HOLE <u>PL</u> <u>OT</u> PLASTIC OTHER

C2 EACH SCREEN	DEPTH (nearest ft.)	
	<u>H0</u> <u>39</u> <u>205</u>	<u>8</u> <u>9</u> <u>11</u> <u>15</u> <u>17</u> <u>21</u>
	<u>23</u> <u>24</u> <u>26</u> <u>30</u> <u>32</u> <u>36</u>	<u>38</u> <u>39</u> <u>41</u> <u>45</u> <u>47</u> <u>51</u>
	SLOT SIZE 1 2 3	
DIAMETER OF SCREEN (NEAREST INCH)		
from to		
GRAVEL PACK		
IF WELL DRILLED WAS FLOWING WELL INSERT F IN BOX 68		

C3	PUMPING TEST	
1 2	HOURS PUMPED (nearest hour)	
	<u>3</u>	
	PUMPING RATE (gal. per min. to nearest gal.)	
	<u>10</u>	
	METHOD USED TO MEASURE PUMPING RATE	
	<u>bucket</u>	
	WATER LEVEL (distance from land surface)	
	BEFORE PUMPING	
	<u>13</u>	
	WHEN PUMPING	
	<u>80</u>	
	TYPE OF PUMP USED (for test)	
<u>A</u> air	<u>P</u> piston	<u>T</u> turbine
<u>C</u> centrifugal	<u>R</u> rotary	<u>O</u> other (describe below)
<u>J</u> jet	<u>S</u> submersible	

PUMP INSTALLED	
DRILLER WILL INSTALL PUMP YES (NO)	
IF DRILLER INSTALLS PUMP, THIS SECTION MUST BE COMPLETED FOR ALL WELLS EXCEPT HOME USE	
TYPE OF PUMP INSTALLED PLACE (A,C,J,P,R,S,T,O) IN BOX - SEE ABOVE:	
CAPACITY: GALLONS PER MINUTE (to nearest gallon)	
<u>31</u> <u>35</u>	
PUMP HORSE POWER	
<u>37</u> <u>41</u>	
PUMP COLUMN LENGTH (nearest ft.)	
<u>43</u> <u>47</u>	
CASING HEIGHT (circle appropriate box and enter casing height)	
<u>+</u> above	LAND SURFACE
<u>-</u> below	<u>1</u> (nearest foot)

CIRCLE APPROPRIATE LETTER
A A WELL WAS ABANDONED AND SEALED WHEN THIS WELL WAS COMPLETED
E ELECTRIC LOG OBTAINED
P TEST WELL CONVERTED TO PRODUCTION WELL

I HEREBY CERTIFY THAT THIS WELL HAS BEEN CONSTRUCTED IN ACCORDANCE WITH COMAR 10.17.13 "WELL CONSTRUCTION" AND IN CONFORMANCE WITH ALL CONDITIONS STATED IN THE ABOVE CAPTIONED PERMIT, AND THAT THE INFORMATION PRESENTED HEREIN IS ACCURATE AND COMPLETE TO THE BEST OF MY KNOWLEDGE.

DRILLERS IDENT. NO. <u>238</u>
DRILLERS SIGNATURE <u>Joseph L. Mayne</u>
SITE SUPERVISOR (sign. of driller or journeyman responsible for sitework if different from permittee)

OEP USE ONLY (NOT TO BE FILLED IN BY DRILLER)		
T (E.R.O.S.)	WQ	
70 72	74 75 76	
TELESCOPE CASING	LOG INDICATOR	OTHER DATA

LOCATION OF WELL ON LOT	
SHOW PERMANENT STRUCTURE SUCH AS BUILDING, SEPTIC TANKS, AND/OR LANDMARKS AND INDICATE NOT LESS THAN TWO DISTANCES (MEASUREMENTS TO WELL)	

34894

HOWARD COUNTY HEALTH DEPARTMENT
Bureau of Environmental Health
3525-H Ellicott Mills Drive
Ellicott City, MD 21043
461-9933

APPLICATION FOR PITLESS ADAPTER, WELL PUMP AND PRESSURE TANK INSTALLATION

New Installation ☒
Replacement ☐

Receipt # 39477
Date 6/16/87

Name of Installer GEORGE C NOULLETTelephone 391-7550License Number 2043Certified Well Pump Installer _____ Well Driller _____ Registered Plumber 2043Name of Property Owner SAMUEL YEP Telephone _____Subdivision GREENEFIELDS Lot # 17 Well Tag # _____Site Address 6564 BRESTWICK DR.

Pump

1. Type
a. Deep well jet _____
b. Shallow well jet _____
c. Submersible ☒

2. Make _____

3. Model # _____

4. Capacity _____ GPM

5. Pump exceeds well capacity Yes ☒ No _____6. If Yes, is low pressure cutoff switch installed? Yes ☒ No _____7. What methods are used to protect the pump and electrical wiring from vibrations? Torque arrestors _____ Cable guards ☒ Other _____

Motor

1. Horsepower _____

2. RPM _____

3. Voltage _____

a. 110 _____

b. 220 _____

Pitless Adapter

1. Make _____

2. Model # _____

3. Depth _____

Tank

1. Capacity 302. Pressure relief valve? YES

Piping

1. Type PLASTIC2. Size 1"3. NSF and/or BOCA Code approved YES4. Depth of supply line 3 FT.

Well data

1. Depth 110 ft.

2. Yield _____ GPM

3. Static water level _____ ft.

4. Will water supply be disinfected by installer? _____


I understand that it is my responsibility to notify the Howard County Health Department when the installation is ready for inspection (otherwise this permit is null and void).

All information given above is true to the best of my knowledge.

Signature of Applicant: George C NoulletDate: June 16, 1987

Note: A sticker indicating approval/status of the installation will be placed on the well casing at the time of the inspection.

OK to proceed

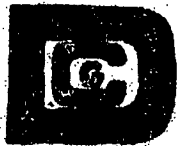

**DEVELOPMENT
CONSULTANTS
GROUP**

SURVEYORS, ENGINEERS & LAND PLANNERS

SUITE 102

17904 GEORGIA AVE.

OLNEY, MD 20852

924-4570

HOUSE LOCATION PLAT FOR 5. YEP

LOT 17 BLOCK

"GREENE FIELDS"

COUNTY OF HOWARD

PLAT BK.

PLAT NO. 6672

BOB/16627




NOTES:

WELL (W) & SEPTIC TANK (ST)
ARE SHOWN IN APPROX.
LOCATIONS. WELL IS
DRILLED, SEPTIC IN.

PROPOSED
SUNROOM
DECK WORK

OK
MR
3/14/99

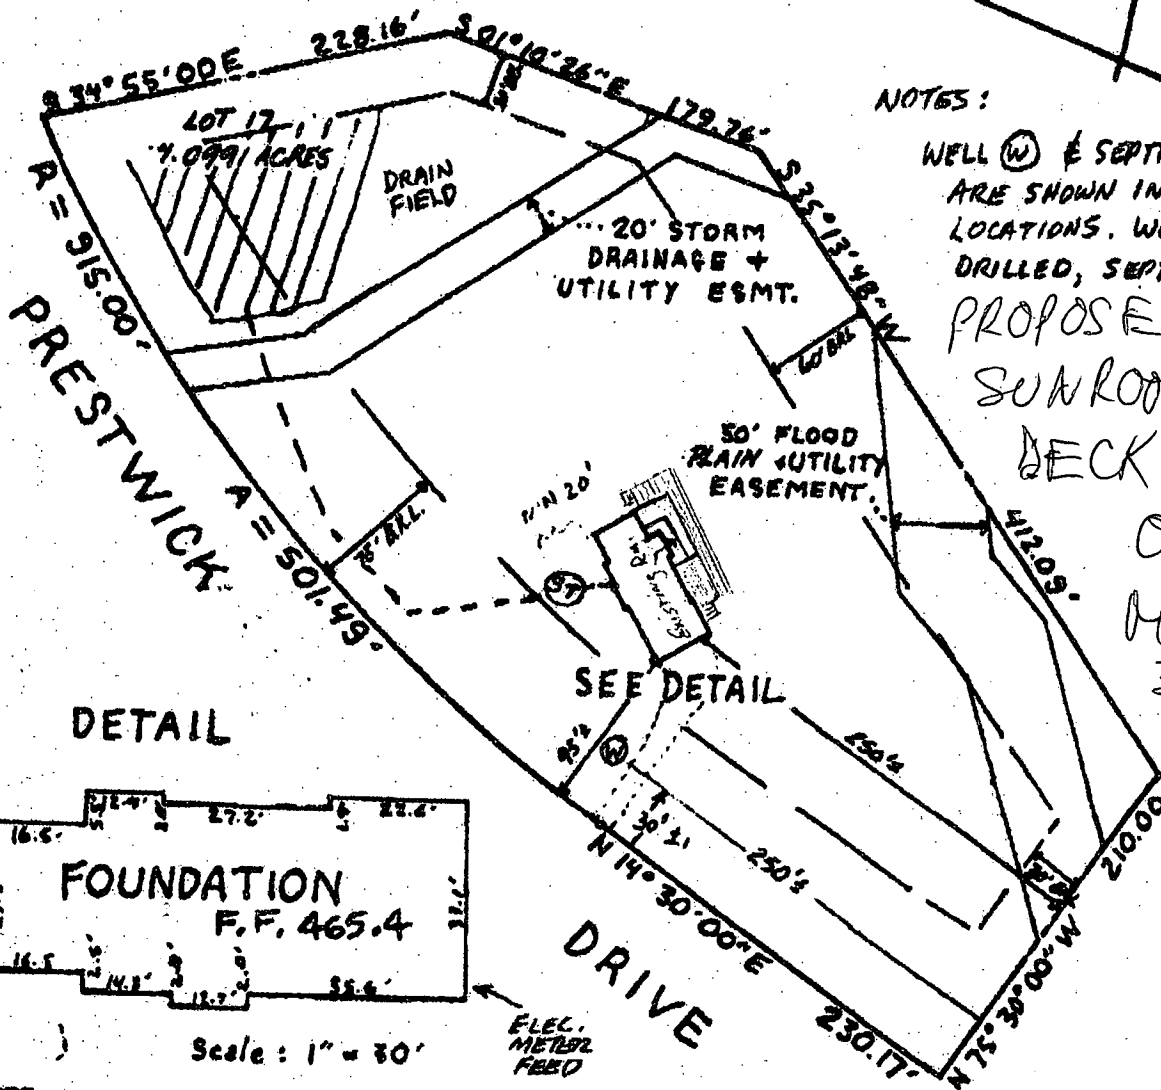

NOTE: Existence of property corners not guaranteed by this plat

SURVEYOR'S CERTIFICATION

I hereby certify that the property delineated hereon is in accordance with the Plat of Subdivision and/or deed of record, that the improvements were located by accepted field practices and include permanent visible structures and encroachments, if any. This Plat is not for determining property lines, but prepared for exclusive use of present owners of property and also those who purchase, mortgage, or guarantee the title thereto, within six months from date hereof, and as to them I warrant the accuracy of this Plat.

No title report furnished.

Jeffrey E. Lawrence
Professional Land Surveyor No 5216

Job No.	21-341
Scale:	1" = 100'
DATE	
Wall Ch:	11-18-86
Final Loc.	
Record:	