

1/22/88 AM

PERMIT

SEWAGE DISPOSAL SYSTEM

MARYLAND STATE DEPARTMENT OF HEALTH*

DISTRICT 3rd

HOWARD COUNTY
BUREAU OF ENVIRONMENTAL HEALTH
461-9933

03-310426
INDEXED

DATE 1/12/88

DATE SYSTEM APPROVED 1/29/88

INSPECTOR B.H.

P 40815
A 349059

Herman C. Sirk & Son IS PERMITTED TO INSTALL X ALTER

ADDRESS 2555 Jennings Chapel Road, Woodbine, Maryland PHONE 489-4724

SUBDIVISION Breezewood Farms ROAD 1880 Woodstock Rd LOT 7

PROPERTY OWNER Jay C. Grochmal
DR. Randy Reese WOODSTOCK 21163

ADDRESS Stephanie Albright & Bill Albright

IF GARBAGE GRINDER IS USED INCREASE SEPTIC TANK CAPACITY BY 50% AND ABSORPTION AREA BY 22%.

GARBAGE GRINDER? YES NO X

BLDG. PERMIT SIGNED
AND RETURNED 7/14/95
Serial # 60804-addition

SEPTIC TANK CAPACITY 1000 GALLONS NUMBER OF BEDROOMS 3

TRENCHES - 180 sq. ft. per bedroom. Trench to be 2 feet wide. Inlet 4 feet below original grade. Bottom maximum depth 8 feet below original grade. Effective area begins at 4 feet below original grade. 4 feet of stone below distribution pipe.

LOCATION - Place the distribution box 216 feet from the front lot line and 756 feet from the LEFT lot line as seen when facing the lot from Woodstock Road. Run trenches on contour toward the left lot line.

NOTE - No trench to exceed 100 feet in length. Provide 6" - 8" diameter cleanout and cap to grade or above on septic tank.

Addition Deck
BLDG. PERMIT SIGNED
AND RETURNED 8-22-95
Serial # 61289

PLANS APPROVED BY S. Abel

DATE 1/19/87

COVER NO WORK UNTIL INSPECTED AND APPROVED.

NEITHER THE HOWARD COUNTY COUNCIL NOR THE HEALTH DEPARTMENT IS RESPONSIBLE FOR THE SUCCESSFUL OPERATION OF ANY SYSTEM.

NOTE: CLEANOUT REQUIRED EVERY 70 FEET OF SEWER LINE AND/OR AT 90° SWEEPS IN LINES FROM HOUSE TO DRAIN FIELDS.

NOTE: ALL PARTS OF SEPTIC SYSTEMS (I.E., TANK, DISTRIBUTION BOX, TRENCHES) TO BE 100 FEET FROM WELL (UNLESS OTHERWISE SPECIFICALLY AUTHORIZED)

NOTE: IF DEEP TRENCH(ES) ARE USED CALL FOR INSPECTION BEFORE AND AFTER PLACING GRAVEL IN TRENCH(ES).

NOTE: NO DRY WELL SHALL EXCEED 15 FOOT IN DIAMETER. NO ABSORPTION TRENCH TO EXCEED 100 FEET IN LENGTH.

NOTE: ALL PIPE FROM HOUSE TO SEPTIC TANK MUST BE CAST IRON OR SCHEDULE 40 PVC OR ABS.

PERMIT VOID AFTER TWO YEARS.

NOTE: INSTALL STAND PIPE ON SEPTIC TANK AND DRY WELL. STAND PIPES MUST BE 6 INCHES IN DIAMETER. CAST IRON, CONCRETE OR TERRA COTTA OR PVC OR ABS ACCEPTED. IF TOP OF SEPTIC TANK IS DEEPER THAN 3 FEET, MANHOLE TO GRADE REQUIRED.

NOTE: DISTRIBUTION BOXES MUST HAVE BAFFLES.


BLDG. PERMIT SIGNED
AND RETURNED 7/18/91
Serial # 36351 - 509gal
BLDG. PERMIT SIGNED
AND RETURNED 7/30/90
Serial # 34121 - Pool

*INSTALLER IS RESPONSIBLE FOR OBTAINING FINAL APPROVAL ON THIS PERMIT

*CALL 461-9933 FOR INSPECTION OF SEPTIC SYSTEMS.

EH - 2-1186

A 34959

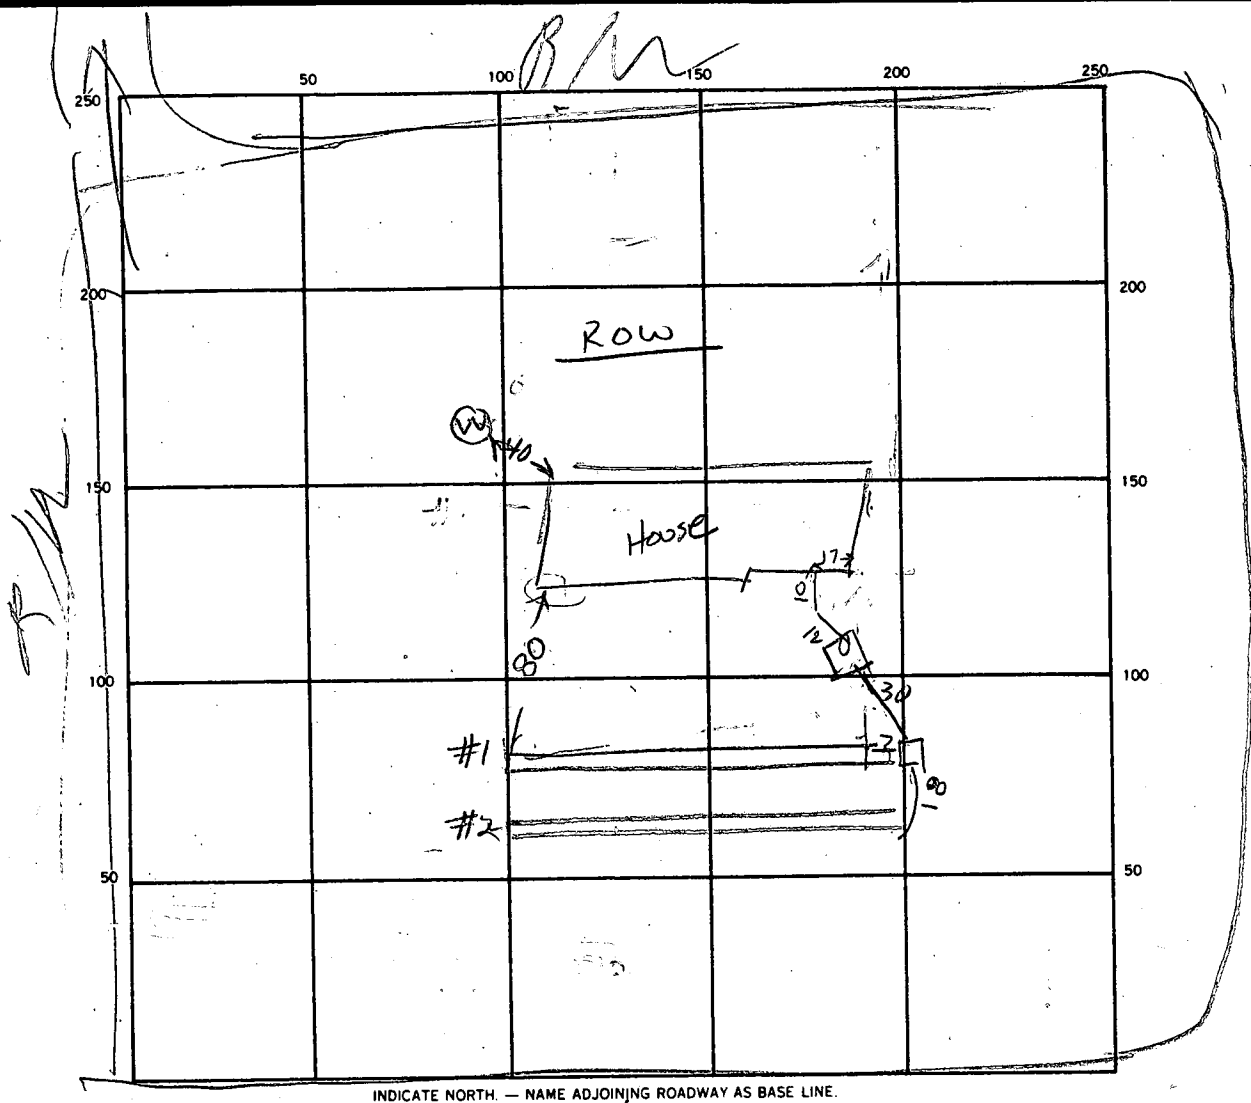

SEPTIC TANK, LEVEL _____ CLEANOUTS _____

DISTRIBUTION BOX, LEVEL _____

DRAIN FIELD/TILE FIELD, DEPTH $\frac{1}{8.5}$ $\frac{2}{9}$ FT. TRENCH WIDTH $\frac{1}{2}$ $\frac{2}{2}$ FT. INLET DEPTH $\frac{1}{3.5}$ $\frac{2}{3.5}$ FT.

EFFECTIVE GRAVEL DEPTH $\frac{1}{4.5}$ $\frac{2}{4.5}$ FT. TOTAL LENGTH $\frac{1}{91}$ $\frac{2}{95}$ FT. TOTAL $\frac{1}{789}$ $\frac{2}{640}$ SQ. FT. REQUIRE

NUMBER OF TRENCHES $\frac{1}{4.5}$ ONE SIDEWALL/BOTTOM AREA $\frac{1}{409}$ $\frac{2}{380}$ SQ. FT. 789 640

DRYWELL INSIDE DIAMETER _____ FT. EFFECTIVE DEPTH BELOW INLET _____ FT.

ABSORBENT AREA _____ SQ. FT.

REMARKS 1/22/88 - LOCATION OK TRENCH #1 & #2 DUG FILL TRENCHES

WITH STONE CALL RA

1/29/88 - TRENCHES OK

DATE SYSTEM APPROVED

1/29/88

INSPECTOR

Raymond Hodges

APPLICATION

SEWAGE DISPOSAL TESTING

STATE OF MARYLAND - DEPARTMENT OF HEALTH AND MENTAL HYGIENE

HOWARD COUNTY HEALTH DEPARTMENT
ENVIRONMENTAL HEALTH SERVICES

P. O. BOX 476 ELLICOTT CITY, MARYLAND 21043
TELEPHONE: 992-2330

A 34959

P _____

DISTRICT 3rd

DATE 2/11/85

TO: THE COUNTY HEALTH OFFICER
ELLICOTT CITY, MARYLAND

I, HEREBY, APPLY FOR THE NECESSARY TEST IN ORDER TO CONSTRUCT (OR RECONSTRUCT) A SEWAGE DISPOSAL SYSTEM.

PROPERTY OWNER Donald R. Reuwer, Jr.
12533 Folly Quarter Road
ADDRESS Ellicott City, Maryland PHONE 531-6455

PROPERTY LOCATION:

SUBDIVISION Reuwer Property LOT NO. 7

ROAD AND DESCRIPTION Woodstock Road

SIZE OF LOT 3.4 Acres TYPE BLDG. 3 or 4 Bedrooms
(NUMBER OF BEDROOMS)

THE SYSTEM INSTALLED UNDER THIS APPLICATION IS ACCEPTABLE ONLY UNTIL PUBLIC FACILITIES BECOME AVAILABLE. I FULLY UNDERSTAND THE
FEE CONNECTED WITH THE FILING OF THIS PERC TEST APPLICATION IS NON-REFUNDABLE UNDER ANY CIRCUMSTANCES. I ALSO AGREE TO COMPLY
WITH ALL M.O.S.H.A. REQUIREMENTS IN TESTING THIS LOT. /s/ Don Reuwer

(SIGNATURE OF APPLICANT)

APPROVED BY _____ FOR _____ DATE _____

REJECTED BY _____ FOR _____ DATE _____


HOLD PENDING FURTHER TESTS _____ DATE _____

REASONS FOR REJECTION OR HOLDING _____

THIS IS NOT A PERMIT

WOOD STOCK RD

45 80
95

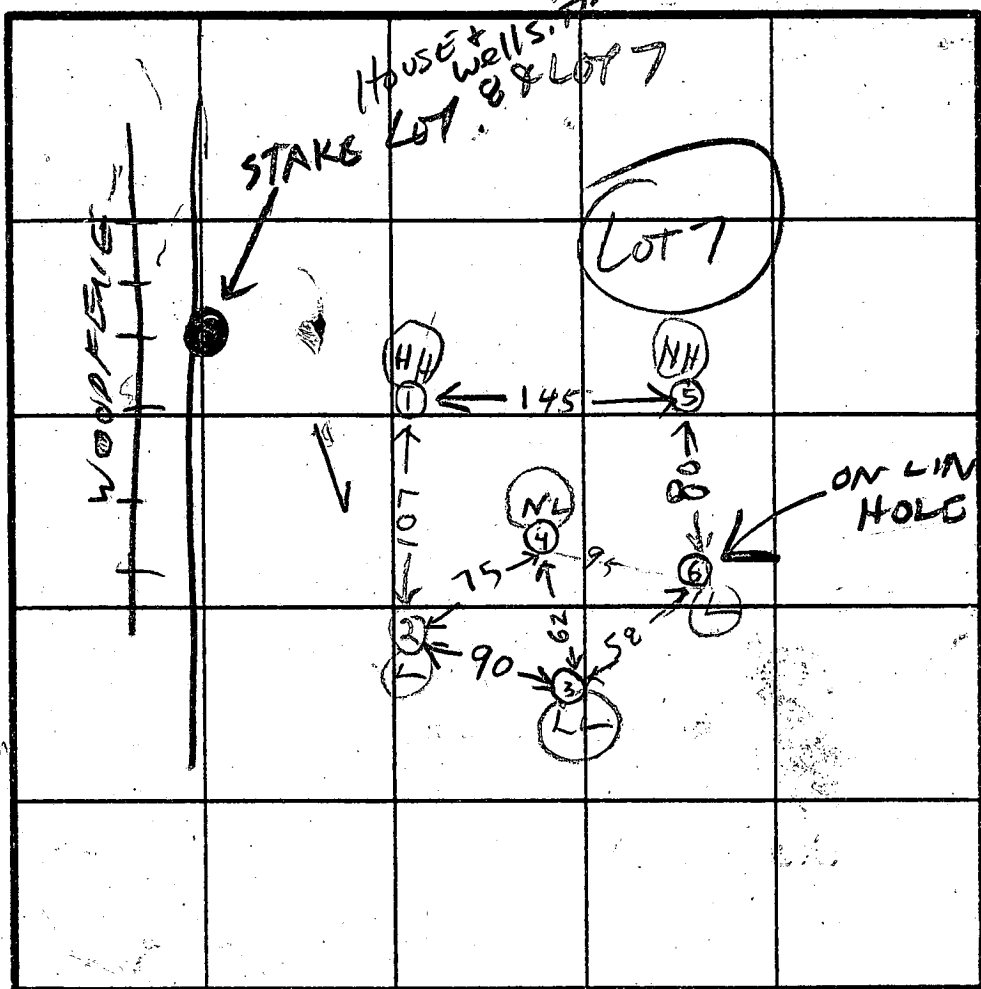

SOIL PROFILE

BROWN CLAY
LIGHT BROWN SAND LOAM

2 4
ALL BROWN GRAY SAND LOAM
3

BROWN CLAY
LIGHT BROWN SAND LOAM
WATER

5 6
BROWN CLAY
LIGHT BROWN SAND LOAM
12-1079

INDICATE NORTH - NAME ADJOINING ROADWAY AS BASE LINE.

HOLD ELEVATION
① = HIGHEST
⑤ = NEXT HIGHEST
③ = LOWEST
② = LOW
④ = NEXT LOW

DATE	TEST NO.	DEPTH	PRE-WET		TEST - 1" DROP		TIME
			START	STOP	START	STOP	
2/27/85	1 S	4	1047	1057	1057	1113	16
	1 V	12	2001	3 01			
	2 S	4	1052	1054	1054	1056	2
	2 V	13	4006	5 01			
	3 V	12	WATER		1117		
	4 V	12	LOOKS OK				
	5 S	4	1122	1124	1124	1126	2
	5 V	11	LOOKS OK				
2/27/85	6 S	4 1/2	1130	1132	1132	1138	5
	6 V	12	LOOKS OK				


X Perc Time
7 min
INLET 3'
BOTTOM 7'
158 P/B

REMARKS ⑥ - ON LINE HOLE FOR BOTH LOT 6 & LOT 7

TYPE OF SOIL

TESTED BY R. HODGES

ALSO PRESENT J. KETTERMAN
D. KETTERMAN

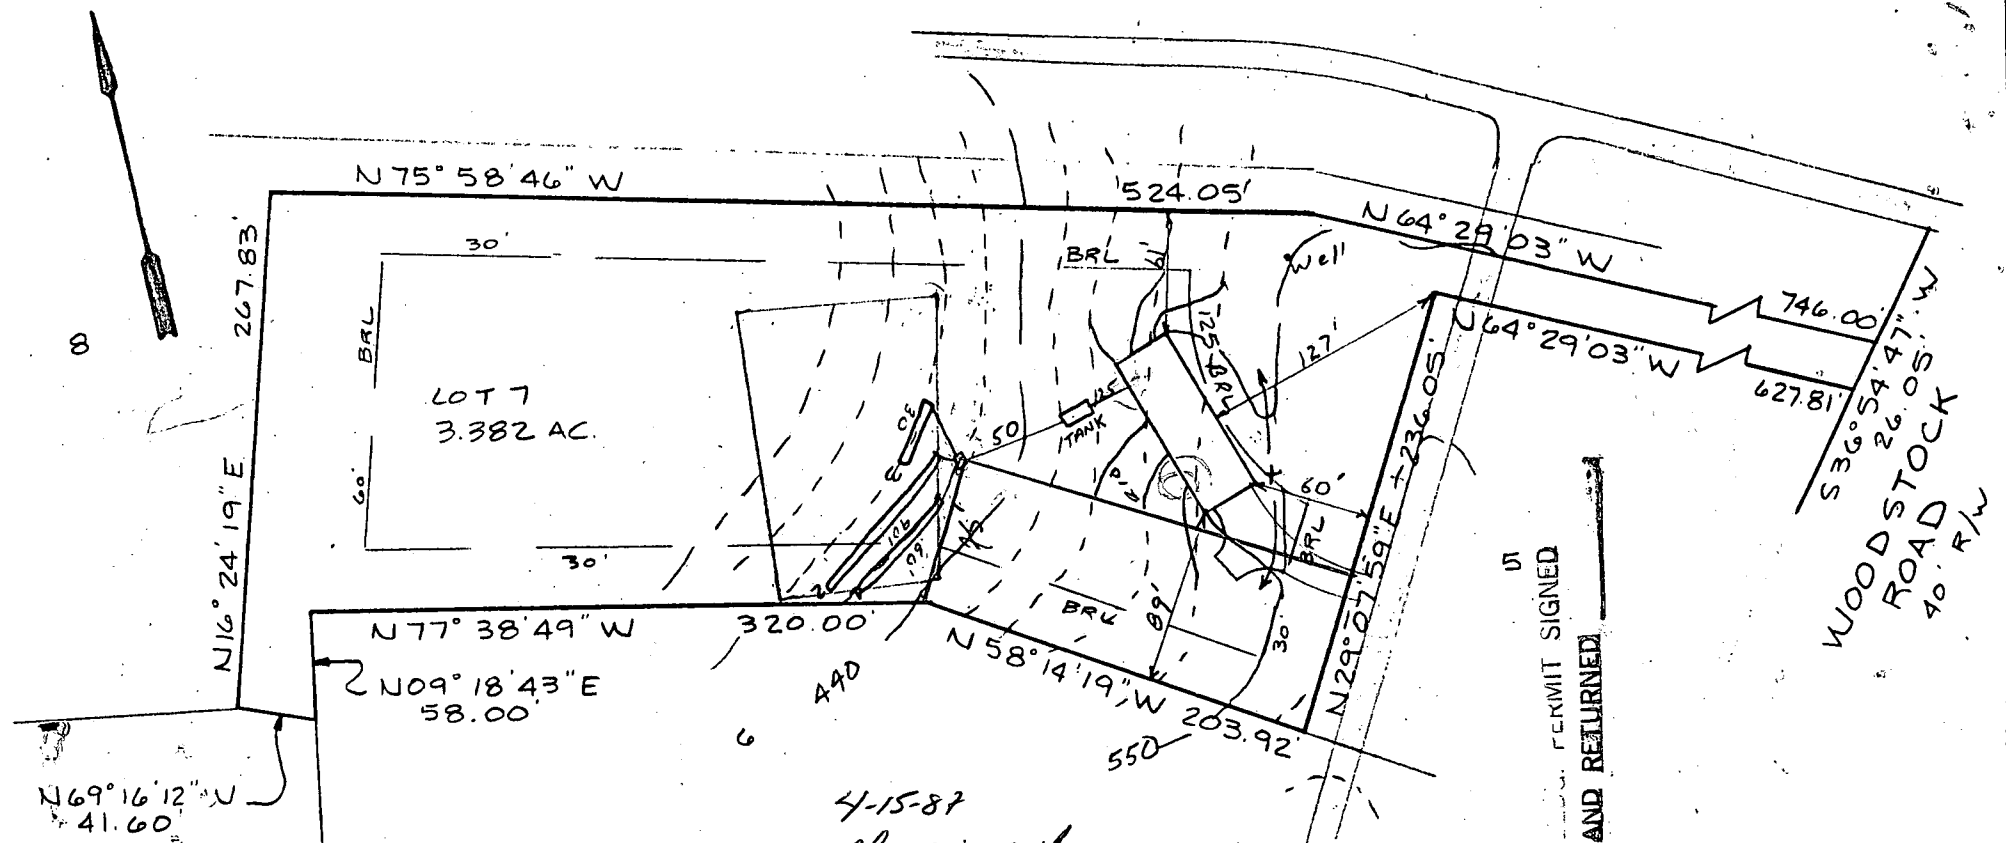

DAY 1015/447

4-15-87
elevations of
S. Shul

BLOG PERMIT SIGNED
AND RETURNED 4-15-87

BP 11152
S. Shul

HOUSE:

FIRST FLOOR 452.3 ✓
BASEMENT 443.3 ✓
INVERT 440.0 ✓ ⊕ BSMT

SEPTIC TANK:

EXISTING GRADE 442.5 ✓
PROPOSED GRADE 442.5 ✓
INVERT IN 439.25 ✓
INVERT OUT 439.0 ✓

DISTRIBUTION BOX:

EXISTING GRADE 438.0 ✓
INVERT IN 434.2 ✓
INVERT OUT 434.1 ✓

TRENCHES:



	#1	#2	#3
EXISTING	438.0 ✓	437.0 ✓	436.0 ✓
INVERT	434.0 ✓	433.0 ✓	432.0 ✓
BOTTOM	430.0 ✓	429.0 ✓	428.0 ✓
STONE	4.0 ✓	4.0 ✓	4.0 ✓
WIDTH	2.0 ✓	2.0 ✓	2.0 ✓
LENGHT	60.0	90.0	30.0 - OK FOR YBR

PLOT PLAN

LOT 7 BRIDGEWOOD FARMS
GLENELG MANOR II
TAX MAP 10 PARCEL 36
3rd ELECTION DISTRICT
HOWARD COUNTY, MD.
SCALE 1"=100' DATE 3/17/87

I certify that the above measurements
and elevations are actual and true for
this property.

J. Carl Hudgins
J. Carl Hudgins

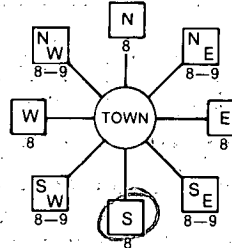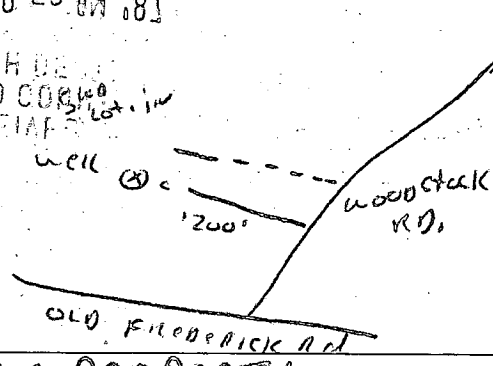B 1 2091	SEQUENCE NO. (OEP USE ONLY)	STATE OF MARYLAND PERMIT TO DRILL WELL please print or type	OEP PERMIT NUMBER HB-81-1920 fill in this form completely
Date Received 		B 3 LOCATION OF WELL	
OWNER INFORMATION REESE RANDY 4213 PULITZER CIRCLE EILICOTT CITY MD 21043		HOWARD BREZEWOOD FARMS SECTION 44 LOT 48 WOODSTOCK MILES FROM TOWN (enter 0 if in town) 2 MI	
DRILLER INFORMATION Ralph Mayne 9120 Brown Church Rd. Mt. Airy Ralph Mayne 2/24/87		B 4 DIRECTION OF WELL FROM TOWN (CIRCLE BOX) 	
WELL INFORMATION APPROX. PUMPING RATE (GAL. PER MIN.) 5 AVERAGE DAILY QUANTITY NEEDED (GAL. PER DAY) 500		NEAR WHAT ROAD WOODSTOCK RD. ON WHICH SIDE OF ROAD (CIRCLE APPROPRIATE BOX) NORTH WEST SOUTH EAST DISTANCE FROM ROAD 1200 ENTER FT or MI FT	
USE FOR WATER (CIRCLE APPROPRIATE BOX) ☒ HOME (SINGLE OR DOUBLE HOUSEHOLD UNIT ONLY) ☐ FARMING (LIVESTOCK WATERING & AGRICULTURAL IRRIGATION) ☐ INDUSTRIAL, COMMERCIAL, STATE AND FEDERAL GOV. OTHER (REQUIRES APPROPRIATION PERMIT) ☐ PUBLIC OR PRIVATE WATER COMPANY (REQUIRES APPROPRIATION PERMIT AND STATE HEALTH DEPARTMENT APPROVAL) ☐ TEST, OBSERVATION, MONITORING (MAY REQUIRE APPROPRIATION PERMIT)		NOT TO BE FILLED IN BY DRILLER HEALTH DEPARTMENT APPROVAL HOWARD COUNTY NAME OEP SIGNATURE DATE ISSUED 02/19/87 COUNTY NO. A 34961 STATE HEALTH INSERT S CO SIGNATURE EXP. DATE 08/19/87 NORTH GRID 541000 EAST GRID 0832000	
APPROXIMATE DEPTH OF WELL 150 FEET APPROXIMATE DIAMETER OF WELL 6" INCH		SHOW MAJOR FEATURES OF BOX & LOCATE WELL WITH AN X SOURCES OF DRILLING WATER 1. well 2. 3. WRITE THE BOX NUMBER FROM THE MAP HERE 8302 5401	
METHOD OF DRILLING (circle one) BORED (or Augered) JETTED Jetted & DRIVEN AIR-ROTARY AIR-PERCussion ROTARY (Hydraulic Rotary) CABLE REVERSE-ROTARY Drive-POINT other		REPLACEMENT OR DEEPENED WELLS (CIRCLE APPROPRIATE BOX) ☒ THIS WELL WILL NOT REPLACE AN EXISTING WELL ☐ THIS WELL WILL REPLACE A WELL THAT WILL BE ABANDONED AND SEALED ☐ THIS WELL WILL REPLACE A WELL THAT WILL BE USED AS A STANDBY ☐ THIS WELL WILL DEEPEAN AN EXISTING WELL PERMIT NUMBER OF WELL TO BE REPLACED OR DEEPEANED (IF AVAILABLE)	
Not to be filled in by driller (OEP USE ONLY) APPROP. PERMIT NUMBER FORCE INITIALS IN BOX PERMIT NO. HB-81-1920 SPECIAL CONDITIONS 465-5522 SAME TAG, SAME PROPERTY, NEW OWNER		DRAW A SKETCH BELOW SHOWING LOCATION OF WELL IN RELATION TO NEARBY TOWNS AND ROADS AND GIVE DISTANCE FROM WELL TO NEAREST ROAD JUNCTION 	

Well Permit No. HO - 81-1920
Location of property (road) WOODSTOCK RD
Subdivision BREEZEWOOD FARMS Lot 7 Block Plat Sec.
Well Driller R. MAYNE Owner ~~ZENTGRAF, QUANE~~
RESSE, RANDY

Depth of well _____

Distance of measuring point (M.P.) above ground _____

Static water level (S.W.L.) below M.P. _____

Time pump started _____ Pumping rate _____
Total time _____ to reach pumping water level _____ ft. below M.P.

[illegible]

H₂O sample dropped
off 4/14/87
H1050

C1 04955		SEQUENCE NO. (OEP USE ONLY)		STATE OF ILLINOIS WELL COMPLETION REPORT FILL IN THIS FORM COMPLETELY PLEASE PRINT OR TYPE		THIS REPORT MUST BE SUBMITTED WITHIN 45 DAYS AFTER WELL IS COMPLETED.	
(THIS NUMBER IS TO BE PUNCHED IN COLS. 3-6 ON ALL CARDS)						COUNTY NUMBER A34961	
DATE Received 8 13		DATE WELL COMPLETED 15 041187 20		Depth of Well 22 300 26 (TO NEAREST FOOT)		PERMIT NO. FROM "PERMIT TO DRILL WELL" 40-81-1926 28 29 30 31 32 33 34 35 36 37	
OWNER KEESE CANDY		last name		first name		TOWN ELLICOTT CITY MD.	
STREET OR RFD 213		PULITZER CIRCLE				LOT 7	
SUBDIVISION BREEZEWOOD FARMS		SECTION —				LOT 7	
WELL LOG Not required for driven wells		GROUTING RECORD		C 3		PUMPING TEST	
STATE THE KIND OF FORMATIONS PENETRATED, THEIR COLOR, DEPTH, THICKNESS AND IF WATER BEARING		WELL HAS BEEN GROUTED (Circle Appropriate Box) Y N		HOURS PUMPED (nearest hour) 3		PUMPING RATE (gal. per min. to nearest gal.) 7	
DESCRIPTION (Use additional sheets, if needed)		TYPE OF GROUTING MATERIAL CEMENT CM BENTONITE CLAY BC		METHOD USED TO MEASURE PUMPING RATE Bucket		WATER LEVEL (distance from land surface) BEFORE PUMPING 35	
FEET FROM TO		NO. OF BAGS 14 NO. OF POUNDS 1400		WHEN PUMPING 105		TYPE OF PUMP USED (for test)	
Top Soil 0 2		GALLONS OF WATER 84		TYPE OF PUMP USED (for test)		A air P piston T turbine	
Sandy 2 50 ✓		DEPTH OF GROUT SEAL (to nearest foot)		TYPE OF PUMP USED (for test)		C centrifugal R rotary O other (describe below)	
Sand Stone 50 60		from 0 ft. to 50 ft.		TYPE OF PUMP USED (for test)		J jet S submersible	
Micka 60 80		(enter 0 if from surface)		PUMP INSTALLED		DRILLER WILL INSTALL PUMP YES NO	
Sand Stone 80 85 ✓		OTHER CASING (if used)		PUMP INSTALLED		IF DRILLER INSTALLS PUMP, THIS SECTION MUST BE COMPLETED FOR ALL WELLS EXCEPT HOME USE	
Micka 85 220		diameter inch depth (feet) from to		PUMP INSTALLED		TYPE OF PUMP INSTALLED PLACE (A,C,J,P,R,S,T,O) IN BOX - SEE ABOVE:	
Sand Stone 220 275 ✓		EACH CASING		PUMP INSTALLED		CAPACITY: GALLONS PER MINUTE (to nearest gallon)	
Micka 275 300		screen type or open hole		PUMP INSTALLED		PUMP HORSE POWER	
		insert appropriate code below		PUMP INSTALLED		PUMP COLUMN LENGTH (nearest ft.)	
		ST BR HO STEEL BRASS OPEN HOLE PL OT PLASTIC OTHER		PUMP INSTALLED		CASING HEIGHT (circle appropriate box and enter casing height)	
		C 2		PUMP INSTALLED		LAND SURFACE (nearest foot)	
		DEPTH (nearest ft.)		PUMP INSTALLED		LOCATION OF WELL ON LOT	
		1 HO 62 300		PUMP INSTALLED		SHOW PERMANENT STRUCTURE SUCH AS BUILDING, SEPTIC TANKS, AND/OR LANDMARKS AND INDICATE NOT LESS THAN TWO DISTANCES (MEASUREMENTS TO WELL)	
		2 23 24 26 30 32 36		PUMP INSTALLED		Pole Line	
		3 38 39 41 45 47 51		PUMP INSTALLED		140' 40' 800'	
		SLOT SIZE 1 2 3		PUMP INSTALLED		Well	
		DIAMETER OF SCREEN (NEAREST INCH)		PUMP INSTALLED			
		from to		PUMP INSTALLED			
		GRAVEL PACK		PUMP INSTALLED			
		IF WELL DRILLED WAS FLOWING WELL INSERT F IN BOX 68		PUMP INSTALLED			
		OEP USE ONLY (NOT TO BE FILLED IN BY DRILLER)		PUMP INSTALLED			
		T (E.R.O.S.) WQ		PUMP INSTALLED			
		70 72 74 75 76		PUMP INSTALLED			
		TELESCOPE CASING LOG INDICATOR OTHER DATA		PUMP INSTALLED			
CIRCLE APPROPRIATE LETTER A A WELL WAS ABANDONED AND SEALED WHEN THIS WELL WAS COMPLETED E ELECTRIC LOG OBTAINED P TEST WELL CONVERTED TO PRODUCTION WELL		I HEREBY CERTIFY THAT THIS WELL HAS BEEN CONSTRUCTED IN ACCORDANCE WITH COMAR 10.17.13 "WELL CONSTRUCTION" AND IN CONFORMANCE WITH ALL CONDITIONS STATED IN THE ABOVE CAPTIONED PERMIT, AND THAT THE INFORMATION PRESENTED HEREIN IS ACCURATE AND COMPLETE TO THE BEST OF MY KNOWLEDGE.		DRILLERS IDENT. NO. 223		DRILLERS SIGNATURE (MUST MATCH SIGNATURE ON APPLICATION)	
				DRILLERS SIGNATURE		SITE SUPERVISOR (sign. of driller or journeyman responsible for sitework if different from permittee)	

B 1		SEQUENCE NO. (OEP USE ONLY)		STATE OF MARYLAND PERMIT TO DRILL WELL		OEP PERMIT NUMBER	
THIS NUMBER IS TO BE PUNCHED IN COLS. 3-6 ON ALL CARDS)				please print or type		fill in this form completely	
Date Received				LOCATION OF WELL			
OWNER INFORMATION				8 COUNTY			
Last Name Owner First Name				23 SUBDIVISION			
Street or RFD				SECTION LOT			
Town State Zip				52 NEAREST TOWN			
DRILLER INFORMATION				MILES FROM TOWN (enter 0 if in town)			
Driller's Name License No.				DIRECTION OF WELL FROM TOWN (CIRCLE BOX)			
Firm Name Address Signature Date				ON WHICH SIDE OF ROAD (CIRCLE APPROPRIATE BOX)			
WELL INFORMATION				NOT TO BE FILLED IN BY DRILLER HEALTH DEPARTMENT APPROVAL			
APPROX. PUMPING RATE (GAL. PER MIN.)				COUNTY NAME COUNTY NO.			
AVERAGE DAILY QUANTITY NEEDED (GAL. PER DAY)				OEP SIGNATURE STATE HEALTH INSERT S			
USE FOR WATER (CIRCLE APPROPRIATE BOX)				DATE ISSUED CO SIGNATURE EXP. DATE			
APPROXIMATE DEPTH OF WELL FEET				NORTH GRID EAST GRID			
APPROXIMATE DIAMETER OF WELL INCH				SHOW MAJOR FEATURES OF BOX & LOCATE WELL WITH AN X			
METHOD OF DRILLING (circle one)				SOURCES OF DRILLING WATER			
BORED (or Augered) JETTED Jetted & DRIVEN				WRITE THE BOX NUMBER FROM THE MAP HERE			
AIR-ROTary AIR-PERCussion ROTARY (Hydraulic Rotary)				DRAW A SKETCH BELOW SHOWING LOCATION OF WELL IN RELATION TO NEARBY TOWNS AND ROADS AND GIVE DISTANCE FROM WELL TO NEAREST ROAD JUNCTION			
CABLE REVERSE-ROTary Drive-POINT				other			
REPLACEMENT OR DEEPEMED WELLS (CIRCLE APPROPRIATE BOX)				N			
THIS WELL WILL NOT REPLACE AN EXISTING WELL				WOODSTOCK			
THIS WELL WILL REPLACE A WELL THAT WILL BE ABANDONED AND SEALED				well @			
THIS WELL WILL REPLACE A WELL THAT WILL BE USED AS A STANDBY				WOODSTOCK RD.			
THIS WELL WILL DEEPMEN AN EXISTING WELL				mid 99			
PERMIT NUMBER OF WELL TO BE REPLACED OR DEEPEMED (IF AVAILABLE)							
Not to be filled in by driller (OEP USE ONLY)							
APPROP. PERMIT NUMBER							
FORCE INITIALS WRITE IN BOX				PERMIT No.			
SPECIAL CONDITIONS							

1-18-88
Anytime

HOWARD COUNTY HEALTH DEPARTMENT
Bureau of Environmental Health
3525-H Ellicott Mills Drive
Ellicott City, MD 21043
461-9933

APPLICATION FOR PITLESS ADAPTER, WELL PUMP AND PRESSURE TANK INSTALLATION

New Installation X
Replacement _____

Receipt # 40811
Date 1/11/88

Name of Installer FENCH Plumbing & Heating

Telephone 4142-5729

License Number 6318

Certified Well Pump Installer _____ Well Driller _____ Registered Plumber X

Name of Property Owner Randy Reese

Telephone 465-5522

Subdivision BREEZEWOOD FARMS Lot # 7

Well Tag # _____

Site Address 1850 Woodstock Rd

Pump

1. Type
 - a. Deep well jet _____
 - b. Shallow well jet _____
 - c. Submersible X
2. Make Goulds
3. Model # _____
4. Capacity 7 GPM
5. Pump exceeds well capacity Yes _____ No X
6. If Yes, is low pressure cutoff switch installed? Yes _____ No _____
7. What methods are used to protect the pump and electrical wiring from vibrations? Torque arrestors _____ Cable guards X Other _____

Motor

1. Horsepower 3/4
2. RPM 1746
3. Voltage 230
 - a. 110 _____
 - b. 220 _____

Pitless Adapter

1. Make _____
2. Model # _____
3. Depth _____

Tank

1. Capacity 42 gal
2. Pressure relief valve? Yes

Piping

- PLASTIC
1. Type tan
 2. Size 1 in
 3. NSF and/or BOCA Code approved _____
 4. Depth of supply line 300 ft

Well data

1. Depth 325 ft.
2. Yield 16 GPM
3. Static water level _____ ft.
4. Will water supply be disinfected by installer? Yes

1-18-88 Trench full of melt water, Drain before covering, SEN - (over)

I understand that it is my responsibility to notify the Howard County Health Department when the installation is ready for inspection (otherwise this permit is null and void).


All information given above is true to the best of my knowledge.

Signature of Applicant: Kenny J. Seys

Date: 1/11/88

Note: A sticker indicating approval/status of the installation will be placed on the well casing at the time of the inspection.

30
24
120
60

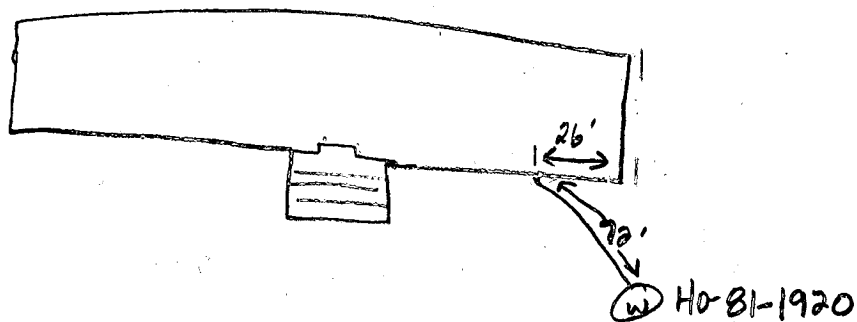

1-18-88 Well line covered with water from snow melt. Pitless adaptor about 42 inches below surface. House connection ok. Pump tank installed with pressure relief valve. Allow trench to drain before covering. JEN,

Woodstock Rd

GARDEN ARKITECTS



a division of Grounds & Gardens

8/22/95


BUILDING PERMIT # 61289

Re: 1880 Woodstock Rd
Woodstock Md 21089

During the pre construction process our crew uncovered the existing holding tank clean out. It was very close to an existing timber wall so we redesigned and moved the wall back approx 4' to provide better access to the clean out and to remove the wall from being on the tank edge. We also will be installing subsurface drain pipe to move any water away from the area and away from the tank. The new design will allow better clean out access for the tank and better drainage for the area near the tank.

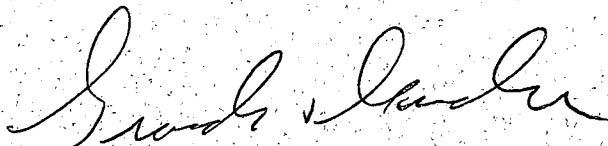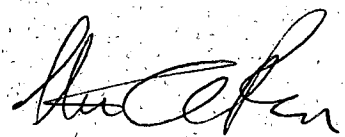
EDUCATION DRAWING

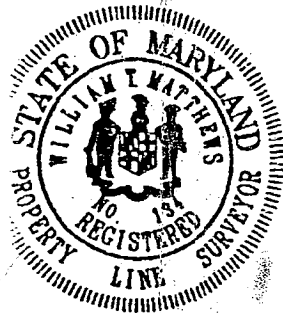

of benefit to a consumer only is required by a lender or a company or its agent in connection with transfer, financing or re-financing, to be relied upon for the establishment of fences, garages, buildings, or other future improvements. The plat is for the accurate identification of any lines, but such identification is required for the transfer of title or financing or refinancing. The approximate dwelling is shown in relation to the lot lines for the property known as 180 Woodstock Road, Prince George's County, Maryland

Matthews 5/19/95

Design Corporation
22 Bellona Lane
Arlington, Maryland 21204
(410) 823-5000
0115 Scale 1" = 120' 95-279

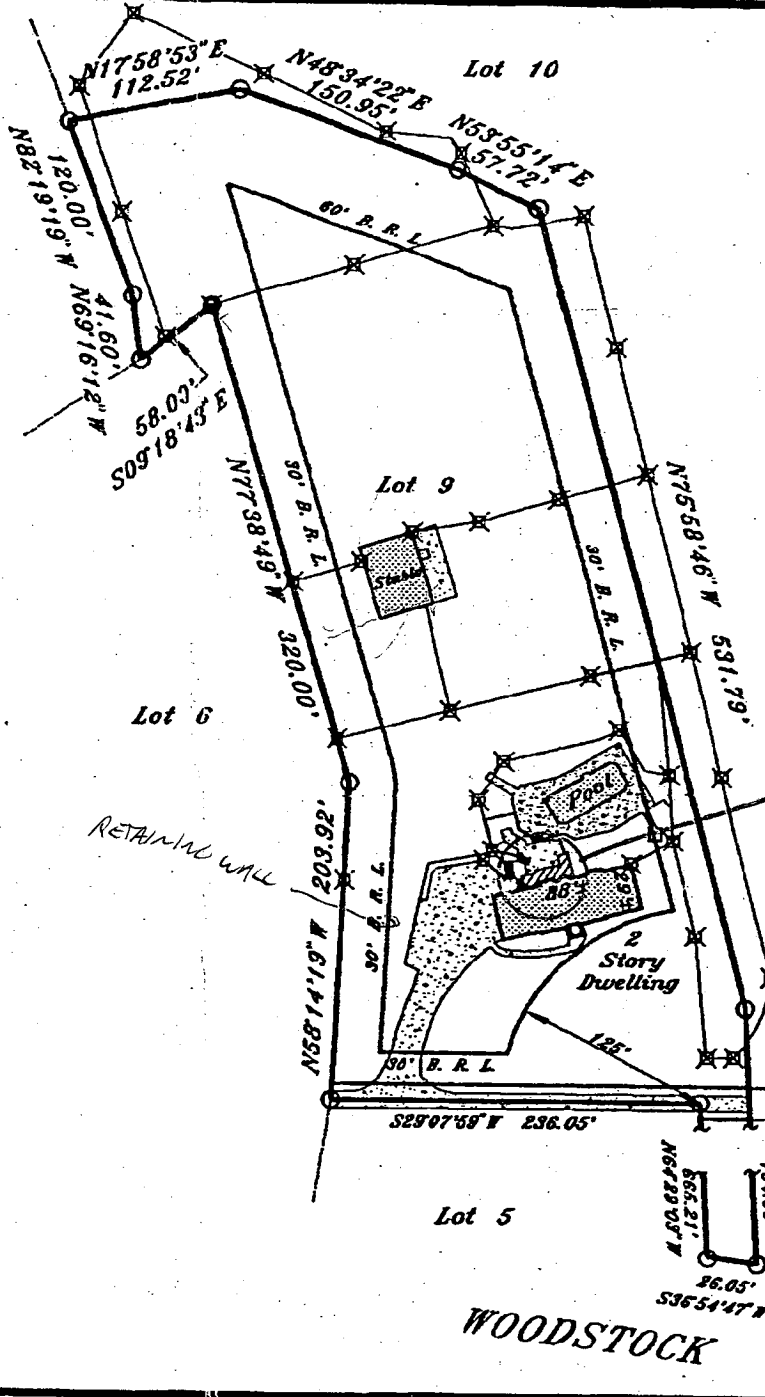

Lot Number : 9
Block/Section : -
Plat Reference : 10063
Title of Plat : Amended Plat of Reuwer's Breezewood Farms, Lots 9 and 10

Replacing existing Deck
See attached

8/22/95 DECK ADDITION APPROVED

SEE LETTER OF UNDERSTANDING RE:


30 61789, *John J. Sanitarian*

20' Easement for Ingress and Egress for Lots 2, 5, 6, 9 & 10


Easement for Ingress and Egress for Lots 5, 6, 9 & 10

Property lies in Flood Zone C
(F.E.M.A. Map Panel Number 240044 0010 B, Dated 12/04/85)

LANDING SITTING ON TIMBER ~~RECTANGLE~~ NO FOOTERS TOP LANDING 4" TO TOP OF PACE
 84" CHANGE IN ELEVATION FLAGSTONE TO DECK

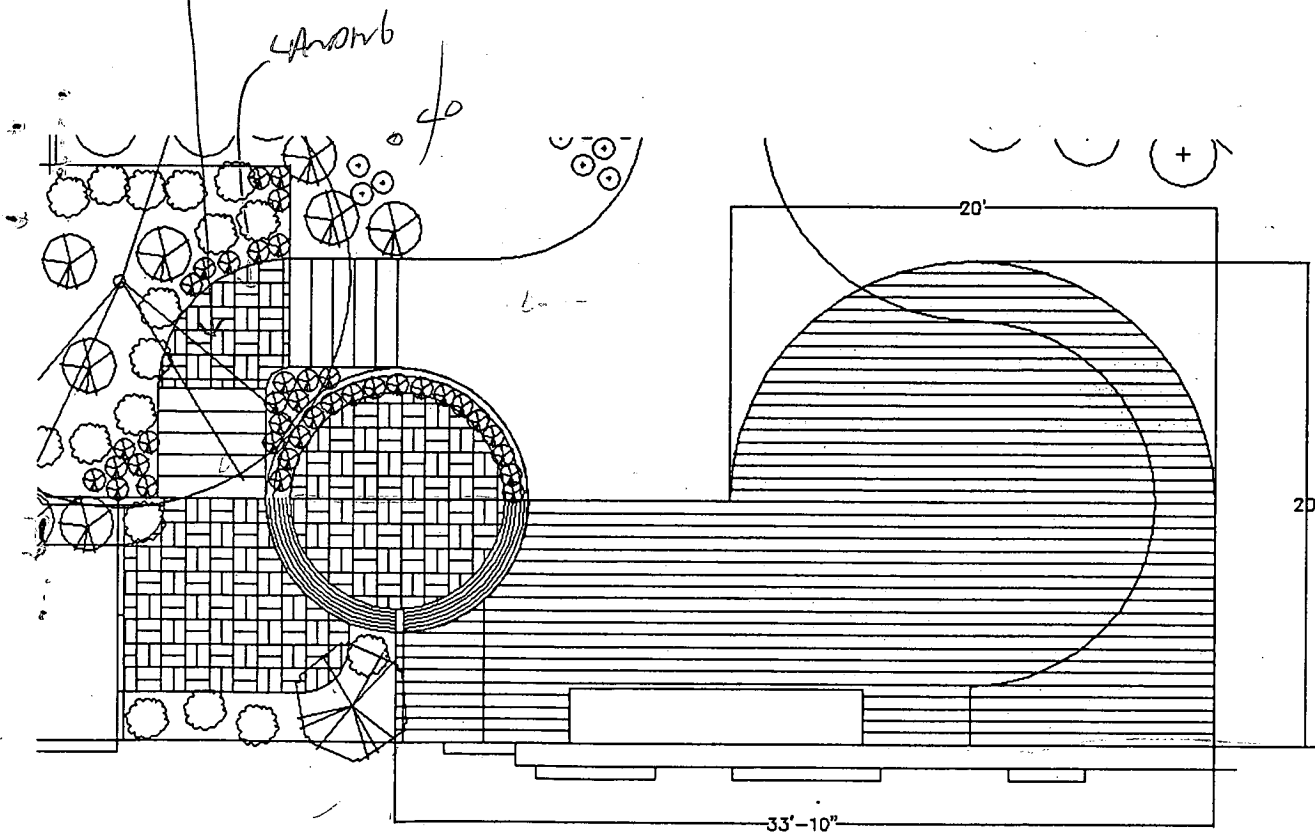

Deck on Rear of house
 20' x 20' + 10' x 14'

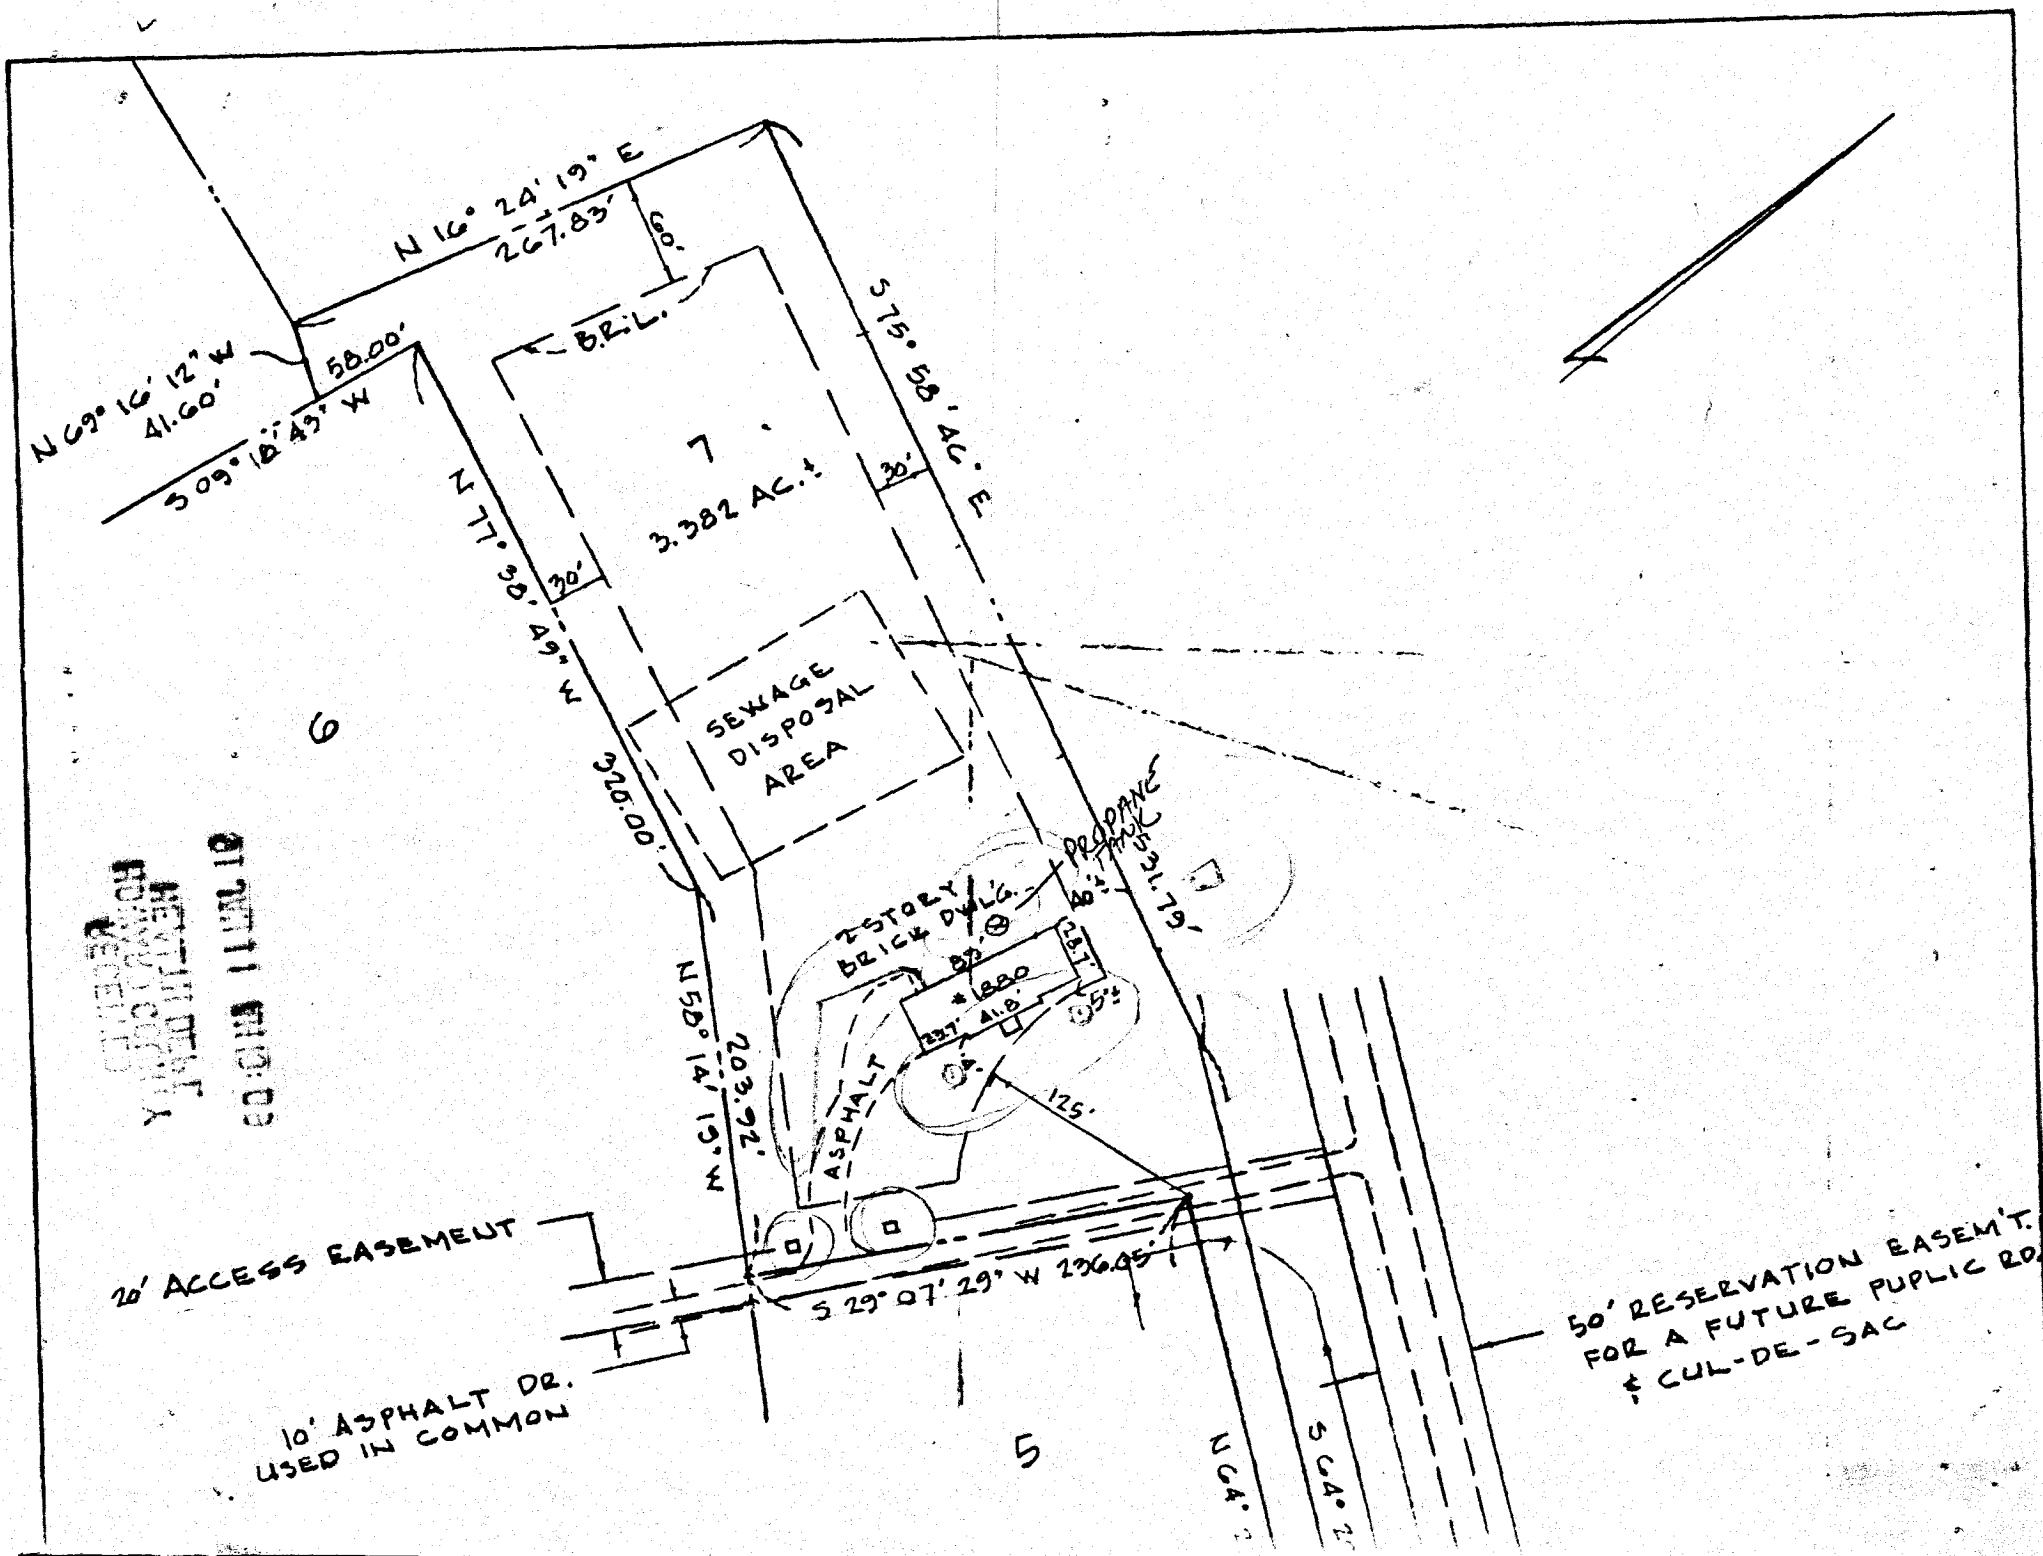

Note:

Designated as Lot No. 7, as shown on the Plat entitled "Reuwer's Breezewood Farms Lots 5-8 A Resubdivision of Lots 3 and 4, Beckett Property," which Plat is recorded among the Land Records of Howard County as Plat No. 6477.

NOT IN FLOOD ZONE

I hereby certify that I have made a survey of this lot for the purpose of locating the improvements thereon and that they are located as shown.

George D. Saine

REG. NO. 8012

MD. RTE. #99

1/18/91

OK TO SIGN PLANS OK

WOODSTOCK ROAD
(ULTIMATE 80' R/W - PAVED 24')

SCALE 1" = 100'	LOCATION SURVEY 1880 Woodstock Road 3rd District Howard Co., Md.	
DATE 11/4/89	GENERAL SURVEYING CO. LAND & TOPOGRAPHIC SURVEYS	
JOB No. 89538	9 Lake Forest Court Baltimore, Md. 21236	

The seal is circular with a double border. The outer ring contains the text "STATE OF MARYLAND" at the top and "PROFESSIONAL LAND SURVEYOR" at the bottom. The inner circle features the coat of arms of the State of Maryland, which depicts two figures holding a shield. Above the shield is a scroll with the motto "DEI PATRI". Below the shield, the text "NO. 8012" and "REGISTERED" are visible.

NOTE: This plat is not intended for use in establishing property lines.



The plat is of benefit to a consumer only insofar as it is required by a lender or a title insurance company or its agent in connection with contemplated transfer, financing or re-financing. The plat is not to be relied upon for the establishment or location of fences, garages, buildings, or other existing or future improvements. The plat does not provide for the accurate identification of property boundary lines, but such identification may not be required for the transfer of title or securing financing or refinancing. The approximate location of the dwelling is shown in relation to the apparent property lines for the property known as

1880 Woodstock Road
Howard County, Maryland

William T. Matthews

5/19/95

Ruxton Design Corporation
8422 Bellona Lane
Towson, Maryland 21204
(410) 823-5000

Fax (410) 823-0115

Scale 1" = 120'

95-279

EXISTING
DECK

OK TO SIGN

PORCH ADDITION

7/14/95 MR

Lot 6


Lot 9

Lot 5

WOODSTOCK ROAD

Lot Number : 9
Block/Section : -
Plat Reference : 10063
Title of Plat : Amended Plat of Reuwer's Brestwood Farms, Lots 9 and 10

SCALE: 1" = 70'

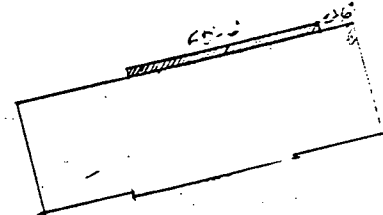

20' Easement for
Ingress and Egress
for Lots 2,5,6,9 & 10


Easement for
Ingress and Egress
for Lots 5,6,9 & 10

Property lies in Flood Zone
C
(F.E.M.A. Map Panel Number
14004 0010 B, Dated 12/04/76)

8/18/95 8/22/95

NOT FINAL CONFIGURATION

88

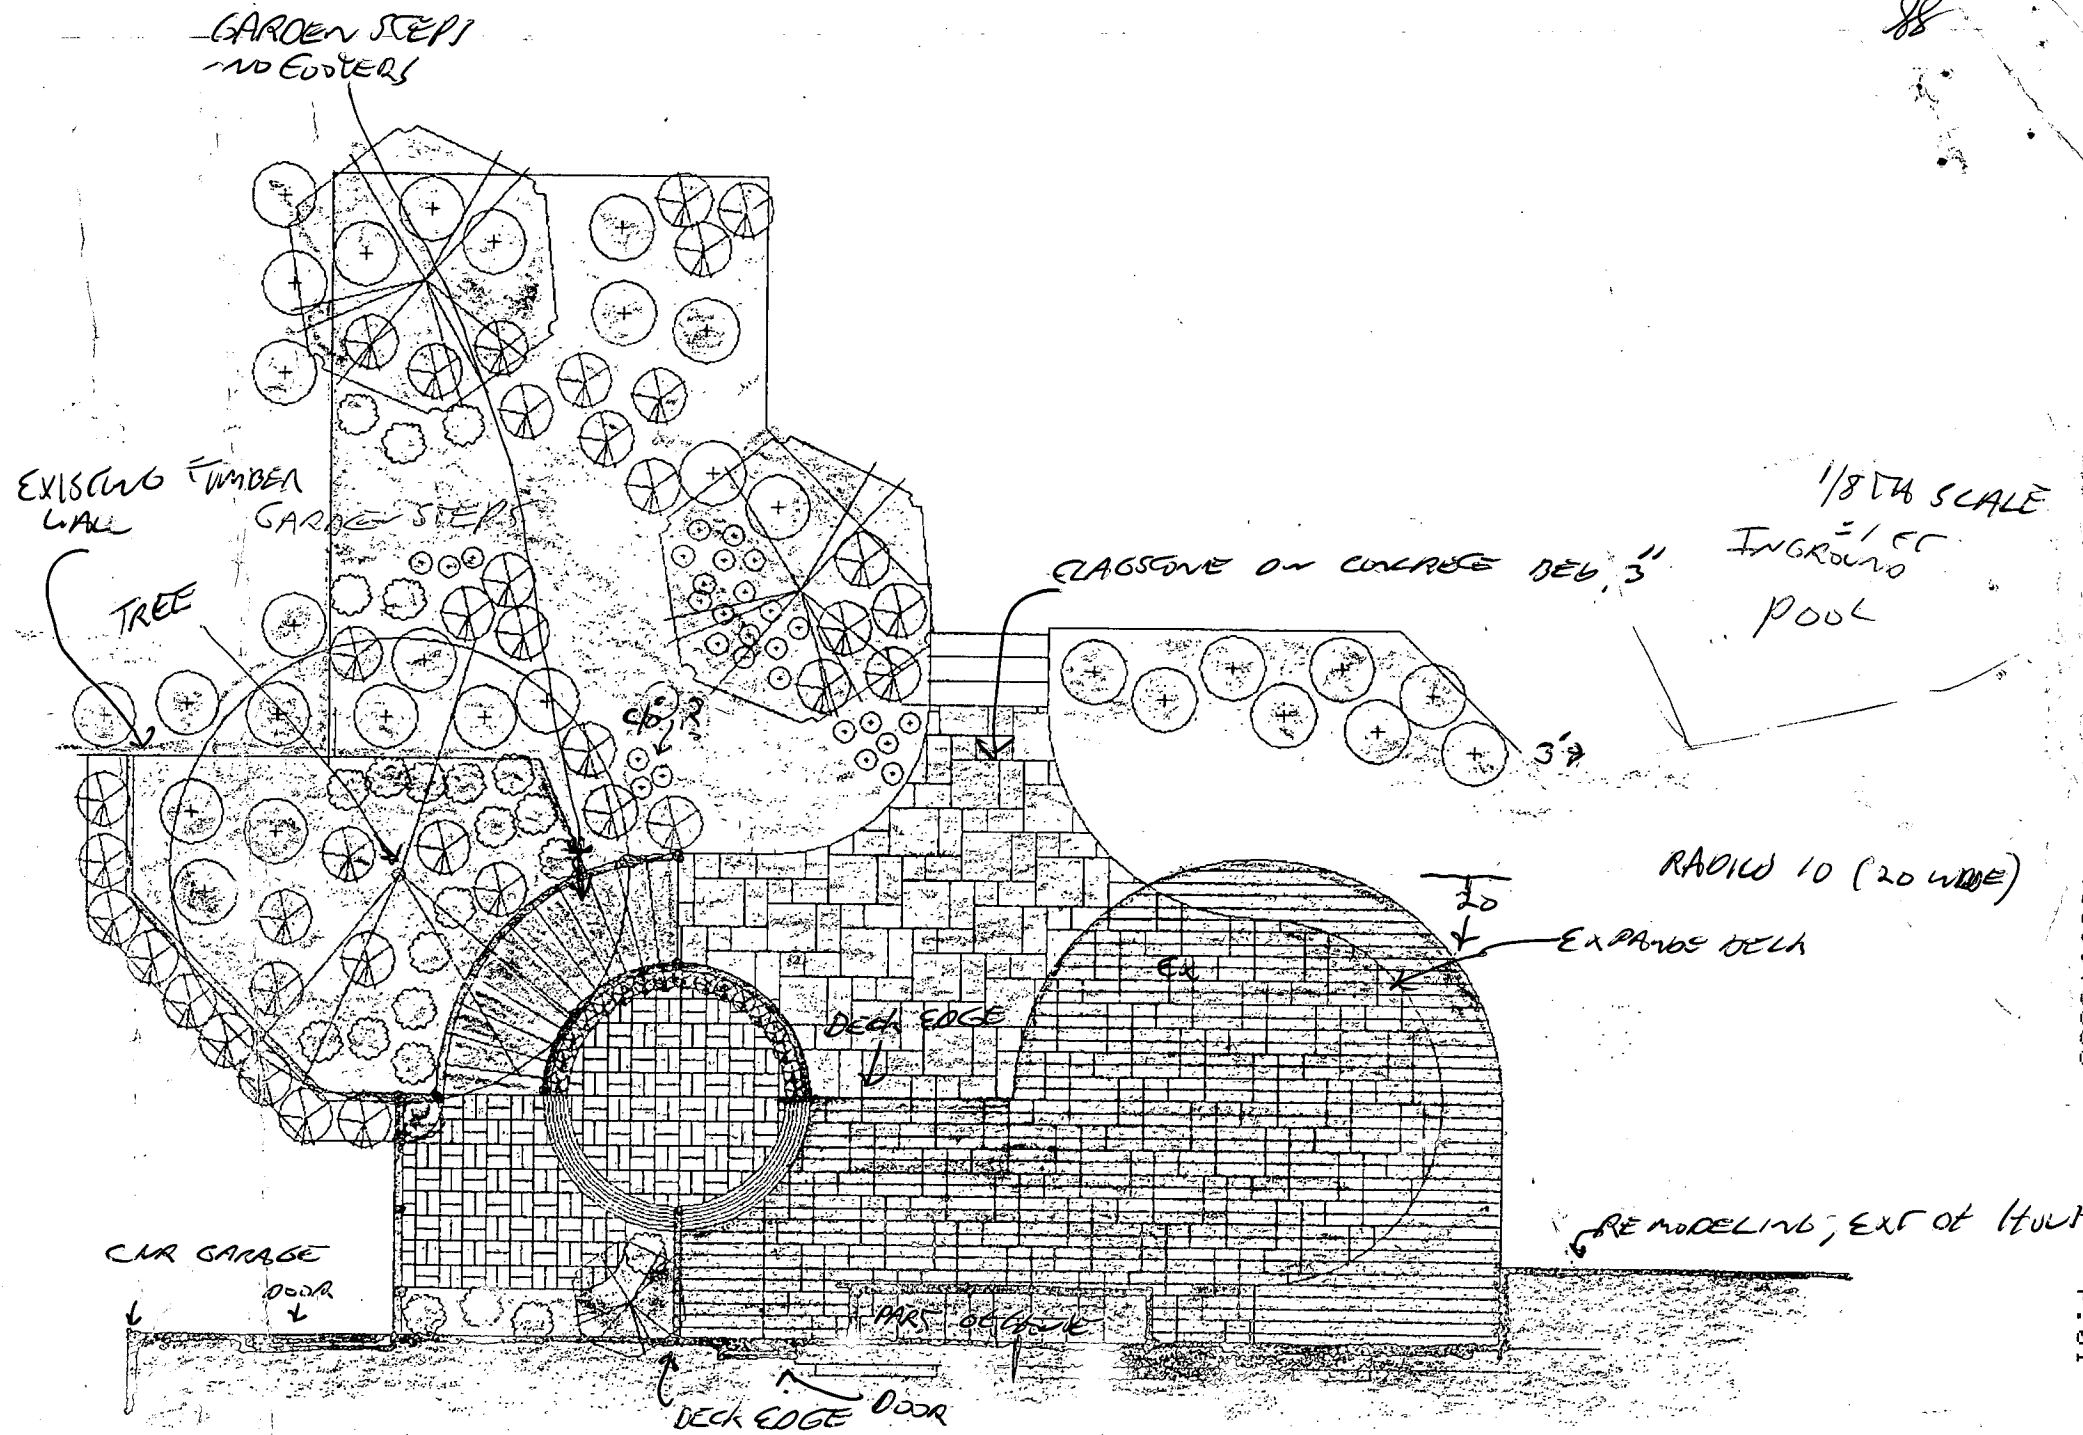

4109970656


P.01

8/18/95

GARAGE


BLACKTOP

HOUSE

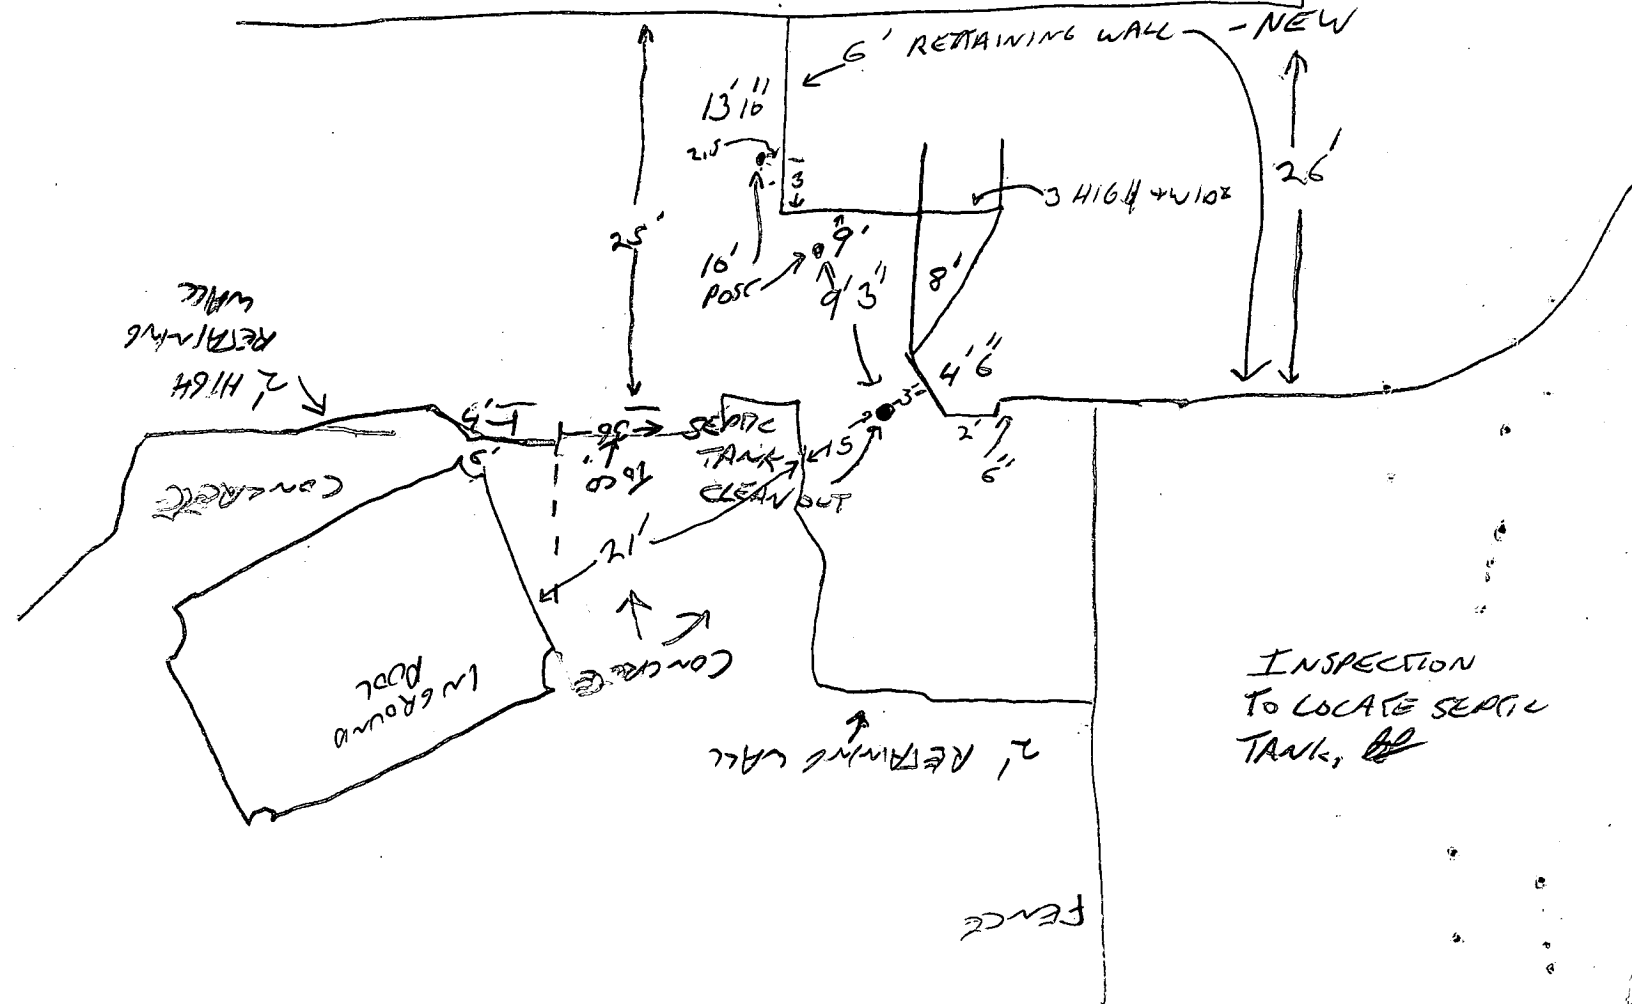

INSPECTION
TO LOCATE SEPTIC
TANK, *BB*

EDUCATION DRAWING

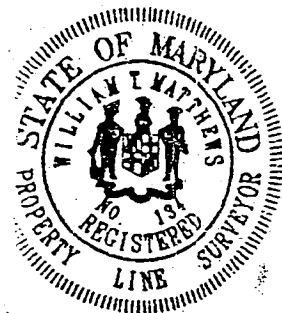

of benefit to a consumer only is required by a lender or a company or its agent in connection with the transfer, financing or re-financing of property to be relied upon for the establishment of fences, garages, buildings, or other improvements. The plat is for the accurate identification of any lines, but such identification is required for the transfer of title or financing. The approximate dwelling is shown in relation to the lot lines for the property known as 30 Woodstock Road, Howard County, Maryland


Matthews 5/19/95

Design Corporation
22 Bellona Lane
Annapolis, Maryland 21204
(410) 823-5000

0115

Scale 1" = 120'

95-279

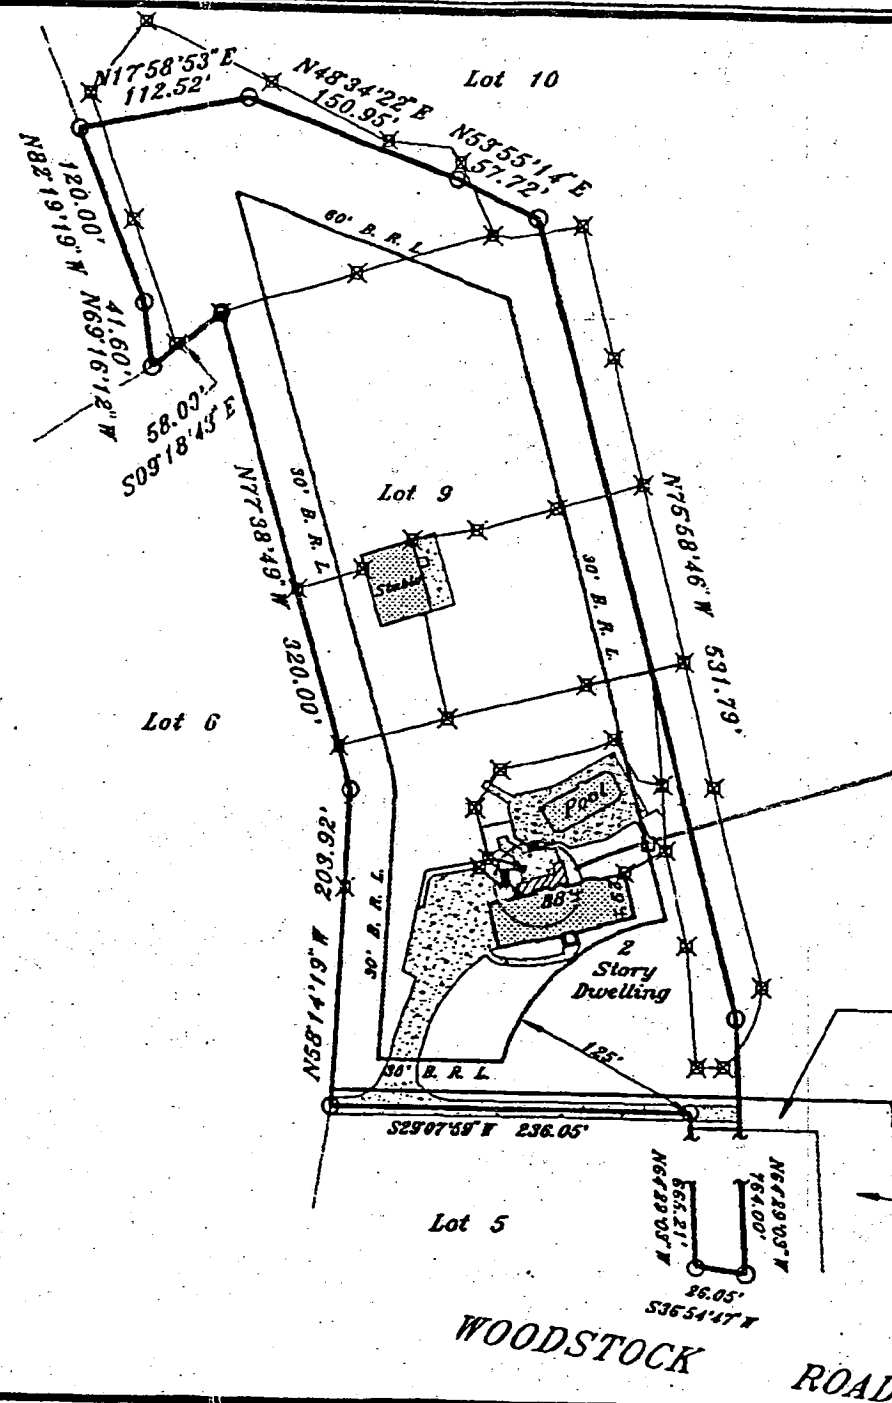

Lot Number : 9
Block/Section : -
Plat Reference : 10063
Title of Plat : Amended Plat of Reuwer's Breezeuood Farms, Lots 9 and 10

Property lies in Flood Zone C
(F.E.M.A. Map Panel Number 240044 0010 B, Dated 12/04/86)