

SEPTIC SYSTEM TO BE INSTALLED PRIOR TO ISSUANCE OF BUILDING PERMIT.

PERMIT

SEWAGE DISPOSAL SYSTEM

MARYLAND STATE DEPARTMENT OF HEALTH

DISTRICT 5th

HOWARD COUNTY

BUREAU OF ENVIRONMENTAL HEALTH

461-9933

05-407524

DATE

10/3/89

DATE SYSTEM APPROVED

4/10/90

INSPECTOR

J.C. Bd.
(Houses connection only)

INDEXED
INDEXED

Alan Whitworth

IS PERMITTED TO INSTALL ☒ ALTER

ADDRESS 12680 Clarksville Pike, Clarksville, Maryland

PHONE 854-2513

SUBDIVISION Waterford

ROAD 12902 Wexford Park

LOT 23, Section 2

PROPERTY OWNER Westchester Homes of Maryland

ADDRESS

IF GARBAGE GRINDER IS USED INCREASE SEPTIC TANK CAPACITY BY 50% AND ABSORPTION AREA BY 22%.

GARBAGE GRINDER? YES ☒ NO

SEPTIC TANK CAPACITY 2000 GALLONS NUMBER OF BEDROOMS 4

TRENCHES - INSTALL 3-100 FT TRENCHES
250 sq. ft. per bedroom with garbage disposal. Trench to be 3 feet wide.

Inlet 1.5 feet below original grade. Bottom maximum depth 3.0 feet below original grade. Effective area begins at 1.5 feet below original grade.

1.5 feet of stone below distribution pipe.

LOCATION - Start the first trench 365 feet from the front lot line and 30 feet from the right lot line as seen when facing the lot from Wexford Park. Run trenches on contour toward the left rear of lot. NOTE: MAINTAIN 100 FEET FROM WELL.

NOTIFY HEALTH DEPARTMENT BEFORE INSTALLING TRENCHES AND REQUEST FIELD INSPECTION WITH CONTRACTOR.

NOTE - No trench to exceed 100 feet in length. Provide 6" - 8" diameter cleanout and cap to grade or above on septic tank. OKICW

PLANS APPROVED BY Sid Abel

DATE 3/31/89

COVER NO WORK UNTIL INSPECTED AND APPROVED

NEITHER THE HOWARD COUNTY COUNCIL NOR THE HEALTH DEPARTMENT IS RESPONSIBLE FOR THE SUCCESSFUL OPERATION OF ANY SYSTEM

NOTE: CLEANOUT REQUIRED EVERY 70 FEET OF SEWER LINE AND/OR AT 90° SWEEPS IN LINES FROM HOUSE TO DRAIN FIELDS

NOTE: ALL PARTS OF SEPTIC SYSTEMS (I.E. TANK, DISTRIBUTION BOX, TRENCHES) TO BE 100 FEET FROM WELL (UNLESS OTHERWISE SPECIFICALLY AUTHORIZED)

NOTE: IF DEEP TRENCHES ARE USED CALL FOR INSPECTION BEFORE AND AFTER PLACING GRAVEL IN TRENCHES

BUDG. PERMIT SIGNED
AND RETURNED 3/7/90

NOTE: NO DRY WELL SHALL EXCEED 15 FOOT IN DIAMETER NO ABSORPTION TRENCH TO EXCEED 100 FEET IN LENGTH

NOTE: ALL PIPE FROM HOUSE TO SEPTIC TANK MUST BE CAST IRON OR SCHEDULE 40 PVC OR ABS

PERMIT VOID AFTER TWO YEARS

NOTE: INSTALL STAND PIPE ON SEPTIC TANK AND DRY WELL. STAND PIPES MUST BE 6 INCHES IN DIAMETER. CAST IRON, CONCRETE OR TERRA COTTA OR PVC OR ABS ACCEPTED. IF TOP OF SEPTIC TANK IS DEEPER THAN 3 FEET, MANHOLE TO GRADE REQUIRED

NOTE: DISTRIBUTION BOXES MUST HAVE BAFFLES

BUDG. PERMIT SIGNED
AND RETURNED 9/28/89

Serial # 26838

*INSTALLER IS RESPONSIBLE FOR OBTAINING FINAL APPROVAL ON THIS PERMIT

*CALL 461-9933 FOR INSPECTION OF SEPTIC SYSTEMS.

SFD-4 Bedrooms

APPLICATION

PERCOLATION TESTING

A 34967

P _____

HOWARD COUNTY HEALTH DEPARTMENT
BUREAU OF ENVIRONMENTAL HEALTH
P.O. BOX 476 ELLICOTT CITY, MARYLAND 21043
TELEPHONE: 461-9933

DISTRICT _____

DATE _____

Mound Testing

TO: THE COUNTY HEALTH OFFICER
ELLICOTT CITY, MARYLAND

I, HEREBY, APPLY FOR THE NECESSARY TEST IN ORDER TO CONSTRUCT (OR RECONSTRUCT) A SEWAGE DISPOSAL SYSTEM.

PROPERTY OWNER SARGENT Westchester Homes of Md.

ADDRESS _____ PHONE _____

PROSPECTIVE BUYER _____

ADDRESS _____ PHONE _____

PROPERTY LOCATION:

SUBDIVISION WATERFORD SEC. 2 LOT NO. 23 Sec. 2
~~14 of 247 lots~~

ROAD AND DESCRIPTION Brighton Dam Rd. 12902 WEXFORD PARK

TAX MAP _____ PARCEL # _____

SIZE OF LOT _____ TYPE BLDG _____
(SINGLE FAMILY DWELLING OR COMMERCIAL)

THE SYSTEM INSTALLED UNDER THIS APPLICATION IS ACCEPTABLE ONLY UNTIL PUBLIC FACILITIES BECOME AVAILABLE. I FULLY UNDERSTAND THE FEE CONNECTED WITH THE FILING OF THIS PERC TEST APPLICATION IS NON-REFUNDABLE UNDER ANY CIRCUMSTANCES. I ALSO AGREE TO COMPLY WITH ALL M.O.S.H.A. REQUIREMENTS IN TESTING THIS LOT.

(SIGNATURE OF APPLICANT)

APPROVED BY Sid Mbej FOR Standard lunch DATE 6-8-84

REJECTED BY _____ FOR _____ DATE _____

HOLD PENDING FURTHER TESTS _____ DATE _____


REASONS FOR REJECTION OR HOLDING 4-22-88 HOLD FOR CONFIRMED APPRAVAL - BEST SYST LOW
PRESSURE DOSE IN SHALLOW BED BETWEEN 12-36" SAND

THIS IS NOT A PERMIT

① ② ③
SOIL PROFILE

0"
1"
6"
(5" #2)
(5" #3)
13"
(16" #2)
(23" #3)
60"±

SURFACE
LITTER (OM)
STRONG BR
LOAM w/
SMALL FRAGS
QUARTZ
YELLOW BR
SILTY CLAY
LOAM
VERGATED
SAND LAYER
YELLOW/WHITE
GRITTY
10% FRAGS
QUARTZ
BROWN w/
PINKISH
YELLOW
VEINS OF
SANDY
LOAM
SILT LOAM
SMALL FRAGS
OF QUARTZ

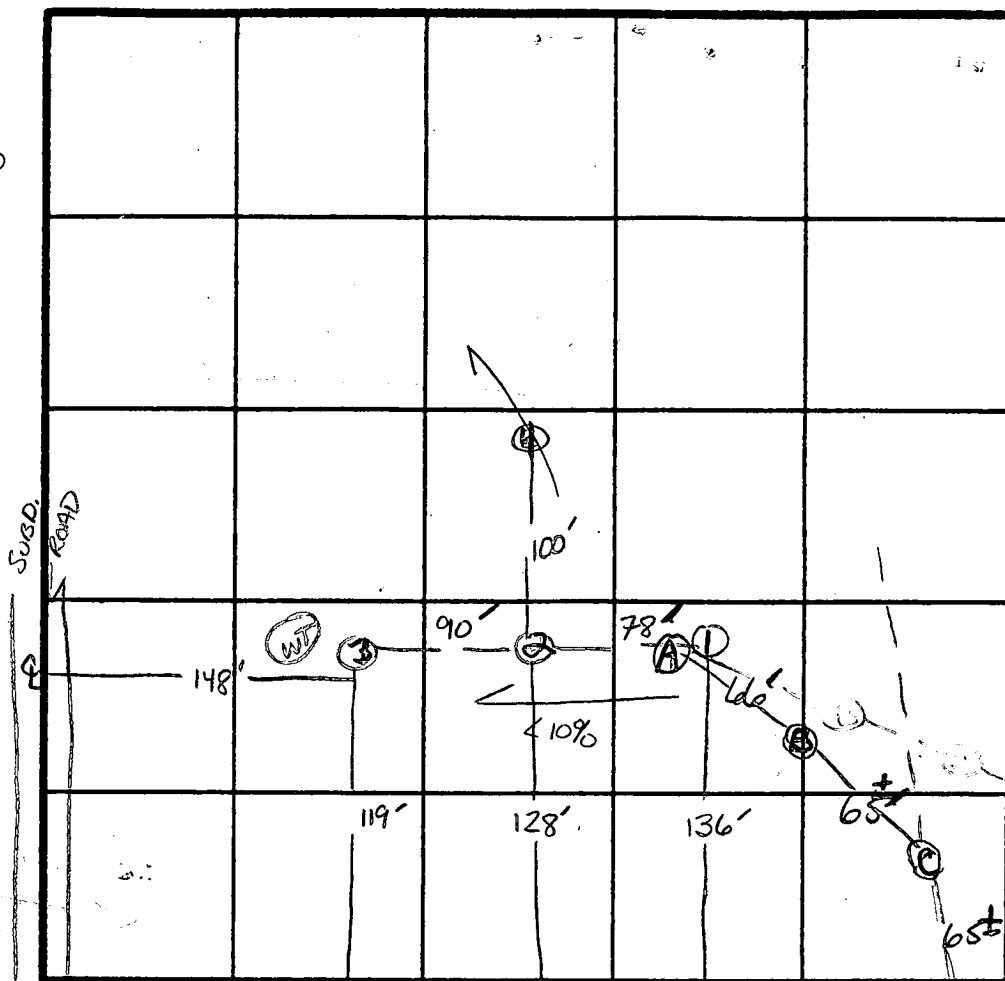

X PERC
10min
210 φ/BR
INV. 12"
BOTTOM 30"

INDICATE NORTH - NAME ADJOINING ROADWAY AS BASE LINE.

Brighton Dam Rd.

APPROX CORR. MARK

DATE	TEST NO.	DEPTH	PRE-WET		TEST - 1" DROP		TIME
			START	STOP	START	STOP	
11/6/87	1 INFILTROMETER	12"	10:22	10:40	10:40	11:14	34 MIN
	1 STANDARD	27"	10:25	10:26:25	10:26:25	10:28:10	1min 45 SEC.
	2 INFILTROMETER	15"	11:20	12:02	12:02	11:00	58 MIN
	2 STANDARD	29"	11:23	11:24	11:24	11:25	1min
	3 INFILTROMETER	13"	1:08	1:50	STOP → < 1/2" movement		
	WT	DRY TO	11' 3"	KNOWN WATER TABLE		AT 7' 6"	
	4	17"	1:58	2:37	2:37	3:45	< 1" movement
4/22/88	A I	6"	10:09	10:51	→ 42min 1"		
	A S	18"	10:18	10:19	10:19	10:22	3min
	B I	3"	10:54	11:30	→ 36min 1"		
	B S	29"	10:21	10:23	10:23	10:33	10min
	C I	SURFACE	10:43	10:46	10:46	10:53	7min
	C S	36"	10:43	10:46	10:46	10:53	7min

WATER
8' 5"

REMARKS

TYPE OF SOIL Chester Silt Loam

TESTED BY S. Abel

ALSO PRESENT John SARA

APPLICATION

PERCOLATION TESTING

A _____

P _____

HOWARD COUNTY HEALTH DEPARTMENT
BUREAU OF ENVIRONMENTAL HEALTH
P.O. BOX 476 ELLICOTT CITY, MARYLAND 21043
TELEPHONE: 461-9933

DISTRICT _____

DATE _____

TO: THE COUNTY HEALTH OFFICER
ELLICOTT CITY, MARYLAND

I, HEREBY, APPLY FOR THE NECESSARY TEST IN ORDER TO CONSTRUCT (OR RECONSTRUCT) A SEWAGE DISPOSAL SYSTEM.

PROPERTY OWNER _____

ADDRESS _____ PHONE _____

PROSPECTIVE BUYER _____

ADDRESS _____ PHONE _____

PROPERTY LOCATION:

SUBDIVISION WATERFORD SEC. 2 LOT NO. NEW LOT #5
OLD LOT 7+8 ORIGINAL TEST

ROAD AND DESCRIPTION _____

TAX MAP _____ PARCEL # _____

SIZE OF LOT _____ TYPE BLDG _____
(SINGLE FAMILY DWELLING OR COMMERCIAL)

THE SYSTEM INSTALLED UNDER THIS APPLICATION IS ACCEPTABLE ONLY UNTIL PUBLIC FACILITIES BECOME AVAILABLE. I FULLY UNDERSTAND THE
FEE CONNECTED WITH THE FILING OF THIS PERC TEST APPLICATION IS NON-REFUNDABLE UNDER ANY CIRCUMSTANCES. I ALSO AGREE TO COMPLY
WITH ALL M.O.S.H.A. REQUIREMENTS IN TESTING THIS LOT. _____

(SIGNATURE OF APPLICANT)

APPROVED BY _____ FOR _____ DATE _____

REJECTED BY _____ FOR _____ DATE _____



HOLD PENDING FURTHER TESTS _____ DATE _____

REASONS FOR REJECTION OR HOLDING _____

HD-216

THIS IS NOT A PERMIT

SOIL PROFILE

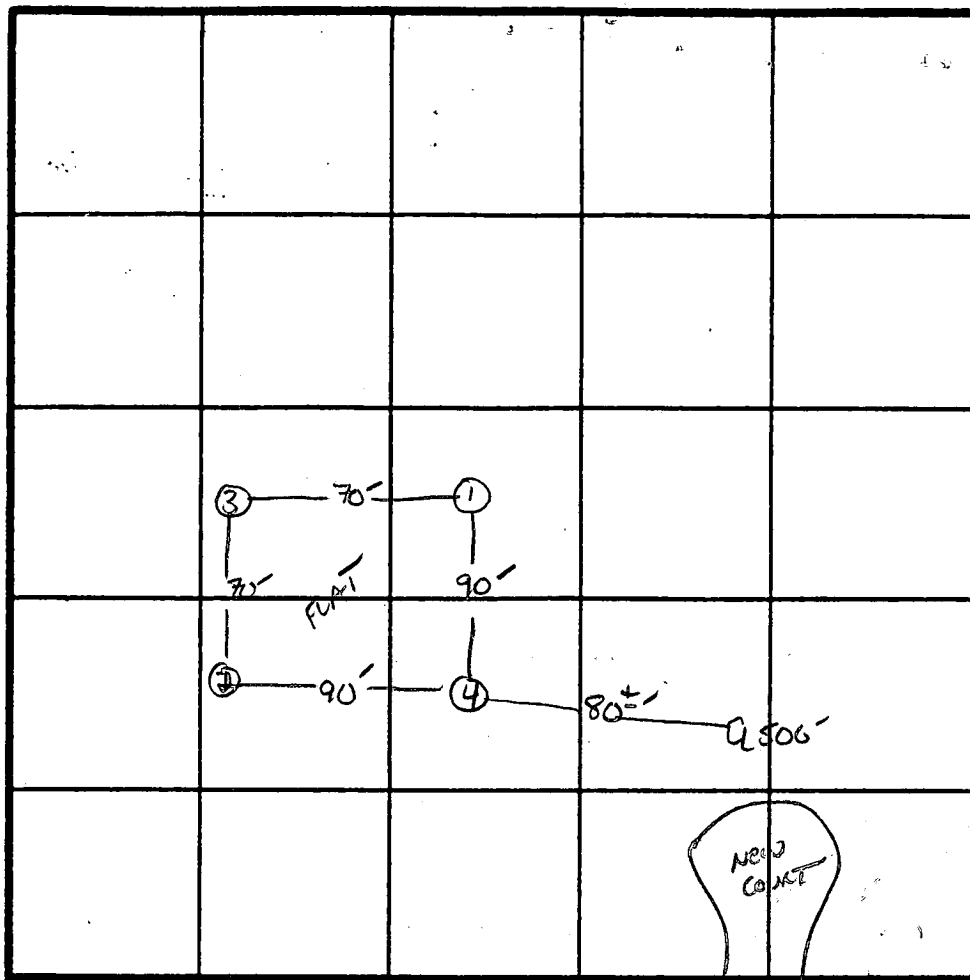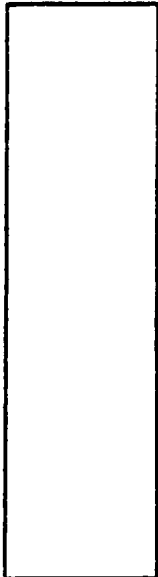

INDICATE NORTH - NAME ADJOINING ROADWAY AS BASE LINE.

Brighton Dam Rd.

DATE	TEST NO.	DEPTH	PRE-WET		TEST - 1" DROP		TIME
			START	STOP	START	STOP	
11/6/87	1	26" STANDARD PORE IN COMPRESSING LAYER	2:52	3:23	1/4" movement		
	2	MOTTIONS AT 33"		HEAVY CLAY TO 33"			
	3	MOTTIONS AT 42"		HEAVY CLAY TO 42"			
	4	MOTTIONS AT 26"		CLAY TO 26"			
H ₂ O 8'5" LOW 4/22/88	A I	6"	10:09				
	A S	18"	10:18	10:19	10:19	10:22	3 min
	B I		10:21	10:23	10:23	10:33	10 min
	B S						

REMARKS _____

TYPE OF SOIL Chester / Glenville

TESTED BY S Abel ALSO PRESENT John S. ...

APPLICATION

SEWAGE DISPOSAL TESTING

STATE OF MARYLAND - DEPARTMENT OF HEALTH AND MENTAL HYGIENE

HOWARD COUNTY HEALTH DEPARTMENT
ENVIRONMENTAL HEALTH SERVICES

P. O. BOX 476 ELLICOTT CITY, MARYLAND 21043
TELEPHONE: 992-2330

A 34967

P _____

DISTRICT 5th ELECTION

DATE 2-14-85

TO: THE COUNTY HEALTH OFFICER
ELLICOTT CITY, MARYLAND

I, HEREBY, APPLY FOR THE NECESSARY TEST IN ORDER TO CONSTRUCT (OR RECONSTRUCT) A SEWAGE DISPOSAL SYSTEM.

PROPERTY OWNER HUNTINGTON INTERNATIONAL CORPORATION

ADDRESS 4951 ROCKWOOD PARKWAY, N.W. WASH, D.C. 20016 PHONE (202) 659-2474

PROPERTY LOCATION: Waterford Sec 2

SUBDIVISION HUNTINGTON ESTATES LOT NO. 20 LOT 12

ROAD AND DESCRIPTION ON BRIGHTON DAM ROAD, 1800' WEST OF TEN OAKS ROAD
INTERSECTION

SIZE OF LOT 3.12 AC. ± TYPE BLDG. SINGLE FAMILY DWELLING
(NUMBER OF BEDROOMS)

THE SYSTEM INSTALLED UNDER THIS APPLICATION IS ACCEPTABLE ONLY UNTIL PUBLIC FACILITIES BECOME AVAILABLE. I FULLY UNDERSTAND THE
FEE CONNECTED WITH THE FILING OF THIS PERC TEST APPLICATION IS NON-REFUNDABLE UNDER ANY CIRCUMSTANCES. I ALSO AGREE TO COMPLY
WITH ALL M.O.S.H.A. REQUIREMENTS IN TESTING THIS LOT.

Charles J. Cross

(SIGNATURE OF APPLICANT)

APPROVED BY _____ FOR _____ DATE _____

REJECTED BY _____ FOR _____ DATE _____

HOLD PENDING FURTHER TESTS _____ DATE _____

REASONS FOR REJECTION OR HOLDING 3-28-85 Perc. SATISFACTORY, HOLD FOR CERTIFIED HOLE
LOCATION, HOUSE AND WELL SIZE. SAVED

THIS IS NOT A PERMIT

①
SOIL PROFILE


0
6"
5'
12.5'

A1-3
BROWN CLAY
LOAM <10%
SAPROLITE
WHITE/BROWN
MICACEOUS
SAND LOAM
20-30%
SAPROLITE

CL = center
line

0
6"
3'
12.5'

A1-3
BROWN CLAY
LOAM <10%
SAPROLITE
WHITE/BROWN
MICACEOUS
SILTY SAND
10-30%
SAPROLITE

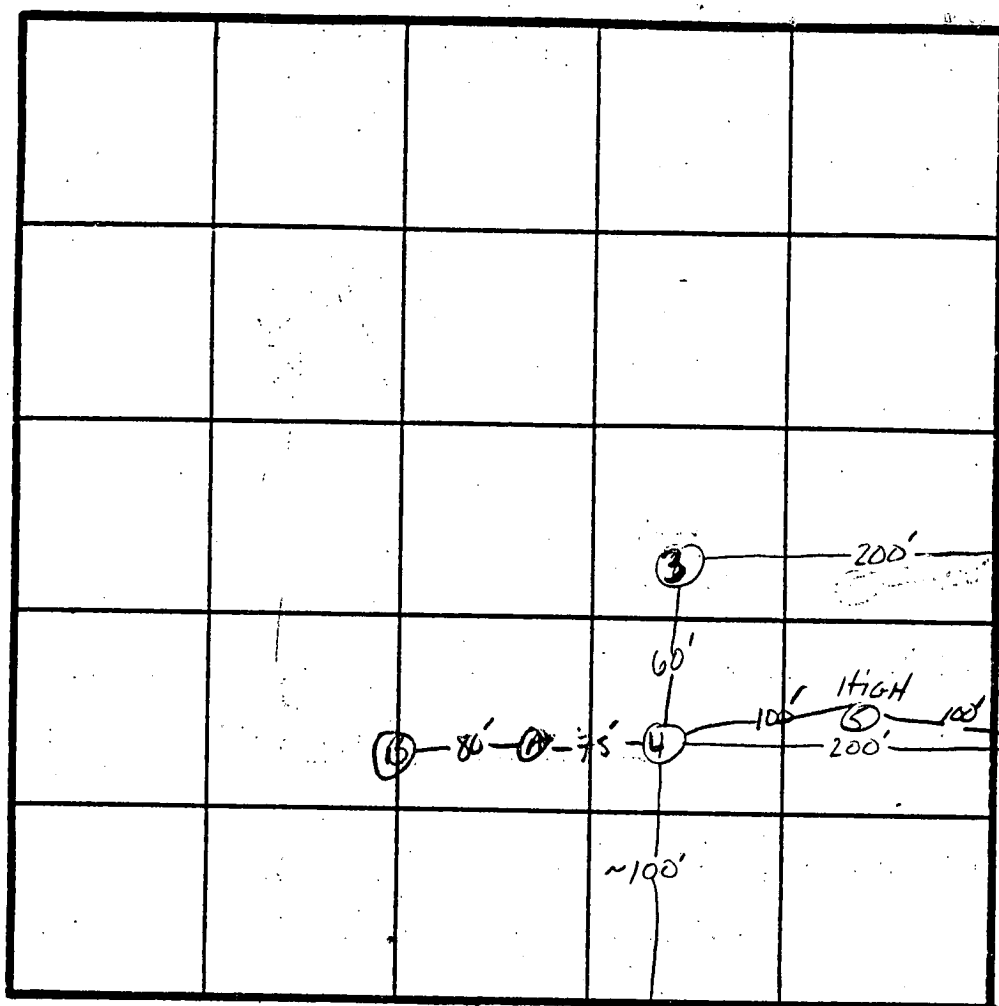

INDICATE NORTH - NAME ADJOINING ROADWAY AS BASE LINE.
BRIGHTON DAM Rd.

DATE	TEST NO.	DEPTH	PRE-WET		TEST - 1" DROP		TIME
			START	STOP	START	STOP	
3/28/85	1S	50'	1:18	1:25	1:25	1:40	15min
	1V	12.5'	UNIFORM SOIL STRUCTURE Below				4.5'
	2S	4'	12:59	1:03	1:03	1:12	9min
	2V	12.5'	UNIFORM SOIL STRUCTURE Below				4'
	3S	11.5'	1:40	1:41	1:41	1:43	2min
	3V	13'	UNIFORM SOIL STRUCTURE Below				1-2'
	4S	4'	1:43	1:44	1:44	1:46	2min
	4V	12.5'	UNIFORM SOIL STRUCTURE Below				3'
	SV		BROWN SANDSILTY 20-30% SAPROLITE				ROCK AT 11'
			UNIFORM SOIL STRUCTURE Below				3'
	A	ROCK AT 7.5'					
	B	WATER AT 7.5'					

REMARKS

TYPE OF SOIL

TESTED BY

S. Abel

SKIP, TERRY, LES

ALSO PRESENT

HOWARD COUNTY HEALTH DEPARTMENT

JOYCE M. BOYD, M.D., M.P.H.
COUNTY HEALTH OFFICER



Bureau of Environmental Health
3525 Ellicott Mills Drive
Ellicott City, Maryland 21043

Director - 461-9956
Water & Sewerage, Permits - 461-9933
Community Environmental Health - 461-9944
Technical Services - 461-9955

May 31, 1988

Mr. Lowrie Sargent
Brighton Group
5570 Sterrett Place, Suite 306
Columbia, Maryland 21045

RE: Waterford, Section 2
Resubdivision of Lot 12

Dear Mr. Sargent:

During the past year several percolation tests were performed on the above referenced property. The testing done was to determine if the site and soil conditions were suitable for mounds under current state regulations. The results of that testing show the soils to be unsatisfactory at shallow depths necessary to approve the lot for a mound system.

At the same time, the soils were reviewed to determine if a low pressure dose system (LPDS) would be acceptable for the site. After review of the state regulations, we were unable to find any provision which would allow for a system of this type on newly created lots.

The testing which was done established satisfactory soils at approximately 12 inches below natural grade with a high water table known to be 8 feet at the lowest hole reviewed. Under current standard trench installation we are able to install a conventional system within these soils providing the following items are addressed:

- (1) Test holes known as 1, 2, A, B, C on the enclosed test sheet are field located.
- (2) A suitable well site not less than 100 feet from and higher in elevation than the sewage disposal area can be established.
- (3) A house site 20 feet from the sewage disposal area and able to reach the highest part of the sewage disposal area on gravity from the first floor can be established.

Mr. Lowrie Sargent

- 2 -

May 31, 1988

- (4) Due to the nature of the system planned for this lot a 15,000 sq. ft. sewage disposal area is required.

If these concerns can be resolved then this office is prepared to approve this lot for conventional on-site sewage disposal system.

Should you have any questions or need any guidance on this project, please feel free to contact me at the above address or by calling 461-9933.

Very truly yours,



Sid Abel, Sanitarian
Water and Sewerage Program

SA:hs

SOIL DESCRIPTION

NAME Sargent COUNTY Howard FILE NO. _____
 SOIL MAP UNIT Chesare Cam MAP SYMBOL Ch DATE 11-22-88
 GEOLOGIC MATERIAL HARD SCHIST Elevation _____ GRID No. _____

No. Male #A WATERFORD SEC. 2 LOT (UNKNOWN) now LOT 12
 DESCRIBED BY Sid Abel

Horizon	Depth in.	Color		Texture	Structure		% Coarse Fragments	Notes (Moisture, Density, Consistence, Structures, Seepage)
		Matrix	Mottles		Grade	Type		
D	Surface							LITTER - LEAVES & weed decomposed ORGANIC MATERIAL
A	0-4"	Yellowish Brown		Silt loam	Fine	granular	15-25%	BOUNDARY - SMOOTH MANY ROOTS STICKY + MOIST
B ₁	4-8"	Strong Brown		Silt loam	Coarse	Blocky SUBANG.	< 10%	BOUNDARY - SMOOTH MANY ROOTS STICKY + MOIST
B ₂	8"-20"	Yellow Brown		S.H. clay loam	Coarse	Block SUBANG	SMALL 25-30%	BOUNDARY - Irregular - VARIES PLASTIC & STICKY some RED DR. CLAY FILMS TO yellow RED
C	20"+	Yellow Bk to GR		Loam (very)	Fine	SAPSURE highly micaceous	20-25%	A weed STRUCTURE CLAY/soil moist highly micaceous

LANDSCAPE FEATURES
 Upland/Marine ☒ Summit _____ ED — MWD — PD —
 Bench _____ Shoulder ☒ WD ☒ SPD — VPD —
 Terrace _____ Sideslope _____ WATER TABLE _____
 Floodplain _____ Footslope _____ Type Humus
 Depression _____ Toeslope _____ Depth 8' S¹¹ (including CAP. RANGE)
 Slope % 5-8 Shape Width VARIABLE Misc. _____
 LIMITING HORIZON Depth
 B-Horizon ☒
 Fragipan _____
 C-Strud Saprolite _____
 Cr-Strud Saprolite ☒
 C-Horizon _____
 R-Bedrock _____
 Other _____
 -OVER-

BEST System - low Pressure Dose

Highly wooded - Removing Trees + Shrubs with roots/trunks
would damage field making mound undesirable.

4/10/90
① A.M. ✓
Not ready
② P.M. ✓

HOWARD COUNTY HEALTH DEPARTMENT
Bureau of Environmental Health
3525-H Ellicott Mills Drive
Ellicott City, MD 21043
461-9933

4/10/90
Final
C.B.D.

APPLICATION FOR PITLESS ADAPTER WELL PUMP AND PRESSURE TANK INSTALLATION
LINE

New Installation ☒
Replacement

Receipt # 45619
Date 03/27/90

Name of Installer Crouse P & H

Telephone 531-3311

License Number 4450

Certified Well Pump Installer

Well Driller

Registered Plumber ☒

Name of Property Owner Westchester Homes

Telephone

Subdivision Waterford

Lot # 23

Well Tag # 40-88-1019

Site Address 12902 Wexford Park

Pump

1. Type

- a. Deep well jet
b. Shallow well jet
c. Submersible ☒

2. Make Grundfos

3. Model #

4. Capacity _____ GPM

5. Pump exceeds well capacity Yes _____ No ☒

6. If Yes, is low pressure cutoff switch installed? Yes ☒ No

7. What methods are used to protect the pump and electrical wiring from vibrations? Torque arrestors _____ Cable guards _____ Other ☒

Motor

1. Horsepower

2. RPM

3. Voltage

a. 110

b. 220 ☒

Pitless Adapter

1. Make

2. Model #

3. Depth

Tank

1. Capacity 100 gal.

2. Pressure relief valve? _____

Piping

1. Type Plastic

2. Size 1"

3. NSF and/or BOCA

Code approved _____

4. Depth of supply

line 42'

Well data

1. Depth _____ ft.

2. Yield _____ GPM

3. Static water level _____ ft.

4. Will water supply be disinfected by installer? _____

I understand that it is my responsibility to notify the Howard County Health Department when the installation is ready for inspection (otherwise this permit is null and void).

All information given above is true to the best of my knowledge.

Signature of Applicant: Robert H. Hestler

Date: 2/27/90

Note: A sticker indicating approval/status of the installation will be placed on the well casing at the time of the inspection.

WELL ABANDONMENT REPORT

REVIEW OIL

TAG D65T-0467 9/12/89

Curren

Date

8/1/89

Permit Number of abandoned well (if any)

40-88-0520

Driller's Name

Easterday George
Last First

Owner's Name

Coventry Construction
Last First

Well Location:

County Howard

Subdivision Waterford

Section Lot 23

Nearest Town Clarksville

Address Weyford Park

Maryland Grid Location

Box Number

E 810
N 490

X	
0/5	5/5
0/0	5/0

Show well location by (x)
within box

Type of Well

- ☒ Drilled
☐ Jetted
☐ Bored or Augered
☐ Other, Specify

Depth of Well 420 Ft.

Type of Casing

- ☒ Steel
☐ Plastic
☐ Concrete
☐ Other, Specify

Size of Casing 6" In.

Was any case removed ☐ yes ☒ no

If yes amount removed Ft.

Was casing ripped or perforated ☐ yes ☒ no

Log of Sealing Material

Materials	Feet	
	From	To
GRAVEL	420'	330'
Bentonite (Hole Plug)	330'	326'
Bentonite (Ben Seal)	326'	0

Driller

George F. Easterday
Signature

License #

MD 46

1 2 3 6 0270 (THIS NUMBER IS TO BE PUNCHED IN COLS. 3-6 ON ALL CARDS)		SEQUENCE NO. (DENY USE ONLY)		STATE OF MARYLAND WELL COMPLETION REPORT FILL IN THIS FORM COMPLETELY PLEASE PRINT OR TYPE		THIS REPORT MUST BE SUBMITTED WITHIN 45 DAYS AFTER WELL IS COMPLETED.	
ST/CO USE ONLY DATE Received		DATE WELL COMPLETED		Depth of Well		PERMIT NO. FROM "PERMIT TO DRILL WELL"	
8 13		15 20		22 26 (TO NEAREST FOOT)		28 29 30 31 32 33 34 35 36 37	
OWNER <u>COUNTRY CONSTRUCTION</u>		last name <u>WILFORD PARK</u>		first name		TOWN <u>CLARKSVILLE</u>	
STREET OR RFD		SUBDIVISION <u>WATER REED</u>		SECTION		LOT <u>23</u>	
WELL LOG Not required for driven wells STATE THE KIND OF FORMATIONS PENETRATED, THEIR COLOR, DEPTH, THICKNESS AND IF WATER BEARING		GROUTING RECORD WELL HAS BEEN GROUTED (Circle Appropriate Box) TYPE OF GROUTING MATERIAL CEMENT <u>CM</u> BENTONITE CLAY <u>BC</u> NO. OF BAGS <u>20</u> NO. OF POUNDS <u>2000</u> GALLONS OF WATER <u>20</u> DEPTH OF GROUT SEAL (to nearest foot) from <u>0</u> ft. to <u>15</u> ft. (enter 0 if from surface)		C 3 1 2 PUMPING TEST HOURS PUMPED (nearest hour) <u>3</u> PUMPING RATE (gal. per min. to nearest gal.) <u>10</u> METHOD USED TO MEASURE PUMPING RATE <u>Bucket</u> WATER LEVEL (distance from land surface) BEFORE PUMPING <u>25</u> WHEN PUMPING <u>113</u> TYPE OF PUMP USED (for test) <u>A</u> air <u>P</u> piston <u>T</u> turbine <u>C</u> centrifugal <u>R</u> rotary <u>O</u> other (describe below) <u>J</u> jet <u>S</u> submersible			
DESCRIPTION (Use additional sheets if needed)		FEET FROM TO		Check if water bearing		C 3 1 2 PUMPING TEST HOURS PUMPED (nearest hour) <u>3</u> PUMPING RATE (gal. per min. to nearest gal.) <u>10</u> METHOD USED TO MEASURE PUMPING RATE <u>Bucket</u> WATER LEVEL (distance from land surface) BEFORE PUMPING <u>25</u> WHEN PUMPING <u>113</u> TYPE OF PUMP USED (for test) <u>A</u> air <u>P</u> piston <u>T</u> turbine <u>C</u> centrifugal <u>R</u> rotary <u>O</u> other (describe below) <u>J</u> jet <u>S</u> submersible	
Top Soil 0 1 Red clay 1 4 Br. mica 4 65 Gray mica 65 135 Gravelly Br. 135 140							
Casing types insert appropriate code below		CASING RECORD STEEL <u>ST</u> CONCRETE <u>CO</u> PLASTIC <u>PL</u> OTHER <u>OT</u> MAIN CASING TYPE <u>ST</u> Nominal diameter top (main) casing (nearest inch) <u>6</u> Total depth of main casing (nearest foot) <u>71</u>		OTHER CASING (if used) diameter inch from to		PUMP INSTALLED DRILLER WILL INSTALL PUMP YES <u>NO</u> (CIRCLE) (YES or NO) IF DRILLER INSTALLS PUMP, THIS SECTION MUST BE COMPLETED FOR ALL WELLS EXCEPT HOME USE TYPE OF PUMP INSTALLED PLACE (A,C,J,P,R,S,T,O) IN BOX - SEE ABOVE: CAPACITY: GALLONS PER MINUTE (to nearest gallon) <u>31</u> PUMP HORSE POWER <u>37</u> PUMP COLUMN LENGTH (nearest ft.) <u>43</u> CASING HEIGHT (circle appropriate box and enter casing height) <u>+</u> above } LAND SURFACE (nearest foot) <u>2</u> <u>-</u> below }	
screen type or open hole insert appropriate code below		SCREEN RECORD STEEL <u>ST</u> BRASS <u>BR</u> OPEN HOLE <u>HO</u> PLASTIC <u>PL</u> OTHER <u>OT</u> DEPTH (nearest ft.) <u>H</u> <u>71</u> <u>146</u>		C 2 1 2 EACH CASING 1 <u>H</u> <u>71</u> <u>146</u> 2 <u>23</u> <u>24</u> <u>26</u> <u>30</u> <u>32</u> <u>36</u> 3 <u>38</u> <u>39</u> <u>41</u> <u>45</u> <u>47</u> <u>51</u>		LOCATION OF WELL ON LOT SHOW PERMANENT STRUCTURE SUCH AS BUILDING, SEPTIC TANKS, AND/OR LANDMARKS AND INDICATE NOT LESS THAN TWO DISTANCES (MEASUREMENTS TO WELL)	
CIRCLE APPROPRIATE LETTER A A WELL WAS ABANDONED AND SEALED WHEN THIS WELL WAS COMPLETED E ELECTRIC LOG OBTAINED P TEST WELL CONVERTED TO PRODUCTION WELL		SLOT SIZE 1 2 3 DIAMETER OF SCREEN (NEAREST INCH) <u>56</u> from to		GRAVEL PACK IF WELL DRILLED WAS FLOWING WELL INSERT F IN BOX 68			
THEREBY CERTIFY THAT THIS WELL HAS BEEN CONSTRUCTED IN ACCORDANCE WITH COMAR 26.04.04 "WELL CONSTRUCTION" AND IN CONFORMANCE WITH ALL CONDITIONS STATED IN THE ABOVE CAPTIONED PERMIT, AND THAT THE INFORMATION PRESENTED HEREIN IS ACCURATE AND COMPLETE TO THE BEST OF MY KNOWLEDGE.		DRILLERS IDENT. NO. <u>411</u>		OEP USE ONLY (NOT TO BE FILLED IN BY DRILLER) T (E.R.O.S.) <u>74</u> <u>75</u> <u>76</u> 70 72 74 75 76 TELESCOPE CASING LOG INDICATOR OTHER DATA			
DRILLERS SIGNATURE (MUST MATCH SIGNATURE ON APPLICATION) <u>Blane Lee Simon</u>		SITE SUPERVISOR (sign of driller or journeyman responsible for sitework if different from permittee)					

HD-224



B 1 4734		SEQUENCE NO. (DP USE ONLY)		STATE OF MARYLAND PERMIT TO DRILL WELL please print or type		STATE PERMIT NUMBER 40-88-1019 fill in this form completely	
1 2 3 4 5 6 (THIS NUMBER IS TO BE PUNCHED IN COLS. 3-6 ON ALL CARDS)							
Date Received (APA) 082889				OWNER INFORMATION			
8 13				15 Last Name 00 VENTRY			
				Owner CONSTRUCT, INC.			
				First Name 9891			
				Street or RFD BROKENLAND PKWY			
				57 Town COLUMBIA			
				70 State 72 MD 21046			
				Zip 76			
DRILLER INFORMATION							
George F. Easterday				40			
Driller's Name				77 License No. 80			
L. Franklin Easterday, Inc.							
Firm Name							
9265 Brown Church Rd., N. Airy, Md. 21771							
Address							
Signature: George F. Easterday				Date 8/23/89			
B 2				WELL INFORMATION			
1 2				APPROX. PUMPING RATE (GAL. PER MIN.)			
				5			
				8 12			
				AVERAGE DAILY QUANTITY NEEDED			
				500			
				14 20			
				USE FOR WATER (CIRCLE APPROPRIATE BOX)			
				☒ HOME (SINGLE OR DOUBLE HOUSEHOLD UNIT ONLY)			
				☐ FARMING (LIVESTOCK WATERING & AGRICULTURAL IRRIGATION)			
				☐ INDUSTRIAL, COMMERCIAL, STATE AND FEDERAL GOV. OTHER (REQUIRES APPROPRIATION PERMIT)			
				☐ PUBLIC OR PRIVATE WATER COMPANY (REQUIRES APPROPRIATION PERMIT AND STATE HEALTH DEPARTMENT APPROVAL)			
				☐ TEST, OBSERVATION, MONITORING (MAY REQUIRE APPROPRIATION PERMIT)			
APPROXIMATE DEPTH OF WELL				220 FEET			
				24 28			
APPROXIMATE DIAMETER OF WELL				6 INCH			
				NEAREST			
				METHOD OF DRILLING (circle one)			
				BORED (or Augered)			
				JETTED			
				Jettied & DRIVEN			
				30 AIR-ROTARY			
				AIR-PERCussion			
				37 CABLE			
				ROTARY (Hydraulic Rotary)			
				REVerse-ROTary			
				Drive-POINT			
				other			
REPLACEMENT OR DEEPEMED WELLS							
				(CIRCLE APPROPRIATE BOX)			
				☒ THIS WELL WILL NOT REPLACE AN EXISTING WELL			
				☐ THIS WELL WILL REPLACE A WELL THAT WILL BE ABANDONED AND SEALED			
				39 ☐ THIS WELL WILL REPLACE A WELL THAT WILL BE USED AS A STANDBY			
				☐ THIS WELL WILL DEEPMEN AN EXISTING WELL			
				PERMIT NUMBER OF WELL TO BE REPLACED OR DEEPEMED (IF AVAILABLE)			
				41 52			
Not to be filled in by driller (OEP USE ONLY)							
APPROP. PERMIT NUMBER				54 GAP 63			
FORCE				WRITE INITIALS IN BOX			
MD				PERMIT NO. 40-88-1019			
				67 68 70 71 72 73 74 75 76 77 78 79			
SPECIAL CONDITIONS							
				B 3			
				LOCATION OF WELL			
				1 2			
				HOWARD			
				8 COUNTY			
				21			
				WATERFORD			
				23 SUBDIVISION			
				42			
				SECTION			
				44 46			
				LOT			
				23			
				48 50			
				CLARKSVILLE			
				52 NEAREST TOWN			
				71			
				MILES FROM TOWN (enter 0 if in town)			
				1 MI			
				73 76 77 78			
B 4							
1 2				DIRECTION OF WELL FROM TOWN (CIRCLE BOX)			
				N			
				NW			
				8-9			
				NE			
				8-9			
				E			
				8			
				W			
				8-9			
				SW			
				8-9			
				S			
				8			
				SE			
				8-9			
				TOWN			
				NORTH			
				W			
				32			
				E			
				30			
				NEAR WHAT ROAD			
				WEXFORD PARK			
				ON WHICH SIDE OF ROAD (CIRCLE APPROPRIATE BOX)			
				NORTH			
				WEST			
				S			
				EAST			
				SOUTH			
				34			
				35			
				37			
				DISTANCE FROM ROAD			
				ENTER FT or MI			
				FT			
				38 39			
				NOT TO BE FILLED IN BY DRILLER HEALTH DEPARTMENT APPROVAL			
				Howard			
				COUNTY NAME			
				A34967			
				COUNTY NO.			
				STATE SIGNATURE			
				DATE ISSUED			
				090189			
				43			
				48			
				CO SIGNATURE			
				Mark E. Perkins			
				3/1/90			
				41			
				NORTH GRID			
				498000			
				50			
				55			
				EAST GRID			
				0810000			
				57			
				63			
				SHOW MAJOR FEATURES OF BOX & LOCATE WELL WITH AN X			
				SOURCES OF DRILLING WATER			
				1. well			
				2.			
				3.			
				WRITE THE BOX NUMBER FROM THE MAP HERE			
				E			
				810			
				N			
				498			
				DRAW A SKETCH BELOW SHOWING LOCATION OF WELL IN RELATION TO NEARBY TOWNS AND ROADS AND GIVE DISTANCE FROM WELL TO NEAREST ROAD JUNCTION			
				N			
				BRIGHTON DAM			
				CLARKSVILLE			
				WEXFORD			

Well Permit No. HO - 88-1019
Location of property (road) Wexford Park
Subdivision Waterford Lot 23 Block Plat Sec. 2
Well Driller G. Eastday Owner The Coventry Group

Depth of well 140'
Distance of measuring point (M.P.) above ground 1'
Static water level (S.W.L.) below M.P. 25'

Time pump started 3:00 Pumping rate 10 GPM
Total time _____ to reach pumping water level _____ ft. below M.P.

[illegible]

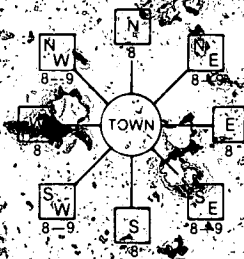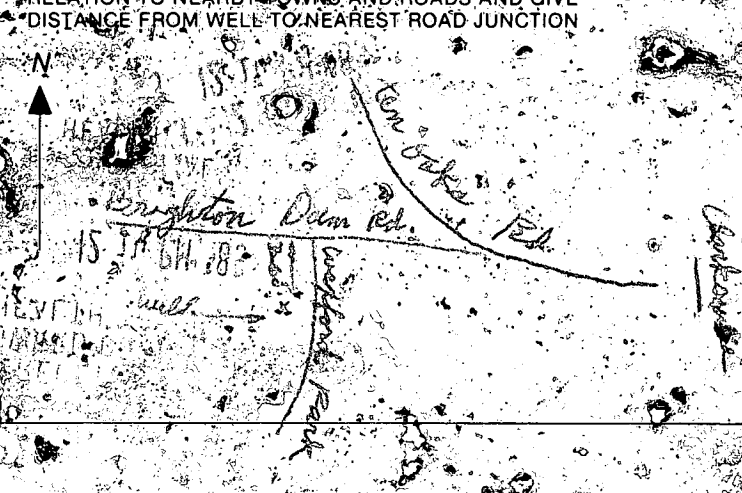B 1 2283 (THIS NUMBER IS TO BE PUNCHED IN COLUMNS 3-6 ON ALL CARDS)	SEQUENCE NO. (DP USE ONLY)	STATE OF MARYLAND PERMIT TO DRILL WELL please print or type	STATE PERMIT NUMBER 46-88-0520
Date Received (APA) 08/23/89 OWNER INFORMATION 15 Last Name: CLEMENTE First Name: CRISTINA Street or RFD: SUITE # 100 Town: State: Zip:		B 3 LOCATION OF WELL COUNTY: SUBDIVISION: SECTION: LOT: 23 NEAREST TOWN: MILES FROM TOWN (enter 0 if in town): 1.3 MI.	
B 2 DRILLER INFORMATION Driller's Name: R. Wayne Firm Name: 512 Ridge Rd. Mt. Airy, Md. 21771 Address: 3/2/89 Signature: Date:		B 4 DIRECTION OF WELL FROM TOWN (CIRCLE BOX)  NEAR WHAT ROAD ON WHICH SIDE OF ROAD (CIRCLE APPROPRIATE BOX) NORTH [] WEST [] EAST [] SOUTH [] DISTANCE FROM ROAD: 3.54 FT ENTER FT or MI: FT	
WELL INFORMATION APPROX. PUMPING RATE (GAL. PER MIN.): 5 AVERAGE DAILY QUANTITY NEEDED (GAL. PER DAY): 500		NOT TO BE FILLED IN BY DRILLER HEALTH DEPARTMENT APPROVAL County Name: Howard County No: A 34963 State Signature: DATE ISSUED: 03/31/89 CO SIGNATURE: EXP. DATE: 09-30-89 NORTH GRID: 4980.00 EAST GRID: 0870.00	
USE FOR WATER (CIRCLE APPROPRIATE BOX) ☒ HOME (SINGLE OR DOUBLE HOUSEHOLD UNIT ONLY) ☐ FARMING (LIVESTOCK WATERING & AGRICULTURAL IRRIGATION) ☐ INDUSTRIAL, COMMERCIAL, STATE AND FEDERAL GOV. OTHER (REQUIRES APPROPRIATION PERMIT) ☐ PUBLIC OR PRIVATE WATER COMPANY (REQUIRES APPROPRIATION PERMIT AND STATE HEALTH DEPARTMENT APPROVAL) ☐ TEST, OBSERVATION, MONITORING (MAY REQUIRE APPROPRIATION PERMIT)		SHOW MAJOR FEATURES OF BOX & LOCATE WELL WITH AN X SOURCES OF DRILLING WATER 1. WELL 2. 3. WRITE THE BOX NUMBER FROM THE MAP HERE	
APPROXIMATE DEPTH OF WELL: 264 FEET APPROXIMATE DIAMETER OF WELL: 6 INCH METHOD OF DRILLING (circle one) BORED (Circled) JETTED Jetted & DRIVEN AIR ROTARY AIR PERCUSSION ROTARY (Hydraulic Rotary) CABLE REVERSE ROTARY Drive POINT Other:		DRAW SKETCH BELOW SHOWING LOCATION OF WELL IN RELATION TO NEARBY TOWNS AND ROADS AND GIVE DISTANCE FROM WELL TO NEAREST ROAD JUNCTION 	
REPLACEMENT OR DEEPEMED WELLS (CIRCLE APPROPRIATE BOX) ☒ THIS WELL WILL NOT REPLACE AN EXISTING WELL ☐ THIS WELL WILL REPLACE A WELL THAT WILL BE ABANDONED AND SEALED ☐ THIS WELL WILL REPLACE A WELL THAT WILL BE USED AS A STANDBY ☐ THIS WELL WILL DEEPEMED AN EXISTING WELL PERMIT NUMBER OF WELL TO BE REPLACED OR DEEPEMED (IF AVAILABLE):		Not to be filled in by driller (DP USE ONLY) APPROP. PERMIT NUMBER: G A P FORCE: SA WRITE INITIALS PERMIT NO: 46-88-0520 SPECIAL CONDITIONS: 290-7000	
COUNTY			

C12269

SEQUENCE NO.
(DENV USE ONLY)

STATE OF MARYLAND
WELL COMPLETION REPORT
FILL IN THIS FORM COMPLETELY
PLEASE PRINT OR TYPE

THIS REPORT MUST BE SUBMITTED WITHIN
45 DAYS AFTER WELL IS COMPLETED.

COUNTY
NUMBERA-34967

DATE Received

DATE WELL COMPLETED
050289

Depth of Well
420
(TO NEAREST FOOT)

PERMIT NO.
FROM "PERMIT TO DRILL WELL"
41-88-0520

OWNERThe Country Group

STREET OR RFDlast nameWEYFORD PARKfirst nameTOWNCHOWNSWINE

SUBDIVISIONWATERFORDSECTION2LOT23

WELL LOG		
Not required for driven wells		
STATE THE KIND OF FORMATIONS PENETRATED, THEIR COLOR, DEPTH, THICKNESS AND IF WATER BEARING		
DESCRIPTION (Use additional sheets if needed)	FEET	
	FROM	TO
TOP SOIL	0	2
BR. SHALE	2	50
THIN MICA	50	65
GRAY MICA	65	70
BR. MICA	70	71
GRAY MICA	71	80
BR. MICA	80	81
GRAY MICA	81	210
BR. MICA	210	211
GRAY MICA	211	320
OPENING	320	321
GRAY MICA	321	364
OPENING	364	365
GRAY MICA	465	470

GROUTING RECORD

WELL HAS BEEN GROUTED
(Circle Appropriate Box)
TYPE OF GROUTING MATERIAL
CEMENTCMBENTONITE CLAYBC
NO. OF BAGS17NO. OF POUNDS1700
GALLONS OF WATER85
DEPTH OF GROUT SEAL (to nearest foot)
from0ft. to11ft.
(enter 0 if from surface)

CASING RECORD

casing types insert appropriate code below
STEELCONCRETE
PLASTICOTHER
MAIN CASING TYPE
Nominal diameter top (main) casing (nearest inch)
Total depth of main casing (nearest foot)
ST113
OTHER CASING (if used)
diameter inchdepth (feet) from to

SCREEN RECORD

screen type or open hole insert appropriate code below
STEELBRASSOPEN HOLE
BRONZEHOLES
PLASTICOTHER
DEPTH (nearest ft.)
H011420
SLOT SIZE 123
DIAMETER OF SCREEN (NEAREST INCH)
fromto
GRAVEL PACK
IF WELL DRILLED WAS FLOWING WELL INSERT F IN BOX 68

C3

PUMPING TEST

HOURS PUMPED (nearest hour)3
PUMPING RATE (gal. per min. to nearest gal.)10
METHOD USED TO MEASURE PUMPING RATE
WATER LEVEL (distance from land surface)
BEFORE PUMPING29
WHEN PUMPING144
TYPE OF PUMP USED (for test)
AairPpistonTturbine
CcentrifugalRrotaryOother (describe below)
JjetSsubmersible

PUMP INSTALLED

DRILLER WILL INSTALL PUMP YESNO
(CIRCLE) (YES or NO)
IF DRILLER INSTALLS PUMP, THIS SECTION MUST BE COMPLETED FOR ALL WELLS EXCEPT HOME USE
TYPE OF PUMP INSTALLED
PLACE (A,C,J,P,R,S,T,O)
IN BOX - SEE ABOVE:
CAPACITY:
GALLONS PER MINUTE
(to nearest gallon)
PUMP HORSE POWER
PUMP COLUMN LENGTH (nearest ft.)
CASING HEIGHT (circle appropriate box and enter casing height)
abovebelow
LAND SURFACE (nearest foot)

CIRCLE APPROPRIATE LETTER
A A WELL WAS ABANDONED AND SEALED WHEN THIS WELL WAS COMPLETED
E ELECTRIC LOG OBTAINED
P TEST WELL CONVERTED TO PRODUCTION WELL
I HEREBY CERTIFY THAT THIS WELL HAS BEEN CONSTRUCTED IN ACCORDANCE WITH COMAR 10.17.13 "WELL CONSTRUCTION" AND IN CONFORMANCE WITH ALL CONDITIONS STATED IN THE ABOVE CAPTIONED PERMIT, AND THAT THE INFORMATION PRESENTED HEREIN IS ACCURATE AND COMPLETE TO THE BEST OF MY KNOWLEDGE.
DRILLERS IDENT. NO. 40
DRILLERS SIGNATURE
(MUST MATCH SIGNATURE ON APPLICATION)
SITE SUPERVISOR (sign. of driller or journeyman responsible for sitework if different from permittee)

TELESCOPE CASING
LOG INDICATOR
OTHER DATA

LOCATION OF WELL ON LOT
SHOW PERMANENT STRUCTURE SUCH AS BUILDING, SEPTIC TANKS, AND/OR LANDMARKS AND INDICATE NOT LESS THAN TWO DISTANCES (MEASUREMENTS TO WELL)

COUNTY

Review _____

HD-224

8-14-89

MIKE BODGER

The Coventry Group

9891 Brokenland Pkwy. Suite 100
Columbia, Md. 21046
Dear MR. Bodger

Waterford (Lot 23 Sec. 2)
Wexford Park

On a recent inspection of the above referenced property, prior ~~to~~ installing the septic system, it was discovered that the well (HO-88-0520) was drilled too close to the sewage disposal easement.


Connecting this problem involves abandoning this well because the sewage easement cannot be adjusted. The location of this well must be certified on a ~~survey~~ ^{survey} plot of the property so ~~an~~ encroachment by the septic system can be prevented.

The Abandonment must be done with bentonite clay to prevent any contamination of groundwater. The clay must be used from ^{the} source of water in the ~~the~~ well to the surface.

If you have any questions please contact me at 861-9933.

11 The Proper location of the new well UTY
must be 10 ft off Right Lot Line AND CW
10 ft off The Left Lot Line at the
rear of the property as seen from Wexford Park.

NOTE: HOUSE SHOWN IN REVERSE OF HOUSE DRAWINGS.

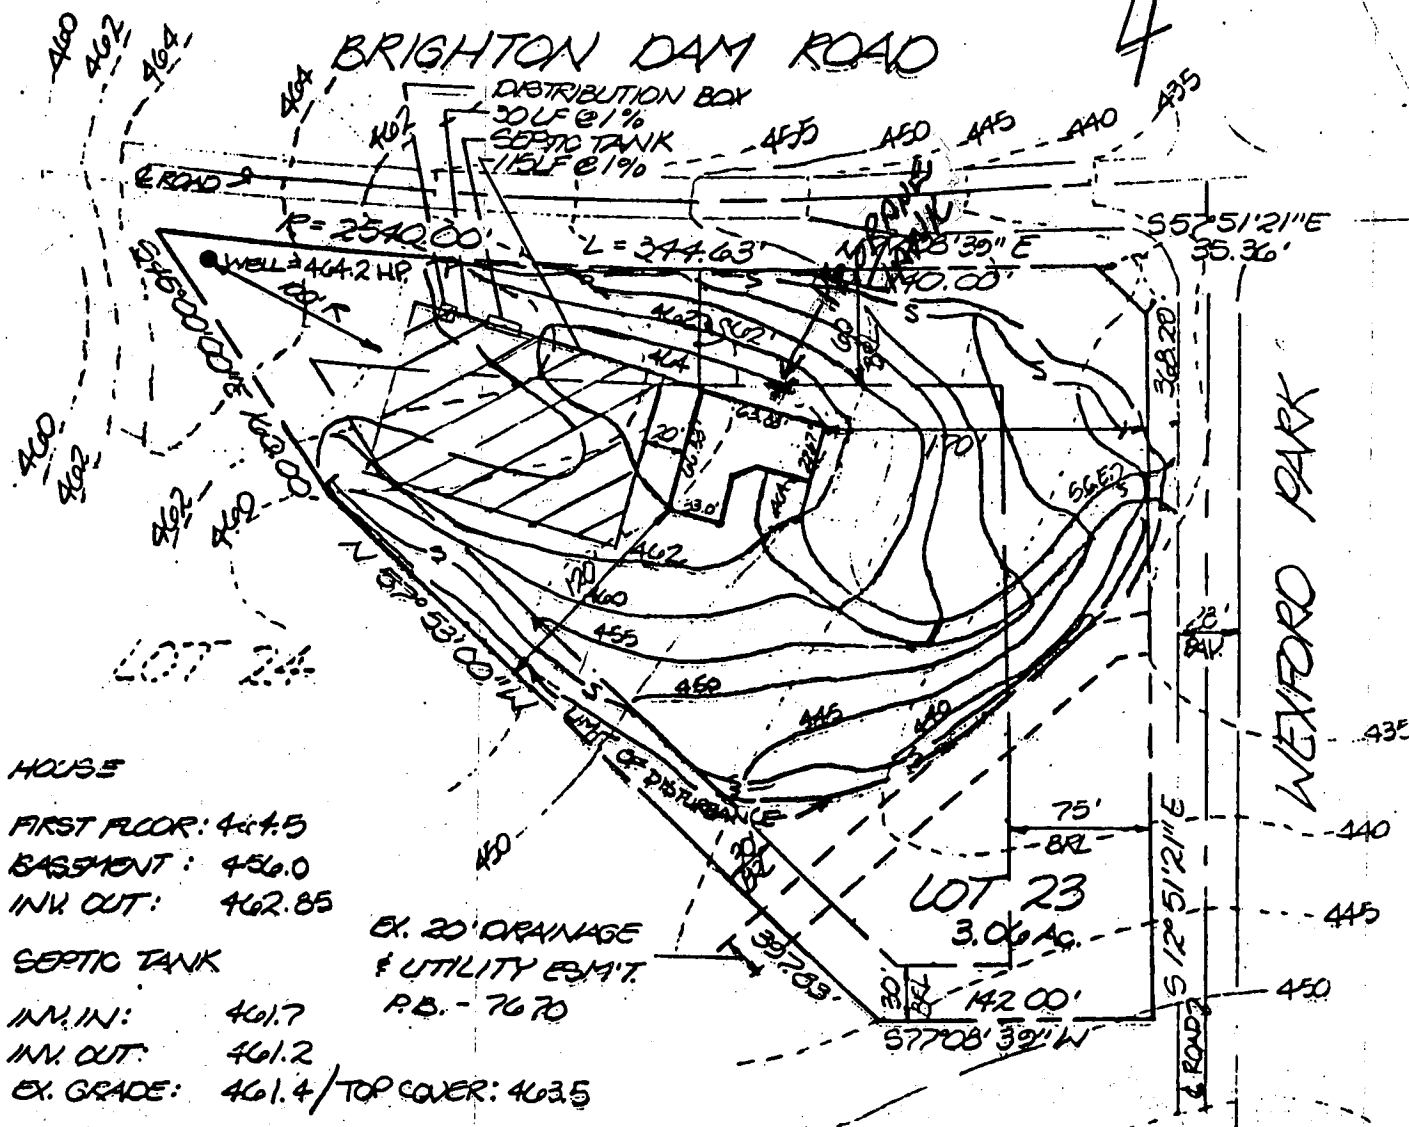

HOUSE

FIRST FLOOR: 444.5

BASMENT: 456.0

INW OUT: 462.85

SEPTIC TANK

INV. IN: 461.7

INV. OUT: 461.2

EX. GRADE: 461.4 / TOP COVER: 463.5

DISTRIBUTION BOX

INV. IN: 460.9

INV. OUT: 460.4

EX. GRADE: 462.4 / TOP COVER: 464.0

WELL

EX. GRADE: 464.2


EX. 20' DRAINAGE
& UTILITY E.M.T.
P.B. - 7670

NOTES:

1. TAX MAP: 34; PARCEL: 261
2. EXISTING ZONING: R
3. REFERENCE: WATERFORD, SECT. 2
LOTS 23 & 24.
4. TOPOGRAPHY SHOWN HEREON IS
BASED ON AERIAL PHOTOGRAMMETRIC
MAPS.
5. CONTRACTOR TO SET GRADES IN
FIELD.
6. TRENCHES TO BE SET IN FIELD BY HOWARD
COUNTY HEALTH DEPARTMENT.

NO IMPACT
ON WELL OR
SEPTIC.
OK TO PROCEED
3/6/96
C. Wells

NOTE: HOUSE SHOWN IN REVERSE OF HOUSE DRAWINGS.

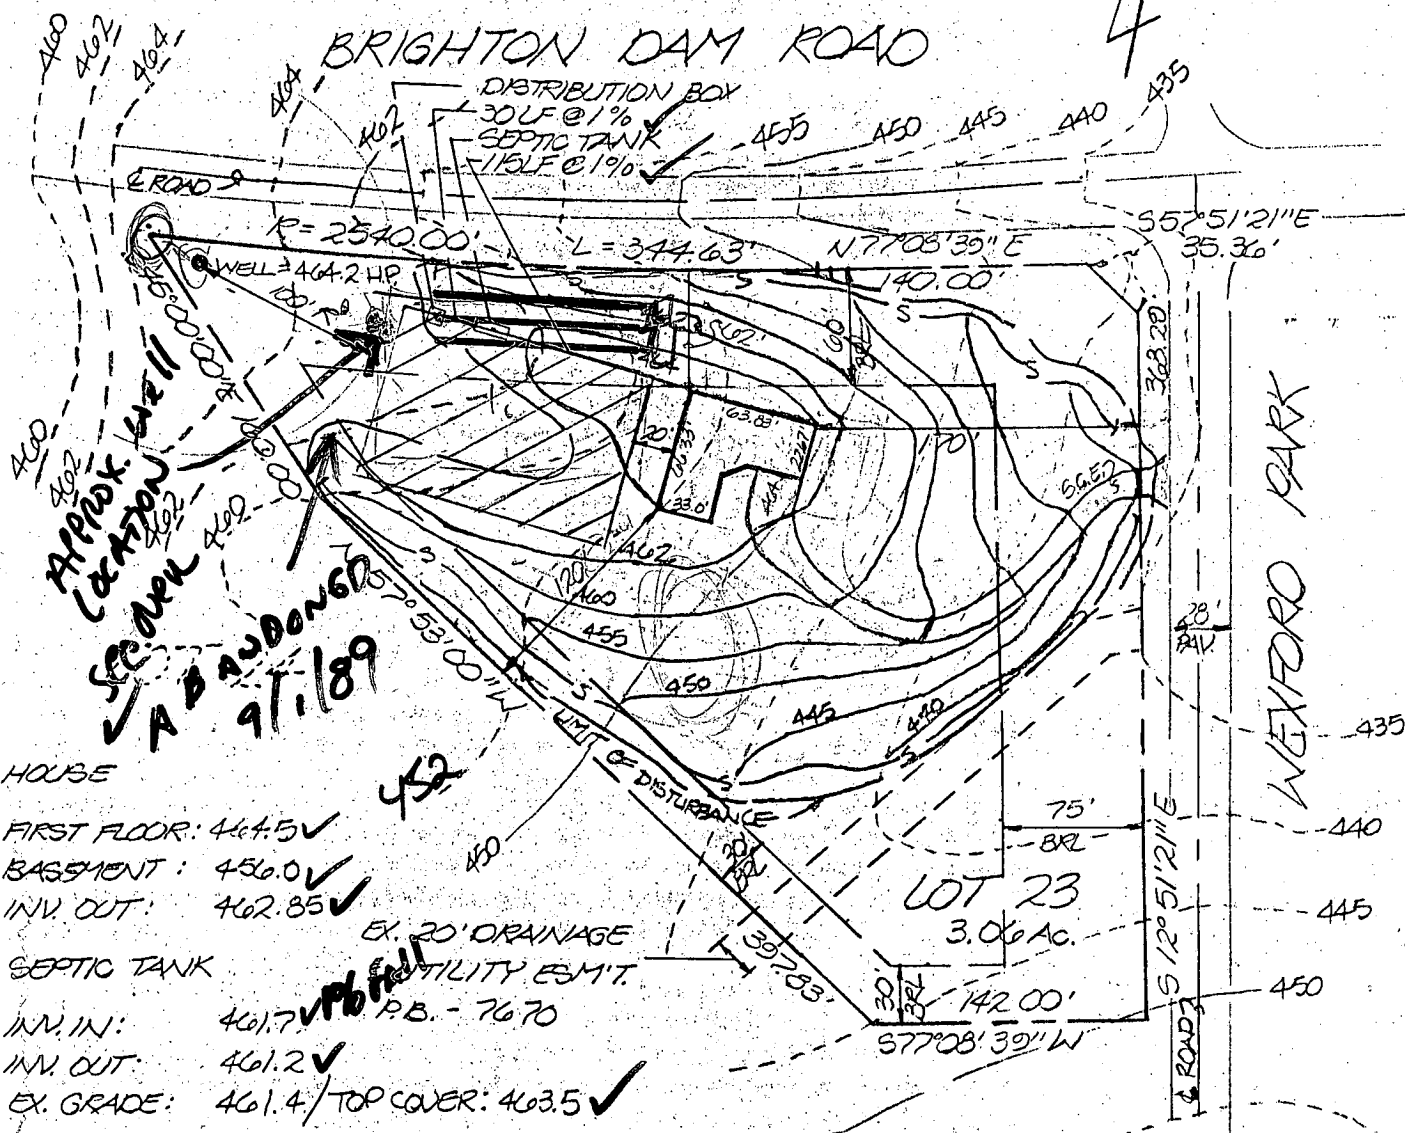

HOUSE

FIRST FLOOR: 464.5 ✓

BASMENT: 456.0 ✓

INV. OUT: 462.85 ✓

SEPTIC TANK

INV. IN: 461.7 ✓

INV. OUT: 461.2 ✓

EX. GRADE: 461.4 / TOP COVER: 463.5 ✓

DISTRIBUTION BOX

INV. IN: 460.9 ✓

INV. OUT: ~~460.4~~ ✓

EX. GRADE: 462.4 ✓

WELL

EX. GRADE: 464.2

NOTES:

1. TAX MAP: 34; PARCEL: 261
2. EXISTING ZONING: R
3. REFERENCE: WATERFORD, SECT. 2 LOTS 23 & 24.
4. TOPOGRAPHY SHOWN HEREON IS BASED ON AERIAL PHOTOGRAMMETRIC MAPS.
5. CONTRACTOR TO SET GRADES IN FIELD.
6. TRENCHES TO BE SET IN FIELD BY HOWARD COUNTY HEALTH DEPARTMENT.

7/11/89

BP elevation on. Due to closeness of elevations and house lower than start of trenches septic to be installed before BP

NOTE: FIRST FLOOR SERVICE ONLY.

TITLE: GRADING STUDY				
PROJECT: WATERFORD, SECT. 2, LOT 23				
LOCATION: 5 TH. ELECTION DISTRICT HOWARD CO., MD.				
SCALE: 1"=100'	DESIGNED BY: J.C.O.	DRAWN BY: J.C.O.	CHECKED BY: R.S.O.	DATE: APRIL, 1989
FIELD BOOK: —	PAGE NO.: —	JOB NO.: 8920	DRAWING NO.: 1 OF 1	

boender associates
inc.
consulting engineers
land surveyors
land planners

COURTHOUSE SQUARE
3565 ELLICOTT MILLS DRIVE
ELLICOTT CITY, MD. 21043
(301) 465-7777


8/14/89

During pre installation insp. of Septic System well was discovered drilled in wrong place. Lot corner lot 23/24 located and well was approx. 100 ft away (on top edge of pre area). Owner notified of problem. This well was drilled by Easterday accidentally. Permit in J. Mayne's name. Easterday had permit for lot 24.

Recommend new well drilled and existing well be sealed from top to bottom with Bentonite Clay since Septic System will need to be very close to abandoned well.

J. H. H.

NOTE: HOUSE SHOWN IN REVERSE OF HOUSE DRAWINGS.

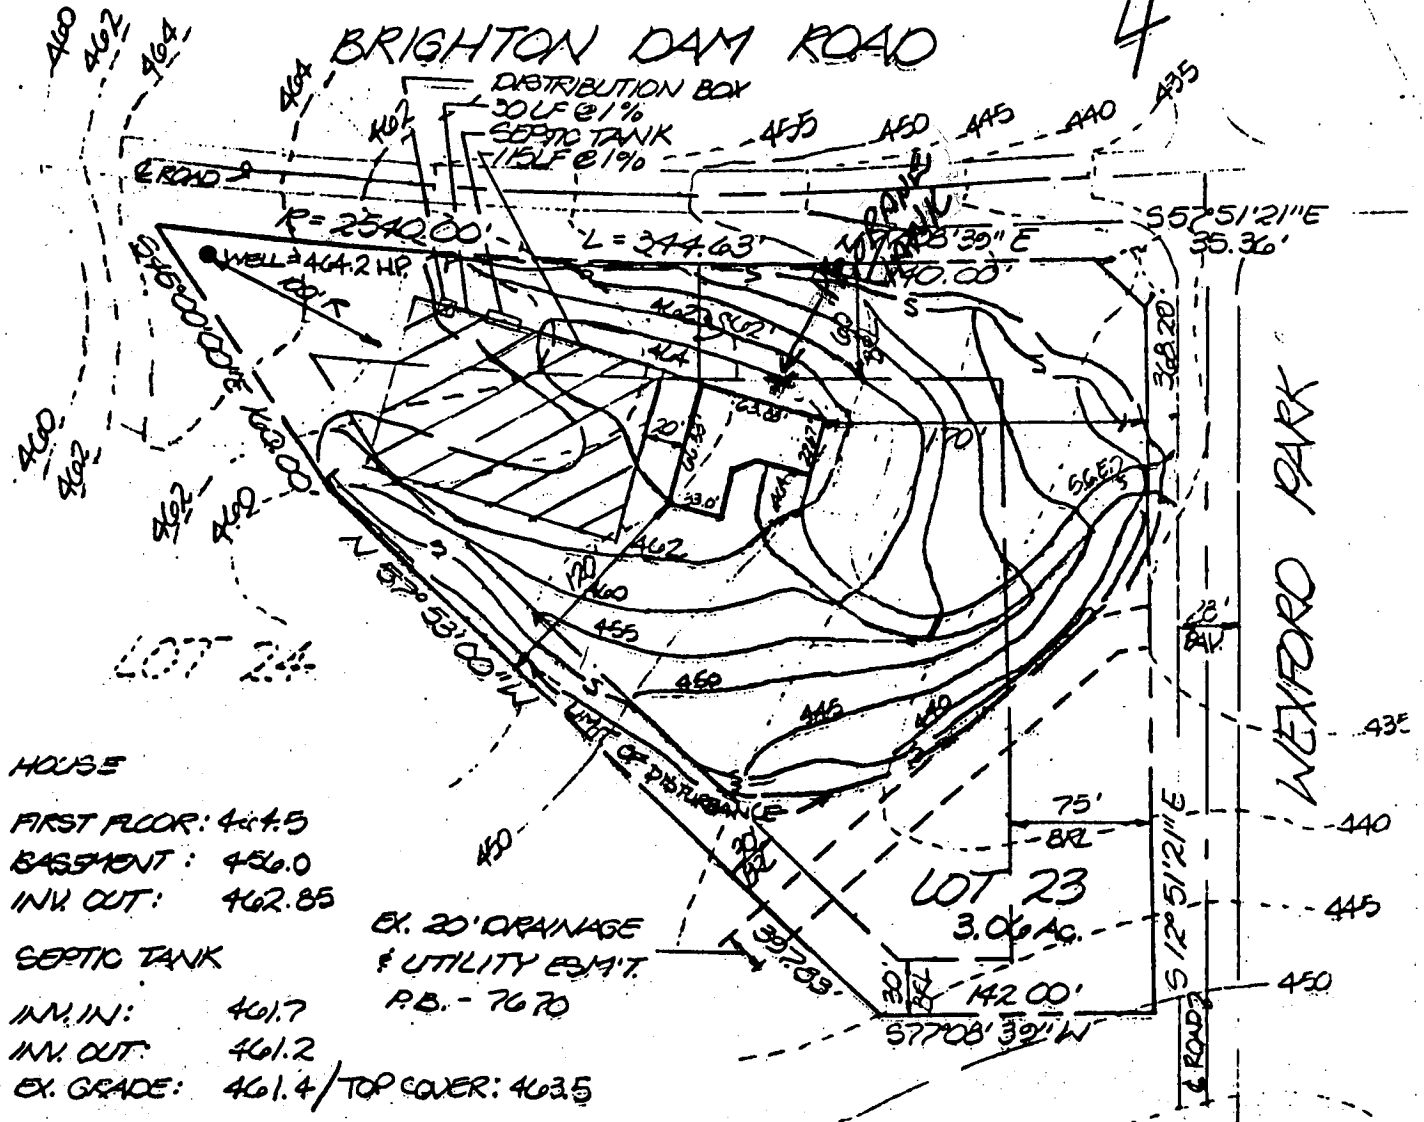

HOUSE

FIRST FLOOR: 44' x 5'
 BASEMENT: 45' x 0'
 INK OUT: 462.85

SEPTIC TANK

INV. IN: 461.7
 INV. OUT: 461.2
 EX. GRADE: 461.4 / TOP COVER: 463.5

DISTRIBUTION BOX

INV. IN: 460.9
 INV. OUT: 460.4
 EX. GRADE: 462.4 / TOP COVER: 464.0

WELL

EX. GRADE: 464.2

EX. 20' DRAINAGE
 & UTILITY EAS'T.
 P.B. - 7670

NOTES:

1. TAX MAP: 34; PARCEL: 261
2. EXISTING ZONING: R
3. REFERENCE: WATERFORD, SECT. 2
 LOTS 23 & 24.
4. TOPOGRAPHY SHOWN HEREON IS
 BASED ON AERIAL PHOTOGRAMMETRIC
 MAPS.
5. CONTRACTOR TO SET GRADES IN
 FIELD.
6. TRENCHES TO BE SET IN FIELD BY HOWARD
 COUNTY HEALTH DEPARTMENT.

NO IMPACT
 ON WELL OR
 SEPTIC.
 OK TO PROCEED
 3/6/90
 C. Well