

7/17/84
A.M. [unclear]
H.O.O.A.M.

8/16/84
a.m. [unclear]

approved 8/16/84
Stayer

PERMIT

SEWAGE DISPOSAL SYSTEM

MARYLAND STATE DEPARTMENT OF HEALTH

P 34104

A REPAIR

HOWARD COUNTY
BUREAU OF ENVIRONMENTAL HEALTH
992-2330

04-334 PM
INDEX

ELLICOTT CITY
DISTRICT _____

DATE 7/17/84

Herman Sirk IS PERMITTED TO INSTALL _____ ALTER X

ADDRESS 2555 Jennings Chapel Road, Woodbine, MD 21797 PHONE 489-4724

SUBDIVISION _____ ROAD 16012 Route 144 LOT _____

PROPERTY OWNER William Sybert

16012 Route 144

ADDRESS Lisbon, Maryland

IF GARBAGE GRINDER IS USED INCREASE SEPTIC TANK CAPACITY BY 50% AND ABSORPTION AREA BY 22%.

GARBAGE GRINDER? YES _____ NO _____

SEPTIC TANK CAPACITY _____ GALLONS NUMBER OF BEDROOMS _____

REPAIR - CALL FOR INSPECTION WHEN GROUND IS OPENED UP SO SANITARIAN CAN RECOMMEND REPAIR.

Two (2) 50ft long trenches, 10ft deep,
inlet at 4ft with 10ft of stones.
Distribution box needed.

8/15/84 O.K. to use a "Y" instead of a distribution box as parking area above
system makes box difficult to remain level. F. Skinner

PLANS APPROVED BY Frank Skinner DATE 7/17/84

COVER NO WORK UNTIL INSPECTED AND APPROVED.

NEITHER THE HOWARD COUNTY COUNCIL NOR THE HEALTH DEPARTMENT IS RESPONSIBLE FOR THE SUCCESSFUL OPERATION OF ANY SYSTEM.

NOTE: IF TRENCH IS USED CALL FOR INSPECTION BEFORE AND AFTER PLACING GRAVEL IN TRENCH.

NOTE: NO DRY WELL SHALL EXCEED 15 FOOT IN DIAMETER. NO ABSORPTION TRENCH TO EXCEED 100 FEET IN LENGTH.

NOTE: ALL PIPE FROM HOUSE TO SEPTIC TANK MUST BE CAST IRON OR SCHEDULE 40 PVC OR ABS.

PERMIT VOID AFTER THREE YEARS.


NOTE: INSTALL STAND PIPE ON SEPTIC TANK AND DRY WELL. STAND PIPES MUST BE 6 INCHES IN DIAMETER. CAST IRON, CONCRETE OR TERRA COTTA, OR PVC OR ABS ACCEPTED. IF TOP OF SEPTIC TANK IS DEEPER THAN 3 FEET MANHOLE TO GRADE REQUIRED.

***INSTALLER IS RESPONSIBLE FOR OBTAINING FINAL APPROVAL ON THIS PERMIT**

***CALL 992-2330 FOR INSPECTION OF SEPTIC SYSTEMS.**

EH - 2-1082

34104

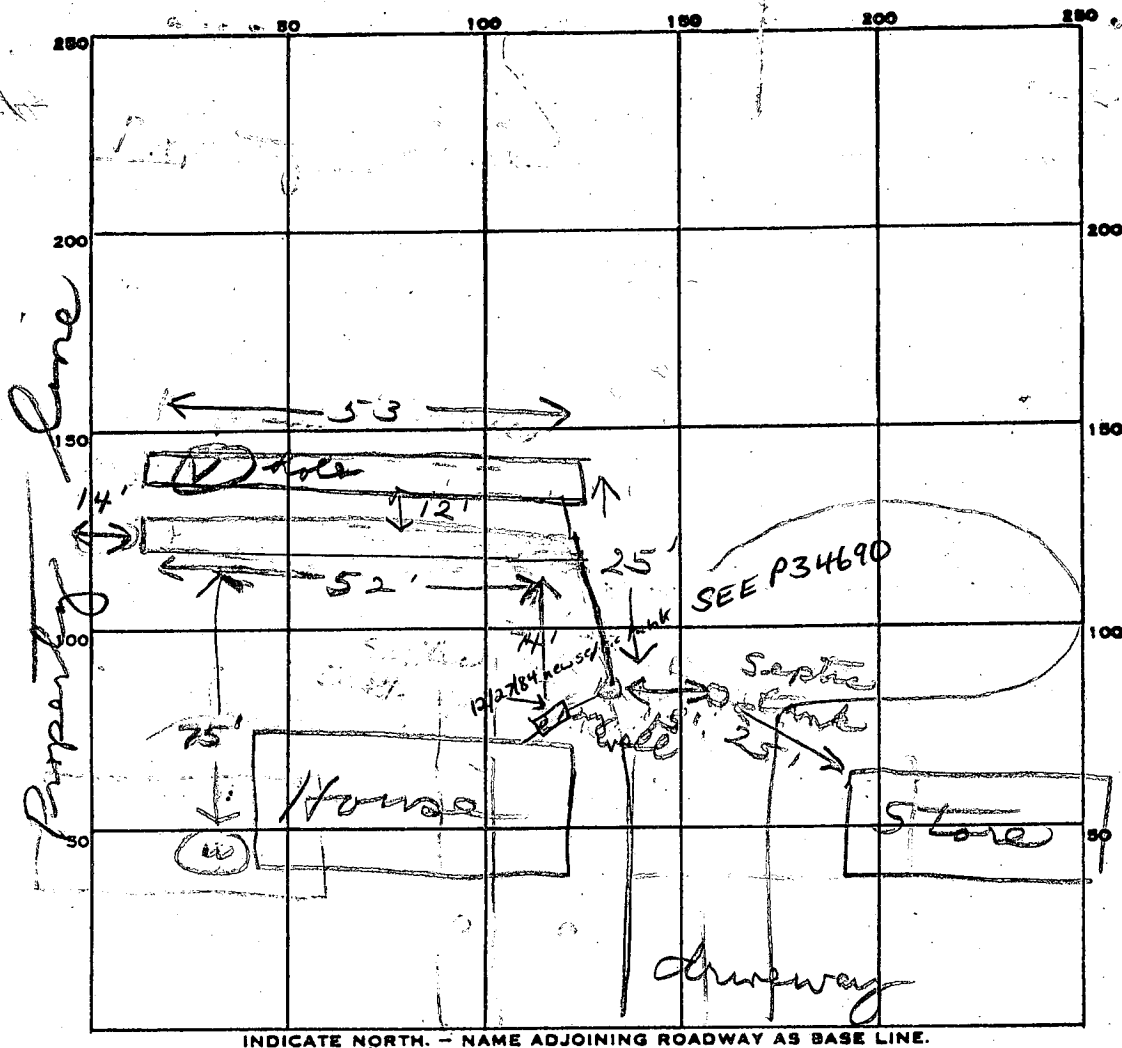

INDICATE NORTH - NAME ADJOINING ROADWAY AS BASE LINE.

RT 144

PERMIT CARD ☒

SEPTIC TANK, LEVEL _____

CLEANOUTS S.T.
OK.

DISTRIBUTION BOX, LEVEL _____

TILE FIELD, DEPTH 10 FT. TRENCH WIDTH 2 FT.

GRAVEL DEPTH 6 IN. TOTAL LENGTH 105 FT.

NUMBER OF TRENCHES 2 TOTAL BOTTOM AREA 630

SEEPAGE PITS, INSIDE DIAMETER _____ FT. DEPTH BELOW INLET _____ FT.

ABSORBENT AREA 630 SQ. FT.

REMARKS 12 ft. Visual - clay to 4 ft. - then clay mica,
sand, loam. Recommend 2 (two) 50 ft. trenches
10 ft. deep, install at 4 ft. left of store.

Dirt box needed if

8/16/84 OK to cover work if

12/27/84 New septic tank installed for house, old septic tank now used for store's septic

DATE SYSTEM APPROVED 8/16/84

INSPECTOR Stager

Sept
7/8

Wellington R. Mayne

AREA

RATING

Howard County Department of Health
BUREAU OF ENVIRONMENTAL HEALTH

RECORD OF INVESTIGATION

DATE

DISPOSITION


DATE

LOCATION Lisbon Video Seibert Electronics ZIP _____
OWNER ☒ Seibert ADDRESS MD. Rte 144 PHONE _____
OCCUPANT ☐ _____ ADDRESS _____ PHONE _____
COMPLAINANT _____ ADDRESS _____ PHONE _____
REASON FOR INVESTIGATION H0-8 1-0818

RECEIVED BY _____ DATE _____ ASSIGNED TO _____ DATE _____

DATE OF INVESTIGATION I-70 TIME _____ WEATHER _____

REPORT _____

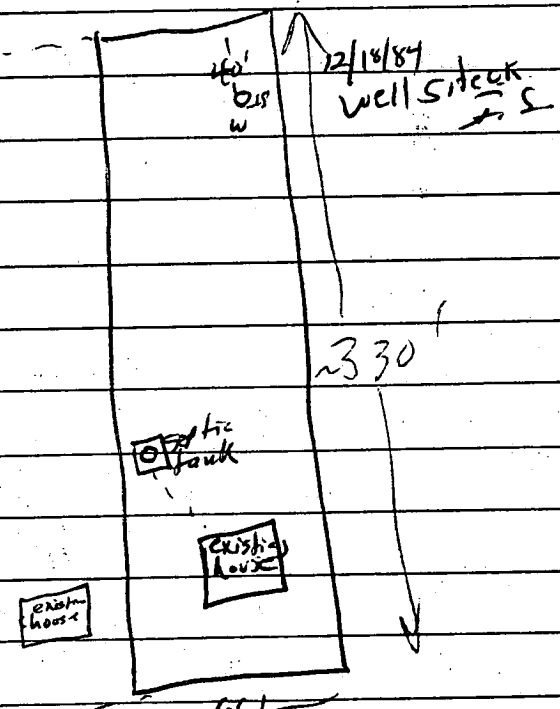




- 12/20/84 1110 PM -
- ① arrive late was scheduled for 1030. Grant started
 - ② 40 ft casing 2 ft out of ground
 - ③ 38 ft open hole as measured with a string per well grout
 - ④ Location OK per drawing
 - ⑤ Purpose of Extra Well is to provide more water
 - ⑥ Talked to Anna Wellis Seibert 442 2014 WORK
 - Mr Seibert said He wants:
 - Each building to have a well (2 buildings on property)
 - Well Gounter said yield very good
 - ⑦ 8 BAGS
 - ⑧ WELL OK RHODGES

DATE SUBMITTED _____ SANITARIAN _____

SYSTEMS.

PERMIT

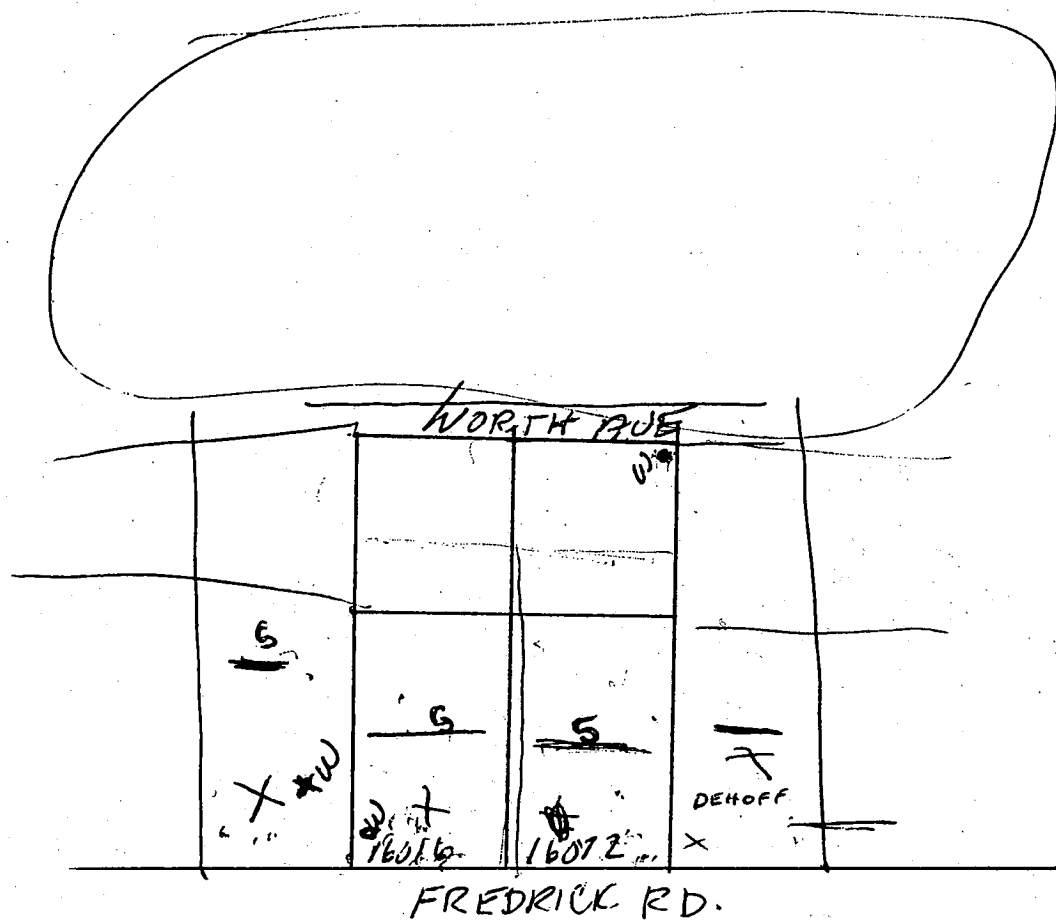

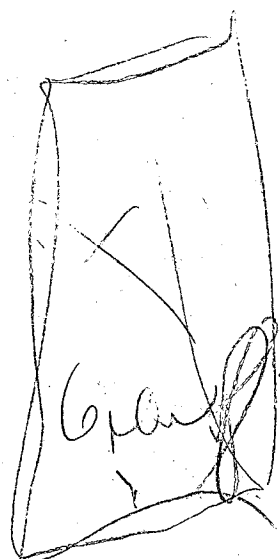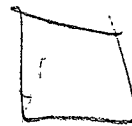

250

