

10/24/84
9:20 AM
11/5/84 9:30 AM

CHECK 11/5/84 12:30
IF GO AHEAD IS RECEIVED TO BEGIN REPAIR. approved
11/5/84
C. W. O. O. O.

PERMIT

SEWAGE DISPOSAL SYSTEM

MARYLAND STATE DEPARTMENT OF HEALTH

P 34160
A Repair

HOWARD COUNTY
BUREAU OF ENVIRONMENTAL HEALTH
992-2330

ELLICOTT CITY

DISTRICT 5th

DATE 7/30/84

INDEXED

Jack Fyock

IS PERMITTED TO INSTALL _____ ALTER ☒

ADDRESS 13775 Triadelphia Road, Glenelg, Maryland 21737 PHONE 988-9270

SUBDIVISION _____ ROAD 11851 Route 216 LOT _____

PROPERTY OWNER C. Ellsworth Iager

ADDRESS 11851 Route 216, Fulton, Md. 20759

IF GARBAGE GRINDER IS USED INCREASE SEPTIC TANK CAPACITY BY 50% AND ABSORPTION AREA BY 22%.

GARBAGE GRINDER? YES _____ NO _____

SEPTIC TANK CAPACITY _____ GALLONS NUMBER OF BEDROOMS _____

REPAIR - Call for an appointment when ground is opened up and Sanitarian will
recommend the repair system.

REPLACE SOLID PIPE STARTING AT TANK. INSTALL 900 SQ FT LEACHING BED
AS SHALLOW AS POSSIBLE. 1 FT STONE REQUIRED. 11/2/84 C.W.O.O.

PLANS APPROVED BY Frank A. Skinner DATE 7/30/84

COVER NO WORK UNTIL INSPECTED AND APPROVED.

NEITHER THE HOWARD COUNTY COUNCIL NOR THE HEALTH DEPARTMENT IS RESPONSIBLE FOR THE SUCCESSFUL OPERATION OF ANY SYSTEM.

NOTE: IF TRENCH IS USED CALL FOR INSPECTION BEFORE AND AFTER PLACING GRAVEL IN TRENCH.

NOTE: NO DRY WELL SHALL EXCEED 15 FOOT IN DIAMETER. NO ABSORPTION TRENCH TO EXCEED 100 FEET IN LENGTH.

NOTE: ALL PIPE FROM HOUSE TO SEPTIC TANK MUST BE CAST IRON OR SCHEDULE 40 PVC OR ABS.

PERMIT VOID AFTER THREE YEARS.


NOTE: INSTALL STAND PIPE ON SEPTIC TANK AND DRY WELL. STAND PIPES MUST BE 6 INCHES IN DIAMETER. CAST IRON, CONCRETE OR TERRA COTTA, OR
PVC OR ABS ACCEPTED. IF TOP OF SEPTIC TANK IS DEEPER THAN 3 FEET MANHOLE TO GRADE REQUIRED.

*INSTALLER IS RESPONSIBLE FOR OBTAINING FINAL APPROVAL ON THIS PERMIT

*CALL 992-2330 FOR INSPECTION OF SEPTIC SYSTEMS.

EH - 2-1082

P 34160
Repair

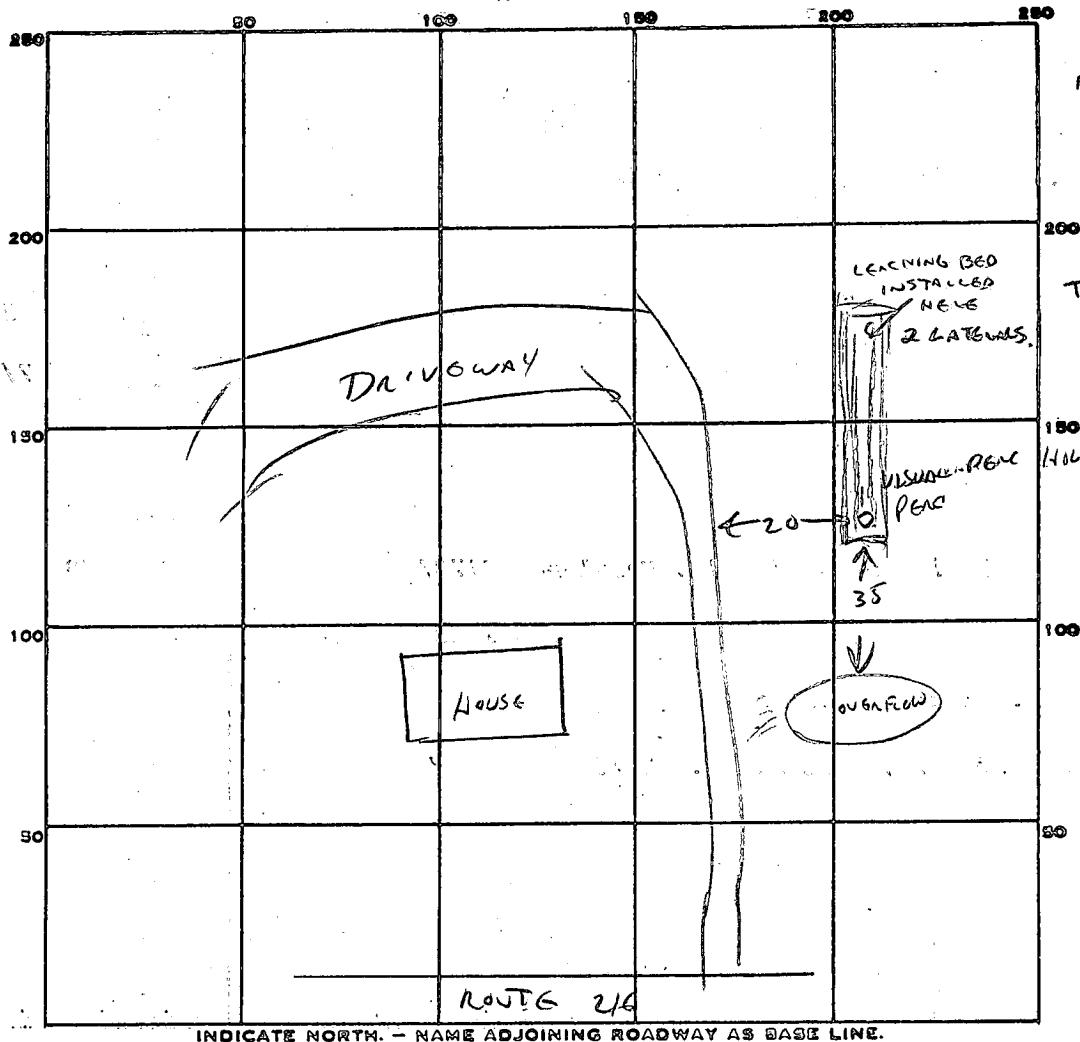

11/2/84
 EXISTING SYSTEM -
 DISPOSAL PIPE
 AT 3'
 BOTTOM OF REPAIR
 TRENCH WOULD HAVE
 TO BE 4' DEEP
 IF GRAVITY
 SYSTEM
 PERMITTED.

CLAY
 6'-6 1/2' MOTTLED
 CLAY &
 LOAM
 8'-9' GREY
 SAND

PERMIT CARD

SEPTIC TANK, LEVEL EXISTING

CLEANOUTS EXISTING

DISTRIBUTION BOX, LEVEL N/A

LEACHING BED
 TILE FIELD, DEPTH 4 FT. TRENCH WIDTH 9 FT.

GRAVEL DEPTH 1 FT TOTAL LENGTH 100 FT.

NUMBER OF TRENCHES 1 TOTAL BOTTOM AREA 900 SQ FT

SEEPAGE PITS, INSIDE DIAMETER — FT. DEPTH BELOW INLET — FT.

ABSORBENT AREA 900 SQ. FT.

REMARKS

SCHEDULE 40 UNDER DRIVEWAY -

11-5-84 LEACHING BED CONNECTED TO EXISTING SYSTEM, CW.

DATE SYSTEM APPROVED 11-5-84

INSPECTOR CWILLIAMS