

2/15/85
AM 10:30-11:00 AM
PERMIT

SEWAGE DISPOSAL SYSTEM

MARYLAND STATE DEPARTMENT OF HEALTH

HOWARD COUNTY

BUREAU OF ENVIRONMENTAL HEALTH
992-2330

APPROVED
2/15/85
RH
P 34966
A REPAIR
ELLICOTT CITY

DISTRICT

DATE 2/13/85

03-295311

INDEXED

Arnold's Septic Tank Service

IS PERMITTED TO INSTALL _____ ALTER ☒

ADDRESS Jacobs Road, Mt. Airy, Maryland 21771 PHONE 795-7873

SUBDIVISION _____ ROAD 1101 River Road LOT _____

PROPERTY OWNER Robert Schleicher Deborah Anderson

ADDRESS 1101 River Road
Sykesville, Maryland

IF GARBAGE GRINDER IS USED INCREASE SEPTIC TANK CAPACITY BY 50% AND ABSORPTION AREA BY 22%.

GARBAGE GRINDER? YES _____ NO ☒

SEPTIC TANK CAPACITY 1000 GALLONS NUMBER OF BEDROOMS 3 CONCRETE

REPLACE METAL SEPTIC TANK WITH 1000 CONCRETE TANK.

PURPOSE OF REPAIR - METAL
TANK CAVED IN. REPLACE WITH
CONCRETE

PLANS APPROVED BY Craig Williams DATE 2/13/85

COVER NO WORK UNTIL INSPECTED AND APPROVED.

NEITHER THE HOWARD COUNTY COUNCIL NOR THE HEALTH DEPARTMENT IS RESPONSIBLE FOR THE SUCCESSFUL OPERATION OF ANY SYSTEM.

NOTE: IF TRENCH IS USED CALL FOR INSPECTION BEFORE AND AFTER PLACING GRAVEL IN TRENCH.

NOTE: NO DRY WELL SHALL EXCEED 15 FOOT IN DIAMETER. NO ABSORPTION TRENCH TO EXCEED 100 FEET IN LENGTH.

NOTE: ALL PIPE FROM HOUSE TO SEPTIC TANK MUST BE CAST IRON OR SCHEDULE 40 PVC OR ABS.

PERMIT VOID AFTER THREE YEARS.

NOTE: INSTALL STAND PIPE ON SEPTIC TANK AND DRY WELL. STAND PIPES MUST BE 6 INCHES IN DIAMETER. CAST IRON, CONCRETE OR TERRA COTTA, OR
PVC OR ABS ACCEPTED. IF TOP OF SEPTIC TANK IS DEEPER THAN 3 FEET MANHOLE TO GRADE REQUIRED.

*INSTALLER IS RESPONSIBLE FOR OBTAINING FINAL APROVAL ON THIS PERMIT

*CALL 992-2330 FOR INSPECTION OF SEPTIC SYSTEMS.


EH - 2-1082

BLDG PERMITS SIGNED

AND RETURNED 5/10/01

B00130127-
P001

P 34966

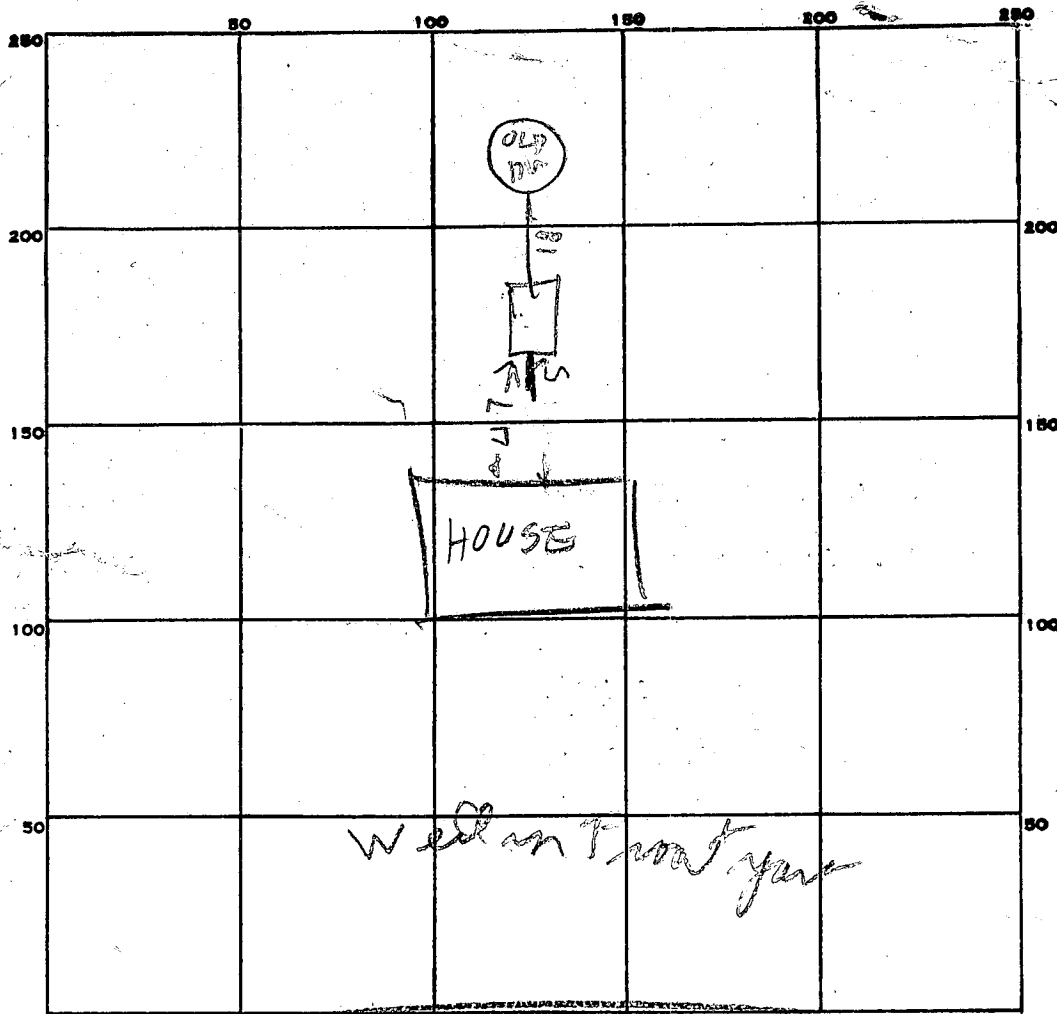

PERMIT CARD _____

SEPTIC TANK, LEVEL 1000

CLEANOUTS ST
212

DISTRIBUTION BOX, LEVEL _____

TILE FIELD, DEPTH _____ FT. TRENCH WIDTH _____ FT.

GRAVEL DEPTH _____ IN. TOTAL LENGTH _____ FT.


NUMBER OF TRENCHES _____ TOTAL BOTTOM AREA _____

SEEPAGE PITS, INSIDE DIAMETER _____ FT. DEPTH BELOW INLET _____ FT.

ABSORBENT AREA _____ SQ. FT.

REMARKS _____

DATE SYSTEM APPROVED 2/15/85 INSPECTOR Raymond H. [Signature]

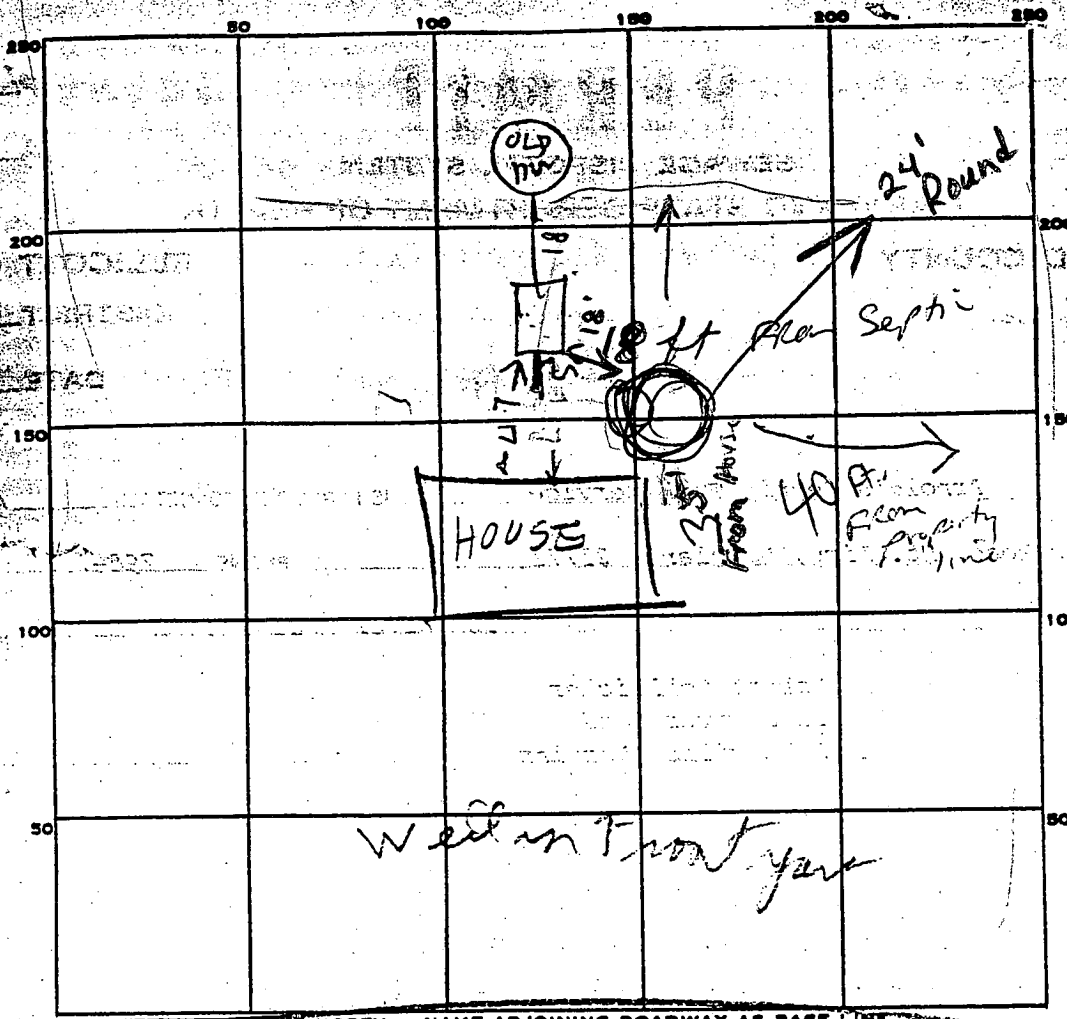

PERMIT CARD

SEPTIC TANK, LEVEL

1000

CLEANOUTS

ST

OK

DISTRIBUTION BOX, LEVEL

IN FIELD, DEPTH

FT.

TRENCH WIDTH

FT.

GRAVEL DEPTH

IN.

TOTAL LENGTH

FT.

NUMBER OF TRENCHES

TOTAL BOTTOM AREA

SEPTAGE PITS, INSIDE DIAMETER

FT.

DEPTH BELOW INLET

FT.

ABSORBENT AREA

SQ. FT.

REMARKS

SYSTEM APPROVED

2/15/85

INSPECTOR

Raymond H. Hargreaves

HOWARD COUNTY PERMIT APPLICATION

PERMIT NUMBER

B. 00130127

Building Address 1101 River Rd
Sykesville, MD 21784

Suite/Apt. #: _____ SDP/WP/Petition #: _____

Census Tract 6030 Subdivision WATERGATE

Section 9 Area 97 Lot 8

Tax Map 99 Parcel 97 Grid 5

Zoning RED Map Coordinates 5C9 Lot size 1 Acre

Existing Use Single family dwelling

Proposed Use Above ground pool

Estimated Construction Cost \$ 900

Description of Work Install above ground pool
24' x 24' Round x 4' w/ fence on
top to be filled by truck, retractable ladder

Occupant or Tenant Deborah M. Anderson

Contact Name SA

Address 1101 River Rd

City Sykesville State MD Zip Code 21784

Phone 410-442-2727 Fax 410-442-5873

Property Owner's Name Deborah M. Anderson

Address 1101 River Rd

City Sykesville State MD Zip Code 21784

Home Phone 410-442-2727 Work Phone 410-298-5832

Applicant's Name & Mailing Address, (if other than stated hereon):

Phone _____ Fax _____

Contractor Company DIG-M. Pool Installers

Contact Person Mark

Address P.O. Box 437

City Levittown State PA Zip Code 19058-1431

License No. 38308 Phone 800-858-3446 Fax 215-943-9431

Engineer or Architect Company _____

Contact Person _____

Address _____

City _____ State _____ Zip Code _____

Phone _____ Fax _____

BUILDING DESCRIPTION - COMMERCIAL

Building Characteristics

Height: _____

No. of stories: _____

Gross area, sq. ft. per floor: _____

Use group: _____

Construction type:

☐ Reinforced Concrete

☐ Structural Steel

☐ Masonry

☐ Wood Frame

☐ State Certified Modular

Utilities

Water Supply:

☐ Public

☐ Private

Sewage Disposal:

☐ Public

☐ Private

Electric Yes ☐ No ☐

Gas Yes ☐ No ☐

Heating System:

Electric ☐ Oil ☐

Natural Gas ☐

Propane Gas ☐

Sprinkler system: N/A ☐

☐ Full

☐ Partial

☐ Other Suppression

of Heads _____

BUILDING DESCRIPTION - RESIDENTIAL

Building Characteristics

SF Dwelling ☒ SF Townhouse ☐

Depth _____ Width _____

1st floor: _____

2nd floor: _____

Basement: _____

Finished Basement ☐ Unfinished Basement ☐

Crawl space ☐ Slab on Grade ☐

No. of Bedrooms _____

Multi-family dwellings:

No. of efficiency units: _____

No. of 1 BR units: _____

No. of 2 BR units: _____

No. of 3 BR units: _____

Other Structure: _____

Dimensions: _____

Footings: _____

Roof: _____

☐ State Certified Modular

☐ Manufactured Home

Utilities

Water Supply:

☐ Public

☒ Private

Sewage Disposal:

☐ Public

☒ Private

Electric Yes ☐ No ☐

Gas Yes ☐ No ☐

Heating System:

Electric ☐ Oil ☐

Natural Gas ☐

Propane Gas ☐

Sprinkler system: N/A ☐

☐ NFPA #13D

☐ NFPA #13R

☐ Other: _____

THE UNDERSIGNED HEREBY CERTIFIES AND AGREES AS FOLLOWS: (1) THAT HE/SHE IS AUTHORIZED TO MAKE THIS APPLICATION; (2) THAT THE INFORMATION IS CORRECT; (3) THAT HE/SHE WILL COMPLY WITH ALL REGULATIONS OF HOWARD COUNTY WHICH ARE APPLICABLE THERETO; (4) THAT HE/SHE WILL PERFORM NO WORK ON THE ABOVE REFERENCED PROPERTY NOT SPECIFICALLY DESCRIBED IN THIS APPLICATION; (5) THAT HE/SHE GRANTS COUNTY OFFICIALS THE RIGHT TO ENTER ONTO THIS PROPERTY FOR THE PURPOSE OF INSPECTING THE WORK PERMITTED AND POSTING NOTICES.

Applicant's Signature Deborah M. Anderson
Title/Company President / Signs & Labels, Inc.

Print Name Deborah M. Anderson
Date 5/10/01

Checks payable to: DIRECTOR OF FINANCE OF HOWARD COUNTY

** PLEASE WRITE NEATLY AND LEGIBLY **

FOR OFFICE USE ONLY

AGENCY

☒ Land Development, DPZ

☐ State Highways

☐ Building Official

☒ Dev. Engineering, DPZ

☒ Health

☐ Fire Protection

Is Sediment Control approval required prior to issuance?

YES ☐ NO ☐

CONTINGENCY CONSTRUCTION START: ☐

ONE STOP SHOP: ☐

DPZ SETBACK INFORMATION

Front: 15' 4" FF

Rear: 10' FF

Side: 20' 4" FF

Side St.: _____

All minimum setbacks met?

YES ☐ NO ☐

Is Entrance Permit required?

YES ☐ NO ☐

Historic District? ☒

YES ☐ NO ☐

Lot Coverage for New Town Zone _____

SDP/Red-line approval date _____

PROPERTY ID#

Filing fee \$ _____

Permit fee \$ 30

Excise tax \$ _____

Sub-total paid \$ _____

Add'l permit fee \$ _____

TOTAL FEES \$ 30

Balance due \$ _____

Check # 2510

Validation # 42544

Accepted by [Signature]