

10/6/86
10/7/86
11 AM

10/7/86
S. Abel
Approved

PERMIT

P 37763

A 33644

SEWAGE DISPOSAL SYSTEM

MARYLAND STATE DEPARTMENT OF HEALTH

HOWARD COUNTY
BUREAU OF ENVIRONMENTAL HEALTH
461-9933

05-380901
INDEXED

ELLICOTT CITY

DISTRICT 5th

DATE 10/6/86

I.C.O.P. issued
only
TIME EXPIRED

Norman Collins

IS PERMITTED TO INSTALL ☒ ALTER ☐

ADDRESS 2024 Millers Mill Road, Cooksville, MD 21723 PHONE

SUBDIVISION The Heritage ROAD 4108 Sharp Road LOT 57

PROPERTY OWNER Crosen Development Company, Inc.

ADDRESS

IF GARBAGE GRINDER IS USED INCREASE SEPTIC TANK CAPACITY BY 50% AND ABSORPTION AREA BY 22%.

GARBAGE GRINDER? YES ☐ NO ☒

SEPTIC TANK CAPACITY 1000 GALLONS NUMBER OF BEDROOMS 3

TRENCHES - 180 sq. ft. per bedroom. Trench to be 2 feet wide. Inlet 3 feet below original grade. Bottom maximum depth 8 feet below original grade. Effective area begins at 3 feet below original grade. 5 feet of stone below distribution pipe.

LOCATION - Start the first trench 80 feet from the front lot line and 180 feet from the right lot line as seen when facing the property from Sharp Road. Run trenches along contour toward front-left part of property.

NOTES - No trench to exceed 100 feet in length. If more than one trench used, a distribution box is required. Call for inspection of trench(s) before and after gravel is installed. Provide 6" - 8" diameter cleanout and cap to grade or above on septic tank.

10/7/86 Pines at 60" well line 52-60" bank grade. DO NOT COVER SINK

PLANS APPROVED BY C. Williams DATE 11/01/85

COVER NO WORK UNTIL INSPECTED AND APPROVED.

NEITHER THE HOWARD COUNTY COUNCIL NOR THE HEALTH DEPARTMENT IS RESPONSIBLE FOR THE SUCCESSFUL OPERATION OF ANY SYSTEM.

NOTE: IF TRENCH IS USED CALL FOR INSPECTION BEFORE AND AFTER PLACING GRAVEL IN TRENCH.

NOTE: NO DRY WELL SHALL EXCEED 15 FOOT IN DIAMETER. NO ABSORPTION TRENCH TO EXCEED 100 FEET IN LENGTH. **BUILDING PERMIT SIGNED AND RETURNED** 7/25/02

NOTE: ALL PIPE FROM HOUSE TO SEPTIC TANK MUST BE CAST IRON OR SCHEDULE 40 PVC OR ABS.

PERMIT VOID AFTER THREE YEARS.

NOTE: INSTALL STAND PIPE ON SEPTIC TANK AND DRY WELL. STAND PIPES MUST BE 6 INCHES IN DIAMETER. CAST IRON, CONCRETE OR TERRA COTTA. OR PVC OR ABS ACCEPTED. IF TOP OF SEPTIC TANK IS DEEPER THAN 3 FEET MANHOLE TO GRADE REQUIRED.


*INSTALLER IS RESPONSIBLE FOR OBTAINING FINAL APROVAL ON THIS PERMIT

*CALL 992-2330 FOR INSPECTION OF SEPTIC SYSTEMS.

EH - 2-1082

800137676 D.R. KITCHEN,
REC ROOM + FULL BATH

33644

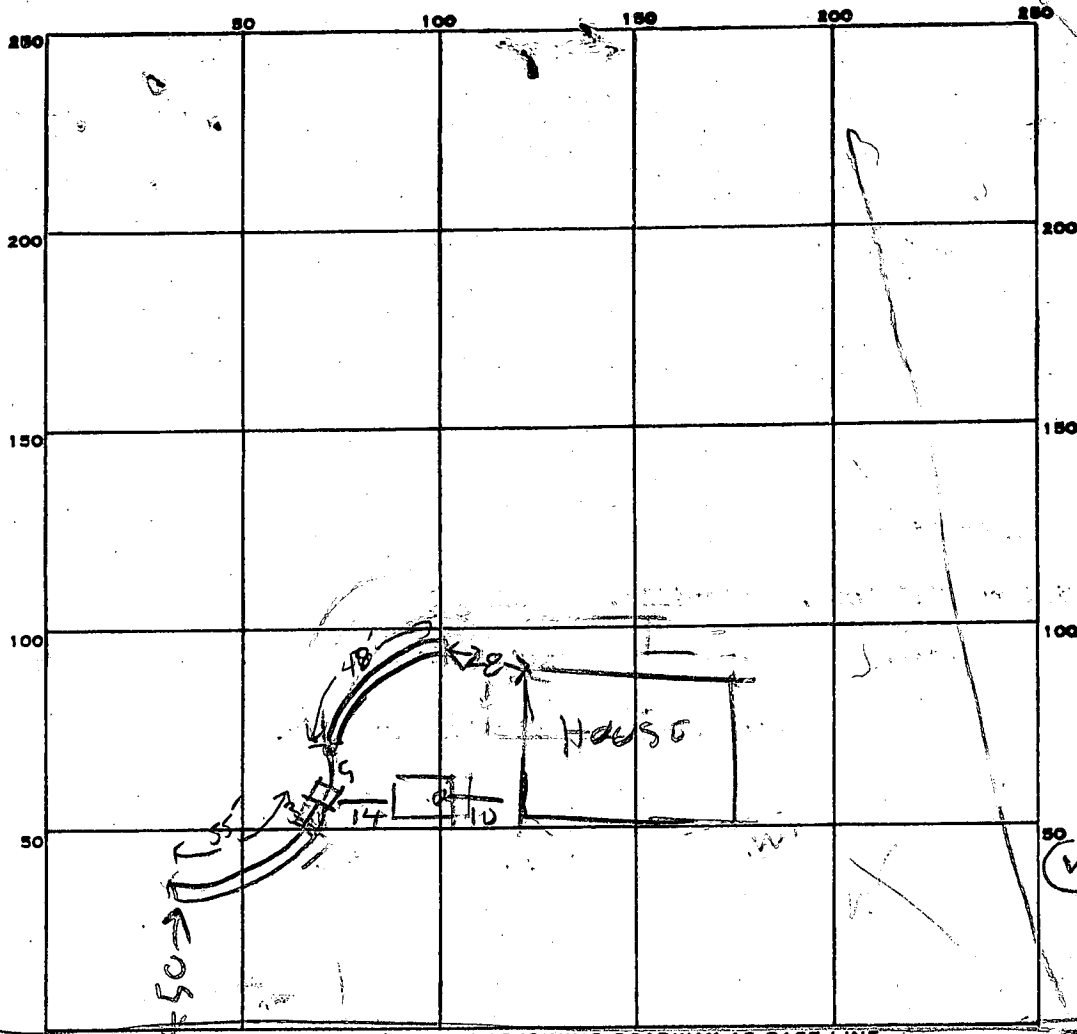

INDICATE NORTH - NAME ADJOINING ROADWAY AS BASE LINE.
SHARP RD

PERMIT CARD ☒

SEPTIC TANK, LEVEL 1500

CLEANOUTS ST OK

DISTRIBUTION BOX, LEVEL ☒

TILE FIELD, DEPTH #1 8.5 #2 9.5 FT. TRENCH WIDTH #1 2 #2 2 FT. INLET 3

GRAVEL DEPTH 5 5.5 IN. TOTAL LENGTH 48 55 FT. TOTAL 101'

NUMBER OF TRENCHES 2 TOTAL BOTTOM AREA 240 303 TOTAL 543


SEEPAGE PITS, INSIDE DIAMETER _____ FT. DEPTH BELOW INLET _____ FT.

ABSORBENT AREA 543 SQ. FT.

REMARKS 10/6/86 - LOCATION PER PLANS ADD STONE

**BUILDING PERMITS
AND RETURNED
TO TRENCH & CAFE R HODGES**

DATE SYSTEM APPROVED 10-7-86 INSPECTOR S. Abel

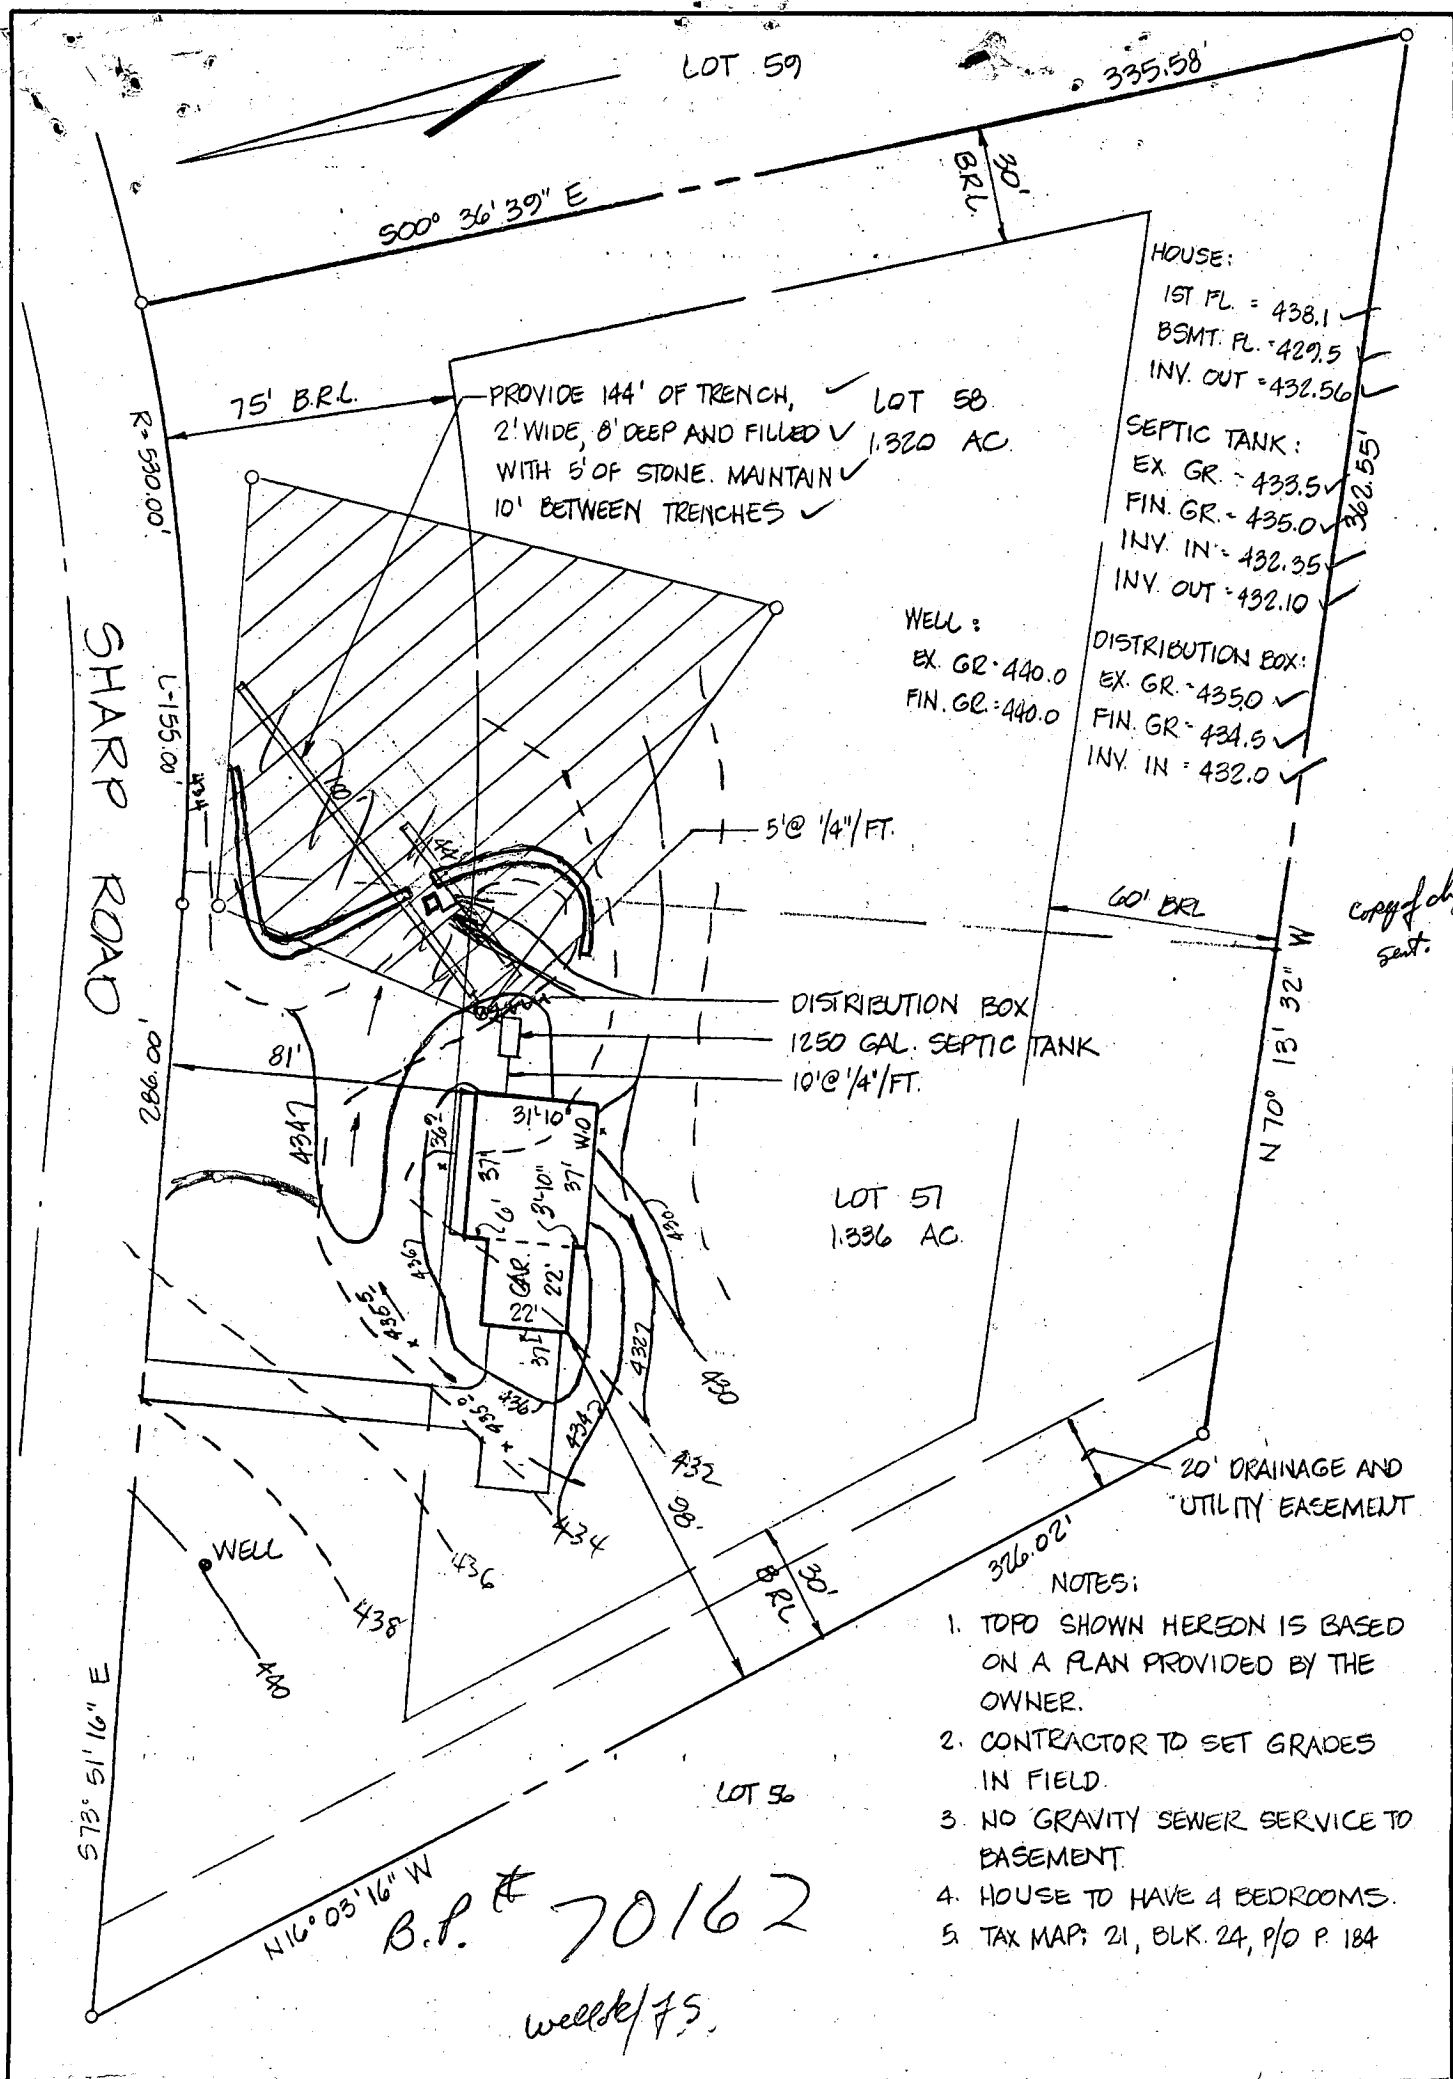

- NOTES:
1. TOPO SHOWN HEREON IS BASED ON A PLAN PROVIDED BY THE OWNER.
 2. CONTRACTOR TO SET GRADES IN FIELD.
 3. NO GRAVITY SEWER SERVICE TO BASEMENT.
 4. HOUSE TO HAVE 4 BEDROOMS.
 5. TAX MAP: 21, BLK. 24, P/O P. 184

PLAT REFERENCE: THE HERITAGE, SECT. 1, AREA 2, RECORDED AS PLAT 3776

TITLE: GRADING STUDY				
PROJECT: THE HERITAGE - SECT. 1 - AREA 2 - LOTS 57 & 58				
LOCATION: 5TH ELECTION DISTRICT HOWARD CO., MD.				
SCALE: 1" = 50'	DESIGNED BY:	DRAWN BY:	CHECKED BY:	DATE: APRIL, 1986
FIELD BOOK:	PAGE NO.:	JOB NO.: 86093	DRAWING NO.: 1 OF 1	

boender associates
inc.
consulting engineers
land surveyors
land planners

COURTHOUSE SQUARE
3565 ELLICOTT MILLS DRIVE
ELLICOTT CITY, MD. 21043
13011 465-7777

SUBDIVISION:

The Heritage

LOT NUMBER:

57 & 58
Combined

A 33644

DRY WELL OR DRY WELL AND TRENCH

_____ sq. ft./bedroom

	<u>Septic Tank</u>
3 bedroom	1000 gallon
4 bedroom	1250 gallon
5 bedroom	1500 gallon

Minimum Total square Feet

Inlet _____ feet below original grade.

Bottom maximum depth _____ feet below original grade.

Effective area begins at _____ feet below original grade.

NOTE: If trench is used to make up absorbent area, run the trench on level ground and leave a 5 foot earth buffer between dry well and trench.
No trench is to exceed 100 feet in length. Trench inlet to be same as dry well, with _____ feet of stone below distribution pipe.

TRENCHES

_____ 180 sq. ft./bedroom

Trench to be 2 wide.Inlet 3 feet below original grade.Bottom maximum depth 8 feet below original grade.Effective area begins at 3 feet below original grade.5 feet of stone below distribution pipe.

- NOTE:
- (1) No trench to exceed 100 feet in length.
 - (2) If more than one trench used, a distribution box is required.
 - (3) Trenches to be installed on level ground.
 - (4) Call for inspection of trench before gravel is installed.
 - (5) Provide 6"-8" diameter cleanout and cap to grade or above on septic tank and drywell.
 - (6) If a Garbage disposal is used, increase septic tank capacity by 50% and increase absorbant sidewall area by 22%.

LOCATION: START THE FIRST TRENCH 80' FROM THE FRONT LOT LINEAND 180' FROM THE RIGHT LOT LINE AS SEEN WHEN FACING THEPROPERTY FROM SHARP RD. RUN TRENCHES ALONG CONTOUR TOWARDFRONT-LEFT PART OF PROPERTY,11/1/55 C WilliamsBP 70162

BLDG. PERMIT SIGNED

AND RETURNED 5-13-86

APPLICATION

SEWAGE DISPOSAL TESTING

STATE OF MARYLAND - DEPARTMENT OF HEALTH AND MENTAL HYGIENE

HOWARD COUNTY HEALTH DEPARTMENT
ENVIRONMENTAL HEALTH SERVICES

P. O. BOX 476 ELLICOTT CITY, MARYLAND 21043
TELEPHONE: 992-2330

A 33644

P _____

DISTRICT 5th

DATE 3/12/84

AMERICAN PROPERTIES, Inc
40 MICHAEL DILLON
10176 BART. NATL. PIKE
E.C. 21043

TO: THE COUNTY HEALTH OFFICER
ELLICOTT CITY, MARYLAND

I, HEREBY, APPLY FOR THE NECESSARY TEST IN ORDER TO CONSTRUCT (OR RECONSTRUCT) A SEWAGE DISPOSAL SYSTEM.

PROPERTY OWNER WALGROW JOINT VENTURE Ceres Development Co. Inc.

ADDRESS _____ PHONE RHETT RENTY, INC

465-4920

PROPERTY LOCATION:

SUBDIVISION THE HERITAGE LOT NO. 57

#4108
ROAD AND DESCRIPTION SHARP RD.

SIZE OF LOT 1.2 ± TYPE BLDG. 3 or 4 BEDRM.
(NUMBER OF BEDROOMS)

THE SYSTEM INSTALLED UNDER THIS APPLICATION IS ACCEPTABLE ONLY UNTIL PUBLIC FACILITIES BECOME AVAILABLE. I FULLY UNDERSTAND THE
FEE CONNECTED WITH THE FILING OF THIS PERC TEST APPLICATION IS NON-REFUNDABLE UNDER ANY CIRCUMSTANCES. I ALSO AGREE TO COMPLY
WITH ALL M.O.S.H.A. REQUIREMENTS IN TESTING THIS LOT.

Michael B Dillon
(SIGNATURE OF APPLICANT)

APPROVED BY _____ FOR _____ DATE _____

REJECTED BY _____ FOR _____ DATE _____

HOLD PENDING FURTHER TESTS _____ DATE _____

REASONS FOR REJECTION OR HOLDING 4/26/85 LOT 57 & 58 TO BE COMBINED
PROBABLY OK BUT MUST CHECK RECORDS FIRST

PERC'D IN DRY WEATHER, SHALLOW SYSTEM ONLY, CW


B.P. 70/62

THIS IS NOT A PERMIT

ENGINEER'S SIGNATURE
AND RETURNED 5-13-86

SOIL PROFILE

0'

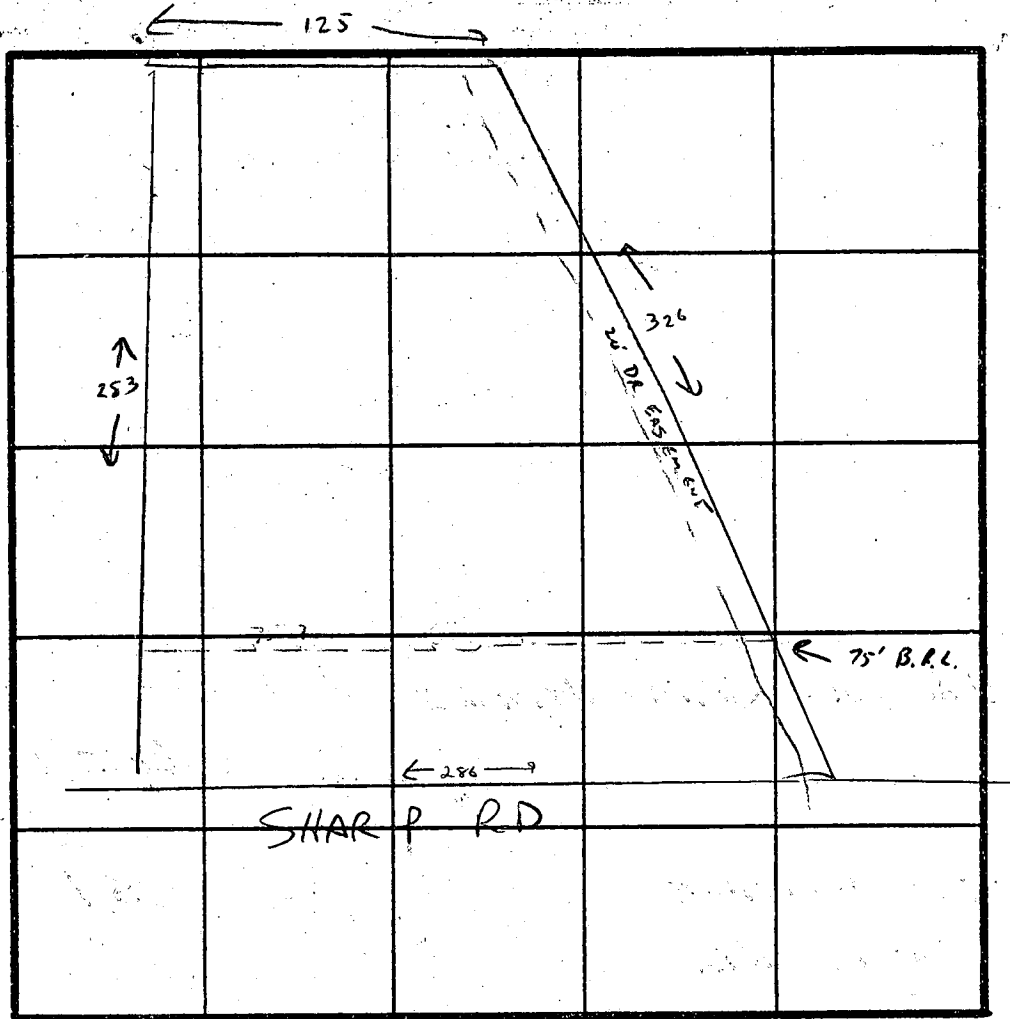

INDICATE NORTH - NAME ADJOINING ROADWAY AS BASE LINE.

DATE	TEST NO.	DEPTH	PRE-WET		TEST - 1" DROP		TIME
			START	STOP	START	STOP	

REMARKS _____

TYPE OF SOIL _____

TESTED BY _____ ALSO PRESENT _____

APPLICATION

SEWAGE DISPOSAL TESTING

STATE OF MARYLAND - DEPARTMENT OF HEALTH AND MENTAL HYGIENE

HOWARD COUNTY HEALTH DEPARTMENT
ENVIRONMENTAL HEALTH SERVICES

P. O. BOX 476 ELLICOTT CITY, MARYLAND 21043
TELEPHONE: 992-2330

A 33644

P _____

DISTRICT 5th

DATE 3/12/84

TO: THE COUNTY HEALTH OFFICER
ELLICOTT CITY, MARYLAND

I, HEREBY, APPLY FOR THE NECESSARY TEST IN ORDER TO CONSTRUCT (OR RECONSTRUCT) A SEWAGE DISPOSAL SYSTEM.

PROPERTY OWNER WALGROW JOINT-VENTURE

ADDRESS _____ PHONE R. HETT REALTY, INC.

465-4920

PROPERTY LOCATION:

SUBDIVISION THE HERITAGE LOT NO. 57

ROAD AND DESCRIPTION SHARP RD.

SIZE OF LOT 1.2 ± TYPE BLDG. 300 4 BEDRM.

(NUMBER OF BEDROOMS)

THE SYSTEM INSTALLED UNDER THIS APPLICATION IS ACCEPTABLE ONLY UNTIL PUBLIC FACILITIES BECOME AVAILABLE. I FULLY UNDERSTAND THE

FEE CONNECTED WITH THE FILING OF THIS PERC TEST APPLICATION IS NON-REFUNDABLE UNDER ANY CIRCUMSTANCES. I ALSO AGREE TO COMPLY

WITH ALL M.O.S.H.A. REQUIREMENTS IN TESTING THIS LOT. Michael B. Dillon

(SIGNATURE OF APPLICANT)

APPROVED BY _____ FOR _____ DATE _____

REJECTED BY _____ FOR _____ DATE _____

HOLD PENDING FURTHER TESTS _____ DATE _____

REASONS FOR REJECTION OR HOLDING _____

THIS IS NOT A PERMIT

ALSO PRESENT OKETZELMAN S/S

4-12' Loes
or 10,000 ft.

APPLICATION

used on
lot 49
A ~~10/27/95~~

SEWAGE DISPOSAL TESTING

P _____

STATE OF MARYLAND - DEPARTMENT OF HEALTH AND MENTAL HYGIENE

HOWARD COUNTY HEALTH DEPARTMENT
ENVIRONMENTAL HEALTH SERVICES

P. O. BOX 476, ELLICOTT CITY, MARYLAND 21043
TELEPHONE: 465-5000, EXT. 356

DISTRICT 5

DATE 10/27/95

TO: THE COUNTY HEALTH OFFICER
ELLICOTT CITY, MARYLAND

I, HEREBY, APPLY FOR THE NECESSARY TEST IN ORDER TO CONSTRUCT (OR RECONSTRUCT) A SEWAGE DISPOSAL SYSTEM.

PROPERTY OWNER Walgreen Joint Venture Co.

ADDRESS _____ PHONE _____

PROPERTY LOCATION:

SUBDIVISION Walgreen Estate LOT NO. RFB 58

ROAD AND DESCRIPTION _____

SIZE OF LOT _____ TYPE BLDG. 3 or 4

NUMBER OF BEDROOMS

IF NOT SINGLE RESIDENCE DESCRIBE _____

THE SYSTEM INSTALLED UNDER THIS APPLICATION IS ACCEPTABLE ONLY UNTIL PUBLIC FACILITIES BECOME AVAILABLE

SIGNATURE OF APPLICANT Lat John Schneider

APPROVED BY _____ FOR _____ DATE _____

(KIND OF SYSTEM)


REJECTED BY _____ FOR _____ DATE _____

(KIND OF SYSTEM)

HOLD PENDING FURTHER TESTS _____ DATE _____

REASONS FOR REJECTION OR HOLDING _____

THIS IS NOT A PERMIT

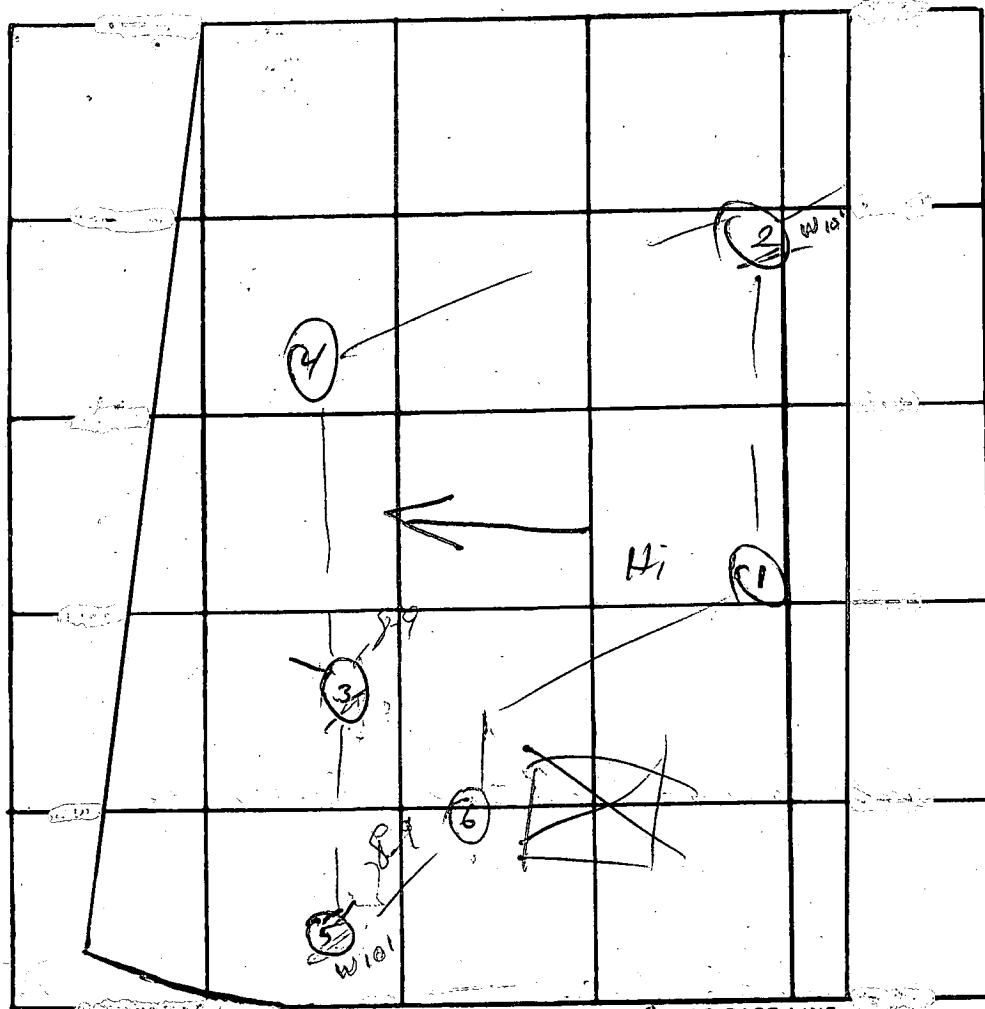

DATE	TEST NO.	DEPTH	PRE-WET		TEST - 1" DROP		TIME
			START	STOP	START	STOP	
5/15	1	2	0	4	4	9	5
	1A	6	0	10	10	20 23	18
	1B	12	0	10	10	23	13
	2	2	8	12	12	24	12
	2A	8	8	19	19	34	25
	(2B)	(12)	water	@	10' not	—	—
	3	2	0	5	5	11	6
	3A	7	0	8	8	16	8
	(3B)	12	0	25	25	30	—
	4	11	Vis	dry			
	5	2	0	11	11	27	16
	5A	7	0	3	3	6	3
	(5B)	(12)	water	@ 10'			
	6	12	Vis	dry			

REMARKS

TYPE OF SOIL

TESTED BY

ALSO PRESENT:

THE HERITAGE
SECTION 1 AREA 2

SEE BACK

64K

LINTHICUM

HIGH PORTION
OF LOTS

According to
Denny & Bender's

All holes
clay to 5-6'
damp below
WATER AS
indicated

Approx 1.0 A
EACH

Dissected
with 73-

sm 4/11/77
64K

S
H
A
R
P

f
i
l
l
e
d

LOT 66

○ WATER
AT 8'

LOT 65

○ WATER
AT 10'

LOT 64

○ WATER
AT 11'

M
A
R
S
H
L
I
K
E

STREAM

STREAM

Linthicum

Approx 1.0 A
each

some cut or fill
on 60

S
H
A
R
P

LOT 59

F
I
L
L
E
D

LOT 58

LOT 57


SEDIMENTATION
POND


← ~ 150 →

limited
high
ground

DRAINAGE
STREAM

D
R
O
P
O
F
F

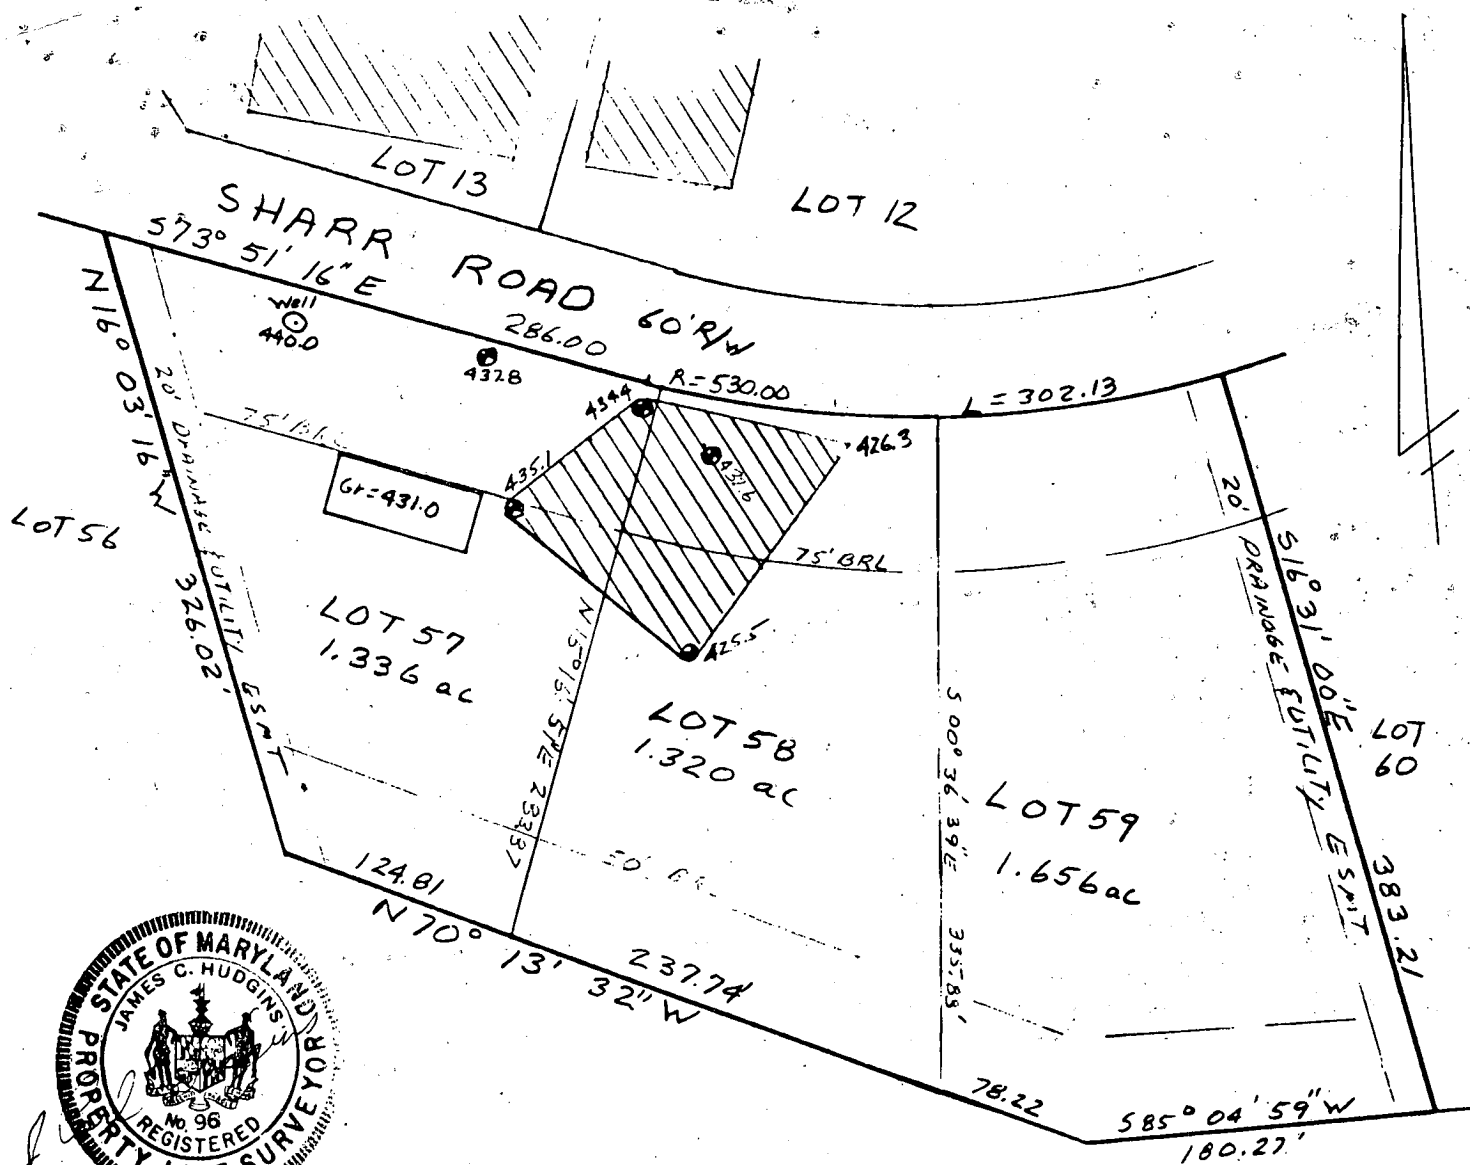

 This area designates a private sewage easement of 10,000 square feet as required by the Maryland State Department of Health and Mental Hygiene for individual sewage disposal. Improvements of any nature in this area are restricted until public sewage is available. These easements shall become null and void upon connection to a public sewage system. The County Health Officer shall have the authority to grant variances for encroachments into the private sewage easement. Recordation of a modified sewage easement shall not be necessary.

Percolation test holes shown hereon have been field located and shown as "⊕".

The lots shown hereon comply with the minimum ownership width and lot areas as required by the Maryland State Department of Health and Mental Hygiene.

Percolation areas and water wells for adjoining lots have been shown where pertinent.

APPROVED: For Private Water and Private Sewage Systems

James M. Boyd M.D. per F.S.
County Health Officer

8-16-85
Date

PERCOLATION TEST PLAT

Lots 57, 58 & 59

THE HERITAGE

Section 1 Area 2

5th Election District
Howard County, Maryland
Scale 1"=100'
Date 7/29/85

NTT Associates
101 Sterrett Place
Columbia, MD 21044
442 2031

FIELD DATA SHEET
HOWARD COUNTY WELL YIELD TEST

Well Permit No. HO - 81-11535
Location of property (road) Sharp Road
Subdivision The Heritage Lot 57 Block Plat Sec. 1
Well Driller Ralph Mayne Owner Brian Mooring

Depth of well 245 ft
Distance of measuring point (M.P.) above ground 2 ft
Static water level (S.W.L.) below M.P. 10 ft

I. High rate pumping -- reservoir drawdown

Time pump started 12:00 Pumping rate 96 p.m.
Total time 15 min to reach pumping water level 40 ft. below M.P.

II. Recovery pump test data - observations to be recorded every 15 minutes

[illegible]

80 ft PL 19 bags

2mg

William

FIELD DATA SHEET

Well Permit No. HO - 81-11535
Location of property (road) Sharp Road
Subdivision The Heritage Lot 57 Block _____ Plat _____ Sec. _____
Well Driller Ralph Mayace Owner Brian Mooring

Depth of well 275
Distance of measuring point (M.P.) above ground 2
Static water level (S.W.L.) below M.P. 10 FT

I. High rate pumping -- reservoir drawdown

Time pump started 12:00 Pumping rate 96 PM
Total time 15 min to reach pumping water level 40 ft. below M.P.

II. Recovery pump test data - observations to be recorded every 15 minutes

[illegible]

B 1 1765

SEQUENCE NO.
(OEP USE ONLY)STATE OF MARYLAND
PERMIT TO DRILL WELL

OEP PERMIT NUMBER

40-81-1155

(THIS NUMBER IS TO BE PUNCHED
IN COLS. 3-6 ON ALL CARDS)

please print or type

fill in this form completely

Date Received

082285

OWNER INFORMATION

MOORING BRIAN

10106 GREENCLOVER DR

ELLICOTT CITY MD 21043

DRILLER INFORMATION

Ralph Mayne 223

Ralph Mayne (well drilling)

9120 Brown Church Rd. Mt Airy

Thrush Mayne 8/20/85

Signature Date

WELL INFORMATION

APPROX. PUMPING RATE (GAL. PER MIN.) 5

AVERAGE DAILY QUANTITY NEEDED
(GAL. PER DAY) 500

USE FOR WATER (CIRCLE APPROPRIATE BOX)

- ☒ HOME (SINGLE OR DOUBLE HOUSEHOLD UNIT ONLY)
- ☐ FARMING (LIVESTOCK WATERING & AGRICULTURAL IRRIGATION)
- ☐ INDUSTRIAL, COMMERCIAL, STATE AND FEDERAL GOV. OTHER (REQUIRES APPROPRIATION PERMIT)
- ☐ PUBLIC OR PRIVATE WATER COMPANY (REQUIRES APPROPRIATION PERMIT AND STATE HEALTH DEPARTMENT APPROVAL)
- ☐ TEST, OBSERVATION, MONITORING (MAY REQUIRE APPROPRIATION PERMIT)

APPROXIMATE DEPTH OF WELL 150 FEET

APPROXIMATE DIAMETER OF WELL 6" NEAREST INCH

METHOD OF DRILLING (circle one)

BORED (or Augered) JETTED Jetted & DRIVEN

AIR-ROTARY AIR-PERCussion ROTARY (Hydraulic Rotary)

CABLE REVERSE-ROTARY DRIVE-POINT

other

REPLACEMENT OR DEEPEMED WELLS
(CIRCLE APPROPRIATE BOX)

- ☒ THIS WELL WILL NOT REPLACE AN EXISTING WELL
- ☐ THIS WELL WILL REPLACE A WELL THAT WILL BE ABANDONED AND SEALED
- ☐ THIS WELL WILL REPLACE A WELL THAT WILL BE USED AS A STANDBY
- ☐ THIS WELL WILL DEEPMEN AN EXISTING WELL
- PERMIT NUMBER OF WELL TO BE REPLACED OR DEEPMED (IF AVAILABLE) 41

Not to be filled in by driller (OEP USE ONLY)

APPROX. PERMIT NUMBER 54 GAP 63

FORCE SA WRITE INITIALS IN BOX PERMIT No. 40-81-1155

SPECIAL CONDITIONS

B 3

LOCATION OF WELL

HOWARD


THE HERITAGE

SECTION 2 LOT 57

GLENDELG

MILES FROM TOWN (enter 0 if in town) 2 MI

B 4

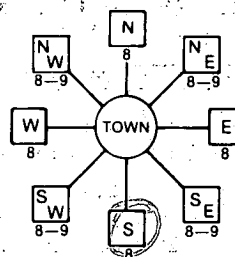DIRECTION OF WELL FROM
TOWN (CIRCLE BOX)

SHARP Rd

NEAR WHAT ROAD

ON WHICH SIDE OF ROAD
(CIRCLE APPROPRIATE BOX)

DISTANCE FROM ROAD

ENTER FT or MI

NOT TO BE FILLED IN BY DRILLER
HEALTH DEPARTMENT APPROVAL

Howard

COUNTY NAME

A-3583-2

COUNTY NO.

OEP

STATE HEALTH

SIGNATURE

INSERT S

DATE ISSUED

082785

Sichau Hal

02-27-86

NORTH

GRID 318000

EAST

GRID 0799000

SHOW MAJOR FEATURES OF
BOX & LOCATE WELL
WITH AN X


SOURCES OF DRILLING WATER

- well
-
-

WRITE THE BOX NUMBER
FROM THE MAP HERE

790

5108

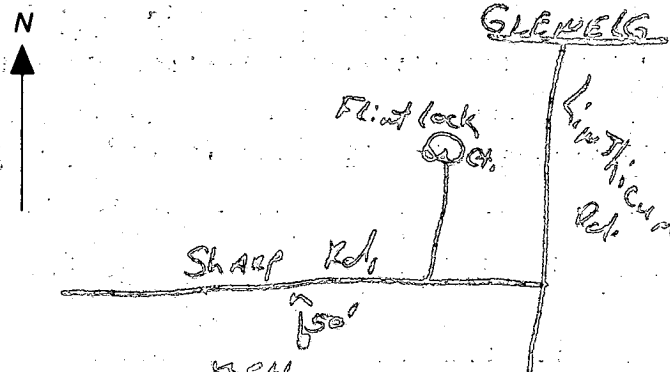DRAW A SKETCH BELOW SHOWING LOCATION OF WELL IN
RELATION TO NEARBY TOWNS AND ROADS AND GIVE
DISTANCE FROM WELL TO NEAREST ROAD JUNCTION.

HOWARD COUNTY HEALTH DEPARTMENT
BUREAU OF ENVIRONMENTAL HEALTH

PUMP INSTALLATION

THE FOLLOWING STATEMENT MUST BE COMPLETED BY THE HOME OWNER
WHEN A PUMP IS INSTALLED BY A PERSON OTHER THAN THE WELL
DRILLER:

My well driller is not to install the pump for my water well, and I
hereby certify that it will be my responsibility to have a Pump Permit
taken out by a registered master plumber or certified pump installer.
It will be my responsibility to notify the Health Department before
and during the installation so that inspections can be made by their
representative. (Pursuant to Chapter XVII, of the Plumbing Code of
Howard County.)

Brian Morley
(Name)

10/06 GREENCLOVER DR ELLICOTT CITY
(Address) MD. 21043

HO-81-1155
(OEP Well Permit Number)

(Date)

See water sample results.

NOTIFY HEALTH DEPT AT TIME OF FOOTING INSP. **CD**

HOWARD COUNTY

SERIAL NUMBER

APPLICATION

PERMIT APPLICATION

DEPARTMENT OF PUBLIC WORKS

BUREAU OF INSPECTIONS LICENSES & PERMITS

3430 COURT HOUSE DRIVE, ELICOTT CITY, MARYLAND 21043

12336

BUILDING ADDRESS (HOUSE NO., STREET, TOWN OR AREA)

4108 Sharps Rd
Glenelg, MD.

LOT NO. PARCEL NO. SEC. AREA BLOCK NO. LIBER FOLIO

5157 14 1 2 1 5226

SUB DIVISION ZONE ZONE MAP ELEC. DIST. CENSUS TR.

Heritage 11 9

OWNER'S NAME AND ADDRESS PHONE NO.

Mr. & Mrs. Jeff Anderson
4108 Sharps Rd.
Glenelg, MD. 410-200-8

OCCUPANT'S NAME AND ADDRESS PHONE NO.

Anderson

ARCHITECT OR ENGINEER'S NAME AND ADDRESS PHONE NO.

Robert C. ... 410-200-8

CONTRACTOR'S NAME AND ADDRESS PHONE NO.

James T. King, Inc.
11111 ...
... 410-200-8

EXISTING USE PROPOSED USE

Single family dwelling Same

EST. CONSTRUCTION COST LICENSE NUMBER PERMIT FEE

410,000

GRADING/SEDIMENT CONTROL ☐ YES ☐ NO

SDP #

DESCRIPTION OF WORK AUTHORIZED

1st flr addition ...

SIZE OF BLDG. FRONT DEPTH HEIGHT

13x20 20' 18' 12'

TYPE OF BLDG. AREA VOLUME ROOF

B. ROOMS
ROOMS
BATHS
FIREPLACES

FOOTINGS FOUNDATION S. WALLS

... 10' x 10' ...

UTILITIES

WATER/WELL SEWER/SEPTIC GAS ELECTRICITY TYPE OF HEAT AC

I have carefully examined and read this application and know the same is true and correct, and that in doing this work, all provisions of Howard County Ordinances and the State Laws of Maryland will be complied with, whether specified or not; and I will notify the Bureau of Inspections, and Permits twenty-four hours in advance when I am ready for the inspections called for elsewhere in this application; and that no work will be covered up until such inspections have been complied with.

Signature

James T. King

DATE

TITLE

W/S CODE FOR OFFICE USE ONLY

DISTANCE IN FEET FROM R/W LINE TO FRONT BUILDING LINE

140' 12 1/2'

SIDE YARD

(DISTANCE IN FEET FROM SIDE BLDG. LINE TO SIDE PROPERTY LINE)

DISTANCE IN FEET FROM SIDE STREET R/W LINE

TO SIDE BUILDING LINE

DISTANCE IN FEET, REAR YD. REQUIRING SET

BACK (CORNER LOT ONLY)

CONDITIONS (IF ANY) SDP #

Checks payable to DIRECTOR OF FINANCE OF HOWARD COUNTY

CAUTION

To begin construction before a permit placard has been issued and displayed on the job is a violation of the law.

Use and occupancy permit must be applied for two weeks before it will be issued.

IMPORTANT: PLEASE SHOW ZIP CODES AND AREA CODES WHEREVER REQUIRED.

FUNCTION DATE SIGNATURE APPROVAL

ZONING/PLANNING

SHA

SEDIMENT/GRADING

BUILDING OFFICIAL

WATER & SEWER

HEALTH DEPT. 4/29/88 Craigwell

FIRE PROTECTION

STORM WATER MGM.

APPROVED

DATE

Distribution of Copies:
White - Building Official
Green - Planning & Zoning


Yellow - Engineering
Pink - Health Dept.
Gold - S.H.A.

LP-69
Revised

SHARP ROAD

FIELD MEASUREMENTS
10' TOTAL
15' TO FIELD
DISCUSS EXTENT
OF EXCAVATION
PRIOR TO DECISION
4/18/88

PROPOSAL HAS BEEN
ADJUSTED TO INCLUDE
NO EXCAVATION - CRAWL SPACE ONLY.
BUIDG. TO BE SUPPLY LOTION.
APPROVED SUBJECT TO FOOTING INSPECTION
4/20/88

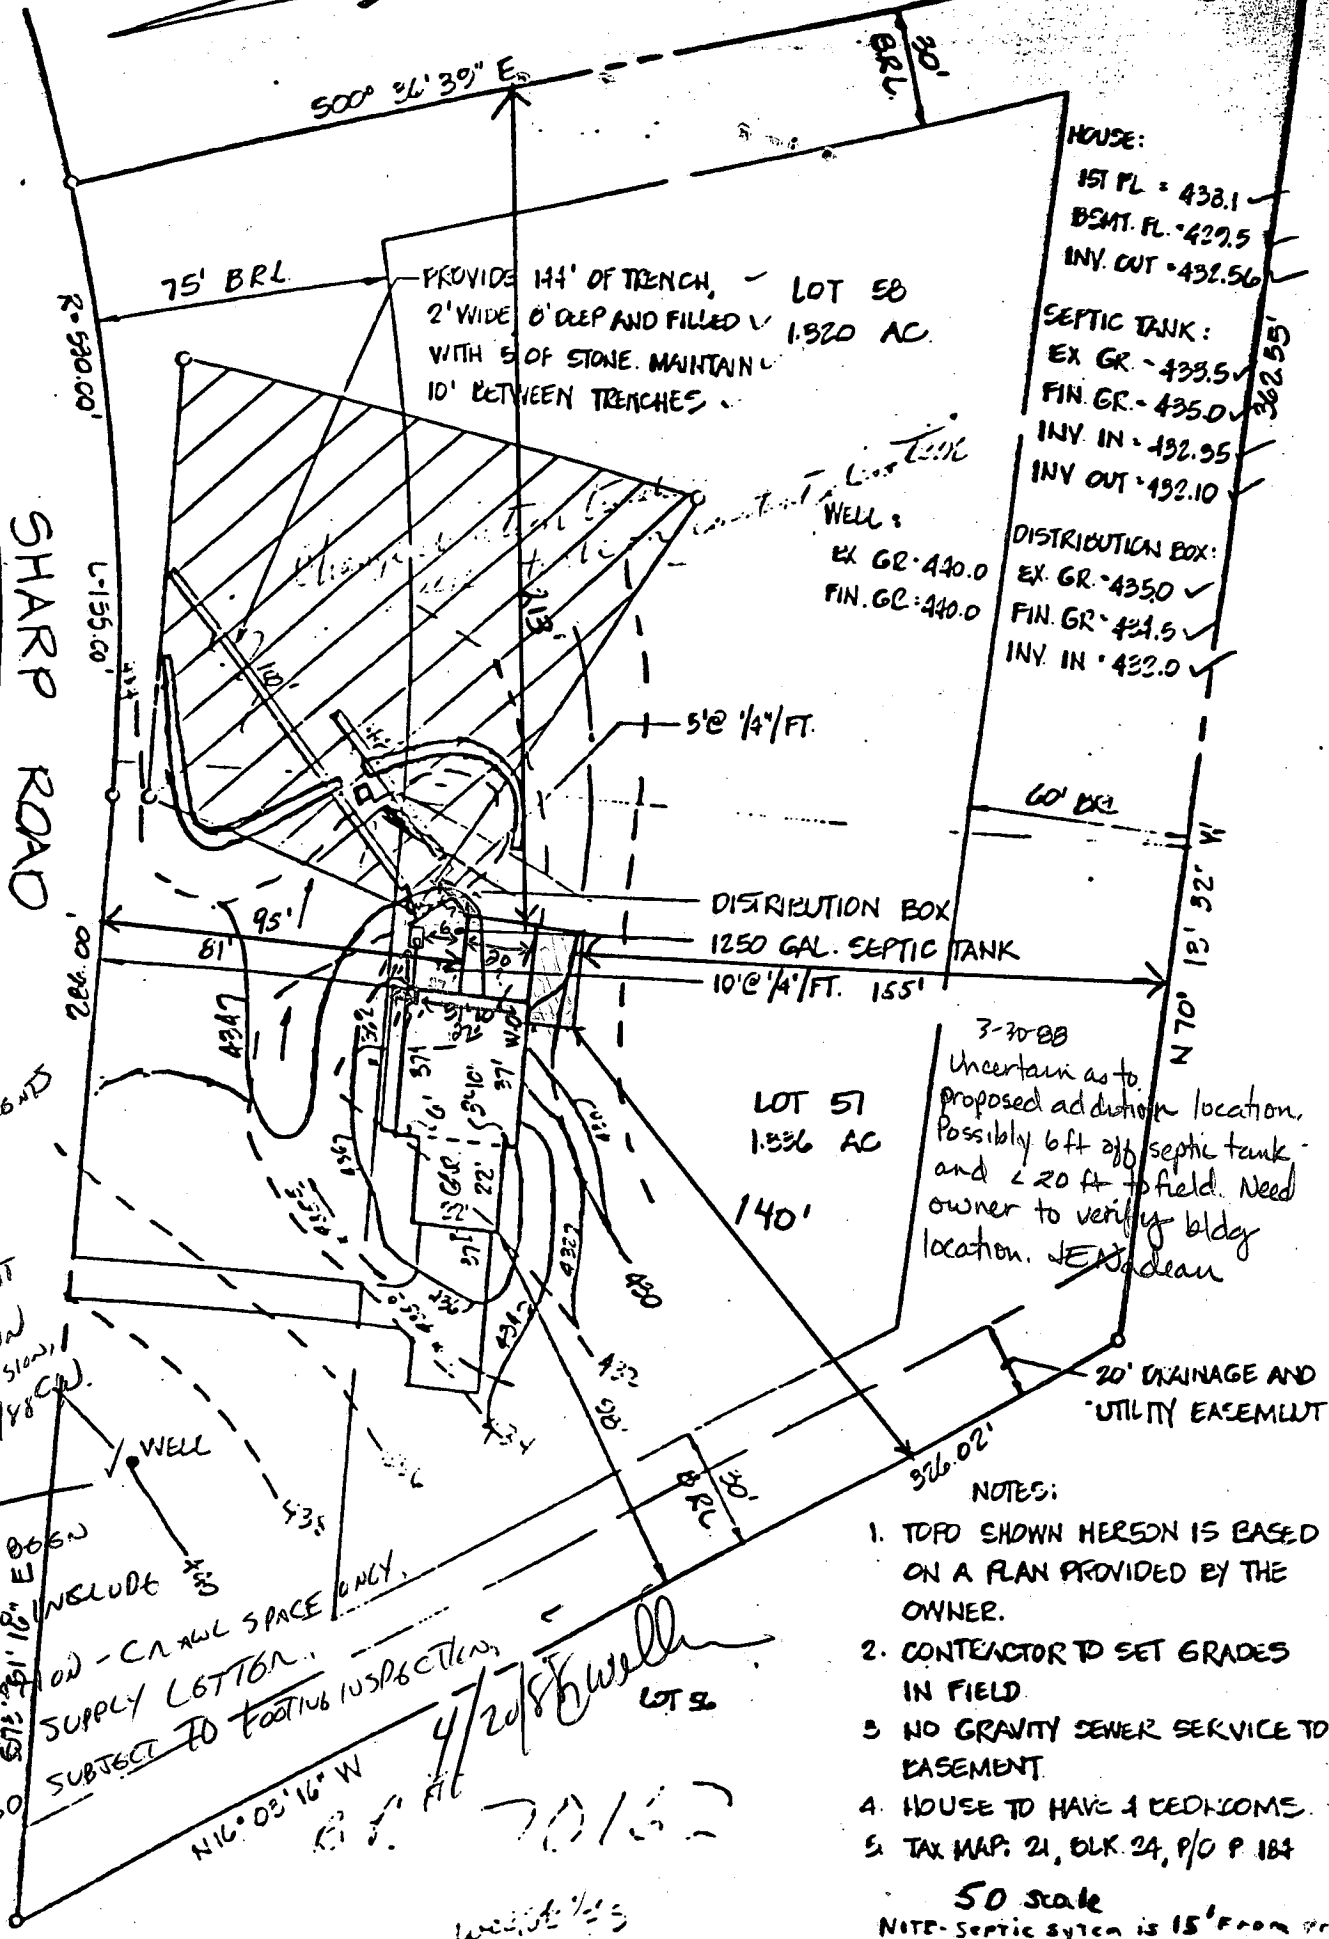

HOUSE:
1ST FL. = 438.1
BENT. FL. = 429.5
INV. OUT = 432.56
SEPTIC TANK:
EX. GR. = 439.5
FIN. GR. = 435.0
INV. IN = 432.95
INV. OUT = 432.10
DISTRIBUTION BOX:
EX. GR. = 435.0
FIN. GR. = 434.5
INV. IN = 432.0

WELL:
EX. GR. = 440.0
FIN. GR. = 440.0


DISTRIBUTION BOX
1250 GAL. SEPTIC TANK
10' 0\"/>

3-7028
Uncertain as to
proposed addition location.
Possibly 6 ft off septic tank
and 20 ft to field. Need
owner to verify bldg
location. JEN Wadeau

- NOTES:
1. TOPO SHOWN HEREON IS BASED ON A PLAN PROVIDED BY THE OWNER.
 2. CONTRACTOR TO SET GRADES IN FIELD.
 3. NO GRAVITY SEWER SERVICE TO EASEMENT.
 4. HOUSE TO HAVE 4 BEDROOMS.
 5. TAX MAP: 21, BLK 24, P/O P 184

50 scale
NOTE: Septic system is 15' from property line.
Addition - Yellow
Fence - Green
ENCLOSURE - Green

PLAT REFERENCE: THE HERITAGE, SECT. 1, AREA 2, RECORDED AS PLAT 3776

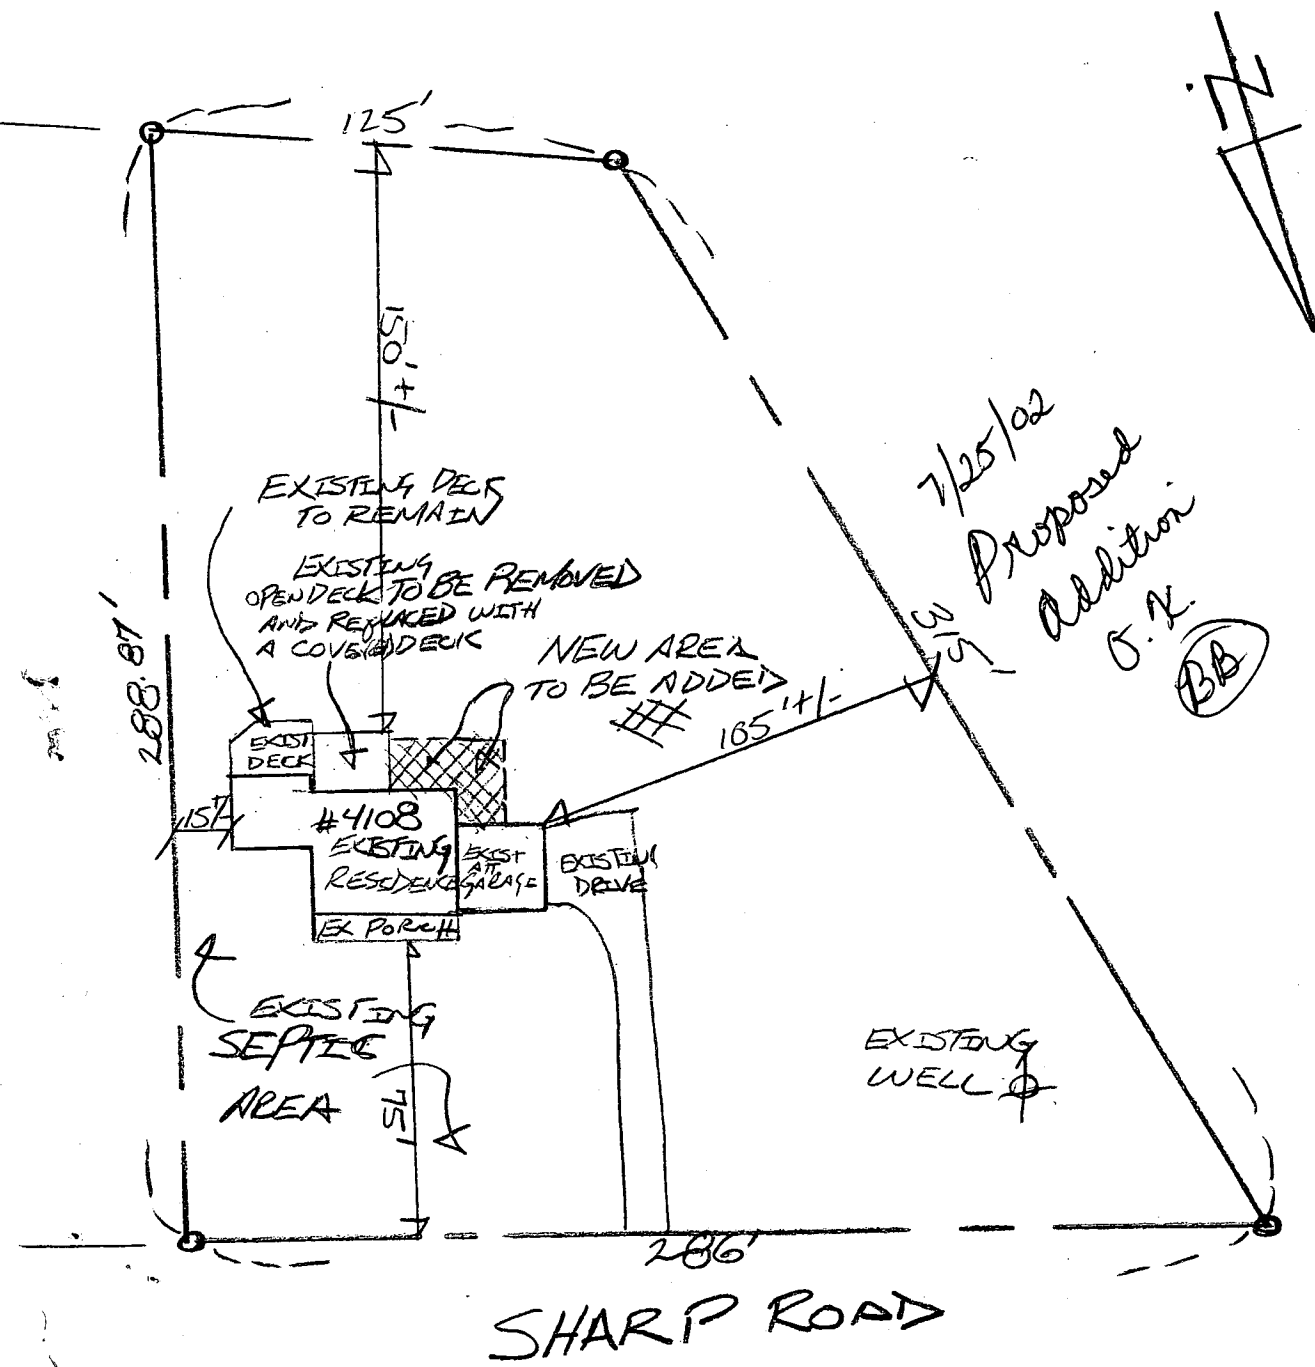

PLOT PLAN
 ANDERSON RESIDENCE
 ADDITION TO EXISTING
 RESIDENCE
 4108 SHARP ROAD
 1"=50' 7/22/02