

3/8/84
after 1³⁰

approved
4/11/84
C. Williams

PERMIT

SEWAGE DISPOSAL SYSTEM

MARYLAND STATE DEPARTMENT OF HEALTH

13/11/83
9:30 AM
Barrelled
10:10 AM
12/20/83

HOWARD COUNTY

BUREAU OF ENVIRONMENTAL HEALTH
992-2330

00-433766
INDEX

33178
A Repair

ELLICOTT CITY

DISTRICT

DATE Sept. 28, 1983

State Wide Plumbing Heating and General Contractors, Inc.

IS PERMITTED TO INSTALL ☐ ALTER ☒

ADDRESS 2843 Louisiana Avenue, Baltimore, MD 21227 PHONE 636-1700

SUBDIVISION ROAD 9586 Whiskey Bottom Rd LOT

PROPERTY OWNER Laura Jones Phone: 725-3685

ADDRESS 9586 Whiskey Bottom Road, Laurel, MD

IF GARBAGE GRINDER IS USED INCREASE SEPTIC TANK CAPACITY BY 50% AND ABSORPTION AREA BY 22%.

GARBAGE GRINDER? YES ☐ NO ☒

SEPTIC TANK CAPACITY GALLONS NUMBER OF BEDROOMS

REPAIR-CALL FOR INSPECTION WHEN GROUND IS OPENED UP SO SANITARIAN CAN RECOMMEND REPAIR.

3' CLAY THEN SAND TO 10'. WATER ROSE TO 7' 12-20-83 C. Williams

REQUIRES 1500 g HOLDING TANK, WITH HIGH WATER ALARM.

TANK MUST BE PARGED ^{F. Tar} AROUND SEAM DUE TO HIGH WATER TABLE.

1 YR PUMP SERVICE CONTRACT NECESSARY. 12-21-83

C. Williams per F.S.

PLANS APPROVED BY Frank Skinner

DATE September 28, 1983

COVER NO WORK UNTIL INSPECTED AND APPROVED.

NEITHER THE HOWARD COUNTY COUNCIL NOR THE HEALTH DEPARTMENT IS RESPONSIBLE FOR THE SUCCESSFUL OPERATION OF ANY SYSTEM.

NOTE: IF TRENCH IS USED CALL FOR INSPECTION BEFORE AND AFTER PLACING GRAVEL IN TRENCH.

NOTE: NO DRY WELL SHALL EXCEED 15 FOOT IN DIAMETER. NO ABSORPTION TRENCH TO EXCEED 100 FEET IN LENGTH.

NOTE: ALL PIPE FROM HOUSE TO SEPTIC TANK MUST BE CAST IRON OR SCHEDULE 40 PVC OR ABS.

PERMIT VOID AFTER THREE YEARS.


NOTE: INSTALL STAND PIPE ON SEPTIC TANK AND DRY WELL. STAND PIPES MUST BE 6 INCHES IN DIAMETER. CAST IRON, CONCRETE OR TERRA COTTA, OR PVC OR ABS ACCEPTED. IF TOP OF SEPTIC TANK IS DEEPER THAN 3 FEET MANHOLE TO GRADE REQUIRED.

*INSTALLER IS RESPONSIBLE FOR OBTAINING FINAL APROVAL ON THIS PERMIT

*CALL 992-2330 FOR INSPECTION OF SEPTIC SYSTEMS.

EH - 2-1082

33178

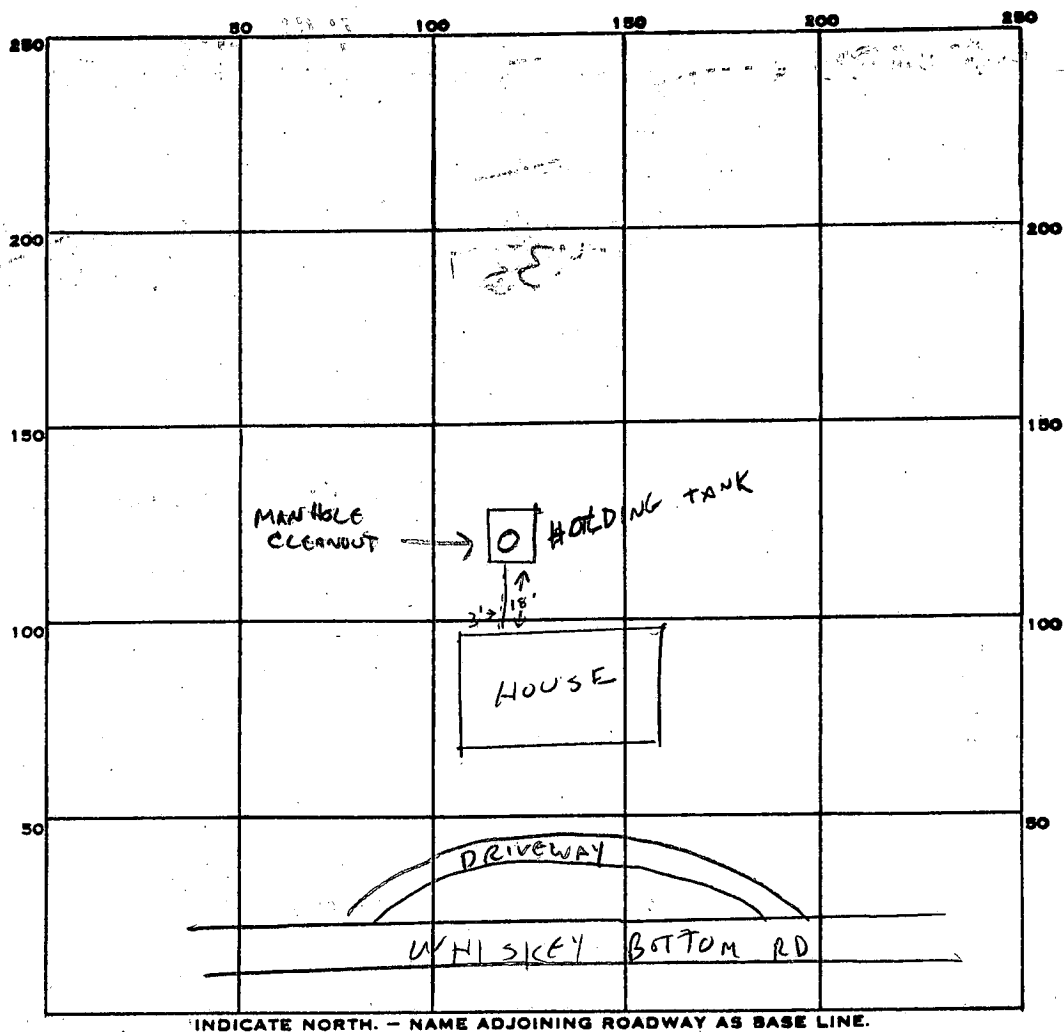

PERMIT CARD _____

SEPTIC TANK, LEVEL _____

CLEANOUTS HOLDING TANK-MANHOLE CLEANOUT

DISTRIBUTION BOX, LEVEL _____

TILE FIELD, DEPTH _____ FT. TRENCH WIDTH _____ FT.

GRAVEL DEPTH _____ IN. TOTAL LENGTH _____ FT.

NUMBER OF TRENCHES _____ TOTAL BOTTOM AREA _____

SEEPAGE PITS, INSIDE DIAMETER _____ FT. DEPTH BELOW INLET _____ FT.

ABSORBENT AREA _____ SQ. FT.

REMARKS _____

TANK & PIPE INSTALLED. MUST CALL WHEN HIGH WATER ALARM INSTALLED 3-8-84 CW

3-15-84 ALARM SYSTEM INSTALLED. ONE YEAR SERVICE CONTRACT WITH SCAVENGER
REQUIRED FOR FINAL APPROVAL. CW

4/11/84 CONTRACT RECEIVED - ALL OK CW

DATE SYSTEM APPROVED

4/11/84

INSPECTOR

CW

HOWARD COUNTY HEALTH DEPARTMENT

JOYCE M. BOYD, M.D., M.P.H.
COUNTY HEALTH OFFICER



BUREAU OF ENVIRONMENTAL HEALTH
TIBER PLACE
8308B FORREST STREET
ELLCOTT CITY, MARYLAND 21043
TELEPHONE: 992-2330

December 23, 1983

Mr. Matt Anderson
Community Development and Housing
Carroll Building
3450 Court House Drive
Ellicott City, Maryland 21043

RE: Laura Jones property
9586 Whiskey Bottom Road

Dear Mr. Anderson:

I have discussed with Frank Skinner the conditions found during the perc test of December 20, 1983 at the above referenced property. Due to the high water table a 1500 gallon holding tank will be required. This tank must be parged around the seam to prevent groundwater intrusion.

Additional requirements are for a high water alarm device to be attached to the tank and for a copy of a one year pump service contract to be shown to this office.

If you have any questions relating to this matter, please call me at 992-2330.

Yours truly,

A handwritten signature in cursive script, reading "Craig Williams".

Craig Williams, Sanitarian
Water and Sewerage Program

CW:hs

PHONE 636-1700-1701

24 HOURS - A - DAY



Statewide Plumbing, Heating, General Contractor, Inc.



REGISTERED, BONDED & INSURED

2843 LOUISIANA AVE.

BALTIMORE 27, MD.

March 11, 1984

Laura Jones
9586 Whiskey Bottom Rd.
Laurel, Maryland 20707

This is a certificate of pumping, good up to
5 pumpings for 1 year from March 1, 1984 to
March 11, 1985 on 1500 Gal. Holding Tank,

Tyree L. Back

Tyree L. Back

RECEIVED
HOUSING & COMMUNITY
DEVELOPMENT OFFICE
HOWARD CO., MD.

1984 MAR 33 PM 12:10

12/19/89
No Record Filed
inspection needed
3317P

HOLDING TANK EXEMPTION CERTIFICATE APPLICATION

Provide the following information in full and submit the completed application to:

Compliance Monitoring Coordinator
Little Patuxent Wastewater Treatment Plant
8900 Greenwood Place
Savage, Maryland 20763

<u>owner</u>	<u>Tenant</u>
APPLICANT'S NAME (1) <u>Winfield Smith</u>	<u>Walter Updyke</u>
ADDRESS: <u>6706 Bellport Place</u> <u>exin Hill Md. 20744</u>	<u>9586 Whiskey Btm Rd.</u> <u>Laurel Md.</u>
TELEPHONE NO. <u>1-301 567 5066</u>	<u>776 4695</u>

HOLDING TANK SIZE 2000 gal. GALLONS

Describe source(s) of waste discharged to holding tank:



water only

Provide frequency at which holding tank is emptied by waste hauler (example: 1 time/week, 2 times/month, etc.)

Provide sketch below showing holding tank location:

EXAMPLE:

PUT YOUR SKETCH HERE:

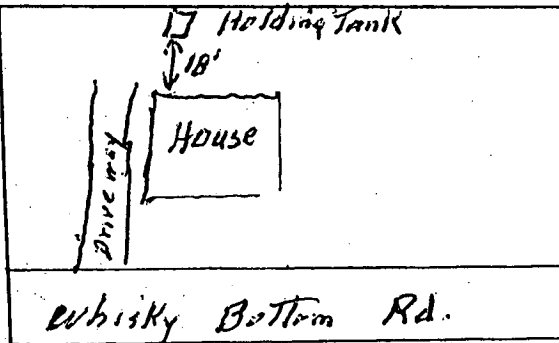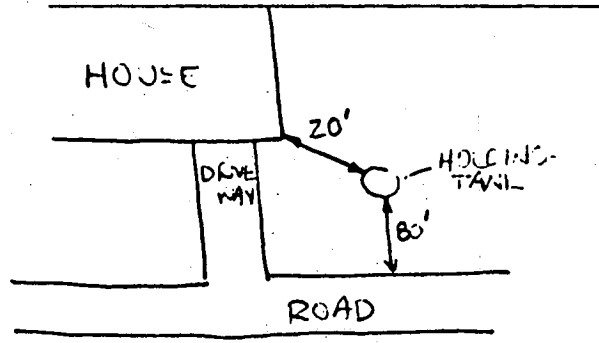

DO NOT WRITE BELOW THIS LINE

NOTES: (1) Applicant must be property owner.

APPROVED _____ DENIED BY HEALTH DEPT., REVIEWER _____ DATE _____

IF DENIED, STATE REASON _____