

11/7/83
11/8/83
ASAP

PERMIT

SEWAGE DISPOSAL SYSTEM

MARYLAND STATE DEPARTMENT OF HEALTH*

HOWARD COUNTY

BUREAU OF ENVIRONMENTAL HEALTH

992-2330

ELLICOTT CITY

DISTRICT _____

DATE 11/07/83

INDEX

Jack Fyock

IS PERMITTED TO INSTALL

ALTER X

ADDRESS 13775 Triadelphia Road, Glenelg, Maryland 21737 PHONE 988-9270

SUBDIVISION _____ ROAD 1731 Route 32 LOT _____

PROPERTY OWNER William Davis
1731 Route 32

ADDRESS 4 mile N of Rt 99 - East Side of Rt 32

IF GARBAGE GRINDER IS USED INCREASE SEPTIC TANK CAPACITY BY 50% AND ABSORPTION AREA BY 22%.

GARBAGE GRINDER? YES _____ NO —

SEPTIC TANK CAPACITY _____ GALLONS. NUMBER OF BEDROOMS 3

REPAIR - CALL FOR INSPECTION WHEN GROUND IS OPENED UP SO SANITARIAN CAN RECOMMEND

REPAIR. DEEP LEACHING BED 7 FT DEEP
WITH 2 FT STONE, 7 FT WIDE, & 100 FT LONG
PLACE BED BETWEEN TANK & OLD
DRAIN FIELD 11/4/83

PLANS APPROVED BY Frank Skinner DATE 11/07/83

COVER NO WORK UNTIL INSPECTED AND APPROVED.

NEITHER THE HOWARD COUNTY COUNCIL NOR THE HEALTH DEPARTMENT IS RESPONSIBLE FOR THE SUCCESSFUL OPERATION OF ANY SYSTEM.

NOTE: IF TRENCH IS USED CALL FOR INSPECTION BEFORE AND AFTER PLACING GRAVEL IN TRENCH.

NOTE: NO DRY WELL SHALL EXCEED 15 FOOT IN DIAMETER. NO ABSORPTION TRENCH TO EXCEED 100 FEET IN LENGTH.

NOTE: ALL PIPE FROM HOUSE TO SEPTIC TANK MUST BE CAST IRON OR SCHEDULE 40 PVC OR ABS.

PERMIT VOID AFTER THREE YEARS.

NOTE: INSTALL STAND PIPE ON SEPTIC TANK AND DRY WELL. STAND PIPES MUST BE 6 INCHES IN DIAMETER. CAST IRON, CONCRETE OR TERRA COTTA, OR PVC OR ABS ACCEPTED. IF TOP OF SEPTIC TANK IS DEEPER THAN 3 FEET MANHOLE TO GRADE REQUIRED.


BLDG. PERMIT SIGNED
AND RETURNED 4/4/85
Serial # 69034 Prob.

*INSTALLER IS RESPONSIBLE FOR OBTAINING FINAL APPROVAL ON THIS PERMIT

*CALL 992-2330 FOR INSPECTION OF SEPTIC SYSTEMS.

EH - 2-1082

133284

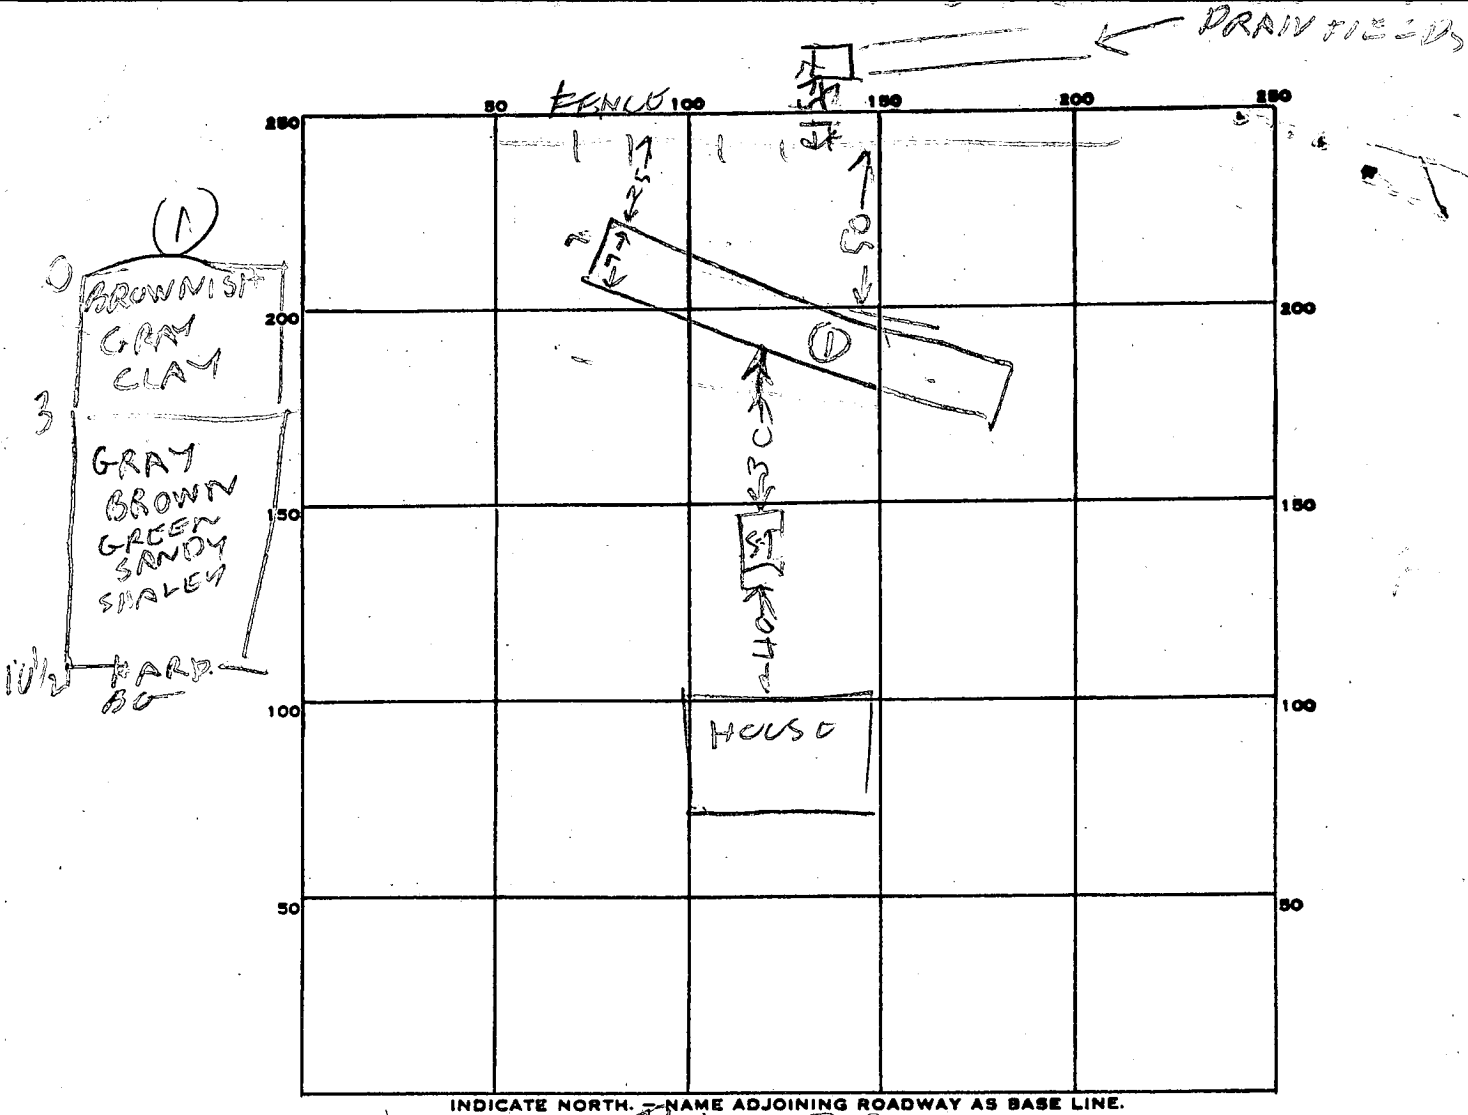

INDICATE NORTH. NAME ADJOINING ROADWAY AS BASE LINE.

ROUTE 32

PERMIT CARD _____

SEPTIC TANK, LEVEL _____

CLEANOUTS ST - MANHOLE CLEANOUT

DISTRIBUTION BOX, LEVEL _____

TILE FIELD, DEPTH 7 FT. TRENCH WIDTH 7 FT.

GRAVEL DEPTH _____ IN. TOTAL LENGTH 50 98 100 FT.

NUMBER OF TRENCHES _____ TOTAL BOTTOM AREA 700

SEEPAGE PITS, INSIDE DIAMETER _____ FT. DEPTH BELOW INLET _____ FT.

ABSORBENT AREA 700 SQ. FT. + OLD DRAINFIELD

REMARKS 11/7/83 DITCH DUG OUT 60 FT LONG 7 FT WIDE 7 FT DEEP

& VISUAL HOLE DUG. SOIL LOOKS OK BELOW 3 FT

11/7/83 - DITCH LENGTHENED TO 98 FT & SOME STONE ADDED RH

11/8/83 DITCH FINISHED. NEW 1500 ST TANK INSTALLED
W/ MANHOLE CLEANOUT. CW

DATE SYSTEM APPROVED 11-8-83 INSPECTOR CW

