

7/1/82
After 11:00 A.M.

7/1/82 App'd *SS*

PERMIT

P 32006

A Repair

SEWAGE DISPOSAL SYSTEM

MARYLAND STATE DEPARTMENT OF HEALTH

HOWARD COUNTY

02-234939
INDEX

ELLICOTT CITY

DISTRICT 2nd

DATE 6/30/82

Jenkins Brothers

IS PERMITTED TO INSTALL _____ ALTER ☒

ADDRESS 10439 Frederick Road, Ellicott City, Md. 21043 PHONE 465-6646

SUBDIVISION _____ ROAD 2401 Sunset Farm Road LOT _____

PROPERTY OWNER Robert Ohler

ADDRESS ~~XXXXXXXXXXXXXXXXXXXXXXXXXXXX~~ 2401 Sunset Farm Road, Ellicott City, Md. 21043

SPECIFICATIONS

SEPTIC TANK CAPACITY _____ GALLONS
DRAIN FIELD _____ DEPTH _____ FEET, BOTTOM AREA _____ SQ. FT.
DEEP TRENCH _____ DEPTH _____ FEET, BOTTOM AREA _____ SQ. FT.
SEEPAGE PITS _____ ABSORBENT SIDE-WALL AREA _____ SQ. FT.
INLET PIPE _____ FT. BELOW ORIGINAL GRADE. MAXIMUM DEPTH _____ FT. BELOW ORIGINAL GRADE
EFFECTIVE DEPTH AT _____ FT. BELOW ORIGINAL GRADE.
LOCATE DISPOSAL AREA _____ FT. FROM _____ LOT LINE AND _____ FT. FROM _____ LOT LINE AS SEEN WHEN
FACING LOT FROM

REPAIR - Call for an appointment when ground is opened up and Sanitarian will

recommend the repair system.

Replace metal tank & concrete septic tank


PLANS APPROVED BY Palmer F. Wine DATE 6/29/82

COVER NO WORK UNTIL INSPECTED AND APPROVED.
NEITHER THE HOWARD COUNTY COUNCIL NOR THE HEALTH DEPARTMENT IS RESPONSIBLE FOR THE SUCCESSFUL OPERATION OF ANY SYSTEM.
NOTE: IF TRENCH IS USED CALL FOR INSPECTION BEFORE PLACING GRAVEL IN TRENCH.
NOTE: NO DRY WELL SHALL EXCEED 15 FOOT IN DIAMETER.
NOTE: ALL PIPE FROM HOUSE TO DISPOSAL AREA MUST BE CAST IRON.
PERMIT VOID AFTER THREE YEARS.
NOTE: INSTALL STAND PIPE ON SEPTIC TANK AND DRY WELL. STAND PIPES MUST BE 6 INCHES IN DIAMETER. CAST IRON, CONCRETE OR TERRA
COTTA ACCEPTED.

*INSTALLER IS RESPONSIBLE FOR OBTAINING FINAL APPROVAL ON THIS PERMIT.

BLDG. PERMIT SIGNED
AND RETURNED 5/6/91
Serial # 37733 - deck

P. 32006

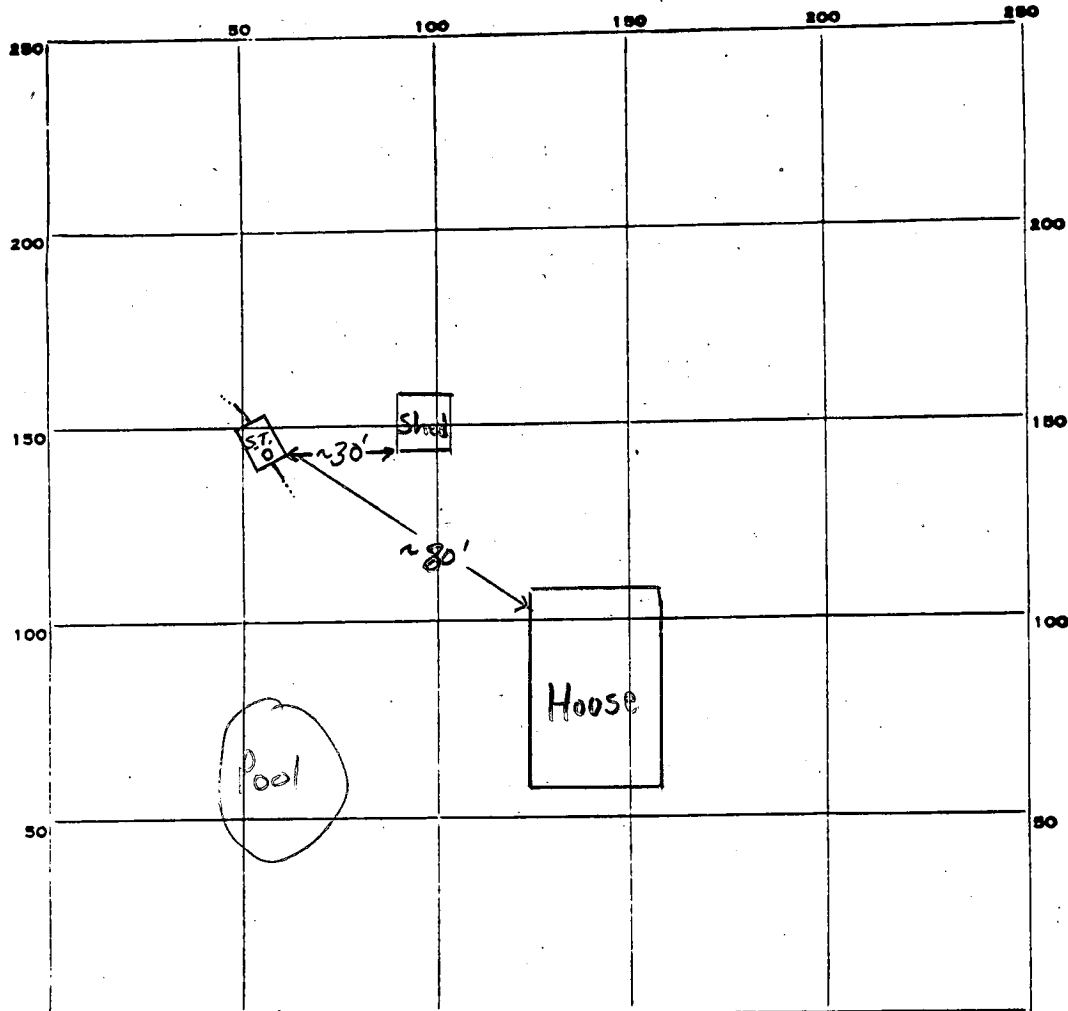

end of Sunset Farm Road

PERMIT CARD ✓ Signed OK.

SEPTIC TANK, LEVEL ✓ 100 gal

CLEANOUTS S.T. OK.

DISTRIBUTION BOX, LEVEL na

TILE FIELD, DEPTH — FT. TRENCH WIDTH — FT.

GRAVEL DEPTH — IN. TOTAL LENGTH — FT.


NUMBER OF TRENCHES — TOTAL BOTTOM AREA —

SEEPAGE PITS, INSIDE DIAMETER — FT. DEPTH BELOW INLET — FT.

ABSORBENT AREA — SQ. FT.

REMARKS OK to cover all work, cast iron pipe on both ends of tank connected
to existing orange clay pipe F.S.


DATE SYSTEM APPROVED 7/1/82 INSPECTOR F. Skinner

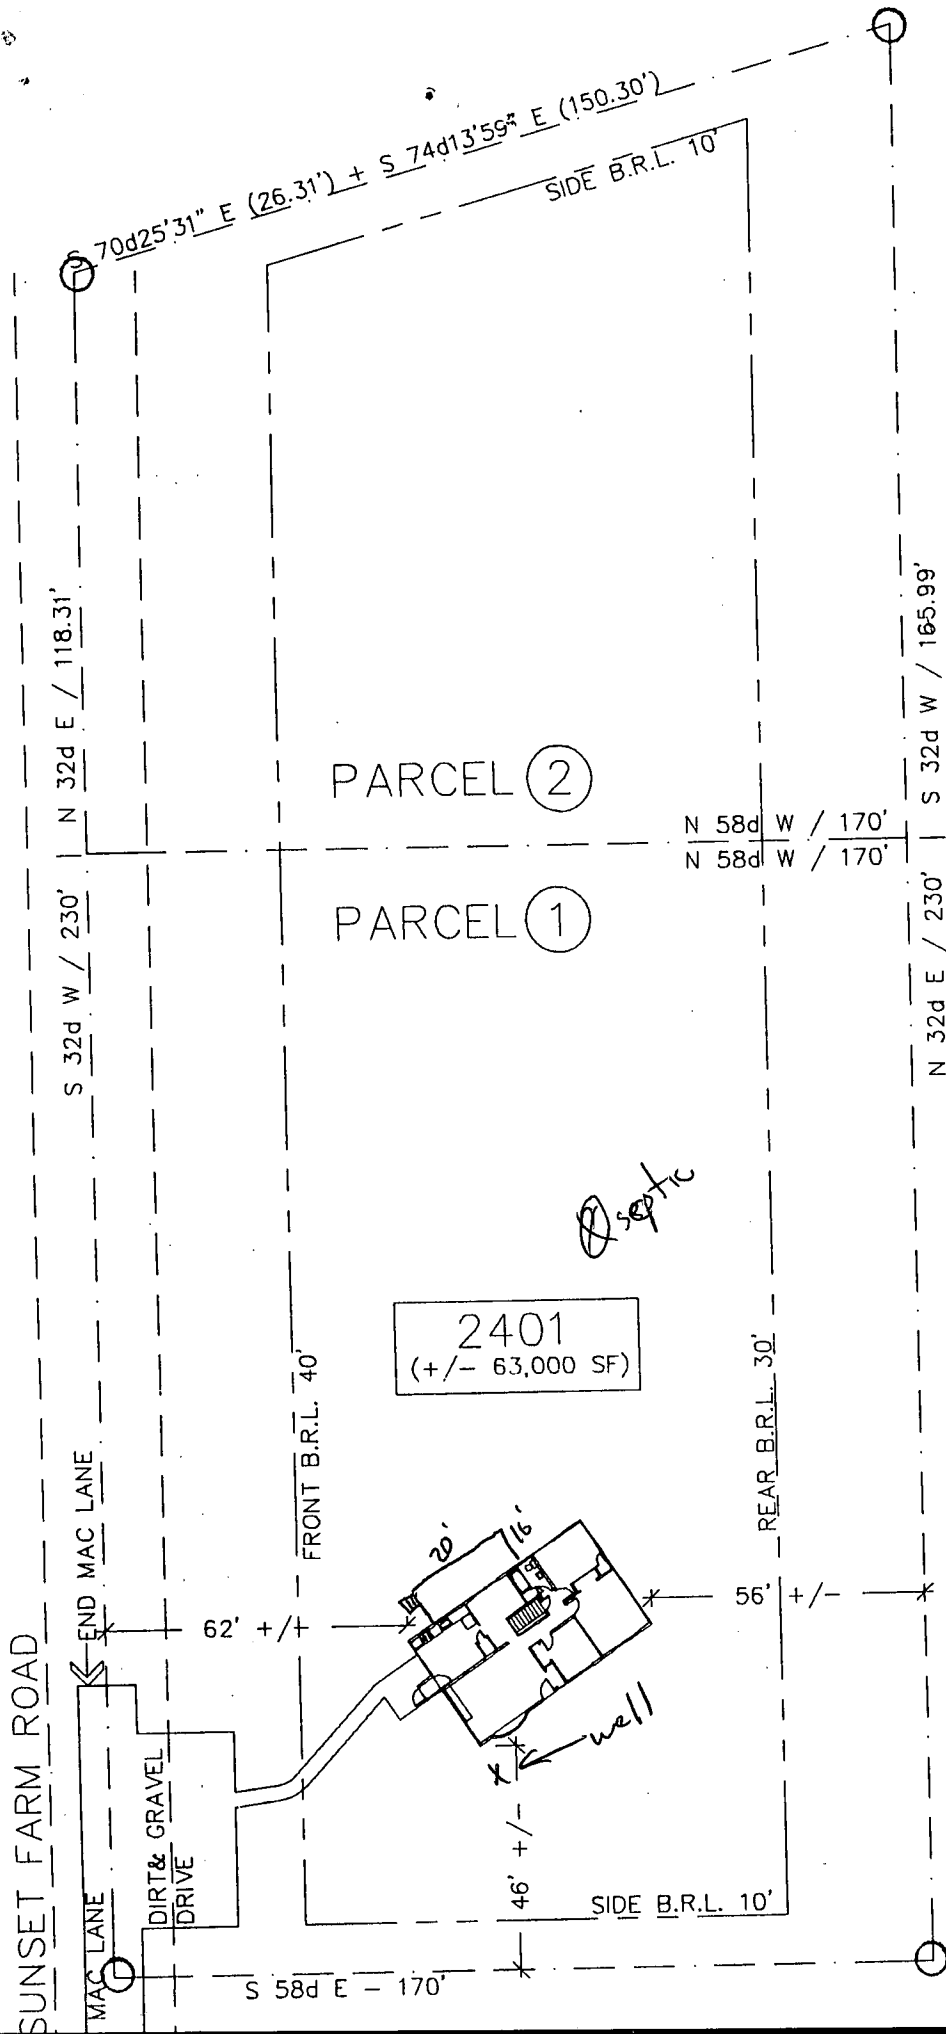

Septic

EXISTING

Scale: 1" = 16'

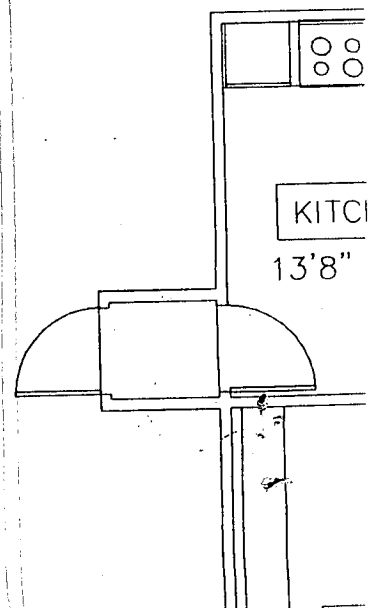

SUNSET FARM ROAD

END MAC LANE

MAC LANE

DIRT & GRAVEL
DRIVE

FRONT B.R.L. 40'

2401
(+/- 63,000 SF)

REAR B.R.L. 30'

62' +/-

56' +/-

46' +/-

SIDE B.R.L. 10'

S 58d E - 170'

EXISTING HOUSE LOCATION & PLAT

Scale : 1" = 30'

PLAT INFORMATION TAKEN FROM:
LOCATION CERTIFICATION
2401 SUNSET FARM ROAD
LIBER 557 / FOLIO 232 / HO.CO.
4/8/90 / FILE 9479 by
HICKS ENGINEERING COMPANY, INC.
301-494-0001

