

PERMIT

SEWAGE DISPOSAL SYSTEM

MARYLAND STATE DEPARTMENT OF HEALTH

HOWARD COUNTY

04-337743

ELLICOTT CITY

DISTRICT 4th

DATE 10/5/82

INDEX

Arnold Septic Tank Service

IS PERMITTED TO INSTALL X ALTER

ADDRESS Jacobs Road, Mt. Airy, Maryland 21771

PHONE 795-7873

SUBDIVISION Stanley B. Miller

ROAD 16477 Route 144

LOT 26

PROPERTY OWNER Kenneth Douglas Phebus Vasilios Galliatatos
2256 Florence Road

ADDRESS Woodbine, Maryland 21797

BUILDING PERMIT SIGNED

SPECIFICATIONS 3 Bedrooms

SEPTIC TANK CAPACITY 1000 GALLONS

DRAIN FIELD DEPTH FEET, BOTTOM AREA SQ. FT.

DEEP TRENCH DEPTH FEET, BOTTOM AREA SQ. FT.

Dry well and SEEPAGE PITS X ABSORBENT SIDE-WALL AREA 192 SQ. FT. per bedroom
Trench

INLET PIPE 3 FT. BELOW ORIGINAL GRADE. MAXIMUM DEPTH 10 FT. BELOW ORIGINAL GRADE

EFFECTIVE DEPTH AT FT. BELOW ORIGINAL GRADE.

LOCATE DISPOSAL AREA 105 FT. FROM front LOT LINE AND 20 FT. FROM right LOT LINE AS SEEN WHEN

FACING LOT FROM Maryland Route 144

Start the trench after a 5 foot earth buffer with the dry well and proceed to dig trench on level ground the necessary distance. Call for inspection of trench before placing gravel in trench.

If trench only, 225 SQ. FT. / B.R. required F.S.

PLANS APPROVED BY Frank Skinner

DATE 7/28/82

COVER NO WORK UNTIL INSPECTED AND APPROVED.

NEITHER THE HOWARD COUNTY COUNCIL NOR THE HEALTH DEPARTMENT IS RESPONSIBLE FOR THE SUCCESSFUL OPERATION OF ANY SYSTEM.

NOTE: IF TRENCH IS USED CALL FOR INSPECTION BEFORE PLACING GRAVEL IN TRENCH.

NOTE: NO DRY WELL SHALL EXCEED 15 FOOT IN DIAMETER.

NOTE: ALL PIPE FROM HOUSE TO DISPOSAL AREA MUST BE CAST IRON.

PERMIT VOID AFTER THREE YEARS.

NOTE: INSTALL STAND PIPE ON SEPTIC TANK AND DRY WELL. STAND PIPES MUST BE 6 INCHES IN DIAMETER. CAST IRON, CONCRETE OR TERRA COTTA ACCEPTED.

*INSTALLER IS RESPONSIBLE FOR OBTAINING FINAL APPROVAL ON THIS PERMIT.

BDDG. PERMIT SIGNED

AND RETURNED 6-24-89

Serial # 118942
deck

BDDG. PERMIT SIGNED

AND RETURNED 4/12/88

Serial # 19230
1 story addition

EH-2-1079


approved 10/19/82
Stayer P 32225

A 32053

BDDG. PERMIT SIGNED
AND RETURNED 3/21/01
Enclose ex. deck

A
32053

225
3
675

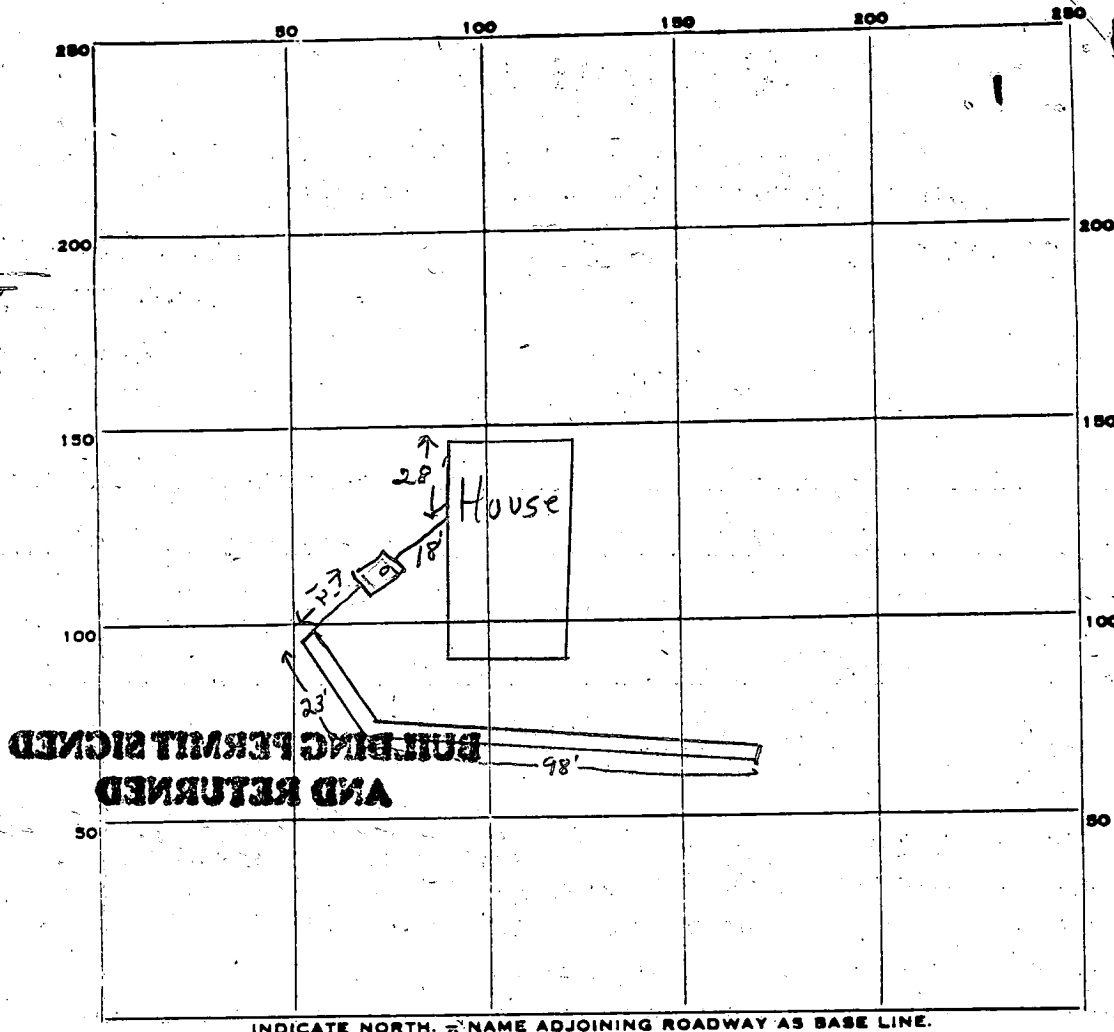

237
7
1611
490
651

PERMIT CARD ✓ signed W.S.C. F.S.

SEPTIC TANK, LEVEL ✓

CLEANOUTS 57
4

DISTRIBUTION BOX, LEVEL _____

TILE FIELD, DEPTH 10 FT. TRENCH WIDTH 2 FT.

GRAVEL DEPTH 5' avg. FT. IN. TOTAL LENGTH 121 FT.

NUMBER OF TRENCHES 1 ONE SIDE TOTAL BOTTOM AREA 651

SEEPAGE PITS, INSIDE DIAMETER _____ FT. DEPTH BELOW INLET _____ FT.

ABSORBENT AREA 651 SQ. FT.

REMARKS 10/18/82 OK to all garden to end spots to main water works for Bill Arnold; 3 ft of gravel to be under sign at far end for an area; gravel depth of 5 ft under pipe in 98 ft long section of trench. F.S.

10/19/82 OK to cover all work JS

DATE SYSTEM APPROVED 10/19/82

INSPECTOR Stayer

APPLICATION

SEWAGE DISPOSAL TESTING

STATE OF MARYLAND - DEPARTMENT OF HEALTH AND MENTAL HYGIENE

HOWARD COUNTY HEALTH DEPARTMENT
ENVIRONMENTAL HEALTH SERVICES

P. O. BOX 476 ELLICOTT CITY, MARYLAND 21043
TELEPHONE: 992-2330

DISTRICT

A 32053

P

3 B.R. 1000 gal. septic tank
4 B.R. 1250 gal. septic tank

DATE

7/27/82

192 SQ. FT. effective sidewall absorption area per bedroom to begin below the first 3 ft. of non-porous soil. Maximum depth permitted for drywell bottom is 10 ft. below original grade. Place the drywell 105 ft. from the front property line and 20 ft. from the right side line as seen when facing the property from Md. Rte. 144. Start the trench after a 5 foot earth buffer with the drywell and proceed to dig trench on level ground the necessary distance. Call for inspection of trench before placing gravel in trench.

TO: THE COUNTY HEALTH OFFICER

ELLICOTT CITY, MARYLAND

I, HEREBY, APPLY FOR THE NECESSARY TEST IN ORDER TO CONSTRUCT (OR RECONSTRUCT) A SEWAGE DISPOSAL SYSTEM.

PROPERTY OWNER ☒ Kenneth Douglas and Janice Faye Phebus

ADDRESS ☒ 2256 Florence Rd. Woodbine Md. 21797

PHONE ☒ 489-1611

PROPERTY LOCATION:

SUBDIVISION ☒ Stanley B. Miller

LOT NO. ☒ 26

ROAD AND DESCRIPTION ☒ Rt. 144 1/2 mile west of Rt. 91

16477 Route 144

SIZE OF LOT

TYPE BLDG.

3 Bedrooms
(NUMBER OF BEDROOMS)

THE SYSTEM INSTALLED UNDER THIS APPLICATION IS ACCEPTABLE ONLY UNTIL PUBLIC FACILITIES BECOME AVAILABLE. I FULLY UNDERSTAND THE

FEE CONNECTED WITH THE FILING OF THIS PERC TEST APPLICATION IS NON-REFUNDABLE UNDER ANY CIRCUMSTANCES. I ALSO AGREE TO COMPLY

WITH ALL M.O.S.H.A. REQUIREMENTS IN TESTING THIS LOT.

Kenneth Douglas Phebus
(SIGNATURE OF APPLICANT)

APPROVED BY

Frank Shinner

FOR

Drywell & trench

DATE

7/28/82

REJECTED BY

FOR

DATE

HOLD PENDING FURTHER TESTS

DATE

REASONS FOR REJECTION OR HOLDING

BLDG. PERMIT SIGNED

Howard County Health Dept.

AND RETURNED

P. O. Box 476


Serial # 57384

Ellicott City, Maryland 21043

THIS IS NOT A PERMIT

SOIL PROFILE

5246

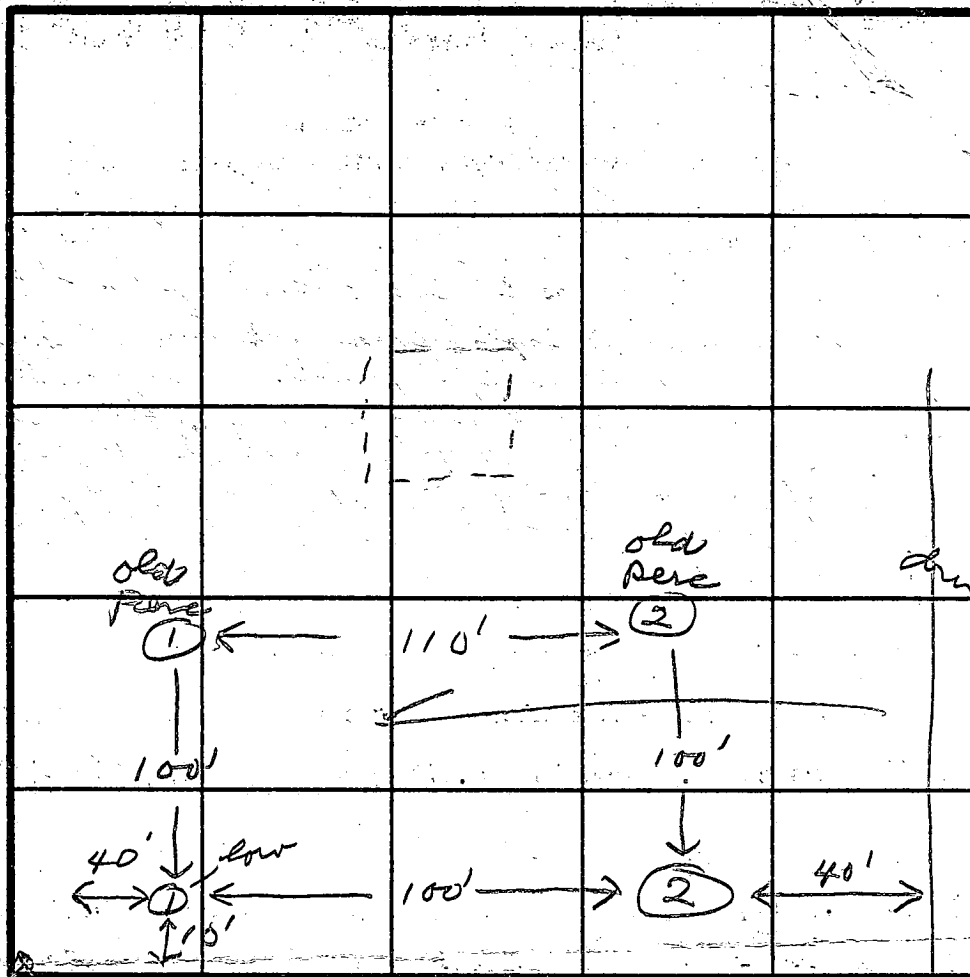

INDICATE NORTH - NAME ADJOINING ROADWAY AS BASE LINE.

RZ 144

[illegible]

REMARKS

TYPE OF SOIL

TESTED BY

ALSO PRESENT

B. Arnold

APPLICATION

A 22851

SEWAGE DISPOSAL TESTING

P _____

STATE OF MARYLAND - DEPARTMENT OF HEALTH AND MENTAL HYGIENE

HOWARD COUNTY HEALTH DEPARTMENT
ENVIRONMENTAL HEALTH SERVICES

3 B.R.

4 B.R.

DISTRICT

4

P. O. BOX 476, ELLICOTT CITY, MARYLAND 21043

TELEPHONE: 465-5000, EXT. 356

DATE 2/23/76

180 SQ. FT.

below the first 3 ft. of non-porous soil. effective side wall absorption area per bedroom to begin is 10 ft. below original grade. Place the drywell 190 ft. from the front property line and 15 ft. from the right side line, as seen when facing the property from Md. Rte. 144. Start the trench after a 5 foot left hand buffer with the drywell and proceed to dig it on level ground the necessary distance. NOTE: Call for inspection of trench before good is installed.

TO: THE COUNTY HEALTH OFFICER
ELLICOTT CITY, MARYLAND

I, HEREBY, APPLY FOR THE NECESSARY TEST IN ORDER TO CONSTRUCT (OR RECONSTRUCT) A SEWAGE DISPOSAL SYSTEM.

PROPERTY OWNER

Stanley B. Miller Jr.

Kenny Plebus

ADDRESS

2800 Florence Road Woodbine

PHONE

489-4382

PROPERTY LOCATION:

Route 144 One Mile West of Route 94

2941 Mc Henry Rd.

SUBDIVISION

Stanley Miller Property

LOT NO.

2256 McHenry Rd. Glenwood, Md. 16 B. new 26

ROAD AND DESCRIPTION

Route 144 one mile west of Lisbon

on left.

SIZE OF LOT

1.300 Acres +

TYPE BLDG.

Residential - 3

NUMBER OF BEDROOMS

IF NOT SINGLE RESIDENCE DESCRIBE _____

THE SYSTEM INSTALLED UNDER THIS APPLICATION IS ACCEPTABLE ONLY UNTIL PUBLIC FACILITIES BECOME AVAILABLE.

SIGNATURE OF APPLICANT

Stanley B. Miller Jr.

APPROVED BY

Frank Sheffer

FOR

Drywell & trench

DATE

1/11/78

(KIND OF SYSTEM)

REJECTED BY

FOR

DATE

(KIND OF SYSTEM)


HOLD PENDING FURTHER TESTS

hold for signed boundary plot

DATE

REASONS FOR REJECTION OR HOLDING _____

THIS IS NOT A PERMIT

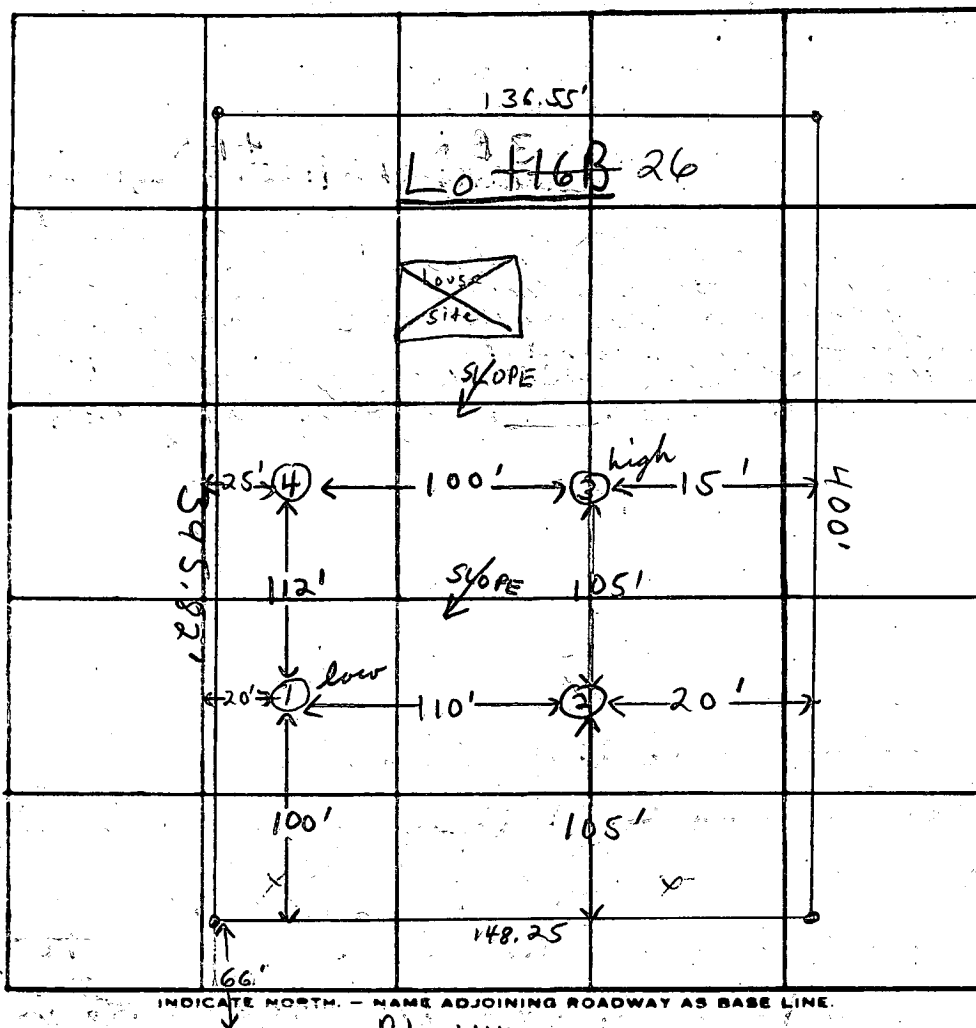

Rte 144

DATE	TEST NO.	DEPTH	PRE-WET		TEST - 1" DROP		TIME
			START	STOP	START	STOP	
2/26/76	1 low	4'	9:59	10:05	10:05	10:18	13min
	1A	12 1/2'	10:06	10:13	10:13	10:41	28 min
	2	4'	10:07	10:11	10:11	10:14	8 min
	2A	13'	10:04	10:25	10:25	10:52	27 min
	3 high	4 1/2'	10:23	10:26	10:26	10:31	4 min inlet 3'
	3A	13'	10:20	10:27	10:27	10:47	20 min
	4	4'	10:32	10:35	10:35	10:42	7 min
	4	10'	Clay to 3' silty loam 3-10' QUARTZ Boulders at 10 1/2'				

REMARKS inlet 3' max depth 11'

TYPE OF SOIL Silty loam below top ~ 3 clay

TESTED BY F.S.

ALSO PRESENT: S. Miller

DRILLER: OBTAIN HEALTH DEPT. APPROVAL AND RETURN ALL PARTS OF THIS FORM INTACT TO THE WATER RESOURCES ADMINISTRATION.

EMERGENCY NO. (If any) -

STATE OF MARYLAND

WATER RESOURCES ADMINISTRATION

TAWES STATE OFFICE BLDG., ANNAPOLIS, MARYLAND 21401

APPLICATION FOR PERMIT TO DRILL WELL

WRA PERMIT NUMBER

1073-3194

FILL IN THIS FORM COMPLETELY

DATE RECEIVED
(WRA USE ONLY)

4/2/79

9:30 A.M.

OWNER

COL 18 LAST NAME

Cheney

Kennedy

FIRST NAME

COL. 34

STREET OR RFD

COL 36

2941 McHenry Rd.

POST OFFICE

COL 56

Men Wood Ind.

COL. 55

COL. 76

CONTINUED

DRILLER INFORMATION

B 3

LOCATION OF WELL

1 2 3 (SEQ. NO.) 8

COUNTY

Howard

(DO NOT ABBREVIATE COUNTY NAME)

SUBDIVISION

Stanley Miller

SECTION

LOT

26

NEAREST TOWN

Lisbon

MILES FROM TOWN (ENTER 0 IF IN TOWN)

73

4.10

70 77 78

WELL INFORMATION

B 4

DIRECTION FROM TOWN
(CIRCLE APPROPRIATE BOX)

1 2 3 (SEQ. NO.) 0

N NORTH

E EAST

NE NORTHEAST

SE SOUTHEAST

S SOUTH

W WEST

NW NORTHWEST

SW SOUTHWEST

NEAR WHAT ROAD

144

ON WHICH SIDE OF ROAD
(CIRCLE APPROPRIATE BOX)

N

S

E

W

DISTANCE FROM ROAD
(ENTER DISTANCE AND CIRCLE APPROPRIATE BOX)

150

DRAW A SKETCH BELOW SHOWING LOCATION OF WELL IN RELATION TO NEARBY TOWN, ROADS AND STREAMS WITH NORTH IN THE DIRECTION OF THE ARROW, AND GIVE DISTANCE FROM WELL TO NEAREST ROAD JUNCTION OR STREAM CROSSING SHOWN ON THE SKETCH. ALSO SHOW, BY MEANS OF AN "X", THE WELL LOCATION IN THE BOX BELOW AND THE BOX NUMBER FROM THE WELL LOCATION MAP.

N

Sketch showing location of well in relation to nearby town, roads and streams. Includes handwritten notes: "144 144", "4/2/79", "3' 42" Well Head", "9' 2" Well Casing", "24 Bag of Cement", "C.B. V".

(1) No house plans (2) 1/2 Casing out of ground (3) No septic

BOX NUMBER: E 770, N 540

NORTH COORDINATE: 50 51 52 53 54 55
EAST COORDINATE: 57 58 59 60 61 62 63

ELEVATION AT WELL HEAD (FEET): 55 56 57 58 59 60 61 62 63

Notary Seal

METHOD OF DRILLING USED (CIRCLE APPROPRIATE METHOD)

BORED (OR AUGERED)

JETTED

DRIVEN

AIR PERCUSSION

AIR-PERCUSSION

ROTARY (HYDRAULIC ROTARY)

REVERSE-ROTARY

REVERSE-ROTARY

DRIVE-POINT

REPLACEMENT OR DEEPEMED WELLS (CIRCLE APPROPRIATE BOX)

- ☒ THIS WELL WILL NOT REPLACE AN EXISTING WELL
- ☐ THIS WELL WILL REPLACE A WELL THAT WILL BE ABANDONED AND SEALED
- ☐ THIS WELL WILL REPLACE A WELL THAT WILL BE USED AS A STANDBY
- ☐ THIS WELL WILL DEEPEMED AN EXISTING WELL

NOT TO BE FILLED IN BY DRILLER (WRA USE ONLY)

PERFORATION NUMBER: 04 05 06 100

HEALTH DEPARTMENT APPROVAL

Howard

W29576

COUNTY NAME

COUNTY NO.

Donald W. Monaghan, Sanitarian

B 1	4674	SEQUENCE NO. (WRA USE ONLY)	STATE OF MARYLAND WATER RESOURCES ADMINISTRATION TAWES STATE OFFICE BLDG., ANNAPOLIS, MARYLAND 21401 APPLICATION FOR PERMIT TO DRILL WELL	WRA PERMIT NUMBER 40 733194
1 2 3 (SEQ. NO.) 6 (THIS NUMBER IS TO BE PUNCHED IN COES. 3-6 ON ALL CARDS)			FILL IN THIS FORM COMPLETELY	

DATE RECEIVED (WRA USE ONLY)	OWNER <u>Phibbs</u> COL 15 LAST NAME	FIRST NAME <u>Kenny</u> COL. 34
	STREET OR RFD <u>2941 Matthews Rd.</u> COL 36	COL. 55
	POST OFFICE <u>Shore Wood Md.</u> COL 57	COL. 76

B 1	CONTINUED	DRILLER INFORMATION
1 2 3 (SEQ. NO.) 6		
DATE <u>May 13 1979</u>		LICENSE NUMBER <u>138</u> 77 80
FIRST NAME <u>Joseph H. Maurer</u>		LAST NAME <u>Maurer</u>
SIGNATURE <u>Joseph H. Maurer</u>		

B 3	CONTINUED	LOCATION OF WELL
1 2 3 (SEQ. NO.) 6		
COUNTY <u>Howard</u> (DO NOT ABBREVIATE COUNTY NAME)		21
SUBDIVISION <u>Stanley Miller</u>		23
SECTION <u>44</u>		LOT <u>5826</u> 48 50
NEAREST TOWN <u>Lisbon</u>		52
MILES FROM TOWN (ENTER 0 IF IN TOWN) <u>9.10</u>		73 76 77 78

B 2	CONTINUED	WELL INFORMATION
1 2 3 (SEQ. NO.) 6		
MAXIMUM PUMPING RATE (GALLONS PER MINUTE) <u>5</u>		8 12
AVERAGE DAILY QUANTITY NEEDED (GALLONS PER DAY) <u>750</u>		14 20
USE FOR WATER (CIRCLE APPROPRIATE BOX)		
☒ HOME (SINGLE OR DOUBLE HOUSEHOLD UNIT ONLY)		
☐ FARMING, AGRICULTURE, IRRIGATION		
☐ INDUSTRIAL, COMMERCIAL, STATE AND FEDERAL GOVERNMENT.		
☐ MUNICIPAL WATER SUPPLY		
☐ PRIVATE WATER COMPANY		
☐ TEST		
MUST HAVE STATE HEALTH DEPT. APPROVAL		

B 4	CONTINUED	DIRECTION FROM TOWN (CIRCLE APPROPRIATE BOX)
1 2 3 (SEQ. NO.) 6		
☐ N NORTH ☐ E EAST ☐ NE NORTHEAST ☐ SE SOUTHEAST ☐ S SOUTH ☒ W WEST ☐ NW NORTHWEST ☐ SW SOUTHWEST		
NEAR WHAT ROAD <u>MD 144</u>		
ON WHICH SIDE OF ROAD (CIRCLE APPROPRIATE BOX)		
☐ N NORTH ☒ S SOUTH ☐ E EAST ☐ W WEST		
DISTANCE FROM ROAD (ENTER DISTANCE AND CIRCLE APPROPRIATE BOX) <u>150</u>		
34 37 38 39		

APPROXIMATE DEPTH OF WELL <u>180</u>	FEET
APPROXIMATE DIAMETER OF WELL <u>6</u>	(NEAREST INCH)

METHOD OF DRILLING USED (CIRCLE APPROPRIATE METHOD)		
☒ BORED (OR AUGERED)	☐ JETTED	☐ DRIVEN
30-37 ☒ AIR-ROTARY	☐ AIR-PERCUSSION	☐ ROTARY (HYDRAULIC ROTARY)
☐ CABLE	☐ REVERSE-ROTARY	☐ DRIVE-POINT
OTHER (DESCRIBE)		

REPLACEMENT OR DEEPENED WELLS (CIRCLE APPROPRIATE BOX)	
☒ THIS WELL WILL NOT REPLACE AN EXISTING WELL	
☐ THIS WELL WILL REPLACE A WELL THAT WILL BE ABANDONED AND SEALED	
☐ THIS WELL WILL REPLACE A WELL THAT WILL BE USED AS A STANDBY	
☐ THIS WELL WILL DEEPEAN AN EXISTING WELL	
PERMIT NUMBER OF WELL TO BE REPLACED OR DEEPEANED (IF AVAILABLE)	

NOT TO BE FILLED IN BY DRILLER (WRA USE ONLY)	
APPROPRIATION PERMIT NUMBER	ENGINEER REVIEW DISTRICT NO.
FORCE	CONDITIONS

B 4	CONTINUED	HEALTH DEPARTMENT APPROVAL
1 2 3 (SEQ. NO.) 6		
DATE <u>031679</u>		APPROVED BY <u>Donald W. Monaghan, Sanitarian</u>
COUNTY NAME <u>Howard</u>		COUNTY NO. <u>W29576</u>

DRAW A SKETCH BELOW SHOWING LOCATION OF WELL IN RELATION TO NEARBY TOWNS, ROADS AND STREAMS WITH NORTH IN THE DIRECTION OF THE ARROW, AND GIVE DISTANCE FROM WELL TO NEAREST ROAD JUNCTION OR STREAM CROSSING SHOWN ON THE SKETCH. ALSO SHOW, BY MEANS OF AN "X", THE WELL LOCATION IN THE BOX BELOW AND THE BOX NUMBER FROM THE WELL LOCATION MAP.


N 	<table border="1" style="width:100%; border-collapse: collapse;"> <tr> <td style="width:50%;">BOX NUMBER</td> <td style="width:50%;">E</td> </tr> <tr> <td>N</td> <td>770</td> </tr> <tr> <td></td> <td>540</td> </tr> </table>	BOX NUMBER	E	N	770		540		
BOX NUMBER	E								
N	770								
	540								
<table border="1" style="width:100%; border-collapse: collapse;"> <tr> <td style="width:50%;">NORTH COORDINATE</td> <td style="width:50%;">EAST COORDINATE</td> </tr> <tr> <td>50 51 52 53 54 55</td> <td>57 58 59 60 61 62 63</td> </tr> <tr> <td>ELEVATION AT WELL HEAD (FEET)</td> <td></td> </tr> <tr> <td>65 66 67 68</td> <td></td> </tr> </table>		NORTH COORDINATE	EAST COORDINATE	50 51 52 53 54 55	57 58 59 60 61 62 63	ELEVATION AT WELL HEAD (FEET)		65 66 67 68	
NORTH COORDINATE	EAST COORDINATE								
50 51 52 53 54 55	57 58 59 60 61 62 63								
ELEVATION AT WELL HEAD (FEET)									
65 66 67 68									

B 5	CONTINUED	SPECIAL CONDITIONS 8-63 (WRA USE ONLY)
1 2 3 (SEQ. NO.) 6		

C 1 5167		SEQUENCE NO. (WRA USE ONLY)		STATE OF MARYLAND WATER RESOURCES ADMINISTRATION TAWES STATE OFFICE BLDG., ANNAPOLIS, MD. 21401 WELL COMPLETION REPORT		THIS REPORT MUST BE SUBMITTED WITHIN 30 DAYS AFTER WELL IS COMPLETE FILL IN THIS FORM COMPLETELY COUNTY: 01 NUMBER: 2	
DATE RECEIVED (WRA USE ONLY)		DATE WELL COMPLETED Apr 2, 1979		DEPTH OF WELL 260 22 (TO NEAREST FOOT) 26		PERMIT NO. FROM "PERMIT TO DRILL WELL" 40-73-3394 28 29 30 31 32 33 34 35 36 37	
OWNER John Jones LAST NAME		FIRST NAME John		STREET OR RFD 3941 McHenry Rd.		POST OFFICE St. Charles	
WELL LOG STATE THE KIND OF FORMATIONS PENETRATED, THEIR COLOR, DEPTH, THICKNESS AND IF WATER BEARING		WELL DESCRIPTION WELL HAS BEEN GROUTED (CIRCLE APPROPRIATE BOX) Y N TYPE OF GROUTING MATERIAL (CIRCLE BOX) C M B C CEMENT 45-46 BENTONITE CLAY 45 46 NO. OF BAGS 24 NO. OF POUNDS 2256 GALLONS OF WATER 144 DEPTH OF GROUT SEAL (TO NEAREST FOOT) FROM 0 FT. TO 60 FT. (ENTER 0 IF FROM SURFACE)		PUMPING TEST HOURS PUMPED (TO NEAREST HOUR) 8 PUMPING RATE (GALLONS PER MINUTE TO NEAREST GALLON) 2 METHOD USED TO MEASURE PUMPING RATE W WATER LEVEL: (DISTANCE FROM LAND SURFACE) BEFORE PUMPING 40 (NEAREST FOOT) WHEN PUMPING 5 (NEAREST FOOT) TYPE OF PUMPED USED (CIRCLE APPROPRIATE BOX) (FOR PUMPING TEST) A AIR P PISTON T TURBINE C CENTRIFUGAL R ROTARY O OTHER (DESCRIBE BELOW) J JET S SUBMERSIBLE			
DESCRIPTION (USE ADDITIONAL SHEETS IF NECESSARY) Green Shale 0-45 Sand 45-89 Blue Rock 89-260 ft.		FEET FROM TO CHECK IF WATER BEARING		CASING RECORD INSERT APPROPRIATE CODE BELOW S STEEL C CONCRETE P PLASTIC O OTHER MAIN CASING TYPE S T C P O NOMINAL DIAMETER TOP (MAIN) CASING (NEAREST INCH) 6 TOTAL DEPTH OF MAIN CASING (NEAREST FOOT) 92		OTHER CASING (IF USED) DIAMETER (INCH) DEPTH (FEET) FROM TO EACH CASING	
SCREEN TYPE OR OPEN HOLE INSERT APPROPRIATE CODE BELOW S STEEL B BRASS OR BRONZE H OPEN HOLE P PLASTIC O OTHER		SCREEN RECORD C 2 1 2 3 (SEQ. NO.) 6 DEPTH (NEAREST WHOLE FOOT) FROM TO 40 10 260 7 8 9 100		PUMP INSTALLED TYPE OF PUMP (WRITE APPROPRIATE LETTER IN BOX - SEE ABOVE: A, C, J, P, R, S, T, O) DRILLER WILL INSTALL PUMP (CIRCLE APPROPRIATE BOX) Y N CAPACITY: GALLONS PER MINUTE (TO NEAREST GALLON) 31 PUMP HORSE POWER 37 PUMP COLUMN LENGTH (NEAREST FOOT) 43			
CIRCLE APPROPRIATE BOXES A A WELL WAS ABANDONED AND SEALED WHEN THIS WELL WAS COMPLETED E ELECTRIC LOG OBTAINED P TEST WELL CONVERTED TO PRODUCTION WELL I HEREBY CERTIFY THAT I HAVE COMPLIED WITH ALL CONDITIONS STATED ON THE ABOVE-CAPTIONED "PERMIT TO DRILL WELL", AND THAT INFORMATION CONTAINED IN THIS REPORT IS TRUE, ACCURATE, AND COMPLETE TO THE BEST OF MY KNOWLEDGE, INFORMATION AND BELIEF. DRILLERS NAME Joseph L. Mayne (PLEASE PRINT) Joseph L. Mayne SIGNATURE Joseph L. Mayne		CASING HEIGHT (CIRCLE APPROPRIATE BOX AND ENTER CASING HEIGHT) + ABOVE - BELOW LAND SURFACE (NEAREST FOOT) 2 LOCATION OF WELL ON LOT SHOW PERMANENT STRUCTURE SUCH AS BUILDINGS, SEPTIC TANKS, AND/OR OTHER LAND MARKS AND INDICATE NOT LESS THAN TWO DISTANCES (MEASUREMENTS TO WELL). 		WRA USE ONLY (NOT TO BE FILLED IN BY DRILLER) (E.R.O.S.) W Q 70 72 74 75 76 TELESCOPE CASING LOG INDICATOR OTHER DATA AVAILABLE			

EXAMPLE - NO SCALE
Submit 3 copies

MLR 144 Road

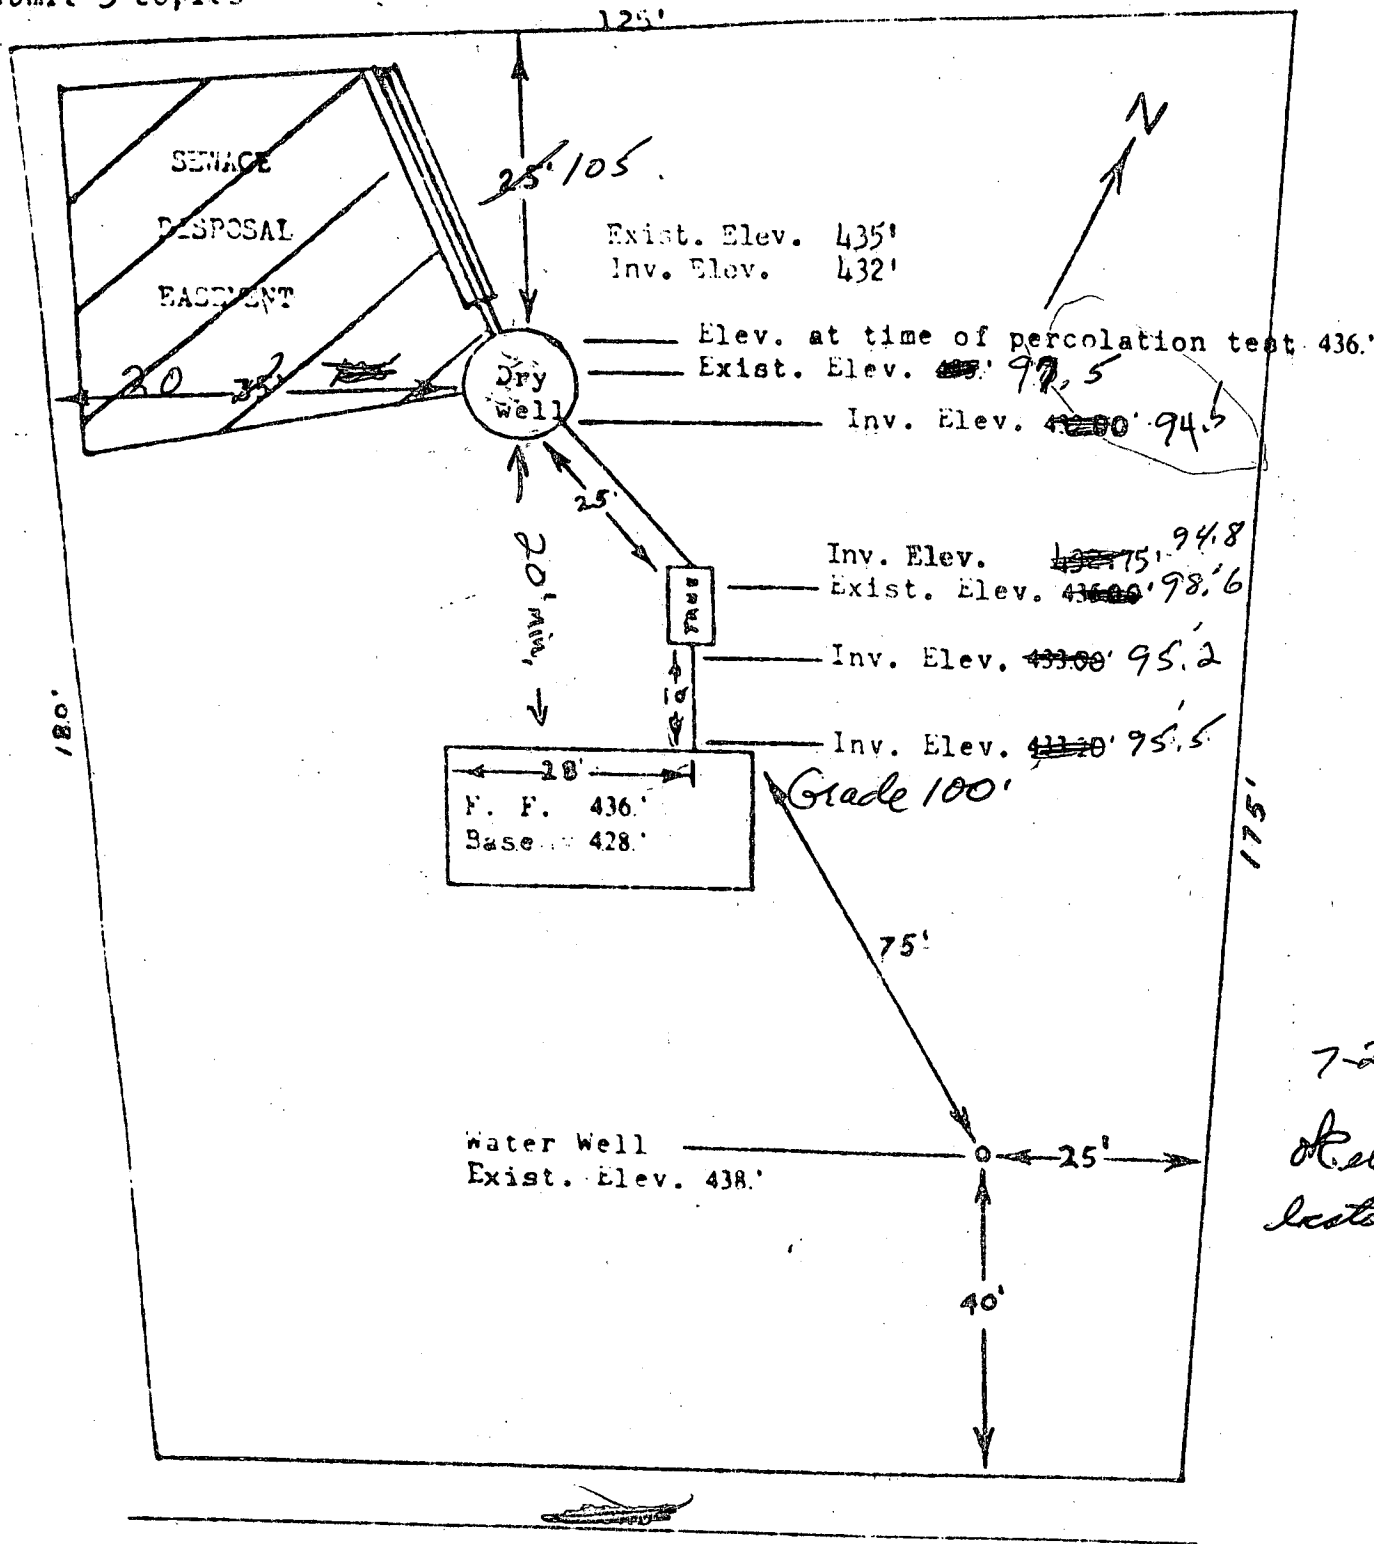

CERTIFY THE ABOVE MEASUREMENTS AND ELEVATIONS ARE ACTUAL & CORRECT FOR THIS PROPERTY.

SIGNED: *Kenneth D. Reber*

IRENEATH PHEBUS
2256 FLORENCE RD
WOODBINE MD.

136.55

BOUNDARY

111'

395'-1

70'

44x28'
HOUSE

50.5

20x26'
CARPORT

DRIVEWAY

400'


220'

148.25

EXISTING DRIVEWAY
CLEAR


16477 RT 144 LOT 26

INT. 144

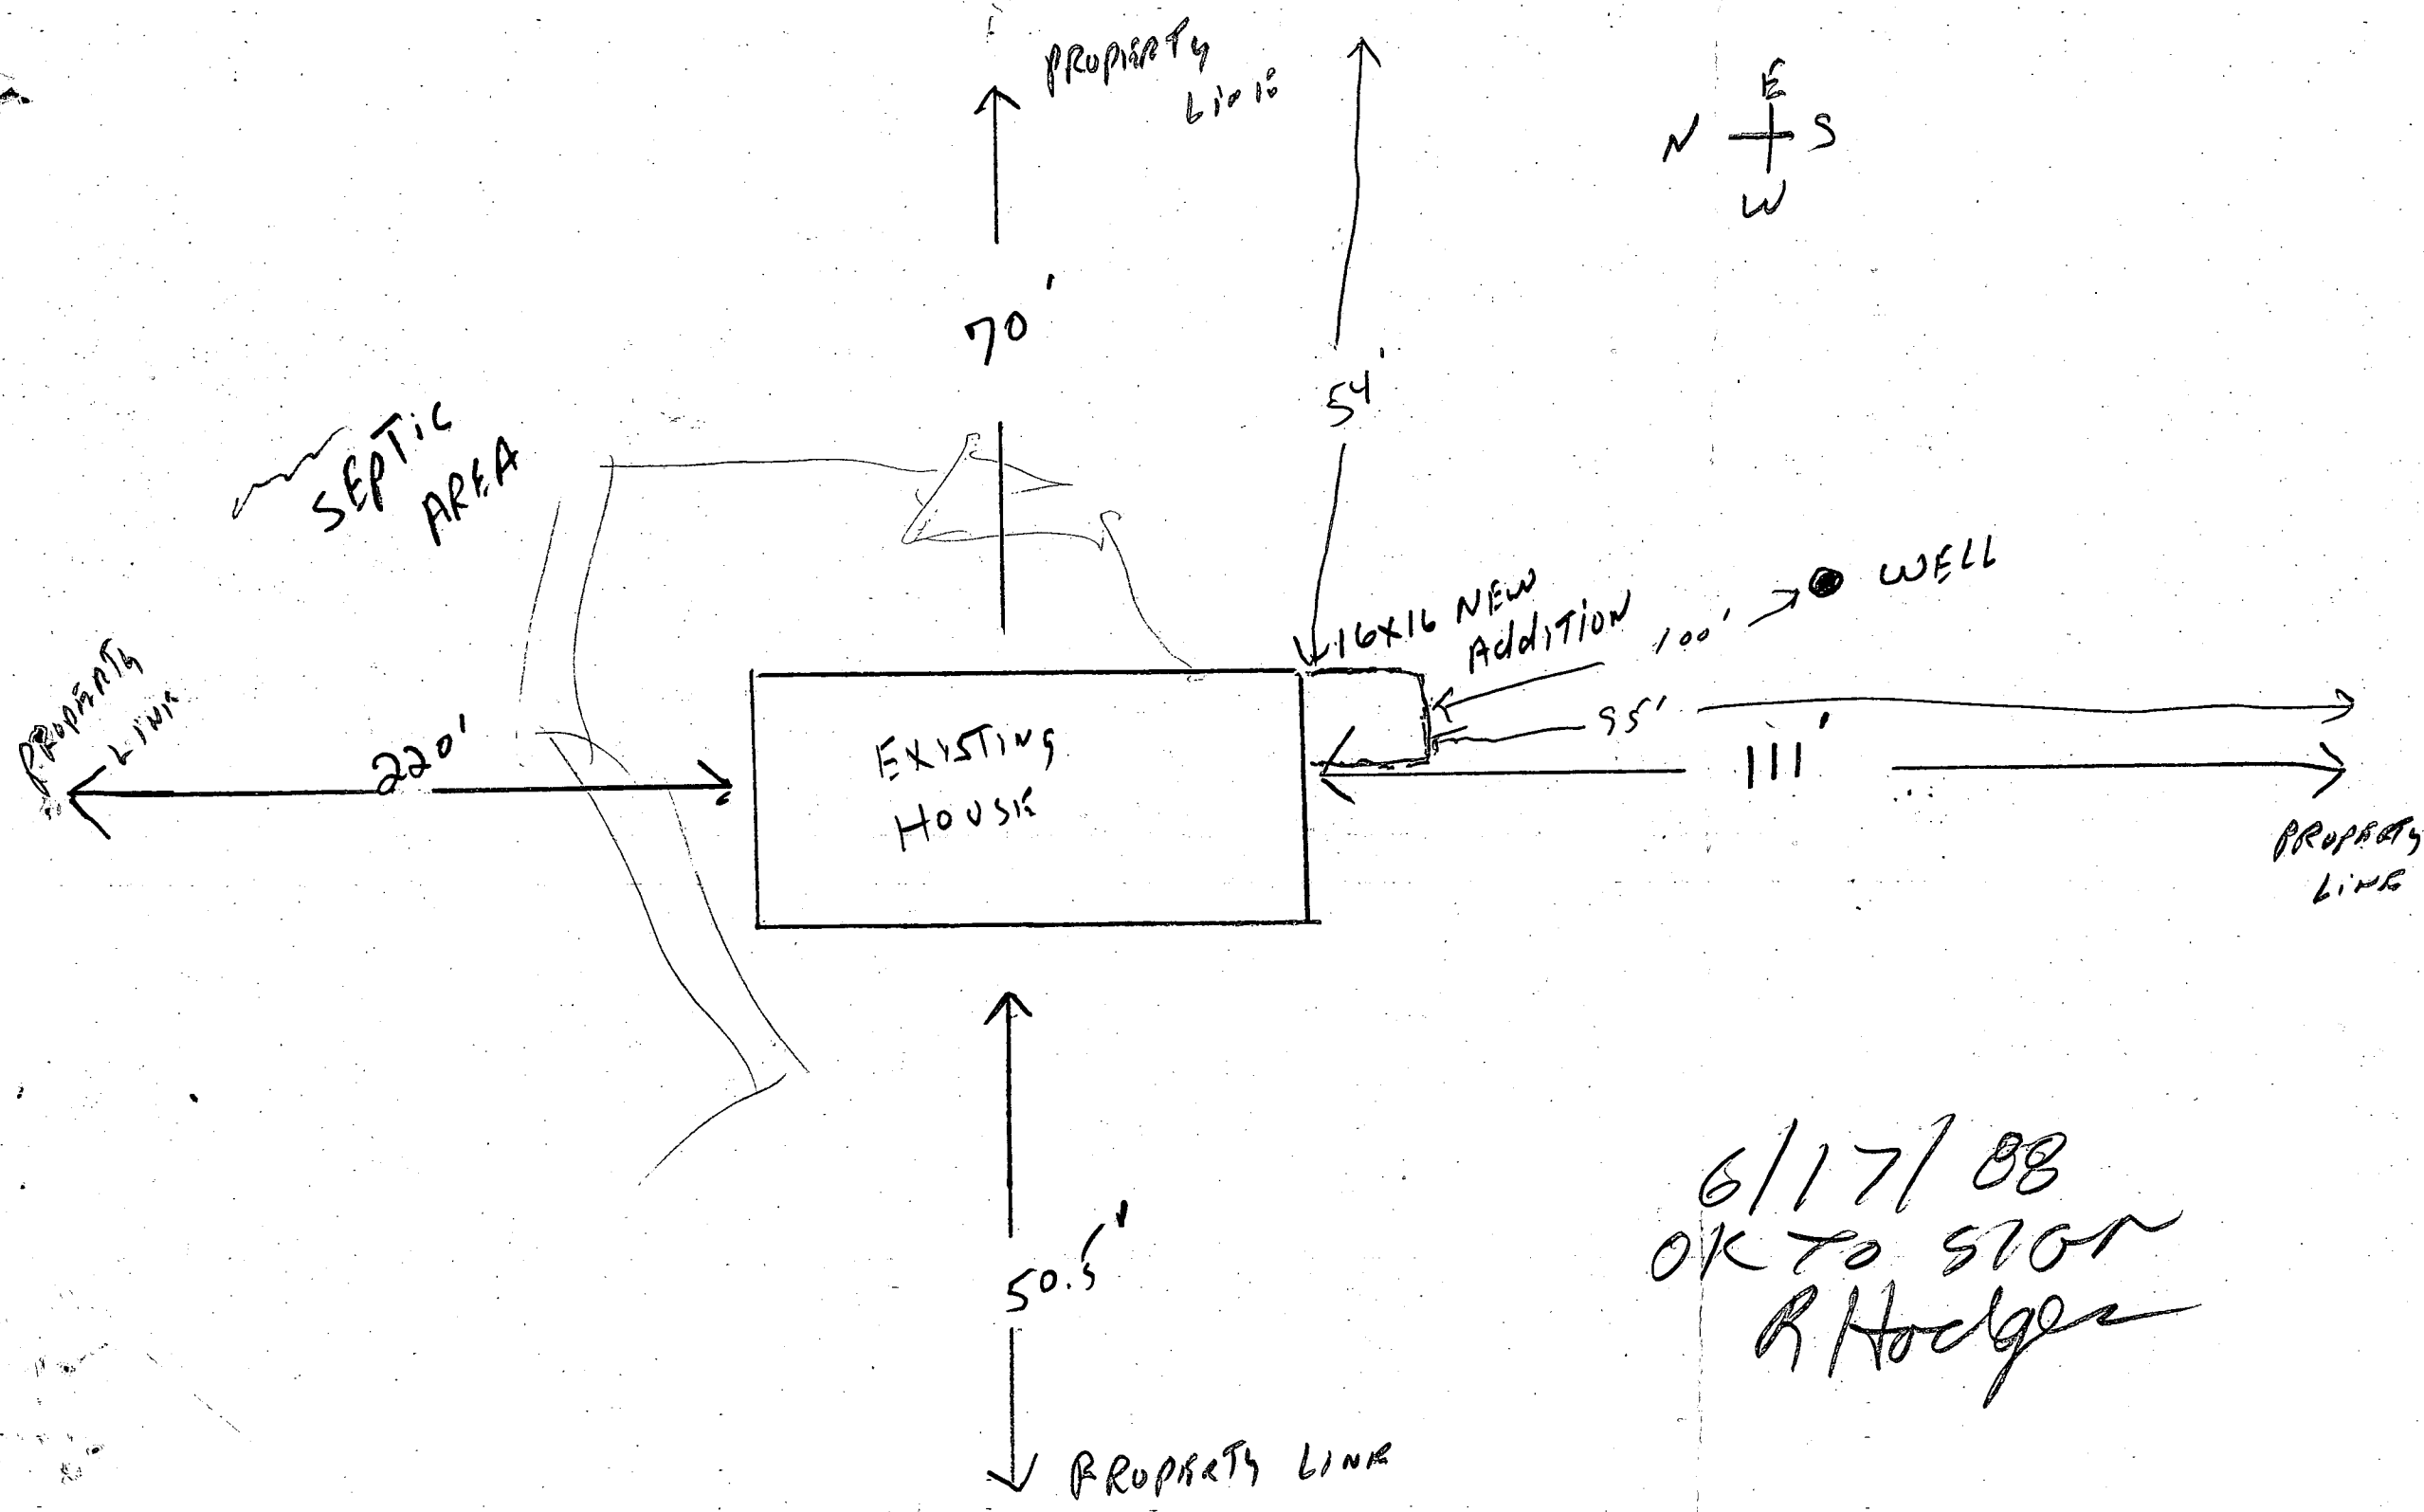

6/17/88
OK TO SIGN
R. Hodges

32053

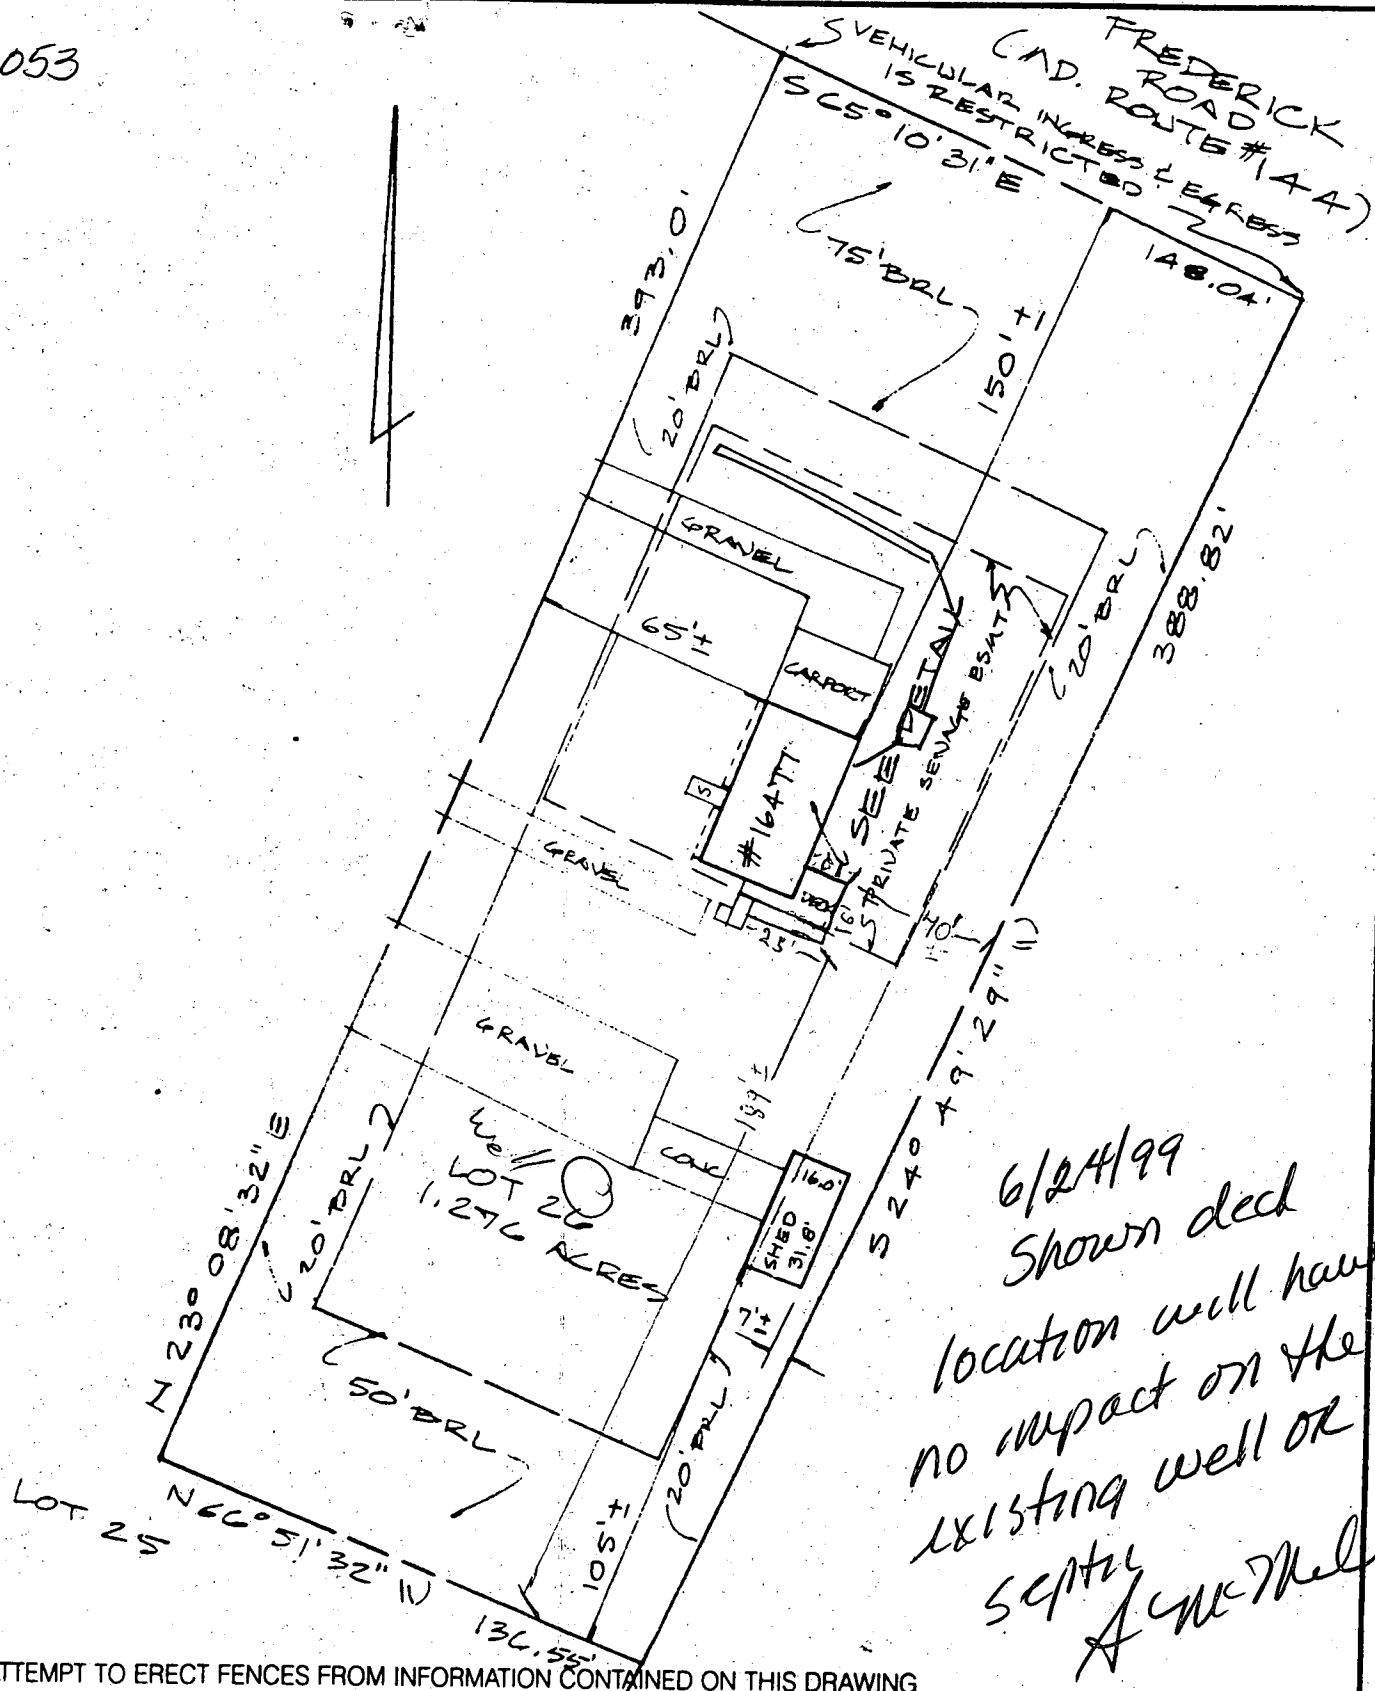

6/24/99
Shown deed
location well have
no impact on the
existing well or
septic
A. McNeill

DO NOT ATTEMPT TO ERECT FENCES FROM INFORMATION CONTAINED ON THIS DRAWING

HOUSE LOCATION SURVEY

LOT 26 16477 FREDERICK ROAD (RT. #144)
RESUBDIVISION OF LOT 16 PART OF PARCEL B2
LAT 3799 HOWARD COUNTY MARYLAND

Date 11/8/94	Sheet 1
Drawn DEN	
Checked CAW	Of 1
Scale 1" = 50'	Project No. 941439

3/16/01
 Enclosing ex. deck
 by Gump & Co.



SURVEYOR'S CERTIFICATION

I hereby certify to best of my knowledge and belief that the property delineated hereon is in accordance with the Plat of Subdivision and/or deed of record, that the improvements were located by accepted field practices and include permanent visible structure and encroachments, if any. This Plat is not for determining property lines, but prepared for the exclusive use of present owners of property and also those who purchase, mortgage, or guarantee the title thereto, within six months from the date hereof, and as to them I warrant the accuracy of this Plat. No title report furnished. NOTE: EXISTENCE OF PROPERTY CORNERS NOT GUARANTEED BY THIS PLAT.

MD Reg. Professional Land Surveyor No. 5216
 Jefferson D. Lawrence


NOT IN FLOOD PLAN PER EXISTING RECORDS UNLESS OTHERWISE NOTED.

O'CONNELL & LAWRENCE, INC.
 SURVEYORS, ENGINEERS & LANDPLANNERS
 17904 Georgia Avenue, Olney, Maryland 20832
 (301) 924-4573 • FAX (301) 924-5872

DO NOT ATTEMPT TO ERECT FENCES FROM INFORMATION CONTAINED ON THIS DRAWING

HOUSE LOCATION SURVEY
 LOT 26 16477 FREDERICK ROAD (RT. #144)
 A RESUBDIVISION OF LOT 16 PART OF PARCEL-B2
 PLAT 3799 HOWARD COUNTY MARYLAND

Date 11/8/94	Sheet 1
Drawn DEN	
Checked CAW	Of 1
Scale 1" = 50'	Project No. 94-14-39

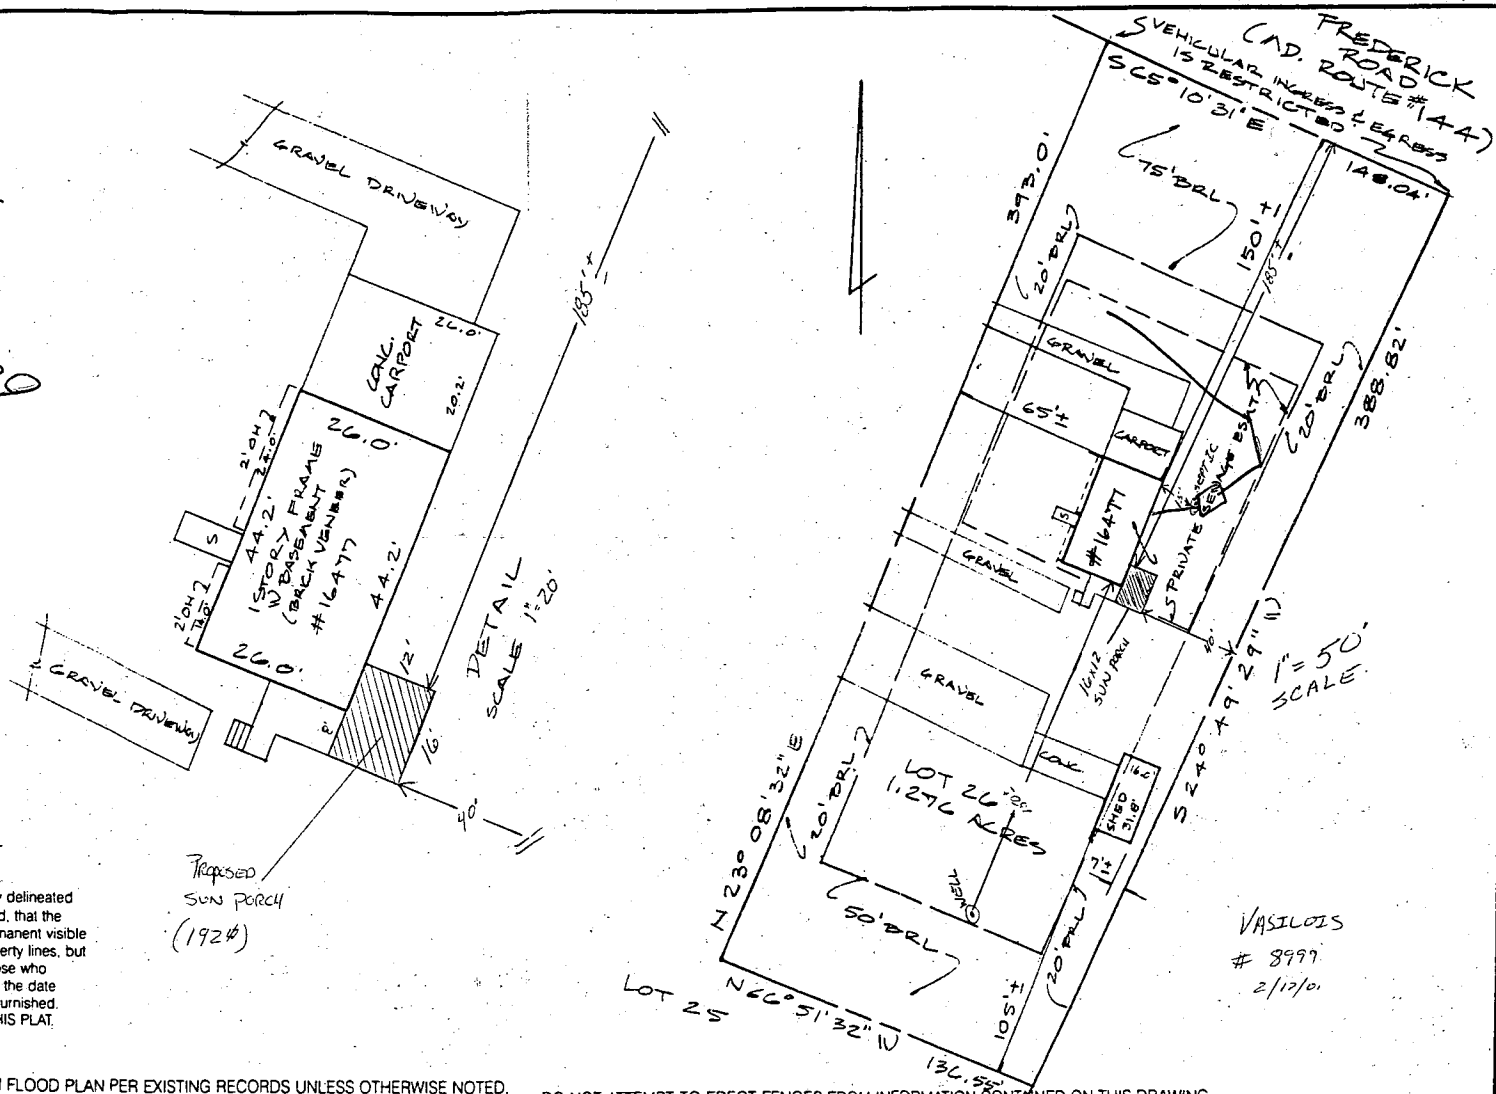

VASILEOIS
 # 8997
 2/12/01


Date 11/8/94	Sheet 1
Drawn DEW	Of 1
Checked CAW	
Scale 1" = 50'	Project No. 94-1439

SITE INSPECTION SHEET

OWNER: Mr. Galiatsatos PHONE #: _____
 ADDRESS: 16477 Frederick Rd CONTRACTOR: _____
Goodbine MI WELL TAG #: 73-3194
 SUBDIVISION: Miller LOT: _____ COUNTY #: _____
 PROPOSAL: Carport to garage w/ 2nd floor to increase the size of the
Master bedroom. Existing structure is to remain 4 bedroom

LOCATION DIAGRAM

Route 144

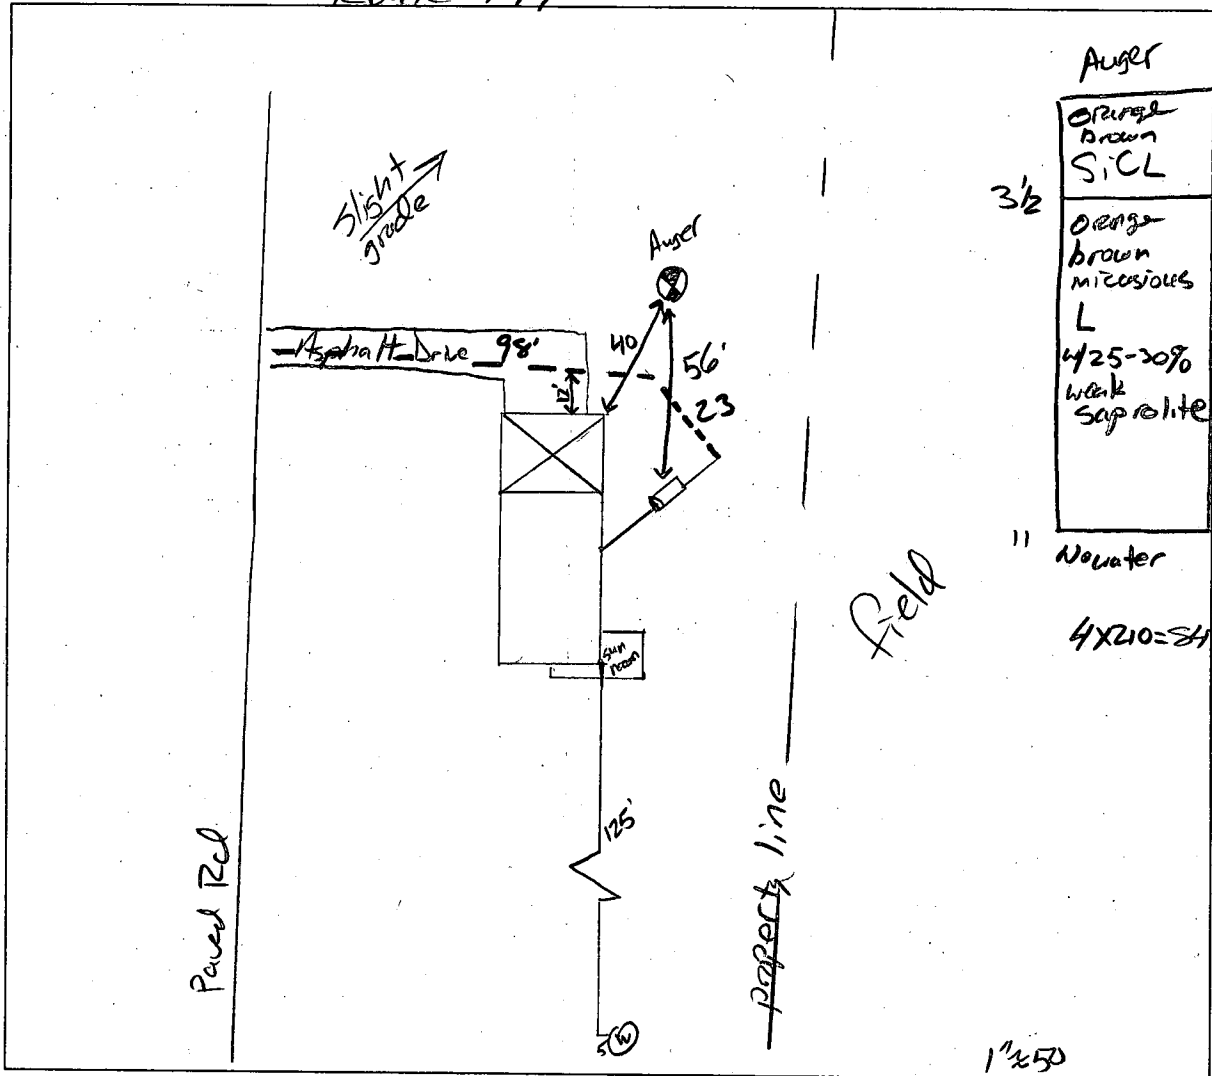


Auger
 Orange
 Brown
 SiCL
 3 1/2
 Orange
 brown
 micaceous
 L
 4/25-30%
 weak
 saprolite
 8-15
 perc
 rate
 3 1/2 (35)
 7'
 " No water
 4x210=840=3-280x45=
 126' req'd

COMMENTS: No features are to be dug. Existing topo slopes away from
existing carport.

DATE: 6/25/03

INSPECTOR: J. Allen

4/24/04
 GARAGE location
 OK (KB)

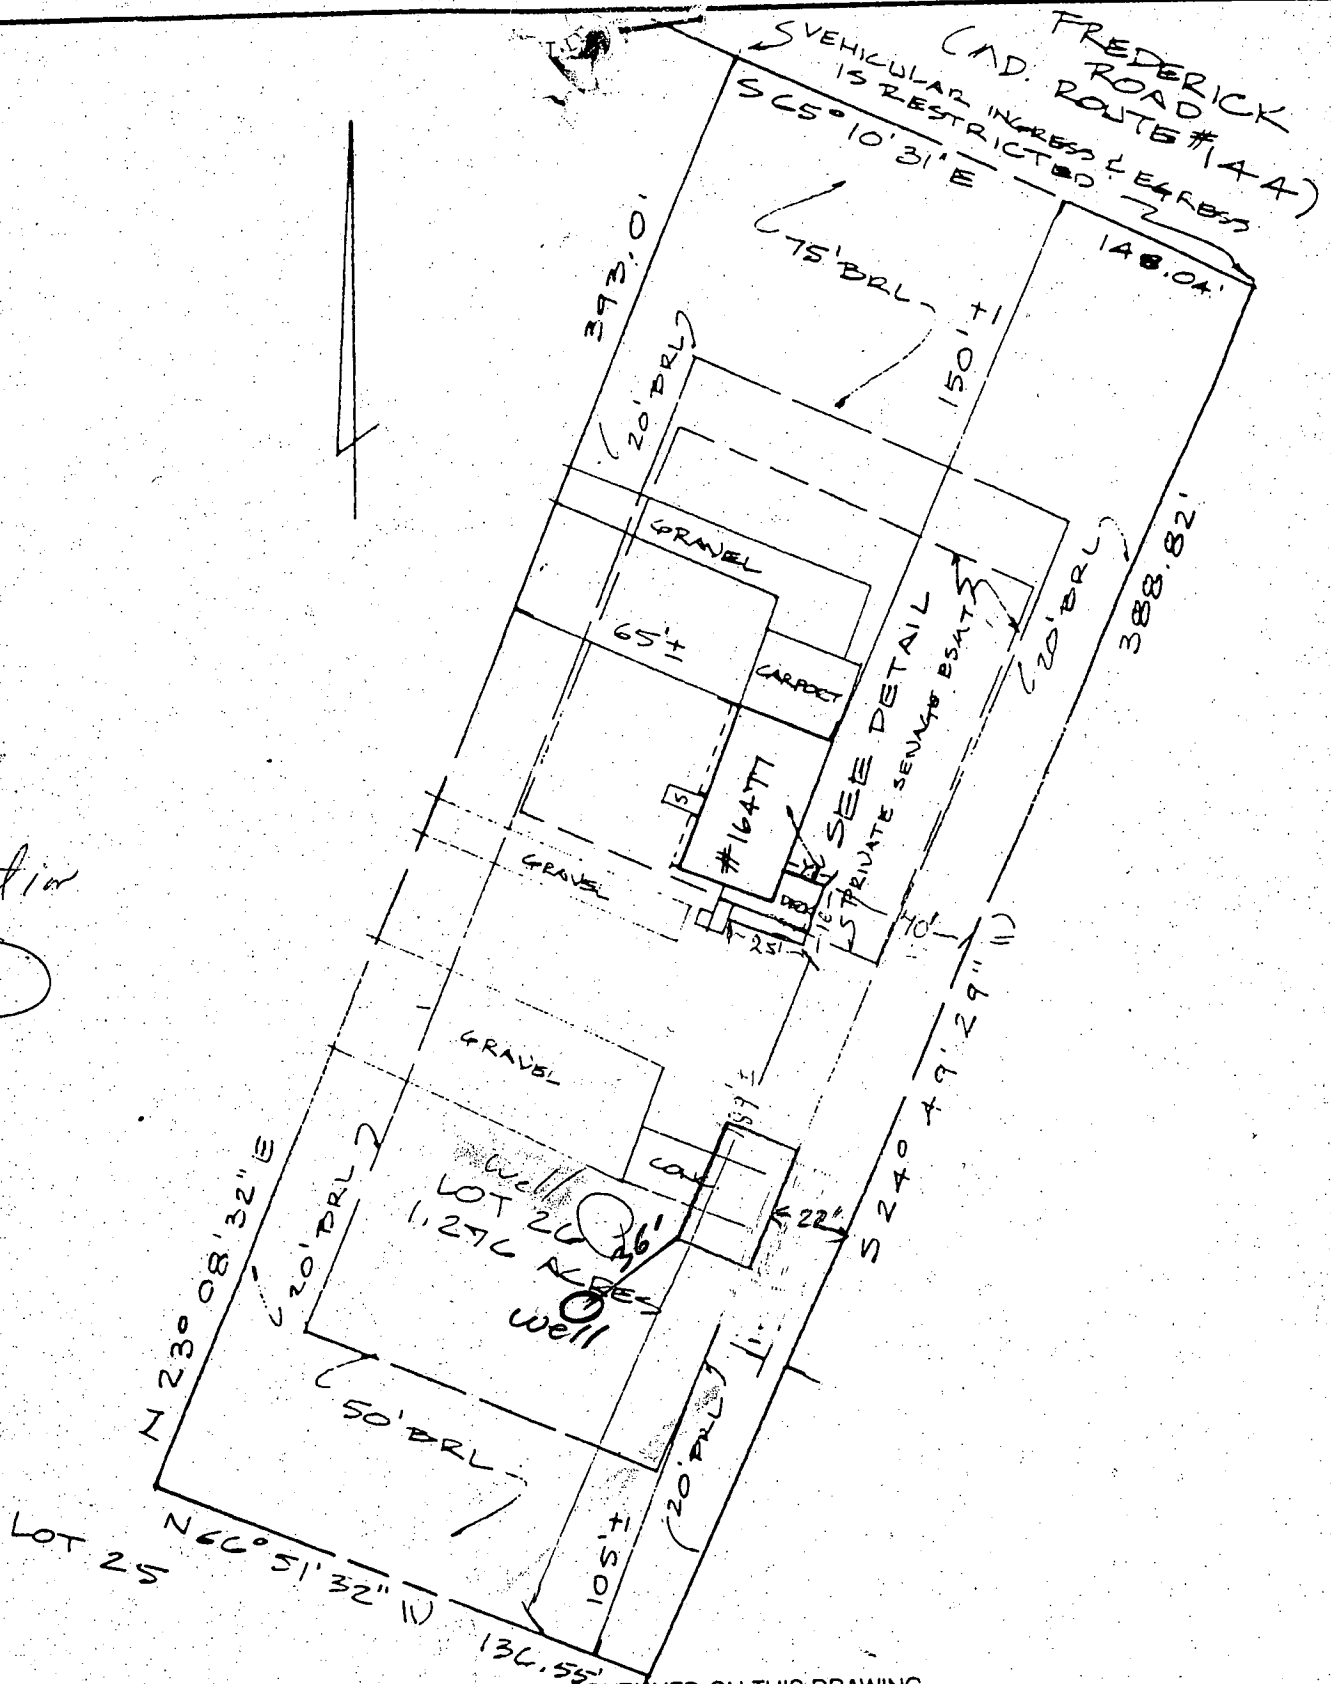

DO NOT ATTEMPT TO ERECT FENCES FROM INFORMATION CONTAINED ON THIS DRAWING

HOUSE LOCATION SURVEY

LOT 26 16477 FREDERICK ROAD (RT. #144)
 RESUBDIVISION OF LOT 16 PART OF PARCEL B2
 LAT 3799 HOWARD COUNTY MARYLAND

Date 11/8/94	Sheet 1
Drawn DEN	
Checked CAW	Of 1
Scale 1" = 50'	Project No. 941439