

3-17-87
144M
3-18-87
AM KAP

PERMIT

SEWAGE DISPOSAL SYSTEM

MARYLAND STATE DEPARTMENT OF HEALTH

HOWARD COUNTY
BUREAU OF ENVIRONMENTAL HEALTH
461-9933

05-393515

P 38853

A 32181

DISTRICT 5th

DATE 3/5/87

DATE SYSTEM APPROVED 3-18-87

INSPECTOR S. Abel

INDEXED

Jack Fyock

IS PERMITTED TO INSTALL X ALTER

ADDRESS PHONE 988-9270

SUBDIVISION Jocelyn Acres ROAD 13428 Rich Lynn Court LOT 4

PROPERTY OWNER Earl Boothe

ADDRESS

IF GARBAGE GRINDER IS USED INCREASE SEPTIC TANK CAPACITY BY 50% AND ABSORPTION AREA BY 22%.

GARBAGE GRINDER? YES NO X

SEPTIC TANK CAPACITY 1250 GALLONS NUMBER OF BEDROOMS 4

TRENCHES - 300 sq. ft. per bedroom. Trench to be 2 feet wide. Inlet 5 feet below original grade. Bottom maximum depth 11 feet below original grade. Effective area begins at 5 feet below original grade. 6 feet of stone below distribution pipe.

LOCATION - Place the distribution box 75 feet from the back (418.46') lot line and 145 feet from the left lot line as seen when facing the lot from Rich Lynn Court. Run trenches on contour toward the right lot line.

NOTE - No trench to exceed 100 feet in length. Provide 6" - 8" diameter cleanout and cap to grade or above on septic tank.

Handwritten signature/initials

PLANS APPROVED BY S. Abel DATE 1/22/87

COVER NO WORK UNTIL INSPECTED AND APPROVED.

NEITHER THE HOWARD COUNTY COUNCIL NOR THE HEALTH DEPARTMENT IS RESPONSIBLE FOR THE SUCCESSFUL OPERATION OF ANY SYSTEM.

NOTE: CLEANOUT REQUIRED EVERY 70 FEET OF SEWER LINE AND/OR AT 90° SWEEPS IN LINES FROM HOUSE TO DRAIN FIELDS.

NOTE: ALL PARTS OF SEPTIC SYSTEMS (I.E., TANK, DISTRIBUTION BOX, TRENCHES) TO BE 100 FEET FROM WELL. (UNLESS OTHERWISE SPECIFICALLY AUTHORIZED)

NOTE: IF DEEP TRENCH(IES) ARE USED CALL FOR INSPECTION BEFORE AND AFTER PLACING GRAVEL IN TRENCH(IES).

NOTE: NO DRY WELL SHALL EXCEED 15 FOOT IN DIAMETER. NO ABSORPTION TRENCH TO EXCEED 100 FEET IN LENGTH.

NOTE: ALL PIPE FROM HOUSE TO SEPTIC TANK MUST BE CAST IRON OR SCHEDULE 40 PVC OR ABS.

PERMIT VOID AFTER TWO YEARS.

NOTE: INSTALL STAND PIPE ON SEPTIC TANK AND DRY WELL. STAND PIPES MUST BE 6 INCHES IN DIAMETER. CAST IRON, CONCRETE OR TERRA COTTA OR PVC OR ABS ACCEPTED. IF TOP OF SEPTIC TANK IS DEEPER THAN 3 FEET, MANHOLE TO GRADE REQUIRED.


NOTE: DISTRIBUTION BOXES MUST HAVE BAFFLES.

***INSTALLER IS RESPONSIBLE FOR OBTAINING FINAL APPROVAL ON THIS PERMIT**

*CALL 461-9933 FOR INSPECTION OF SEPTIC SYSTEMS.

EH - 2-1186

4632181

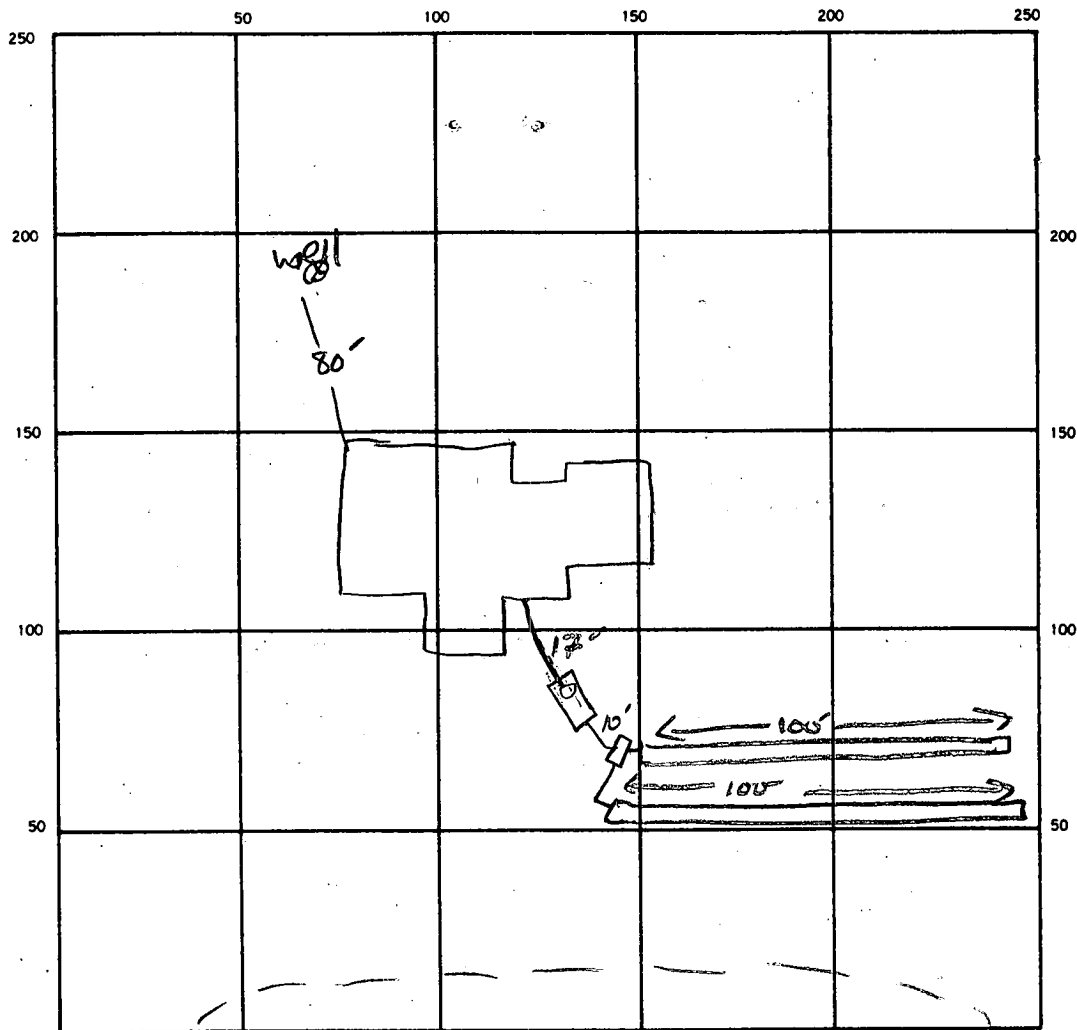

INDICATE NORTH. — NAME ADJOINING ROADWAY AS BASE LINE.

Quarry

SEPTIC TANK, LEVEL 1500 GAL ✓ CLEANOUTS ✓ ST

DISTRIBUTION BOX, LEVEL ✓

DRAIN TILE FIELD, DEPTH 8 FT. TRENCH WIDTH 2 FT. INLET DEPTH 2 FT.

EFFECTIVE GRAVEL DEPTH 6'-6" FT. TOTAL LENGTH 200 FT.

NUMBER OF TRENCHES 2 ONE SIDEWALL/BOTTOM AREA 1200 SQ. FT.

DRYWELL INSIDE DIAMETER — FT. EFFECTIVE DEPTH BELOW INLET — FT.

ABSORBENT AREA 1200 SQ. FT.

REMARKS PERC AREA AS INDICATED 1 - SHALLOW WATER TABLE ~ 7' IN MIDDLE OF AREA; Fill TO 8' IN
UPPER AREA. REPAIR AREA WILL HAVE TO BE FRONT LEFT AREA OF LOT AND WILL REQUIRE
PUMP SYST. MOUND REPAIR MAY BE NECESSARY. INSTALL SYST 2'-8' W 6" STONE
2-100' TRENCHES RUNNING TOWARD LEFT LOT LINE. Soils SEEN IN FIELD VS. WHAT IS
DESCRIBED IN PERC DATA ARE THE SAME

DATE SYSTEM APPROVED 3-18-87 INSPECTOR S. Abel

SUBDIVISION: Jorelyn AcresLOT NUMBER: 4DRY WELL OR DRY WELL AND TRENCH

	<u>Septic Tank</u>	<u>Minimum Total square Feet</u>
3 bedroom	1000 gallon	_____ sq. ft./bedroom
4 bedroom	1250 gallon	_____
5 bedroom	1500 gallon	_____

Inlet _____ feet below original grade.

Bottom maximum depth _____ feet below original grade.

Effective area begins at _____ feet below original grade.

NOTE: If trench is used to make up absorbent area, run the trench on level ground and leave a 5 foot earth buffer between dry well and trench. No trench is to exceed 100 feet in length. Trench inlet to be same as dry well, with _____ feet of stone below distribution pipe.


TRENCHES300 sq. ft./bedroomTrench to be 2 wide.Inlet 5 feet below original grade.Bottom maximum depth 11 feet below original grade.Effective area begins at 5 feet below original grade.6 feet of stone below distribution pipe.

- NOTE:
- (1) No trench to exceed 100 feet in length.
 - (2) If more than one trench used, a distribution box is required.
 - (3) Trenches to be installed on level ground.
 - (4) Call for inspection of trench before gravel is installed.
 - (5) Provide 6"-8" diameter cleanout and cap to grade or above on septic tank and drywell.
 - (6) If a Garbage disposal is used, increase septic tank capacity by 50% and increase absorbant sidewall area by 22%.

LOCATION: PLACE THE DISTRIBUTION BOX 75 FE FROM THE BACK (418.46') LOT
LINE AND 145 FE FROM THE LEFT LOT LINE AS SEEN WHEN FACING THE
LOT FROM KICET LYNN CT. RUN TRENCHES ON CONTOUR TOWARD THE RIGHT
LOT LINE, 1-22-87 S.A.W

B 1 4462 (THIS NUMBER IS TO BE PUNCHED IN COLS. 3-6 ON ALL CARDS)	SEQUENCE NO. (OEP USE ONLY) 8/15/86	STATE OF MARYLAND PERMIT TO DRILL WELL please print or type	OEP PERMIT NUMBER MO-81-1518 fill in this form completely
Date Received 11/10/86		B 3 LOCATION OF WELL 8 COUNTY 21 23 SUBDIVISION 42 SECTION 2 LOT 4 52 NEAREST TOWN 71 MILES FROM TOWN (enter 0 if in town) 3 73 76 77 78	
OWNER INFORMATION 15 Last Name 34 36 Street or RFD 55 57 Town 70 State 72 Zip 76		DRILLER INFORMATION Driller's Name 77 License No. 80 Firm Name Address Signature Date	
B 2 WELL INFORMATION APPROX. PUMPING RATE (GAL. PER MIN.) 5 8 12 AVERAGE DAILY QUANTITY NEEDED (GAL. PER DAY) 500 14 20		B 4 DIRECTION OF WELL FROM TOWN (CIRCLE BOX) LOCATION OF WELL 11 NEAR WHAT ROAD 30 ON WHICH SIDE OF ROAD (CIRCLE APPROPRIATE BOX) 34 37 DISTANCE FROM ROAD ENTER FT or MI 0 38 39	
USE FOR WATER (CIRCLE APPROPRIATE BOX) ☒ HOME (SINGLE OR DOUBLE HOUSEHOLD UNIT ONLY) ☐ FARMING (LIVESTOCK WATERING & AGRICULTURAL IRRIGATION) ☐ INDUSTRIAL, COMMERCIAL, STATE AND FEDERAL GOV. OTHER (REQUIRES APPROPRIATION PERMIT) ☐ PUBLIC OR PRIVATE WATER COMPANY (REQUIRES APPROPRIATION PERMIT AND STATE HEALTH DEPARTMENT APPROVAL) ☐ TEST, OBSERVATION, MONITORING (MAY REQUIRE APPROPRIATION PERMIT)		NOT TO BE FILLED IN BY DRILLER HEALTH DEPARTMENT APPROVAL COUNTY NAME OEP SIGNATURE DATE ISSUED NORTH GRID COUNTY NO. STATE HEALTH INSERT S CO-SIGNATURE EAST GRID	
APPROXIMATE DEPTH OF WELL 200 24 28 FEET APPROXIMATE DIAMETER OF WELL 6 NEAREST INCH		SHOW MAJOR FEATURES OF BOX & LOCATE WELL WITH AN X SOURCES OF DRILLING WATER 1. WELL 2. Filled dry 3. 7. days cement WRITE THE BOX NUMBER FROM THE MAP HERE E 806 5 N 406 5 000 000	
METHOD OF DRILLING (circle one) BORED (or Augered) ☒ AIR-ROTary ☐ CABLE JETTED ☐ AIR-PERCussion ☐ REVERSE-ROTary Jetted & DRIVEN ☐ ROTARY (Hydraulic Rotary) ☐ Drive-POINT		DRAW A SKETCH BELOW SHOWING LOCATION OF WELL IN RELATION TO NEARBY TOWNS AND ROADS AND GIVE DISTANCE FROM WELL TO NEAREST ROAD JUNCTION 	
REPLACEMENT OR DEEPEINED WELLS (CIRCLE APPROPRIATE BOX) ☒ THIS WELL WILL NOT REPLACE AN EXISTING WELL ☐ THIS WELL WILL REPLACE A WELL THAT WILL BE ABANDONED AND SEALED ☐ THIS WELL WILL REPLACE A WELL THAT WILL BE USED AS A STANDBY ☐ THIS WELL WILL DEEPEIN AN EXISTING WELL PERMIT NUMBER OF WELL TO BE REPLACED OR DEEPEINED (IF AVAILABLE) 41 52		Not to be filled in by driller (OEP USE ONLY) APPROP. PERMIT NUMBER 54 G A P 63 FORCE 57 68 WRITE INITIALS IN BOX PERMIT NO. 70 71 72 73 74 75 76 77 78 79	
SPECIAL CONDITIONS			

LOT 4
SECTION 3
RICH LYNN CRT.
SUBDIVISION: JOCELYN ACRES
HIGHLAND, MD.

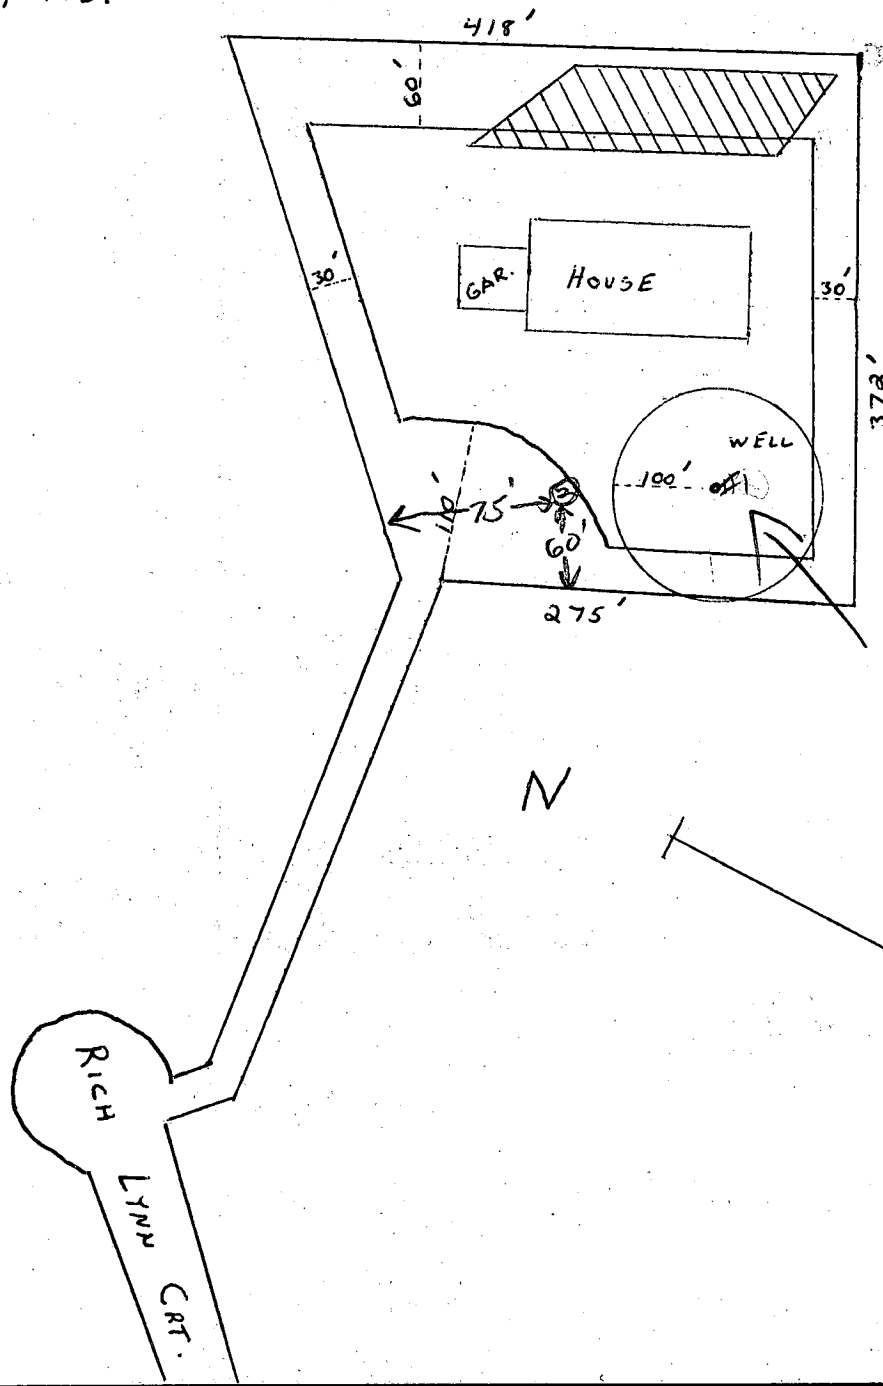

8/5/86
#1 well 240' deep
~1/2 gal water
#2 site OK'd per Tim Rzepkowski
7/17/86
well site OK'd
(BA)

APPLICATION

SEWAGE DISPOSAL TESTING

STATE OF MARYLAND - DEPARTMENT OF HEALTH AND MENTAL HYGIENE

HOWARD COUNTY HEALTH DEPARTMENT
ENVIRONMENTAL HEALTH SERVICES

P. O. BOX 473 ELLICOTT CITY, MARYLAND 21043
TELEPHONE: 992-2330

A 32181

P _____

DISTRICT 5th

DATE 9-16-82

TO: THE COUNTY HEALTH OFFICER
ELLICOTT CITY, MARYLAND

I, HEREBY, APPLY FOR THE NECESSARY TEST IN ORDER TO CONSTRUCT (OR RECONSTRUCT) A SEWAGE DISPOSAL SYSTEM.

PROPERTY OWNER RICHARD DEMMITT EARL BOOTHE

ADDRESS 9966 MARYLAND ROUTE 99 PHONE 465-4544

PROPERTY LOCATION: 13428 RICHLYNN CT.

SUBDIVISION JOCELYN ACRES, SECTION 3 LOT NO. 4

ROAD AND DESCRIPTION HIGHLAND ROAD, DIRECTLY ACROSS FROM ALLENUT LANE

SIZE OF LOT 3 ACRES TYPE BLDG. SINGLE FAMILY DWELLING
(NUMBER OF BEDROOMS)

THE SYSTEM INSTALLED UNDER THIS APPLICATION IS ACCEPTABLE ONLY UNTIL PUBLIC FACILITIES BECOME AVAILABLE. I FULLY UNDERSTAND THE
FEE CONNECTED WITH THE FILING OF THIS PERC TEST APPLICATION IS NON-REFUNDABLE UNDER ANY CIRCUMSTANCES. I ALSO AGREE TO COMPLY
WITH ALL M.O.S.H.A. REQUIREMENTS IN TESTING THIS LOT.

(SIGNATURE OF APPLICANT) Charles J. Cane Jr.

APPROVED BY Raymond Hodge FOR Drywell Hatcher DATE 9/30/83

REJECTED BY _____ FOR _____ DATE _____

HOLD PENDING FURTHER TESTS _____ DATE _____

REASONS FOR REJECTION OR HOLDING 10/5/82 DIG MORE SLOW PERC. & MORE HOLES

NEEDED RHT. 10/6/82 DIG MORE SLOW PERC. & ILLEGAL POTHOLES
MORE HOLES DEEPER VISUAL HOLES RHT'S.
10/28/82 DEEP HOLE #6 DUG 11/22/82 FS SAID OK

THIS IS NOT A PERMIT

9/30/83 Spec Written BH

SOIL PROFILE


BROWN
FILL

DARK
GRAY
BROWN
CLAYISH
SAND
SMALL
ROCK

BLACK
BROWN
FILL

GRAY
BROWN
CLAY
SAND
MIX

BROWN
SAND

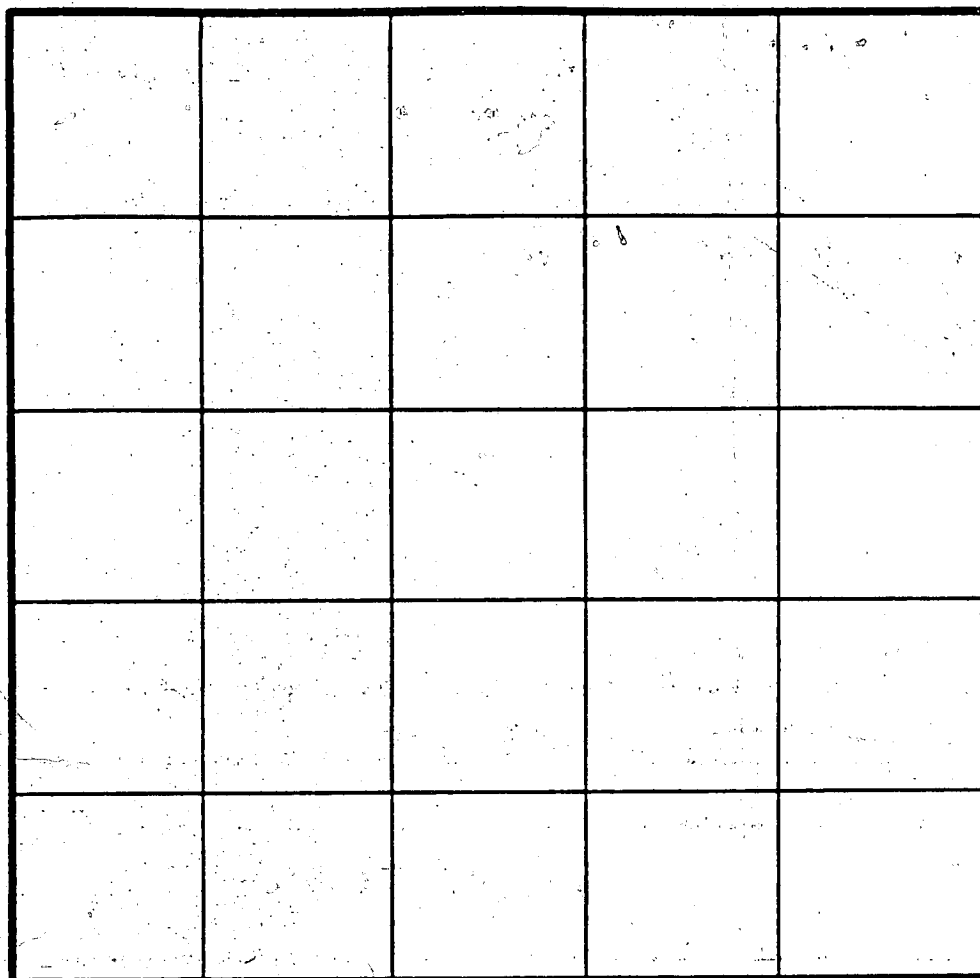

INDICATE NORTH - NAME ADJOINING ROADWAY AS BASE LINE.

DATE	TEST NO.	DEPTH	PRE-WET		TEST - 1" DROP		TIME
			START	STOP	START	STOP	
10/6/82	2ED	9	1228	1233	1233	1253	20
	2ES	5	1229	1253	1253	105	13
	4FS	7 1/2	146	126	126	40	
	5V	12	SEE SOIL PROFILE LOOKS UNSATISFACTORY				
10/6/82	6V	11 1/2	SEE SOIL PROFILE LOOKS DOUBT FULL				
	4ED	11	1037	1041	1041	1046	5
	4EM	8 1/2	1038	1100	1100	1144	44
	6S	4	1102	1109	1109	1125	16
	6D	8	1056	1124	1124	1240	1240
	1EV	14	VISUAL HOLE DEEPENED LOOKS OK SEE PROFILE				
	3EV	18	VISUAL HOLE DEEPENED LOOKS OK SEE PROFILE				
	4EV	19	VISUAL HOLE DEEPENED LOOKS OK				

REMARKS

TYPE OF SOIL

TESTED BY

ALSO PRESENT

OPHD = observed pot hole digging
(5) & (6) UNSATISFACTORY 10/6/82

10/27/82 Deep hole 24" @ 6" reg 2 FS

APPLICATION

SEWAGE DISPOSAL TESTING

STATE OF MARYLAND - DEPARTMENT OF HEALTH AND MENTAL HYGIENE

HOWARD COUNTY HEALTH DEPARTMENT
ENVIRONMENTAL HEALTH SERVICES

P.O. BOX 473 ELLICOTT CITY, MARYLAND 21043
TELEPHONE: 992-2330

A 32181

P _____

DISTRICT 5th

DATE 9-16-82

TO: THE COUNTY HEALTH OFFICER
ELLICOTT CITY, MARYLAND

I, HEREBY, APPLY FOR THE NECESSARY TEST IN ORDER TO CONSTRUCT (OR RECONSTRUCT) A SEWAGE DISPOSAL SYSTEM.

PROPERTY OWNER RICHARD DEMMITT

ADDRESS 9966 MARYLAND ROUTE 99 PHONE 465-4544

PROPERTY LOCATION:

SUBDIVISION JOCELYN ACRES, SECTION 3 LOT NO. 4

ROAD AND DESCRIPTION HIGHLAND ROAD, DIRECTLY ACROSS FROM ALLNUT LANE

SIZE OF LOT 3 ACRES TYPE BLDG. SINGLE FAMILY DWELLING
(NUMBER OF BEDROOMS) _____

THE SYSTEM INSTALLED UNDER THIS APPLICATION IS ACCEPTABLE ONLY UNTIL PUBLIC FACILITIES BECOME AVAILABLE. I FULLY UNDERSTAND THE
FEE CONNECTED WITH THE FILING OF THIS PERC TEST APPLICATION IS NON-REFUNDABLE UNDER ANY CIRCUMSTANCES. I ALSO AGREE TO COMPLY
WITH ALL M.O.S.H.A. REQUIREMENTS IN TESTING THIS LOT.

Charles J. Connor

(SIGNATURE OF APPLICANT)

APPROVED BY _____ FOR _____ DATE _____

REJECTED BY _____ FOR _____ DATE _____

HOLD PENDING FURTHER TESTS _____ DATE _____

REASONS FOR REJECTION OR HOLDING _____


THIS IS NOT A PERMIT

SEE PLAN
FOR
DRAWING
OF LOT

QUARRY PROPERTY

SOIL PROFILE

①
BROWN
FILL
3'
BROWN
CLAY
SAND
7'
BROWN
SAND
8'
FEW
SMALL
ROCKS

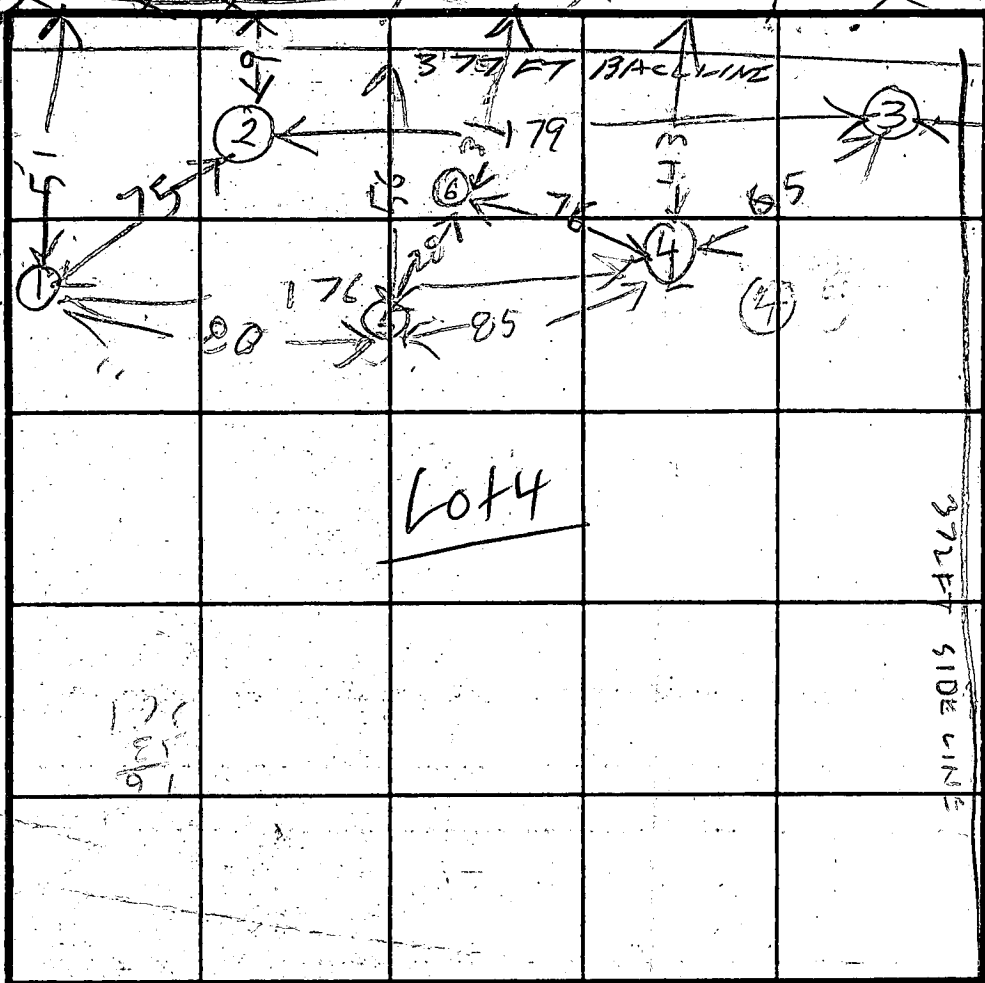

INDICATE NORTH - NAME ADJOINING ROADWAY AS BASE LINE.

④
FIL
4
PSAT
8
SAND
CLAY
MIX
12
BROWN
19

DATE	TEST NO.	DEPTH	PRE-WET		TEST - 1" DROP		TIME
			START	STOP	START	STOP	
12/5/82	1 S	5	113	137	137	210	33
	1 D	8	113	124	124	145	21
1/5/83	1 V	12	SEE	SOIL	PROFILE		
	2 S	4	130	150	150	225	25
	2 D	7 1/2	129	147	147	210	31
	2 V	13 1/2	LOOK	SAT	13 FACTORY		
	3 D	11	246	247	247	249	2
	3 S	7 1/2	249	307	Dirt Fell	in Hole	Redue
10/15/82	3 S Redig	7 1/2	315	320	Dirt fallen	in hole	
10/16/82	1 M	6	1026	1038	1038	1051	13
10/16/82	4 S	5	1029	1033	1033	1051	15
	4 D	9	1029	1036	1036	1051	15
	4 V	12 1/2	SEE	SOIL	PROFILE		
	3 S	7 1/2	1100	1104	1104	1112	8
10/16/82	4 S Redig	5	1124	1205	1205	1214	41

REMARKS

Hole ① ② ③ Almost same Elevation
* HOLE ④ DUG IN LOOSE DIRT REDIG NEEDED

TYPE OF SOIL

TESTED BY

R HODGES

ALSO PRESENT

C CISSEL
R DIMMITT

Lot 4

BROWN
CLAY
SAND

BROWN
FILL

BLACK &
GRAY
TOPSOIL

BROWN
CLAY
SAND
MIX

TAN
SAND

A 32181
 JOCELYN ACRES
 SECT III
 LOT 4

10/18/82	GED	9	335	343	343	357	14
10/28/82	6 EV	19 1/2	LOOKS OK SEE REVISED SOIL PROFILE				
		10					

Av time
 12
 Max Depth
 41 1/2

N 67° 01' 38" E 372.00'


N 22° 21' 47" W

12

418.46'

LOT 4
3.266 AC.

SEPTIC AREA

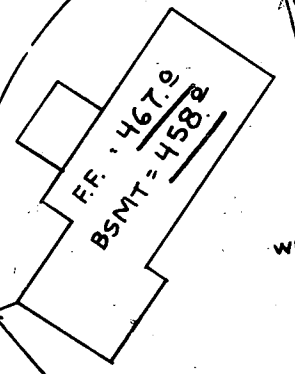

WELL 468'

INLET IN 451.5
D.W.

4BR
D.W. 7' STONE
225/BR
15X15 DW w/
MIN 70' TRENCH

S 21° 06' 29" E

275.29'

S 88° 00' 00" E

N 88° 00' 00" W

BLDG. PERMIT SIGNED
AND RETURNED 9-5-86 S. Aul
HA 72686
FOR DEPOSIT ONLY
HOWARD COUNTY HEALTH DEPARTMENT
10-103516-02



RICH LYNN COURT

Approved for private water and private sewage systems. Howard County Health Department.

Date _____

Howard County Health Officer

I certify that the perc test holes were field located.

Jefferson D. Lawrence
Jefferson D. Lawrence
MD. REG. PLS # 5216

380.00'

360.00'

N 45° 00' 00" W 24.27'
R=50.00'
A=145.42'



DEVELOPMENT
CONSULTANTS
GROUP, INC.

17904 GEORGIA AVENUE
OLNEY, MARYLAND 20832 (301)-924-4570

SITE DEVELOPMENT PLAN
LOT 4
JOCELYN ACRES
5TH ELECTION DISTRICT
HOWARD CO., MARYLAND

PLAT 5586

DATE
AUG. 86.
DRAWN
S.S.
CHECKED
BILL
SCALE
1"=50'

SHEET
1
OF 1
PROJECT NO.
153-02

C1 5227

SEQUENCE NO.
(OEP USE ONLY)STATE OF MARYLAND
WELL COMPLETION REPORTFILL IN THIS FORM COMPLETELY
PLEASE PRINT OR TYPETHIS REPORT MUST BE SUBMITTED WITHIN
45 DAYS AFTER WELL IS COMPLETED.COUNTY
NUMBER

A-32181

DATE Received

1	2	3	4	5	6
8					13

DATE WELL COMPLETED

0	8	1	5	8	6
15					20

Depth of Well

22	1	6	0		26
(TO NEAREST FOOT)					

PERMIT NO.
FROM "PERMIT TO DRILL WELL"

10	-	51	-	15	18
28	29	30	31	32	33
34	35	36	37		

OWNER

P. Z. KOWSKI

CONST.

STREET OR RFD

last name

RICH LYNN CT.

first name

TOWN

HIGHLAND

SUBDIVISION

JOCELYN ACRES

SECTION

3

LOT

4

WELL LOG

Not required for driven wells

STATE THE KIND OF FORMATIONS
PENETRATED, THEIR COLOR, DEPTH,
THICKNESS AND IF WATER BEARINGDESCRIPTION (Use
additional sheets if needed)

FEET

FROM TO

Check
if water
bearing

Top Soil	0	2	
Clay	2	4	
Shale	4	10	
Sand Stone	10	26	
Mica	26	45	
Sand Stone	45	48	✓
Mica	48	135	
Quartz	135	138	✓
Mica	138	160	

GROUTING RECORD

WELL HAS BEEN GROUTED
(Circle Appropriate Box)

yes	no
☒ Y	☐ N
44	44

TYPE OF GROUTING MATERIAL

CEMENT ☒ CM BENTONITE CLAY ☐ BC

NO. OF BAGS

NO. OF POUNDS

GALLONS OF WATER

DEPTH OF GROUT SEAL (to nearest foot)

from	0				ft.	6	17			ft.
(enter 0 if from surface)										

casing
types
insert
appropriate
code
below

CASING RECORD

☒ ST	☐ CO
STEEL	CONCRETE
☐ PL	☐ OT
PLASTIC	OTHER

MAIN Nominal diameter Total depth
CASING top (main) casing of main casing
TYPE (nearest inch) (nearest foot)

☒ ST	☐ 63	☐ 64	☒ 66	☐ 67	☐ 70
60	61	62	63	64	65

EACH CASING

OTHER CASING (if used)

diameter depth (feet)
inch from to

screen type
or open hole

SCREEN RECORD

☒ ST	☐ BR	☐ HO
STEEL	BRASS	OPEN HOLE
☐ PL	☐ OT	
PLASTIC	OTHER	

C2

DEPTH (nearest ft.)											
1	4	0	2	5		1	6	0			
8	9	11	13	15	17	19	21	23	25	27	29
2											
23	24	26	28	30	32	34	36	38	40	42	44
3											
38	39	41	43	45	47	49	51	53	55	57	59

SLOT SIZE 1 2 3

DIAMETER OF SCREEN (NEAREST INCH)

from					to
------	--	--	--	--	----

GRAVEL PACK
IF WELL DRILLED WAS
FLOWING WELL INSERT
F IN BOX 68

OEP USE ONLY

(NOT TO BE FILLED IN BY DRILLER)

T	(E.R.O.S.)	WQ
☐ 70	☐ 72	☐ 74
TELESCOPE	LOG	OTHER DATA
CASING	INDICATOR	

C3

PUMPING TEST

HOURS PUMPED (nearest hour)

PUMPING RATE (gal. per min. to nearest gal.)

METHOD USED TO MEASURE PUMPING RATE

WATER LEVEL (distance from land surface)

BEFORE PUMPING

WHEN PUMPING

TYPE OF PUMP USED (for test)

☒ A	☐ P	☐ T
air	piston	turbine
☐ C	☐ R	☐ O
centrifugal	rotary	other (describe below)
☐ J	☒ S	
jet	submersible	

PUMP INSTALLED

DRILLER WILL INSTALL PUMP YES NO

IF DRILLER INSTALLS PUMP, THIS SECTION
MUST BE COMPLETED FOR ALL WELLS
EXCEPT HOME USE
TYPE OF PUMP INSTALLED
PLACE (A,C,J,P,R,S,T,O)
IN BOX - SEE ABOVE:CAPACITY:
GALLONS PER MINUTE
(to nearest gallon)

PUMP HORSE POWER

PUMP COLUMN LENGTH
(nearest ft.)CASING HEIGHT (circle appropriate box
and enter casing height)LAND SURFACE ± 20 K
below $\checkmark$ 2 (nearest foot)

LOCATION OF WELL ON LOT

SHOW PERMANENT STRUCTURE SUCH AS
BUILDING, SEPTIC TANKS, AND/OR
LANDMARKS AND INDICATE NOT LESS
THAN TWO DISTANCES
(MEASUREMENTS TO WELL)CIRCLE APPROPRIATE LETTER
A A WELL WAS ABANDONED AND SEALED
WHEN THIS WELL WAS COMPLETED.

E ELECTRIC LOG OBTAINED

P TEST WELL CONVERTED TO PRODUCTION
WELLI HEREBY CERTIFY THAT THIS WELL HAS BEEN CONSTRUCTED IN
ACCORDANCE WITH COMAR 10.17.13 "WELL CONSTRUCTION"
AND IN CONFORMANCE WITH ALL CONDITIONS STATED IN THE
ABOVE CAPTIONED PERMIT, AND THAT THE INFORMATION
PRESENTED HEREIN IS ACCURATE AND COMPLETE TO THE BEST
OF MY KNOWLEDGE.

DRILLERS IDENT. NO. 40

DRILLERS SIGNATURE
(MUST MATCH SIGNATURE ON APPLICATION)SITE SUPERVISOR (sign. of driller or journeyman
responsible for sitework if different from permittee)

Review OK'd 8/21/86 

Well Permit No. HO - 81 1598
Location of property (road) RICH LYNW CT.
Subdivision JACELYN ACRES Lot 4 Block Plat Sec. 3
Well Driller GEORGE EASTERDAY Owner CONST. PRZEPKOWSKI

Depth of well 160 12 GPM
Distance of measuring point (M.P.) above ground _____
Static water level (S.W.L.) below M.P. 35'-0" 2'

1. High rate pumping -- reservoir drawdown

Time pump started 9:45 Pumping rate 10 gpm
Total time 30 mins to reach pumping water level 57' ft. below M.P.

- II. Recovery pump test data - observations to be recorded every 15 minutes

[illegible]

Review *H 9831*

FIELD DATA SHEET
HOWARD COUNTY WELL YIELD TEST

Well Permit No. HO - 81-1598
Location of property (road) Rich Lynn CR
Subdivision. Jocelyn Acres Lot 4 Block Plat Sec.
Well Driller Geo. Easterday Owner Pzepakowski

Depth of well / 60

Distance of measuring point (M.P.) above ground 2'

Static water level (S.W.L.) below M.P. " 3'5"

5. High rate pumping -- reservoir drawdown

Time pump started 9:45—

Pumping rate 10

Total time 30 min to reach pumping water level 5 / ft. below M.P.

II. Recovery pump test data - observations to be recorded every 15 minutes

[illegible]