

10/11/83 App'd G.S.

10/11/83
around 10:30 A.M.

PERMIT

SEWAGE DISPOSAL SYSTEM

MARYLAND STATE DEPARTMENT OF HEALTH*

P 33212
A 32662

HOWARD COUNTY

BUREAU OF ENVIRONMENTAL HEALTH

992-2330

ELLICOTT CITY

DISTRICT 5th

INDEX

DATE 10/10/83

Nu-Homes, Inc.

IS PERMITTED TO INSTALL X ALTER _____

ADDRESS 9594 Old Route 32, Columbia, Md. 21044 PHONE _____

SUBDIVISION _____ ROAD 7932 Route 32 LOT _____

PROPERTY OWNER Ulysses Moore

ADDRESS 10341 White Washer Way, Columbia, Md. 21044 Phone: 997-4963

IF GARBAGE GRINDER IS USED INCREASE SEPTIC TANK CAPACITY BY 50% AND ABSORPTION AREA BY 22%.

GARBAGE GRINDER? YES _____ NO X

SEPTIC TANK CAPACITY 1000 GALLONS NUMBER OF BEDROOMS 3

DRY WELL AND TRENCH - 375 sq. ft. minimum total sq. ft. for 3 bedroom house. Inlet 3 1/4 ft. below original grade. Bottom maximum depth 9 feet below original grade. Effective area begins at 3 1/4 ft. below original grade. NOTE: If trench is used to make up absorbent area, run the trench on level ground and leave a 5 foot earth buffer between dry well and trench. No trench is to exceed 100 feet in length. Trench inlet to be same as dry well, with 5 1/4 ft. of stone below distribution pipe.

TRENCHES - 158 sq. ft. per bedroom in system. Trench to be 2 ft. wide. Inlet 3 1/4 feet below original grade. Bottom maximum depth 9 feet below original grade. Effective area begins at 3 1/4 ft. below original grade. 5 1/4 feet of stone below distribution pipe. Start system in vicinity of perc hole #1; approximately 80 ft. from edge of Route 32.

NOTE: HAND DUG WELL TO BE ABANDONED AND SEALED BEFORE WELL AND SEPTIC ARE OK'D.

PLANS APPROVED BY Craig Williams & Frank A. Skinner DATE 4/29/83 & 8/23/83

COVER NO WORK UNTIL INSPECTED AND APPROVED.

NEITHER THE HOWARD COUNTY COUNCIL NOR THE HEALTH DEPARTMENT IS RESPONSIBLE FOR THE SUCCESSFUL OPERATION OF ANY SYSTEM.

NOTE: IF TRENCH IS USED CALL FOR INSPECTION BEFORE AND AFTER PLACING GRAVEL IN TRENCH.

NOTE: NO DRY WELL SHALL EXCEED 15 FOOT IN DIAMETER. NO ABSORPTION TRENCH TO EXCEED 100 FEET IN LENGTH.

NOTE: ALL PIPE FROM HOUSE TO SEPTIC TANK MUST BE CAST IRON OR SCHEDULE 40 PVC OR ABS.

PERMIT VOID AFTER THREE YEARS.

NOTE: INSTALL STAND PIPE ON SEPTIC TANK AND DRY WELL. STAND PIPES MUST BE 6 INCHES IN DIAMETER. CAST IRON, CONCRETE OR TERRA COTTA, OR PVC OR ABS ACCEPTED. IF TOP OF SEPTIC TANK IS DEEPER THAN 3 FEET MANHOLE TO GRADE REQUIRED

BLDG. PERMIT SIGNED
AND RETURNED 3/6/84


Serial # 68940
Addition Bedroom

A 32662

*INSTALLER IS RESPONSIBLE FOR OBTAINING FINAL APPROVAL ON THIS PERMIT

*CALL 992-2330 FOR INSPECTION OF SEPTIC SYSTEMS.

EH - 2-1082

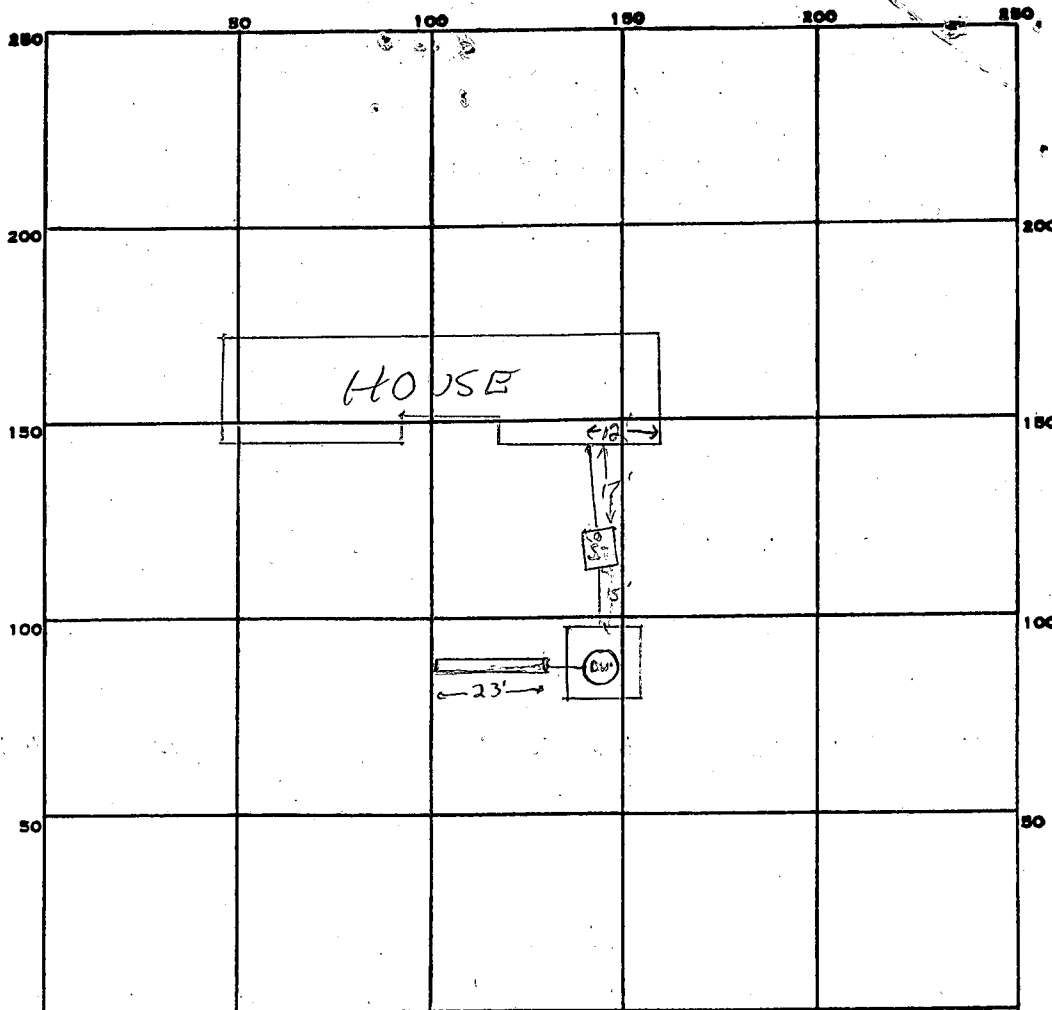

INDICATE NORTH. - NAME ADJOINING ROADWAY AS BASE LINE.

Rte 32

PERMIT CARD ✓ Sequid

S.T. | A.W.

SEPTIC TANK, LEVEL ✓

CLEANOUTS ✓ ✓

DISTRIBUTION BOX, LEVEL ha.

TILE FIELD, DEPTH — FT. TRENCH WIDTH 2 FT. 23

GRAVEL DEPTH 6 IN. TOTAL LENGTH 23 FT.

NUMBER OF TRENCHES 1 ONE SIDEWALL TOTAL BOTTOM AREA ±126 ft²

SEEPAGE PITS, INSIDE DIAMETER 50 FT. DEPTH BELOW INLET 5.5 FT.

ABSORBENT AREA ±401 SQ. FT. total abs. area ±527 ft²

REMARKS 10/11/83 OK to com all work 55

DATE SYSTEM APPROVED 10/11/83 INSPECTOR Frank Skinner

APPLICATION

SEWAGE DISPOSAL TESTING

STATE OF MARYLAND - DEPARTMENT OF HEALTH AND MENTAL HYGIENE

HOWARD COUNTY HEALTH DEPARTMENT
ENVIRONMENTAL HEALTH SERVICES

P. O. BOX 476 ELLICOTT CITY, MARYLAND 21043
TELEPHONE: 992-2330

A 32662

P _____

DISTRICT _____

DATE 4/15/83

TO: THE COUNTY HEALTH OFFICER
ELLICOTT CITY, MARYLAND

I, HEREBY, APPLY FOR THE NECESSARY TEST IN ORDER TO CONSTRUCT (OR RECONSTRUCT) A SEWAGE DISPOSAL SYSTEM.

PROPERTY OWNER Ulysses Moore

ADDRESS _____ PHONE _____

PROPERTY LOCATION:

SUBDIVISION Addie V. Holland Estates LOT NO. _____

ROAD AND DESCRIPTION Route 32

SIZE OF LOT 1.00 acres TYPE BLDG. _____ (NUMBER OF BEDROOMS) _____

THE SYSTEM INSTALLED UNDER THIS APPLICATION IS ACCEPTABLE ONLY UNTIL PUBLIC FACILITIES BECOME AVAILABLE. I FULLY UNDERSTAND THE
FEE CONNECTED WITH THE FILING OF THIS PERC TEST APPLICATION IS NON-REFUNDABLE UNDER ANY CIRCUMSTANCES. I ALSO AGREE TO COMPLY

WITH ALL M.O.S.H.A. REQUIREMENTS IN TESTING THIS LOT. Ketterman/Ulysses Moore
(SIGNATURE OF APPLICANT)


APPROVED BY C William FOR ALL DATE 4-29-83

REJECTED BY _____ FOR _____ DATE _____

HOLD PENDING FURTHER TESTS _____ DATE _____

REASONS FOR REJECTION OR HOLDING _____

THIS IS NOT A PERMIT

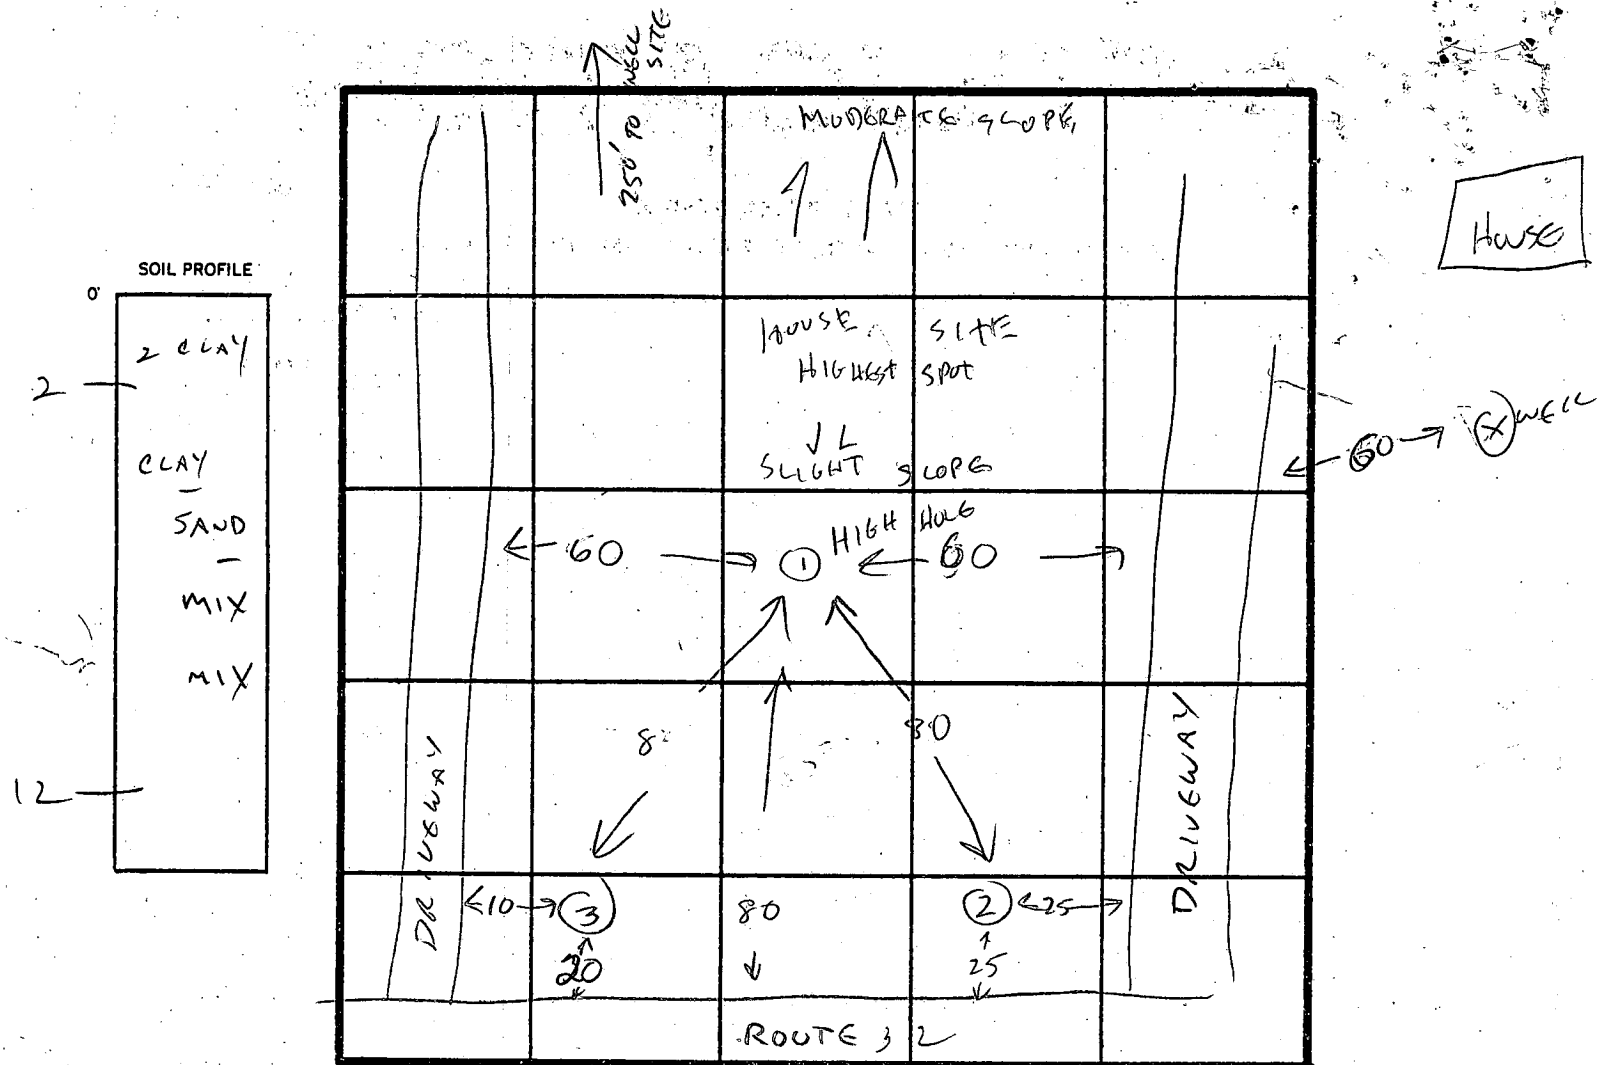

INDICATE NORTH - NAME ADJOINING ROADWAY AS BASE LINE.

DATE	TEST NO.	DEPTH	PRE-WET		TEST - 1" DROP		TIME
			START	STOP	START	STOP	
4-28-83	1	4	10:01	10:06	10:08	10:14	8 MIN
		13	MICA-SAND, SOME CLAY				
4-29-83	2	3	10:09	10:12	10:13	10:16	3 MIN
		13	MICA-SAND, SOME CLAY				
4-29-83	3	4	9:49	9:53	9:53	9:59	6 MIN
		13	MICA-SAND, SOME CLAY				


REMARKS: HOUSE SITE 100-110 FT FROM ROUTE 32

TYPE OF SOIL: SAND IS KALK 90 CLAY + MICA

TESTED BY: C. Williams

ALSO PRESENT: OTO KETTERMAN
MS. MOORE

7932 32

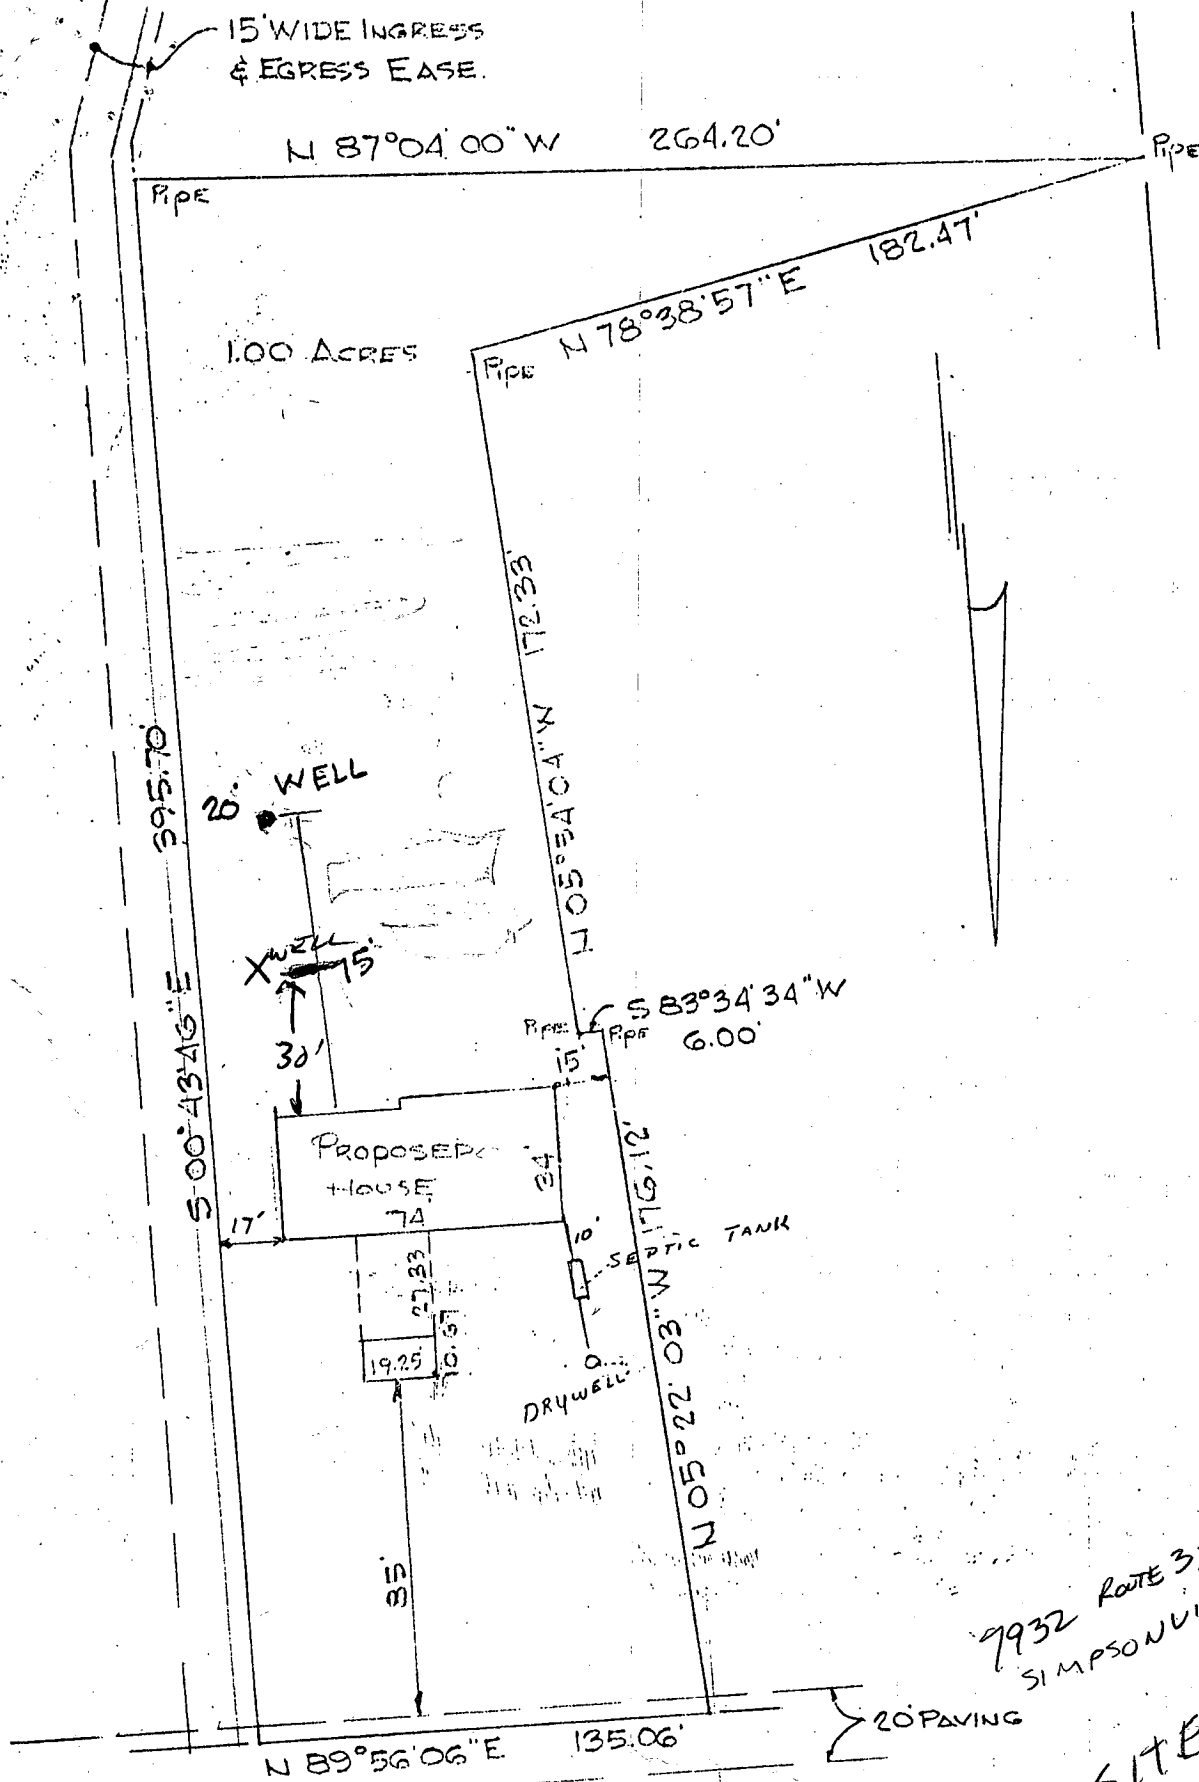

MD. RTE. 32


PLAT OF PROPERTY
MOORE PROPERTY
LIBER 434 FOLIO 490
SCALE 1"=50' DATE 6-3-83

Ulysess Moore

CARLIN & ASSOCIATES
PROFESSIONAL LAND SURVEYORS
4014 CROYDON LANE, BOWIE, MD
301-262-7776

7932 ROUTE 32
SIMPSONVILLE

WELL SITE OK
6-24-83
C. Williams

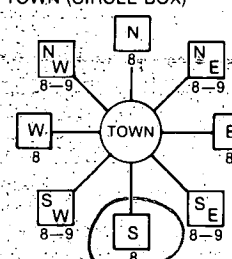B 2	4526	SEQUENCE NO. <u>Pump test</u> (OEP USE ONLY) <u>3 hrs - 8:30</u> <u>7/13/83</u>	STATE OF MARYLAND PERMIT TO DRILL WELL please print or type	OEP PERMIT NUMBER <u>HO-81-0179</u> fill in this form completely
(THIS NUMBER IS TO BE PUNCHED IN COLS. 3-6 ON ALL CARDS)				
Date Received <u>9:30AM-7/13/83 - Grout</u> <u>062183</u>		LOCATION OF WELL <u>HOWARD</u> COUNTY <u>HOWARD</u> <u>taxmap 35 parcel 323</u> SUBDIVISION SECTION <u>44</u> LOT <u>46</u> <u>COLUMBIA</u> NEAREST TOWN MILES FROM TOWN (enter 0 if in town) <u>2</u> MI		
OWNER INFORMATION <u>NU-401ES INC.</u> Last Name <u>NU-401ES</u> Owner <u>INC.</u> First Name <u>9594 OLD RT. 32</u> Street or RFD <u>COLUMBIA</u> <u>MD21044</u> Town State Zip		DRILLER INFORMATION <u>DANA KYKER, JR. 2nd 256</u> Driller's Name License No. 80 <u>Western Rotary Well Drilling, Inc.</u> Firm Name <u>Box 861, Western, MD.</u> Address <u>Dana Kyker, Jr. 2nd 256/20/83</u> Signature Date		
WELL INFORMATION APPROX. PUMPING RATE (GAL. PER MIN.) <u>6</u> AVERAGE DAILY QUANTITY NEEDED (GAL. PER DAY) <u>395</u>		DIRECTION OF WELL FROM TOWN (CIRCLE BOX)  ON WHICH SIDE OF ROAD (CIRCLE APPROPRIATE BOX) <u>RT. 32</u> NEAR WHAT ROAD DISTANCE FROM ROAD <u>250</u> FT ENTER FT or MI <u>FT</u>		
USE FOR WATER (CIRCLE APPROPRIATE BOX) ☒ HOME (SINGLE OR DOUBLE HOUSEHOLD UNIT ONLY) ☐ FARMING (LIVESTOCK WATERING & AGRICULTURAL IRRIGATION) ☐ INDUSTRIAL, COMMERCIAL, STATE AND FEDERAL GOV. OTHER (REQUIRES APPROPRIATION PERMIT) ☐ PUBLIC OR PRIVATE WATER COMPANY (REQUIRES APPROPRIATION PERMIT AND STATE HEALTH DEPARTMENT APPROVAL) ☐ TEST, OBSERVATION, MONITORING (MAY REQUIRE APPROPRIATION PERMIT)		NOT TO BE FILLED IN BY DRILLER HEALTH DEPARTMENT APPROVAL <u>HOWARD</u> COUNTY NAME <u>A 32662</u> COUNTY NO. OEP SIGNATURE <u>Frank She</u> DATE ISSUED <u>1/6/84</u> <u>070683</u> CO SIGNATURE EXP. DATE NORTH GRID <u>492000</u> EAST GRID <u>0832000</u>		
APPROXIMATE DEPTH OF WELL <u>150</u> FEET APPROXIMATE DIAMETER OF WELL <u>6</u> INCH		SHOW MAJOR FEATURES OF BOX & LOCATE WELL WITH AN X SOURCES OF DRILLING WATER 1. <u>CITY</u> 2. 3. WRITE THE BOX NUMBER FROM THE MAP HERE <u>8302</u> <u>4902</u>		
METHOD OF DRILLING (circle one) ☒ BORED (or Augered) ☐ JETTED ☐ Jetted & ☐ DRIVEN ☒ AIR-ROTARY ☐ AIR-PERCussion ☐ ROTARY (Hydraulic Rotary) ☐ CABLE ☐ REVERSE-ROTARY ☐ DRIVE-POINT other		LOCATION OF HAND DUG WELL OPEN <u>30' CASING</u> <u>2' ABOVE GR TO 20'</u> <u>26' OPEN 8-18-83 CW</u> <u>12 BAGS CEMENT</u> <u>WELL</u> <u>7-13-83 CW</u>		
REPLACEMENT OR DEEPEMED WELLS (CIRCLE APPROPRIATE BOX) ☐ THIS WELL WILL NOT REPLACE AN EXISTING WELL ☒ THIS WELL WILL REPLACE A WELL THAT WILL BE ABANDONED AND SEALED ☐ THIS WELL WILL REPLACE A WELL THAT WILL BE USED AS A STANDBY ☐ THIS WELL WILL DEEPMEN AN EXISTING WELL PERMIT NUMBER OF WELL TO BE REPLACED OR DEEPEMED (IF AVAILABLE)		DRAW A SKETCH BELOW SHOWING LOCATION OF WELL IN RELATION TO NEARBY TOWNS AND ROADS AND GIVE DISTANCE FROM WELL TO NEAREST ROAD JUNCTION <u>8/19/83 NOT YET FILLED</u> <u>RT. 32 RA</u> <u>7932 RT 32</u> <u>SIMPSONVILLE</u> <u>2100'</u> <u>WELL</u>		
Not to be filled in by driller (OEP USE ONLY) APPROP. PERMIT NUMBER <u>GAP</u> FORCE <u>FS</u> WRITE INITIALS IN BOX PERMIT NO. <u>HO-81-0179</u> SPECIAL CONDITIONS				

FIELD DATA SHEET
HOWARD COUNTY WELL YIELD TEST

Well Permit No. HO - 81-0179
Location of property (road) Route 32 (7932)
Subdivision Tax Map 35 Parcel 323 Lot _____ Block _____ Plat _____ Sec. _____
Well Driller Dana Kuker Owner Mu-Homes Inc

Depth of well 150'
Distance of measuring point (M.P.) above ground 2 FT
Static water level (S.W.L.) below M.P. 24 FT

I. High rate pumping -- reservoir drawdown

Time pump started 8:00 Pumping rate 15 gpm
Total time 30 min to reach pumping water level 82 ft. below M.P.

II. Recovery pump test data - observations to be recorded every 15 minutes

[illegible]

C1	0782	SEQUENCE NO. (OEP USE ONLY)	STATE OF MARYLAND WELL COMPLETION REPORT FILL IN THIS FORM COMPLETELY PLEASE PRINT OR TYPE		THIS REPORT MUST BE SUBMITTED WITHIN 45 DAYS AFTER WELL IS COMPLETED.		
					COUNTY NUMBER	A 32662	
DATE Received		DATE WELL COMPLETED		Depth of Well		PERMIT NO. FROM "PERMIT TO DRILL WELL"	
071382		071382		2216026 (TO NEAREST FOOT)		40-81-0179	

OWNER	NU-HOMES INC.			first name	TOWN		
STREET OR RFD	2432 Md. Rte. 32			Columbia			
SUBDIVISION	tax map 35, parcel 323			SECTION	LOT		

WELL LOG Not required for driven wells		GROUTING RECORD		PUMPING TEST	
STATE THE KIND OF FORMATIONS PENETRATED, THEIR COLOR, DEPTH, THICKNESS AND IF WATER BEARING		WELL HAS BEEN GROUTED (Circle Appropriate Box)		HOURS PUMPED (nearest hour)	
DESCRIPTION (Use additional sheets if needed)		TYPE OF GROUTING MATERIAL		PUMPING RATE (gal. per min. to nearest gal.)	
Clay		CEMENT CM BENTONITE CLAY BC		5.4	
Soft Brown Bank-sand		NO. OF BAGS 12 NO. OF POUNDS 1128		METHOD USED TO MEASURE PUMPING RATE Submersible	
Soft Brown Bank-sand		GALLONS OF WATER 72		WATER LEVEL (distance from land surface)	
Soft Brown Bank Sand		DEPTH OF GROUT SEAL (to nearest foot)		BEFORE PUMPING	
Hard Blue & Brown Sandstone		from 0 ft. to 28 ft.		24	
Brown Sandstone & Clay Seam		CASING RECORD		WHEN PUMPING	
Blue & Black Sandstone		casing types insert appropriate code below		82	
		STEEL CONCRETE PL OT		TYPE OF PUMP USED (for test)	
		MAIN CASING TYPE		A air P piston T turbine	
		Nominal diameter top (main) casing (nearest inch)		C centrifugal R rotary O other (describe below)	
		Total depth of main casing (nearest foot)		J jet S submersible	
		OTHER CASING (if used) diameter inch depth (feet) from to		PUMP INSTALLED	
		SCREEN RECORD		DRILLER WILL INSTALL PUMP YES NO	
		screen type or open hole insert appropriate code below		IF DRILLER INSTALLS PUMP, THIS SECTION MUST BE COMPLETED FOR ALL WELLS EXCEPT HOME USE	
		STEEL BR BRONZE PL PLASTIC HO OPEN HOLE OT OTHER		TYPE OF PUMP INSTALLED PLACE (A,C,J,P,R,S,T,O) IN BOX - SEE ABOVE:	
		C2		CAPACITY: GALLONS PER MINUTE (to nearest gallon)	
		DEPTH (nearest ft.)		PUMP HORSE POWER	
		H O 30 16 C		PUMP COLUMN LENGTH (nearest ft.)	
		Casing height (circle appropriate box and enter casing height)		Casing height (circle appropriate box and enter casing height)	
		+ above - below		LAND SURFACE (nearest foot)	
		2		2	


CIRCLE APPROPRIATE LETTER		LOCATION OF WELL ON LOT	
A A WELL WAS ABANDONED AND SEALED WHEN THIS WELL WAS COMPLETED		SHOW PERMANENT STRUCTURE SUCH AS BUILDING, SEPTIC TANKS, AND/OR LANDMARKS AND INDICATE NOT LESS THAN TWO DISTANCES (MEASUREMENTS TO WELL)	
E ELECTRIC LOG OBTAINED		Rt. 32	
P TEST WELL CONVERTED TO PRODUCTION WELL			
I HEREBY CERTIFY THAT THIS WELL HAS BEEN CONSTRUCTED IN ACCORDANCE WITH COMAR 10.17.13 "WELL CONSTRUCTION" AND IN CONFORMANCE WITH ALL CONDITIONS STATED IN THE ABOVE CAPTIONED PERMIT, AND THAT THE INFORMATION PRESENTED HEREIN IS ACCURATE AND COMPLETE TO THE BEST OF MY KNOWLEDGE.			
DRILLERS IDENT. NO. 256			
Dana Kyker, Jr. II			
DRILLERS SIGNATURE (MUST MATCH SIGNATURE ON APPLICATION)			
SITE SUPERVISOR (sign if driller or journeyman responsible for sitework if different from permittee)			
TELESCOPE CASING		LOG INDICATOR	
OEP USE ONLY (NOT TO BE FILLED IN BY DRILLER)		WQ	
T (E.R.O.S.)		74 75 76	
70 72		OTHER DATA	

Well Permit No. HO - 81-0179
Location of property (road) Md. Rte. 32
Subdivision taxmap 35 parcel 323 Lot Block Plat Sec.
Well Driller Dena Kyker Jr. Owner Nu-Homes Inc.

Distance of measuring point (M.P.) above ground 24"
 Static water level (S.W.L.) below M.P. 24 7/8

Time pump started 8 AM Pumping rate 15
Total time 30 min to reach pumping water level 82 ft. below M.P.

[illegible]

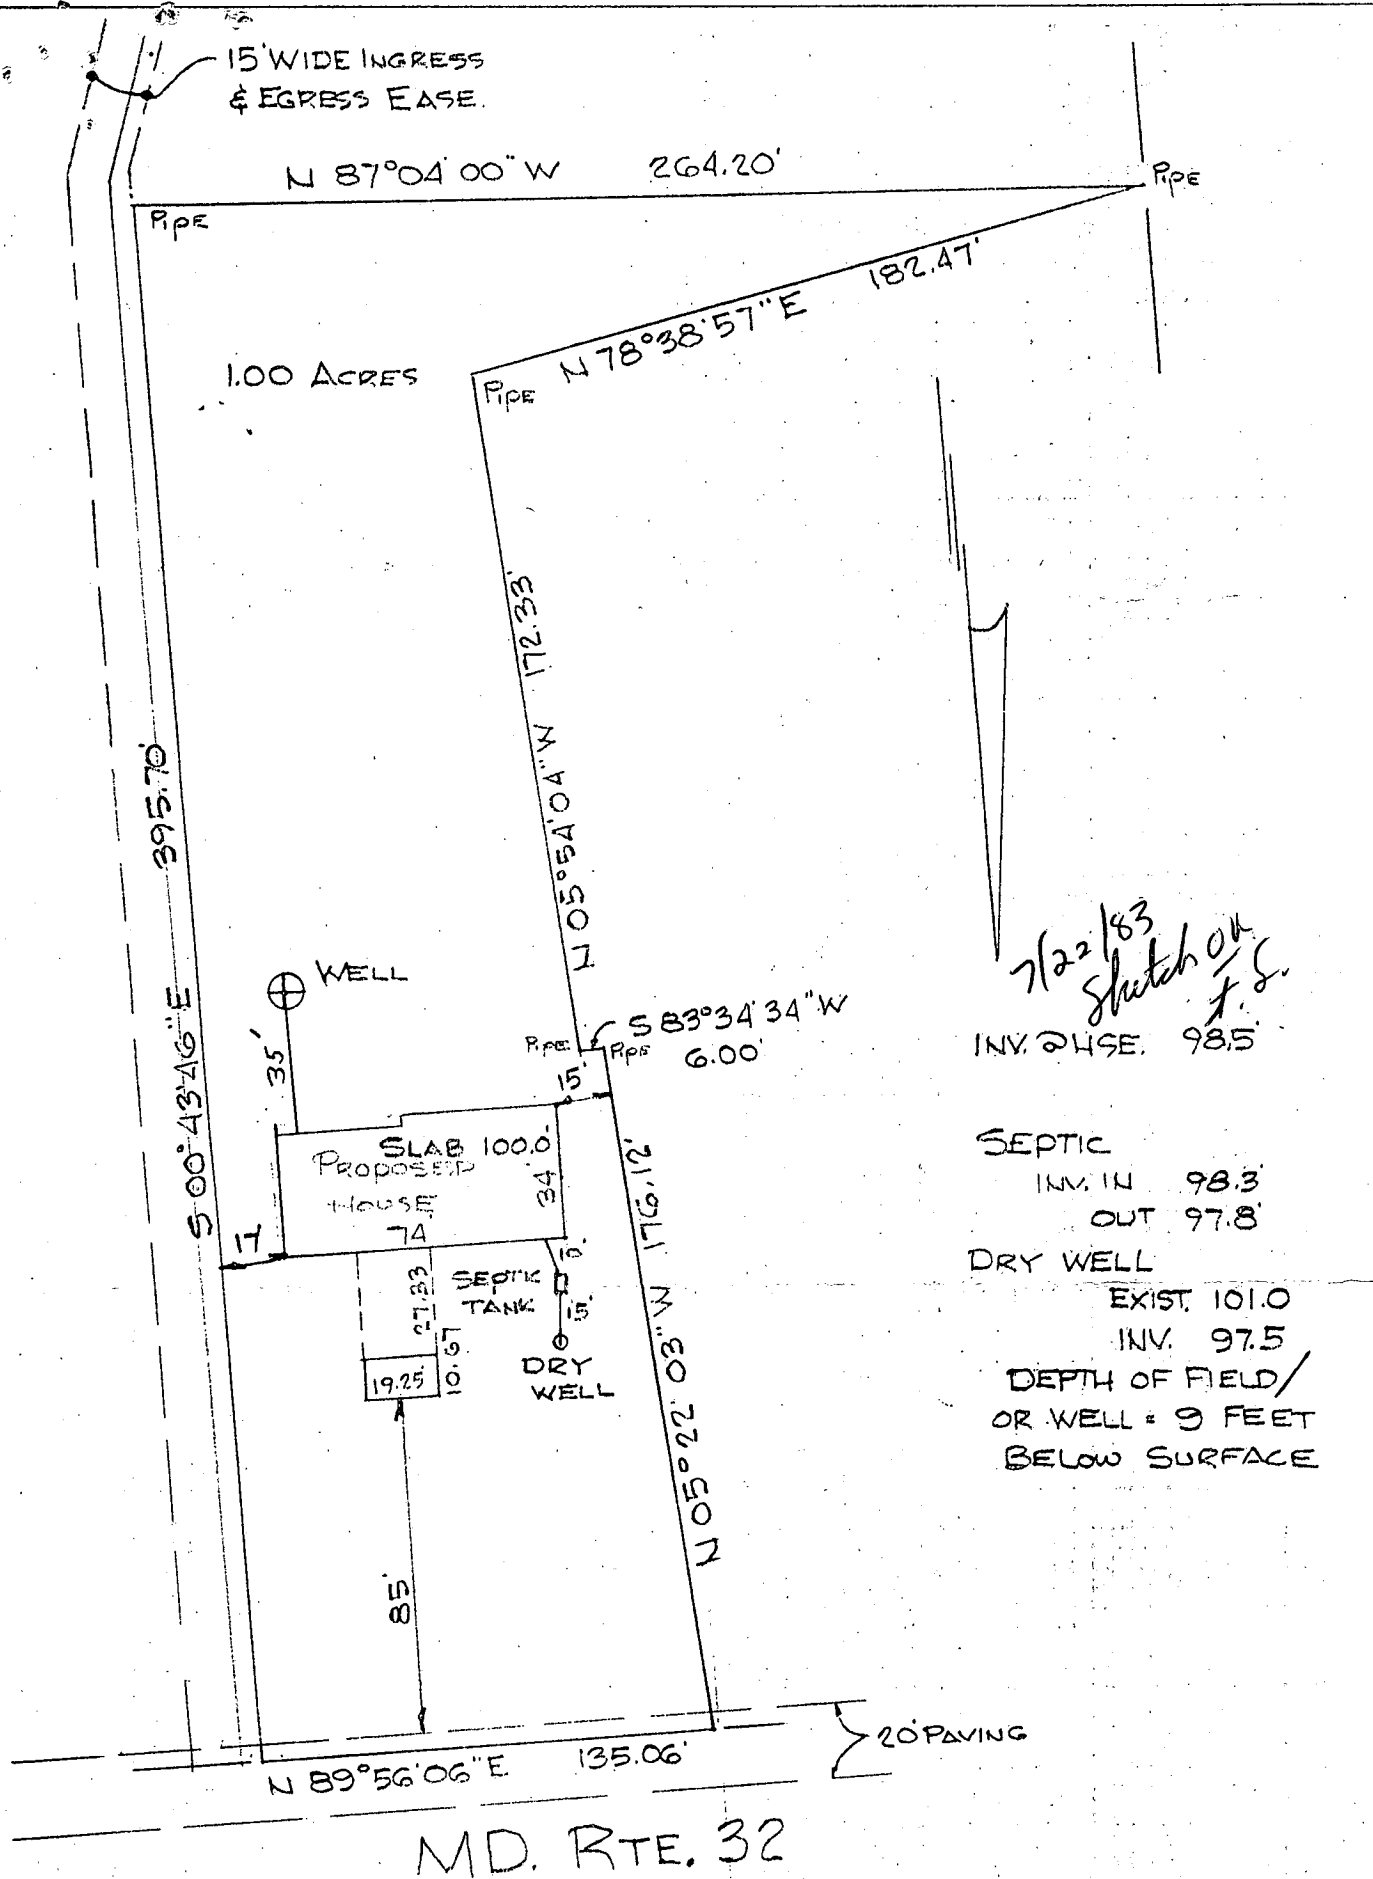

7/22/83
Sketch on
F.S.


INV. 24 SE. 98.5'

SEPTIC
INV. IN 98.3'
OUT 97.8'

DRY WELL
EXIST. 101.0'
INV. 97.5'
DEPTH OF FIELD/
OR WELL = 9 FEET
BELOW SURFACE

PLAT OF PROPERTY
MOORE PROPERTY
LIBER 434 FOLIO 490
SCALE 1" = 50' DATE 6-3-83


7-13-83
7-18-83 (SEPTIC)

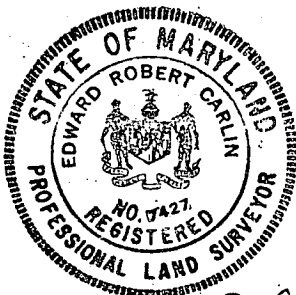

Edward R. Carlin

CARLIN & ASSOCIATES
PROFESSIONAL LAND SURVEYORS
4014 CROYDON LANE, BOWIE, MD
301-262-7776

15-9
0-16

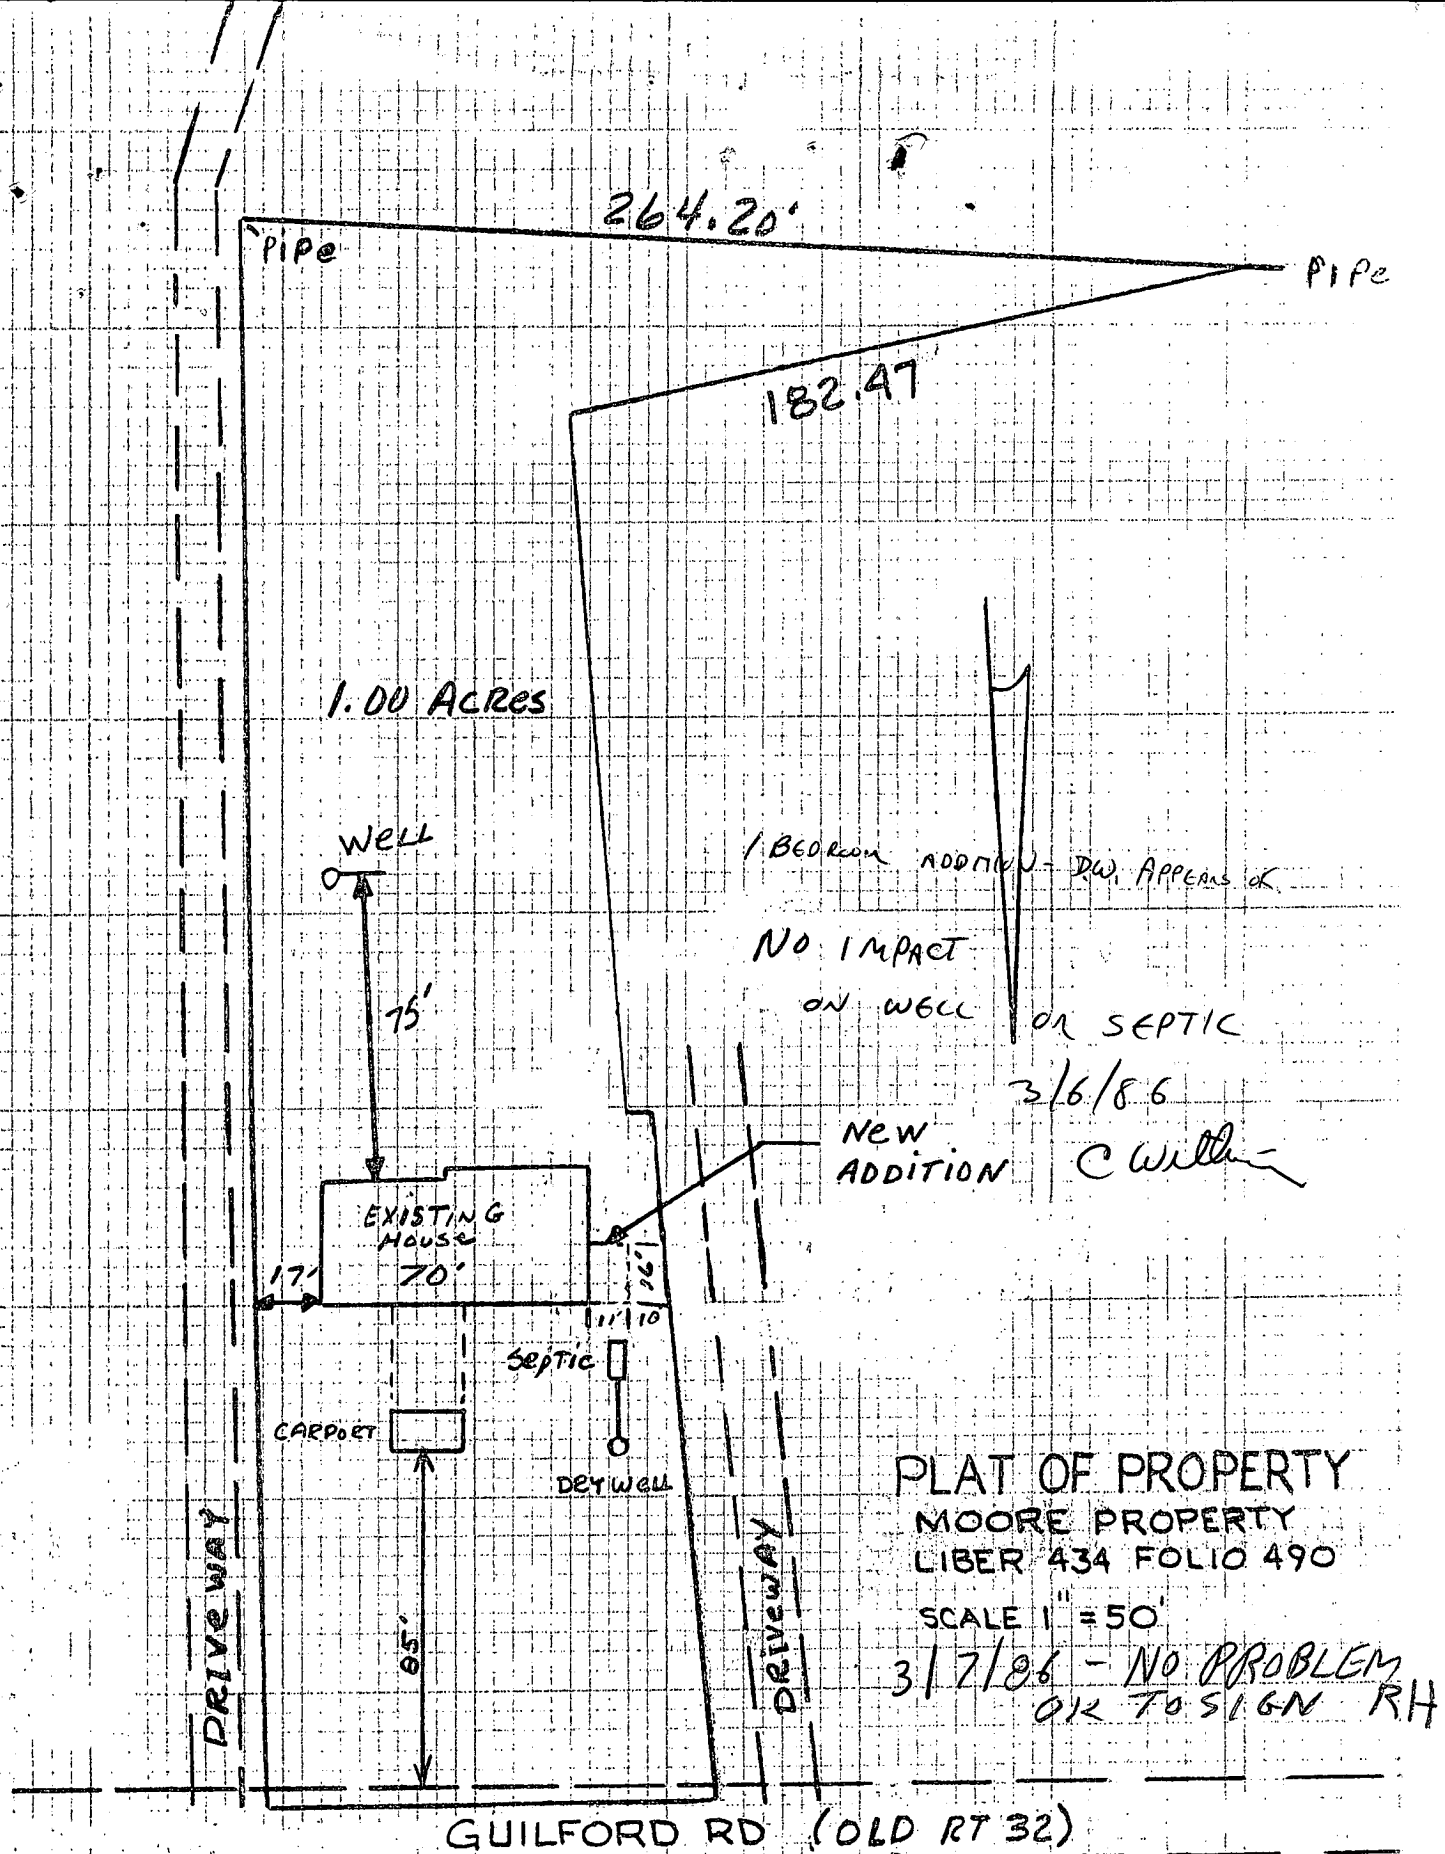

Property LOCATED APPROX:
3/4 MILES EAST OF CEDAR LANE, AND 3/4 WEST
OF FREETOWN RD, 5TH DISTRICT, TAX MAP 35,
BLOCK 23, PARCEL 323 KNOWN AS 7932
GUILFORD RD COLUMBIA, MD 21044

APPLICANT

HOWARD COUNTY

PERMIT APPLICATION

SERIAL NUMBER

11728

DEPARTMENT OF INSPECTIONS, LICENSES & PERMIT

3430 COURT HOUSE DRIVE, ELLICOTT CITY, MARYLAND 21043

BUILDING ADDRESS (HOUSE NO., STREET, TOWN OR AREA)

7932 GUILFORD ROAD
COLUMBIA, MD 21044 (OLD SIMPSONVILLE AREA)

LOT NO.	PARCEL NO.	SEC.	AREA	BLOCK NO.	LIBER	FOLIO
	515			23		

SUB DIVISION	ZONE	ZONE MAP	ELEC. DIST.	CENSUS TR.
	L-20	35	5	6053

OWNER NAME AND ADDRESS

Bloussie L. Moore (301) 596-9770
7932 GUILFORD ROAD COL. MD 21044

OCCUPANT'S NAME AND ADDRESS

Same As Above

ARCHITECT OR ENGINEER'S NAME AND ADDRESS

SELF

CONTRACTOR'S NAME AND ADDRESS

Same As Owner

EXISTING USE

Single Family
dwelling

PROPOSED USE

Same with
Addition

EST. CONSTRUCTION COST

16,500

LICENSE NUMBER

PERMIT FEE

W/S CODE

FOR OFFICE USE ONLY

DISTRICT IN FEET FROM R/W LINE TO FRONT BUILDING LINE

SIDE YARD

(DISTANCE IN FEET FROM SIDE BLDG. LINE TO SIDE PROPERTY LINE)

TO SIDE BUILDING LINE

DISTANCE IN FEET, REAR YD. REQUIRING SET

BACK (CORNER LOT ONLY)

SDP #

Check payable to: DIRECTOR OF FINANCE OF HOWARD COUNTY

CAUTION

To begin construction before a permit placard has been issued and displayed on the job is a violation of the law.

Use and occupancy permit must be applied for 10 weeks before it will be issued.

IMPORTANT: PLEASE SHOW ZIP CODES AND AREA CODES WHEREVER REQUIRED.

LP-69-591

GRADING/SEDIMENT CONTROL ☐ YES ☐ NO

SDP #

DESCRIPTION OF WORK AUTHORIZED

BUILDING A 30' X 36'
ADDITION ON REAR RIGHT
OF EXISTING HOUSE TO CREATE
BEDROOM WITH SITTING AREA.

SIZE OF BLDG.	FRONT	DEPTH	HEIGHT
34' X 36'	36'	30'	12'

TYPE OF BLDG.	AREA	VOLUME	ROOF
---------------	------	--------	------

B. ROOMS			
ROOMS			
BATHS			

FIREPLACES			
------------	--	--	--

FOOTINGS	FOUNDATION	S. WALLS
----------	------------	----------

UTILITIES

WATER/WELL	SEWER/SEPTIC	GAS	ELECTRICITY	TYPE OF HEAT	AC
				H/W	

I have carefully examined and read this application and know the same is true and correct, and that in doing this work, all provisions of Howard County Ordinances and the State Laws of Maryland will be complied with, whether specified or not; and I will notify the Department of Inspections, and Permits twenty-four hours in advance when I am ready for the inspections called for elsewhere in the application; and that no work will be covered up until such inspections have been complied with.

Signature: [Signature] DATE: 3/17/92

TITLE: DATE:

FUNCTION DATE SIGNATURE APPROVAL

ZONING/PLANNING

SHA

SEDIMENT/GRADING

BUILDING OFFICIAL

WATER & SEWER

HEALTH DEPT. 3/27/92 R. Hodge


FIRE PROTECTION

STORM WATER MGMT.

APPROVED

DATE

Distribution of Copies:
White - Building Official
Green - Planning & ZoningYellow - Engineering
Pink - Health Dept.
Gold - S.H.A.

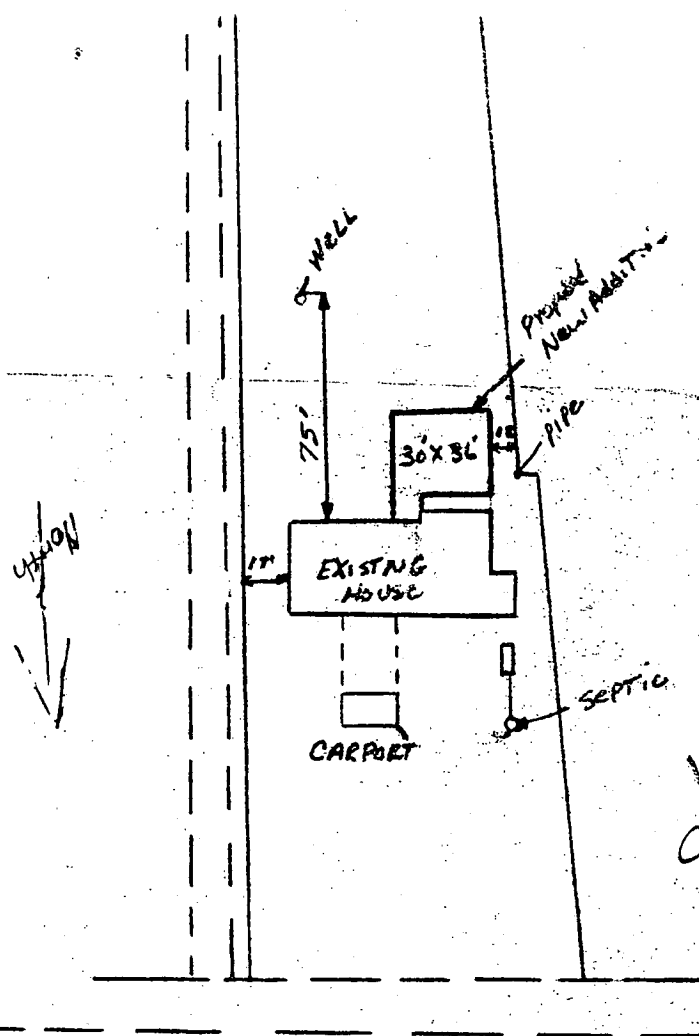

Scale: 1" = 50'

3/27/92
VISITED SITE
OIL TO SIGM
RH

MOORE'S PROPERTY
7932 GUILFORD RD.
COLUMBIA, MD 21044
(OLD SIMPSONVILLE AREA)

ET 6056

RECEIVED

JUL 19 1993

LICENSES & PERMITS
DIVISION

AMENDMENT	
APPROVED BY	
DATE	
7-20-93	
7932 GUILFORD ROAD <i>Craig Anest</i>	
COLUMBIA, MD, 21044	
JULY 16, 1993	
☒ SUBJECT TO FIELD INSPECTION	
☐ SUBJECT TO COMMENTS ON PLANS	
☐ PRELIMINARY	☒ FINAL

MRS. CORBIN:

THIS LETTER IS IN REFERENCE TO OUR CONVERSATION OF JULY 14. I HAVE AN EXISTING PERMIT (#41728), I AM REQUESTING AN AMENDMENT TO IT IN ORDER TO ADD 2 DECKS. THE LAST INSPECTION ON THE PRESENT PERMIT WAS APRIL 8, 1993. THANK YOU VERY MUCH.

2 DECKS SIZES ARE ① 12' X 26' ② 6' X 20' B.L.M.

July 21, 1993

BLOSSIE L. MOORE

To: *Craig William*

*Director of Water + Sewer
Bureau of Environmental Health*


*Mr. William, per our conversation of
July 19, 1993 concerning a deck to be constructed
on my property, no pole will be closer
than 10' (feet) future plan for public water
is possible.*

Blossie L. Moore

* 7-21-93 Agreed to
revision. *Gene E. Nadeau*

AGREED AS PER ABOVE CONDITION
ON CONSTRUCTION 66' MIN DISTANCE
C. Williams

7-20-93
HALL CO. HEALTH

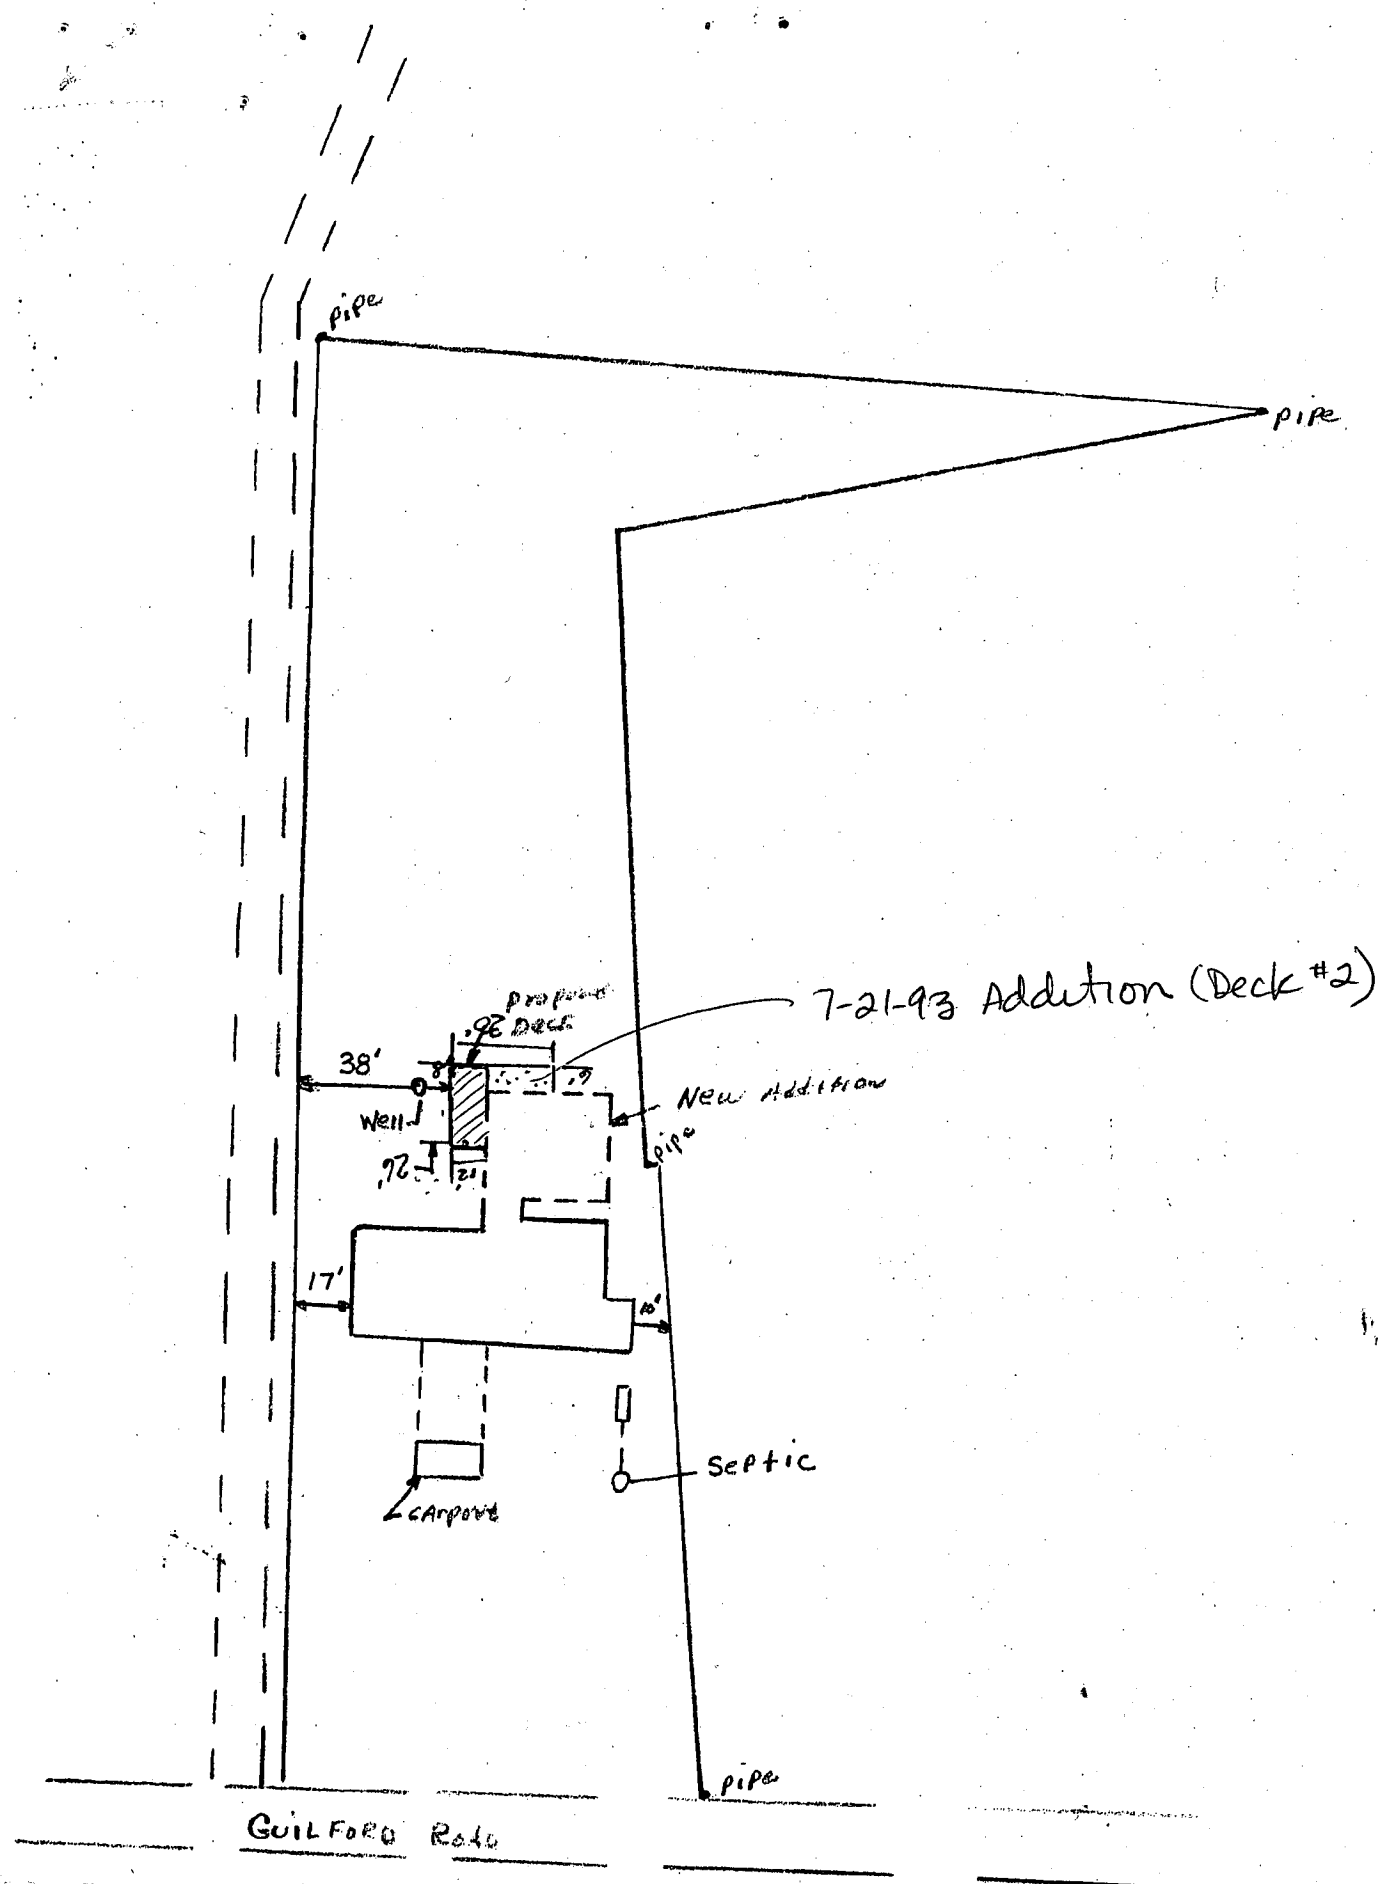

1 + Acre
7932 GUILFORD ROAD

SCALE .2" = 10'

EXISTING BUILDING PERMIT # 41728