

9/15/82
9:30 A.M.

PERMIT

SEWAGE DISPOSAL SYSTEM

MARYLAND STATE DEPARTMENT OF HEALTH

HOWARD COUNTY

INDEX

05-352371

APPROVED
7/10/82
RH

P 32151
A Repair

ELLICOTT CITY

DISTRICT 5th

DATE 9/7/82

Jenkins Brothers

IS PERMITTED TO INSTALL _____ ALTER X

ADDRESS 10439 Frederick Road, Ellicott City, Md. 21043 PHONE 465-6646

SUBDIVISION Kings Manor ROAD 11906 Queen Street - off LOT ? 10
Pindell School Road

PROPERTY OWNER Mrs. Sadie Jackson

ADDRESS 11906 Queen Street, Fulton, Maryland 20759

SPECIFICATIONS 3 BR

SEPTIC TANK CAPACITY _____ GALLONS

DRAIN FIELD _____ DEPTH _____ FEET, BOTTOM AREA _____ SQ. FT.

DEEP TRENCH 9 DEPTH _____ FEET, BOTTOM AREA _____ SQ. FT.

SEEPAGE PITS _____ ABSORBENT SIDE-WALL AREA _____ SQ. FT.

INLET PIPE _____ FT. BELOW ORIGINAL GRADE. MAXIMUM DEPTH _____ FT. BELOW ORIGINAL GRADE

EFFECTIVE DEPTH AT _____ FT. BELOW ORIGINAL GRADE.

LOCATE DISPOSAL AREA _____ FT. FROM _____ LOT LINE AND _____ FT. FROM _____ LOT LINE AS SEEN WHEN
FACING LOT FROM

REPAIR - Call for an appointment when ground is opened up and Sanitarian will

recommend the repair system.

9/9/82 DEEP DITCH 9FT DEEP 2FT WIDE
INET 4FT BELOW ORIGINAL GRADE, 5FT STONE

PLANS APPROVED BY Palmer F. Wine DATE 9/8/82

COVER NO WORK UNTIL INSPECTED AND APPROVED. 72FT LONG

NEITHER THE HOWARD COUNTY COUNCIL NOR THE HEALTH DEPARTMENT IS RESPONSIBLE FOR THE SUCCESSFUL OPERATION OF ANY SYSTEM.

NOTE: IF TRENCH IS USED CALL FOR INSPECTION BEFORE PLACING GRAVEL IN TRENCH.

NOTE: NO DRY WELL SHALL EXCEED 15 FOOT IN DIAMETER.


NOTE: ALL PIPE FROM HOUSE TO DISPOSAL AREA MUST BE CAST IRON.

PERMIT VOID AFTER THREE YEARS.

NOTE: INSTALL STAND PIPE ON SEPTIC TANK AND DRY WELL. STAND PIPES MUST BE 6 INCHES IN DIAMETER. CAST IRON, CONCRETE OR TERRA
COTTA ACCEPTED.

*INSTALLER IS RESPONSIBLE FOR OBTAINING FINAL APPROVAL ON THIS PERMIT.

58
13
71

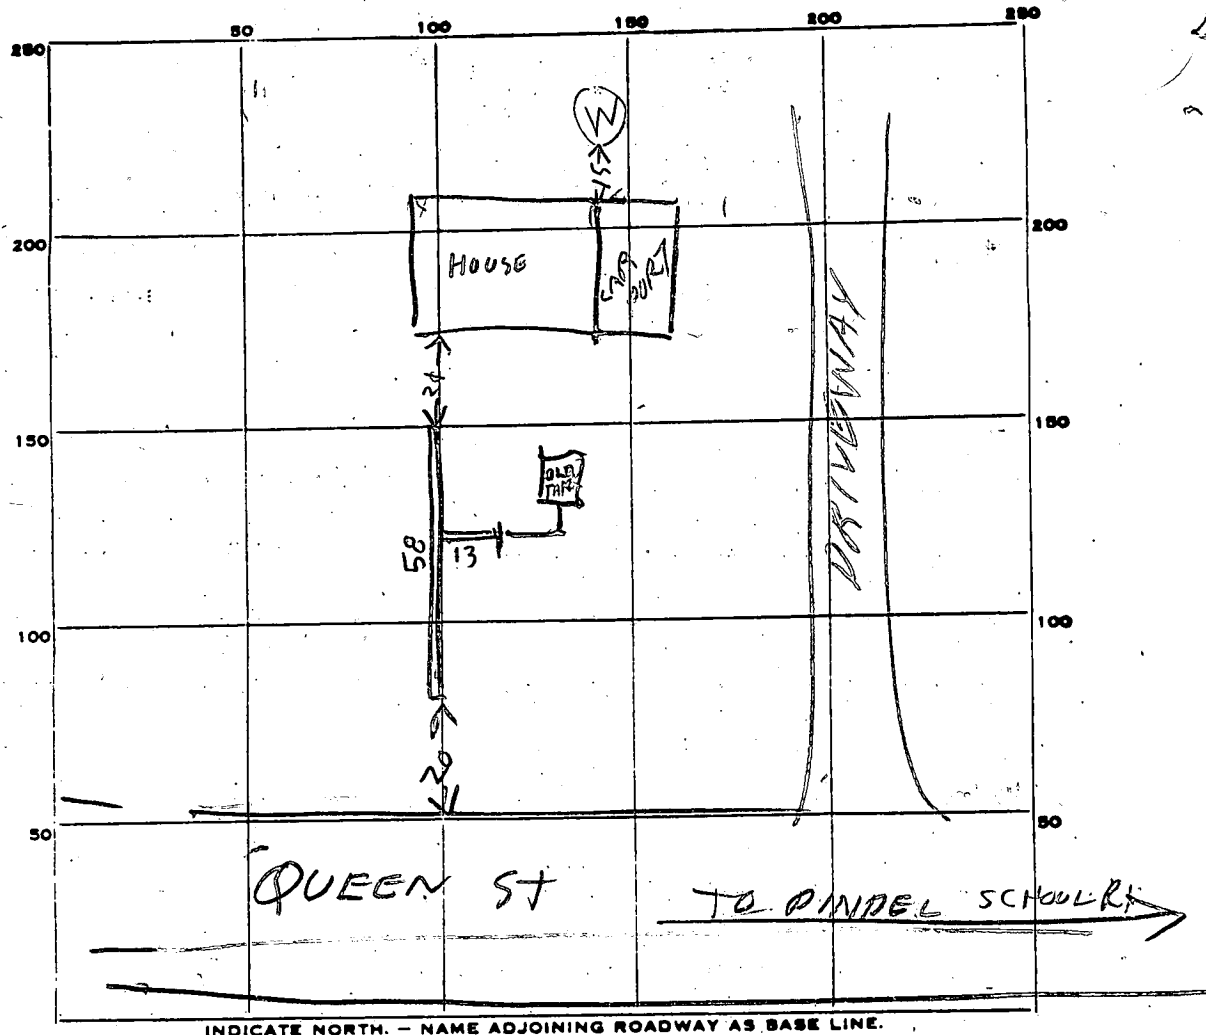

PERMIT CARD _____

SEPTIC TANK, LEVEL _____

CLEANOUTS _____

DISTRIBUTION BOX, LEVEL _____

DITCH
TILE FIELD, DEPTH 9 FT. TRENCH WIDTH 2 FT.

GRAVEL DEPTH 5 1/2 FT. IN. TOTAL LENGTH 71 FT.

NUMBER OF TRENCHES 1 TOTAL BOTTOM AREA 395

5.5
7.1
5.5
385
405

SEEPAGE PITS, INSIDE DIAMETER _____ FT. DEPTH BELOW INLET _____ FT.

ABSORBENT AREA _____ SQ. FT.

REMARKS 9/9/82^{AM} OK TO ADD STONE & PIPE
TO DITCH. DITCH IS HAS 3-5 FT OF CLAY ON
TOP & 4-6 FT PINK SAND ON BOTTOM. RH
9/9/82^{PM} STONE & PIPE ADDED

DATE SYSTEM APPROVED 9/9/82

INSPECTOR Raymond Hodges

APPLICATION

SEWAGE DISPOSAL TESTING

STATE OF MARYLAND - DEPARTMENT OF HEALTH AND MENTAL HYGIENE

HOWARD COUNTY HEALTH DEPARTMENT
ENVIRONMENTAL HEALTH SERVICES

P. O. BOX 476 ELLICOTT CITY, MARYLAND 21043
TELEPHONE: 992-2330

A _____

P Repair

DISTRICT 5th

DATE 9/7/82

TO: THE COUNTY HEALTH OFFICER
ELLICOTT CITY, MARYLAND

I, HEREBY, APPLY FOR THE NECESSARY TEST IN ORDER TO CONSTRUCT (OR RECONSTRUCT) A SEWAGE DISPOSAL SYSTEM.

PROPERTY OWNER Mrs. Sadie Jackson

ADDRESS 11906 Queen Street, Fulton, Md. 20759 PHONE _____

PROPERTY LOCATION:

SUBDIVISION Kings Manor LOT NO. (?)

ROAD AND DESCRIPTION 11906 Queen Street - off Pindell School Road

SIZE OF LOT (?) TYPE BLDG. Existing House
(NUMBER OF BEDROOMS)

THE SYSTEM INSTALLED UNDER THIS APPLICATION IS ACCEPTABLE ONLY UNTIL PUBLIC FACILITIES BECOME AVAILABLE. I FULLY UNDERSTAND THE FEE CONNECTED WITH THE FILING OF THIS PERC TEST APPLICATION IS NON-REFUNDABLE UNDER ANY CIRCUMSTANCES. I ALSO AGREE TO COMPLY WITH ALL M.O.S.H.A. REQUIREMENTS IN TESTING THIS LOT. /s/ Jenkins Brothers for Sadie Jackson

(SIGNATURE OF APPLICANT)


APPROVED BY _____ FOR _____ DATE _____

REJECTED BY _____ FOR _____ DATE _____

HOLD PENDING FURTHER TESTS _____ DATE _____

REASONS FOR REJECTION OR HOLDING _____

THIS IS NOT A PERMIT

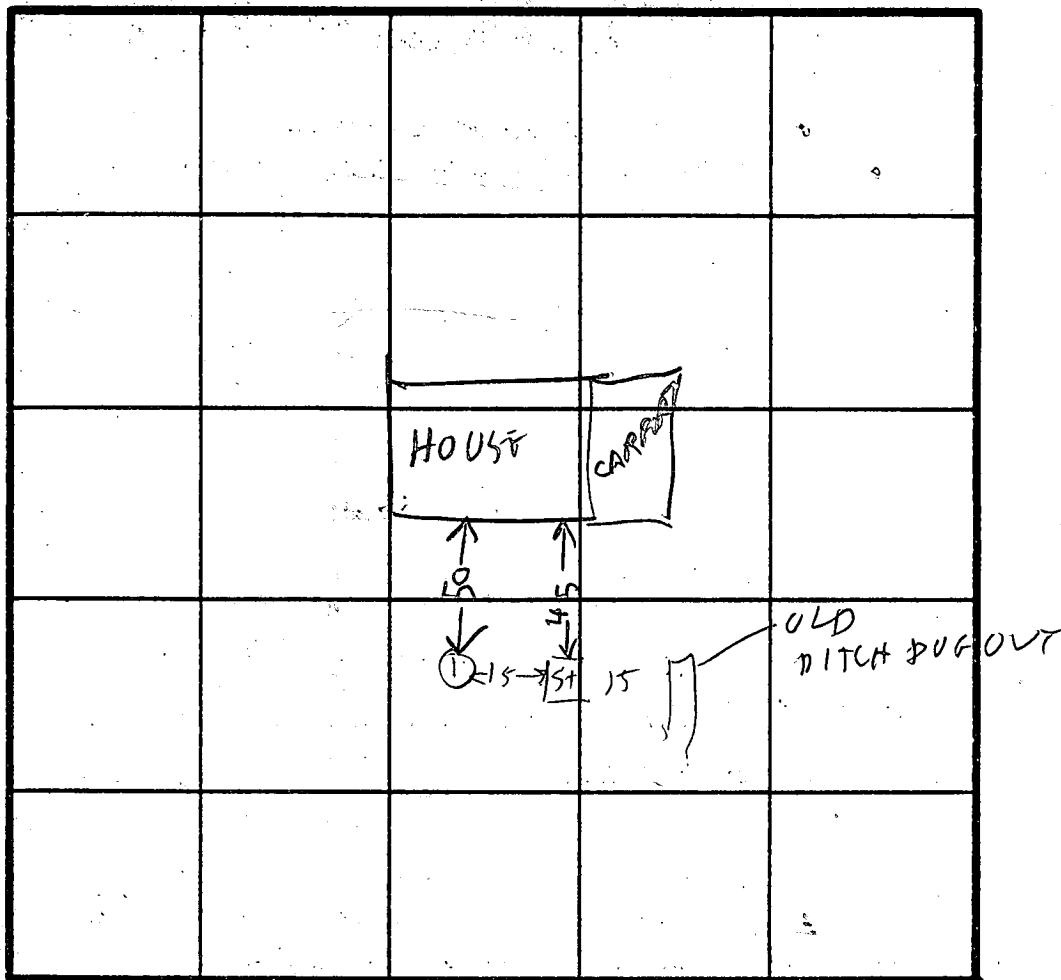[illegible]

TYPE OF SOIL

TESTED BY

OLD DW REPAIRED IN 1973 SHALLOW
OUT IN A 7.6 FT LEVEL BECAUSE
OF WATER AT 7 FT

ALSO PRESENT

PERMIT

SEWAGE DISPOSAL SYSTEM

MARYLAND STATE DEPARTMENT OF HEALTH

HOWARD COUNTY

ELLICOTT CITY

DISTRICT 5

DATE 9/10/64

INDEXED

approved
(9/21/64)
draw

P 09033

A 08022

A 32151

Elwood Scaggs

IS PERMITTED TO INSTALL ☒ ALTER

ADDRESS Laurel, Maryland

PHONE PA 5-0324

A SEWAGE DISPOSAL SYSTEM LOCATED AT _____

SUBDIVISION Kings Manor

ROAD Queen Street

LOT 10

PROPERTY OWNER Grover Horman

ADDRESS RFD 1, Laurel, Maryland

SPECIFICATIONS 3 bedrooms

DRAIN FIELD _____ DEPTH _____ FEET, BOTTOM AREA _____ SQ. FT.

SEEPAGE PITS _____ ABSORBENT SIDE-WALL AREA _____ SQ. FT.

SEPTIC TANK CAPACITY 750 GALLONS

FOR GARBAGE GRINDER, INCREASE DISPOSAL AREA 22% & TANK CAPACITY 50%.

OTHER Dry well - 300 sq. ft. side wall area below inlet pipe. Inlet
pipe must be 5 ft. below original grade.

Place dry well about 36 ft. from front lot line near center of lot.


PLANS APPROVED BY Donald W. Monaghan

DATE 2/13/64

FILL SEPTIC TANK AND DISTRIBUTION BOX WITH WATER BEFORE CALLING FOR AN INSPECTION. COVER NO WORK UNTIL INSPECTED AND APPROVED.

NEITHER THE HOWARD COUNTY COMMISSIONERS NOR THE HEALTH DEPARTMENT IS RESPONSIBLE FOR THE SUCCESSFUL OPERATION OF ANY SYSTEM.

A 32151
A 08022

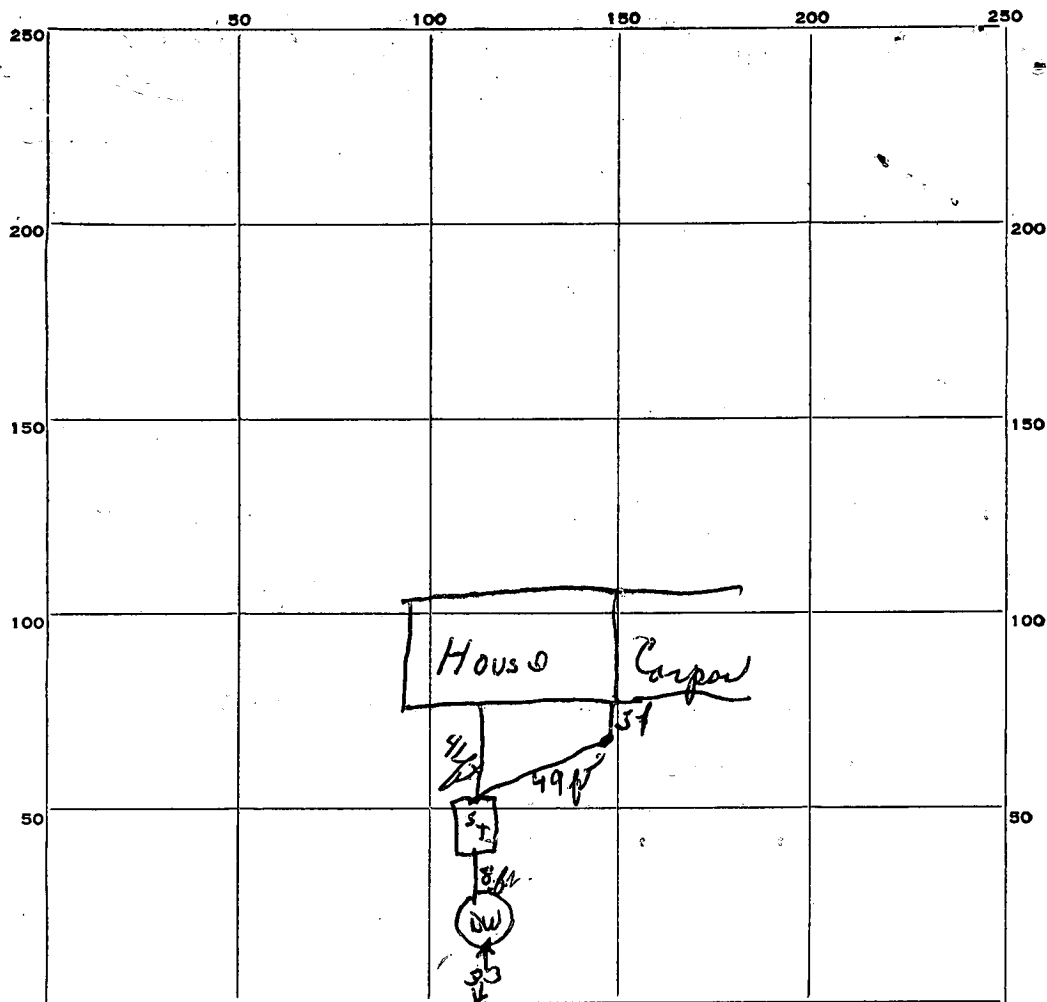

INDICATE NORTH. — NAME ADJOINING ROADWAY AS BASE LINE.

Queen Street

PERMIT CARD OK

SEPTIC TANK, LEVEL OK

CLEANOUTS OK

DISTRIBUTION BOX, LEVEL _____

TILE FIELD, DEPTH _____ FT. TRENCH WIDTH _____ FT.

GRAVEL DEPTH _____ IN. TOTAL LENGTH _____ FT.

NUMBER OF TRENCHES _____ TOTAL BOTTOM AREA _____

SEEPAGE PITS, INSIDE DIAMETER 9 FT. DEPTH BELOW INLET 10 FT.

ABSORBENT AREA 982 + SQ. FT.

REMARKS 7/21/64 - Wall to Wall diameter is 12 ft x 10 depth = 376 sq ft

DATE SYSTEM APPROVED 9/21/64

INSPECTOR DW. Monag

APPLICATION

SEWAGE DISPOSAL TESTING

MARYLAND STATE DEPARTMENT OF HEALTH

HOWARD COUNTY

ELLICOTT CITY

DISTRICT 5

DATE 2-10-64

*Septic Tank - 750 gals.
Dry Well - 300 sq ft red wall area below inlet pipe. Inlet
pipe must be 5 ft below original grade.
Place Dry Well about 36 ft from front lot line near
center of lot.*

TO: THE COUNTY HEALTH OFFICER
ELLICOTT CITY, MARYLAND

I, HEREBY, APPLY FOR THE NECESSARY TESTS IN ORDER TO CONSTRUCT (OR RECONSTRUCT) A SEWAGE DISPOSAL SYSTEM.

PROPERTY OWNER Shaver Norman

ADDRESS RFD 1 Laurel PHONE _____

PROPERTY LOCATION:

SUBDIVISION Kings Manor LOT NO. 10

ROAD AND DESCRIPTION Queen Street

OCCUPANT _____ PHONE _____

PERSON TO CONSTRUCT SYSTEM _____

ADDRESS _____ PHONE _____

SIZE OF LOT 1 acre TYPE BLDG. 3 NUMBER OF BEDROOMS

IF NOT SINGLE RESIDENCE DESCRIBE _____

SIGNATURE OF APPLICANT David Scapp


APPROVED BY Donald W. Monaghan FOR Dry Well DATE 2/13/64

REJECTED BY _____ FOR _____ DATE _____

HOLD PENDING FURTHER TESTS _____ DATE _____

REASONS FOR REJECTION OR HOLDING _____

THIS IS NOT A PERMIT

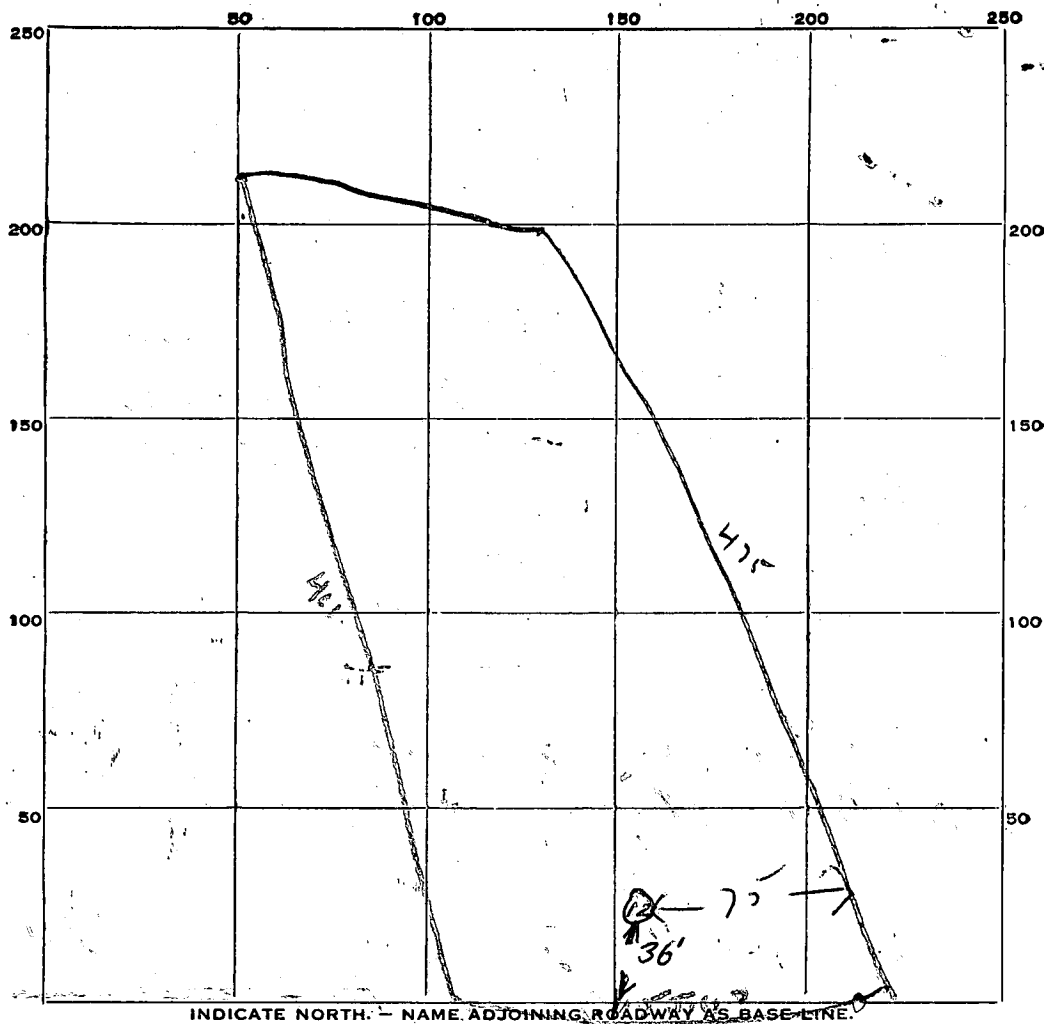

Queen Street

DATE	TEST NO.	DEPTH	PRE-WET		TEST - 1" DROP		TIME
			START	STOP	START	STOP	
2/13/64	1	9 ft.	10:12	10:19	10:17	10:25	8 min
	2	4 1/2 ft	10:13	stop	test - slow peak.		

SOIL AUGER FINDING Good soil starts at 5 ft.

TESTED BY RDF PWM 2/13/64

REMARKS

ALSO PRESENT Edward Jagggs

LOT NO. 10