

1/31/83
9:30 A.M.

1/18/83
~11:30

01-159356

PERMIT

SEWAGE DISPOSAL SYSTEM

MARYLAND STATE DEPARTMENT OF HEALTH

HOWARD COUNTY

BUREAU OF ENVIRONMENTAL HEALTH
992-2330

P 38387

A REPAIR

APPROVED 1/18/83

RH/CW

ELLICOTT CITY

DISTRICT 1st

DATE Dec. 28, 1892

ON RT 1 - JUST NORTH & OPPOSITE
ROUTE 100. CW

INDEXED

Mr. Thomas G. Harris

IS PERMITTED TO INSTALL _____ ALTER ☒

ADDRESS P. O. Box 6 Monkton, Monkton, Md. 21111 PHONE 472-4613

SUBDIVISION _____ ROAD 7965 Washington Blvd LOT _____

PROPERTY OWNER Ernest L. Binder, Sr.

ADDRESS 7065 Washington Blvd. Jessup, Md.

IF GARBAGE GRINDER IS USED INCREASE SEPTIC TANK CAPACITY BY 50% AND ABSORPTION AREA BY 22%.

GARBAGE GRINDER? YES _____ NO ☒

SEPTIC TANK CAPACITY _____ GALLONS NUMBER OF BEDROOMS _____

REPAIR - CALL FOR INSPECTION WHEN GROUND IS OPENED UP SO SANITARIAN CAN
RECOMMEND REPAIR.

PLANS APPROVED BY Palmer F. Wine DATE December 28, 1982

COVER NO WORK UNTIL INSPECTED AND APPROVED.

NEITHER THE HOWARD COUNTY COUNCIL NOR THE HEALTH DEPARTMENT IS RESPONSIBLE FOR THE SUCCESSFUL OPERATION OF ANY SYSTEM.

NOTE: IF TRENCH IS USED CALL FOR INSPECTION BEFORE AND AFTER PLACING GRAVEL IN TRENCH.

NOTE: NO DRY WELL SHALL EXCEED 15 FOOT IN DIAMETER. NO ABSORPTION TRENCH TO EXCEED 100 FEET IN LENGTH.

NOTE: AL₂ PIPE FROM HOUSE TO SEPTIC TANK MUST BE CAST IRON OR SCHEDULE 40 PVC OR ABS.

PERMIT VOID AFTER THREE YEARS.

NOTE: INSTALL STAND PIPE ON SEPTIC TANK AND DRY WELL. STAND PIPES MUST BE 6 INCHES IN DIAMETER. CAST IRON, CONCRETE OR TERRA COTTA, OR
PVC OR ABS ACCEPTED. IF TOP OF SEPTIC TANK IS DEEPER THAN 3 FEET MANHOLE TO GRADE REQUIRED.

BLDG. PERMIT SIGNED
AND RETURNED 1/17/83

52104


*INSTALLER IS RESPONSIBLE FOR OBTAINING FINAL APROVAL ON THIS PERMIT

*CALL 992-2330 FOR INSPECTION OF SEPTIC SYSTEMS.

EH - 2-1082

P 38387

OBSERVED
1-6-83
CLW

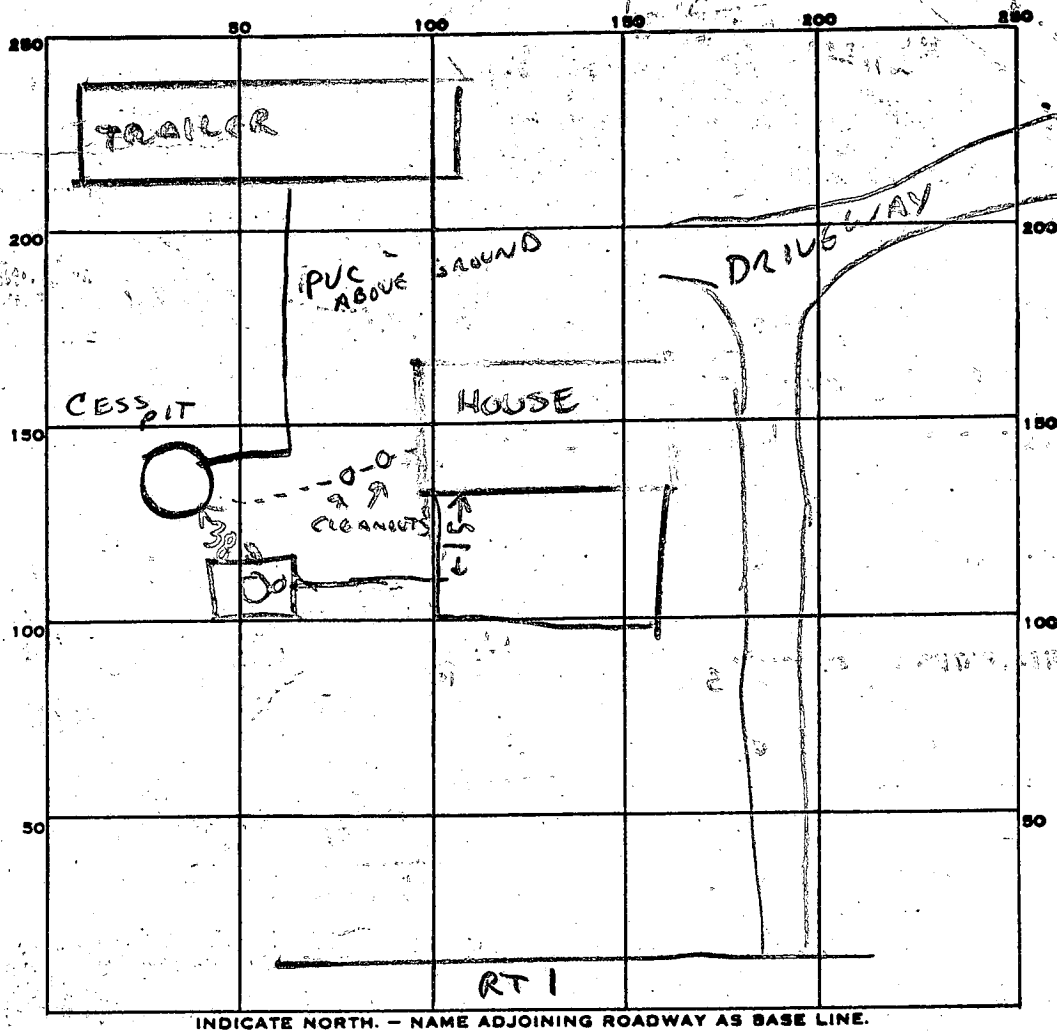

PERMIT CARD _____

SEPTIC TANK, LEVEL 15001

CLEANOUTS OK MANHOLE

DISTRIBUTION BOX, LEVEL _____

TILE FIELD, DEPTH _____ FT. TRENCH WIDTH _____ FT.

GRAVEL DEPTH _____ IN. TOTAL LENGTH _____ FT.

NUMBER OF TRENCHES _____ TOTAL BOTTOM AREA _____

SEEPAGE PITS, INSIDE DIAMETER _____ FT. DEPTH BELOW INLET _____ FT.

ABSORBENT AREA _____ SQ. FT.

REMARKS 1/11/83 SEE COMPLAINT SHEET FOR PERC RESULTS

1/18/83 ADDITIONAL PERC HOLES DUG & INSPECTED BY HARRIS.
DECIDED HOLES UNSATISFACTORY SO SEALED TANK INSTALLED
OK TO COVER SEALED TANK & HOUSE SEWER. FILL IN
CESS POOL & INSTALL AN ALARM DEVICE ON THE TANK & CALL RN
NO FINAL INSPECTION REQUEST AS OF 7/17/95 - INDEX AS APPROVED (CLW)

DATE SYSTEM APPROVED _____ INSPECTOR _____

APPLICATION

HOWARD COUNTY

PERMIT APPLICATION

DEPARTMENT OF PUBLIC WORKS
BUREAU OF INSPECTIONS & PERMITS
COUNTY OFFICE BUILDING, ELLICOTT CITY, MARYLAND 21043

SERIAL NUMBER

52104

PERMIT NUMBER

DATE ISSUED

BUILDING ADDRESS (HOUSE NO., STREET, TOWN OR AREA)

100 WASHINGTON BLVD.

LOT NO. (OR TAX MAP & PARCEL NO.)

100

BLOCK NO.

LIBER

FOLIO

ZONE

ZONE MAP

ELEC. DIST.

CENSUS TR.

OWNER'S NAME AND ADDRESS

100 WASHINGTON BLVD.

100

OCCUPANT'S NAME AND ADDRESS

100 WASHINGTON BLVD.

100

ARCHITECT OR ENGINEER'S NAME AND ADDRESS

100 WASHINGTON BLVD.

100

CONTRACTOR'S NAME AND ADDRESS

100 WASHINGTON BLVD.

100

INTENDED USE OF STRUCTURE (BE SPECIFIC)

100 WASHINGTON BLVD.

100

ST. CONSTRUCTION COST

100

LICENSE NUMBER

100

PERMIT FEE

100

ACK

CONDITIONS (IF ANY)

100

CHECKS payable to

DIRECTOR OF FINANCE OF HOWARD COUNTY

100

CAUTION

If begun construction before a permit placard has been issued and

displayed on the job is a violation of the law

and no occupancy permit must be applied for two weeks before it

will be issued

IMPORTANT: PLEASE SHOW ZIP CODES AND

AREA CODES WHEREVER REQUIRED.

P-69

QUALIFIED INSPECTOR OF CONSTRUCTION

SEAL

Application is hereby made for a permit to (INDICATE ONE)
ERECT USE ALTER EXTEND RAZE MOVE the (INDICATE
ONE) PERMANENT TEMPORARY structure described.

DESCRIPTION OF WORK

RED BRICK BLDG. 100 W. WASH. BLVD. ELLICOTT CITY, MD. 21043
WHITE, FIRE DAMAGE IS BEING RE-PAINTED. NOT FULLY BUILT IN 1910-11.

SIZE OF BLDG.

FRONT

DEPTH

HEIGHT

TYPE OF BLDG.

AREA

VOLUME

ROOF

B. ROOMS

ROOMS

BATHS

FIREPLACES

FOOTINGS

FOUNDATION

S. WALLS

UTILITIES

WATER/WELL

SEWER/SEPTIC

GAS

ELECTRICITY

TYPE OF HEAT

AC

I have carefully examined and read this application and know the same is true and correct, and that in doing this work, all provisions of Howard County Ordinances and the State Laws of Maryland will be complied with, whether specified or not; and I will notify the Bureau of Inspections, and Permit twenty-four hours in advance when I am ready for the inspections called for elsewhere in this application; and that no work will be covered up until such inspections have been complied with.

SIGNATURE
DATE

TITLE
DATE

FOR OFFICE USE ONLY

DISTANCE IN FEET FROM R/W LINE TO FRONT BUILDING LINE

SIDE YARD (DISTANCE IN FEET FROM SIDE BLDG. LINE TO SIDE PROPERTY LINE)

DISTANCE IN FEET FROM SIDE STREET R/W LINE

SIDE BUILDING LINE

DISTANCE IN FEET, REAR YD. REQUIRING SET

ACK (CORNER LOT ONLY)

CONDITIONS (IF ANY)

100

CHECKS payable to

DIRECTOR OF FINANCE OF HOWARD COUNTY

100

CAUTION

If begun construction before a permit placard has been issued and

displayed on the job is a violation of the law

and no occupancy permit must be applied for two weeks before it

will be issued

IMPORTANT: PLEASE SHOW ZIP CODES AND

AREA CODES WHEREVER REQUIRED.

P-69

FUNCTION

DATE

SIGNATURE APPROVAL

ZONING/PLANNING

1/1/83

SHA

ROADS & STREETS

BUILDING OFFICIAL

WATER & SEWER

HEALTH DEPT.

1/7/83

Grand Shuman

FIRE PROTECTION

STORM WATER MGM.

1/7/83

Grand Shuman

APPROVED

DATE

Distribution of Copies:
White - Building Official
Green - Planning & Zoning

Yellow - Engineering
Pink - Health Dept.
Gold - S.H.A.

E.C. Pinda Jr

7065 Washington Blvd

1/11/83

Hold for Review - Probably
Sealed Tank only answer
per R H. But discuss with FS
for any ideas.

(8-1-472-4613)

1/12/83 T.C. & Mr. Harris Recommend more testing to right side of house or
install sealed tank & alarm device T.C.

1/18/83 Sealed Tank Installed

032387

FILE SEWAGE DISPOSAL PERMIT DATE REPORTED _____

PROPERTY OWNER EL BINDER SR 7065 WASH BLVD

P. O. ADDRESS _____

DIRECTIONS TO PROPERTY WASH BLVD OPPOSITE

CLAYTON'S BAR REPAIR OF OLD HOUSE

INFORMANT SEE OTHER SIDE FOR DRAWING

DATE	NOLE #	DEPTH	START	STOP	START	STOP	TIME
1/11/83	1	9	1208	1208 1/2	1208 1/2	1210	1 1/2 MIN
	4	3	1219	1202	little per SLOW		


CONDITION FOUND:

1/18/83 "Enta Hole Dec & inspected
by Harris. Hole Unstable
so sealed Tank Installed
BH.


ACTION TAKEN: _____

FINAL DISPOSITION: _____

(7) ALL CLAY WATER EFT

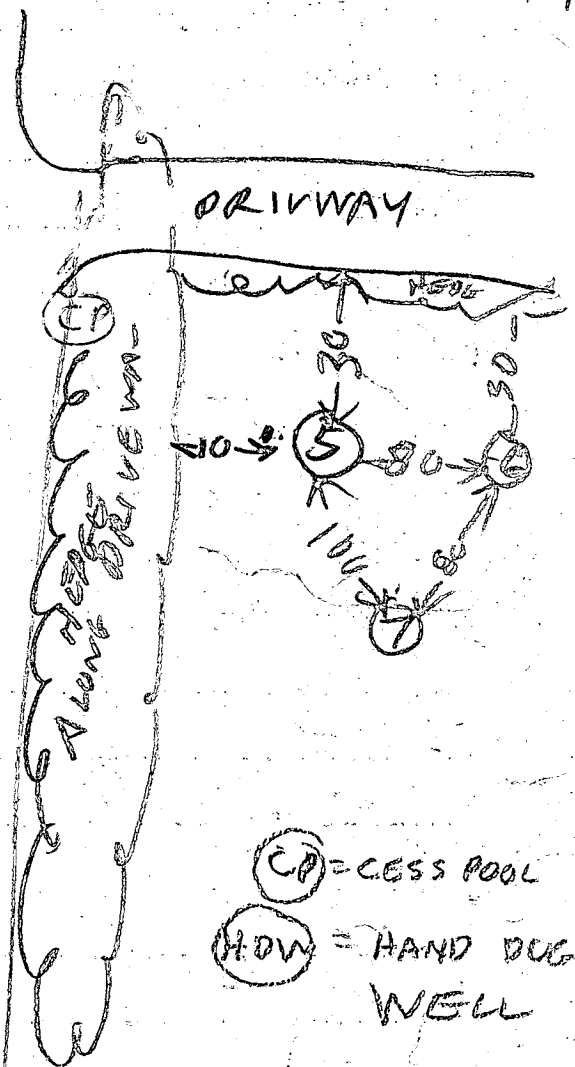

(CP) = CESS POOL
(HOW) = HAND DUG WELL

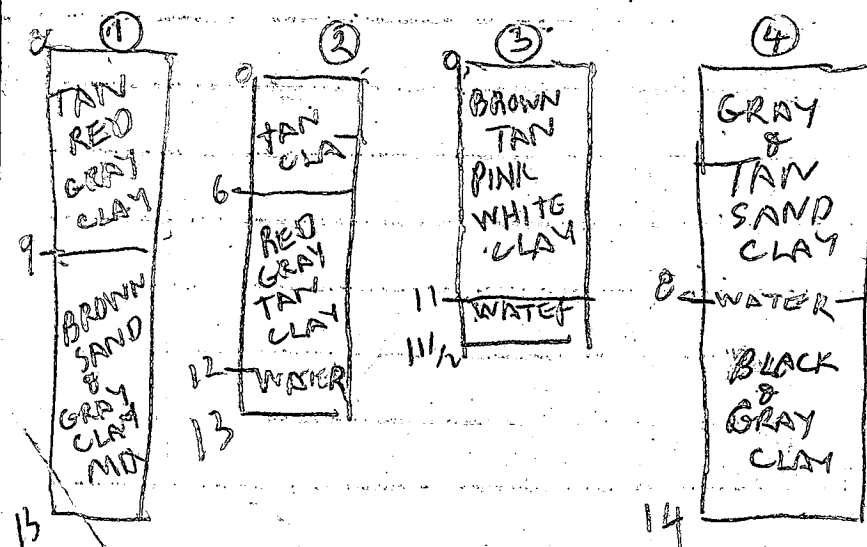

GROUP ONE
ELEVATION OF HOLDS

④ = HIGHEST
①-② MEDIUM
③ LOWEST

GROUP TWO
ELEVATION OF HOLES

5 HIGHEST
6 MEDIUM
5 LOW

~~Treated By R. Hodge~~
Also present HARRIS