

3/4/83 11 a.m.
between 12 noon
and 1 p.m.

APPROVED
3/4/83 RH
P 32519
A Repair

PERMIT

SEWAGE DISPOSAL SYSTEM

MARYLAND STATE DEPARTMENT OF HEALTH

HOWARD COUNTY
BUREAU OF ENVIRONMENTAL HEALTH
992-2330

03-287408

ELLICOTT CITY
DISTRICT 3rd

DATE 3/3/83

INDEX

Jack Fyock

IS PERMITTED TO INSTALL _____ ALTER ☒

ADDRESS 13775 Triadelphia Road, Glenelg, Md. 21737 PHONE 988-9270

SUBDIVISION _____ ROAD 671 River Road LOT _____

PROPERTY OWNER Cathy Fournier

ADDRESS 671 River Road, Sykesville, Maryland 21784 Phone: 442-2823

IF GARBAGE GRINDER IS USED INCREASE SEPTIC TANK CAPACITY BY 50% AND ABSORPTION AREA BY 22%.

GARBAGE GRINDER? YES _____ NO _____

SEPTIC TANK CAPACITY _____ GALLONS NUMBER OF BEDROOMS _____

REPAIR - Call for an appointment when ground is opened up and Sanitarian will
recommend the repair system.

Liba #90 Folger OLIVER HOLMES USED TO
OWN THIS PROPERTY HE BUILT
HOUSE IN 1965 or 1966 & THAT
IS THE ORIGINAL SYSTEM
MRS FOURNIER MOVED IN 1976
1 2194

PLANS APPROVED BY Palmer F. Wine DATE 3/3/83

COVER NO WORK UNTIL INSPECTED AND APPROVED.

NEITHER THE HOWARD COUNTY COUNCIL NOR THE HEALTH DEPARTMENT IS RESPONSIBLE FOR THE SUCCESSFUL OPERATION OF ANY SYSTEM.

NOTE: IF TRENCH IS USED CALL FOR INSPECTION BEFORE AND AFTER PLACING GRAVEL IN TRENCH.

NOTE: NO DRY WELL SHALL EXCEED 15 FOOT IN DIAMETER. NO ABSORPTION TRENCH TO EXCEED 100 FEET IN LENGTH.

NOTE: ALL PIPE FROM HOUSE TO SEPTIC TANK MUST BE CAST IRON OR SCHEDULE 40 PVC OR ABS.

PERMIT VOID AFTER THREE YEARS.

NOTE: INSTALL STAND PIPE ON SEPTIC TANK AND DRY WELL. STAND PIPES MUST BE 6 INCHES IN DIAMETER. CAST IRON, CONCRETE OR TERRA COTTA, OR
PVC OR ABS ACCEPTED. IF TOP OF SEPTIC TANK IS DEEPER THAN 3 FEET MANHOLE TO GRADE REQUIRED.

B.L.D.G. PERMIT SIGNED
AND RETURNED 11/21/85
Seal # 67803
Family room
Living room

*INSTALLER IS RESPONSIBLE FOR OBTAINING FINAL APPROVAL ON THIS PERMIT


*CALL 992-2330 FOR INSPECTION OF SEPTIC SYSTEMS.

EH - 2-1082

X 032519

RIVER RD

①
BROWN CLAY
PINK & BROWN SAND

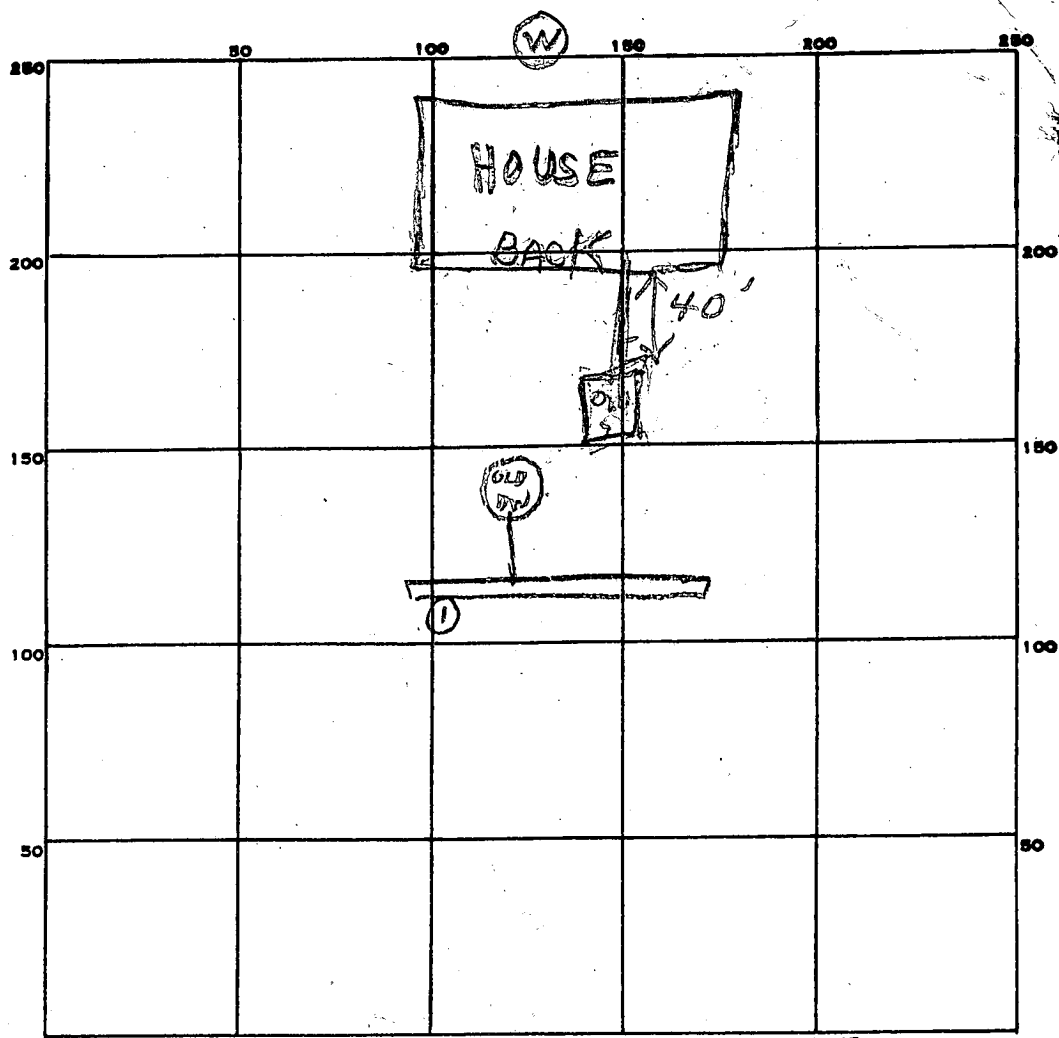

INDICATE NORTH. - NAME ADJOINING ROADWAY AS BASE LINE.

PERMIT CARD _____
SEPTIC TANK, LEVEL _____ CLEANOUTS _____
DISTRIBUTION BOX, LEVEL _____
TILE FIELD, DEPTH 12 FT. TRENCH WIDTH 2 FT.
GRAVEL DEPTH 8.5 IN. TOTAL LENGTH 50 45 FT.
NUMBER OF TRENCHES 1 TOTAL BOTTOM AREA 382
SEEPAGE PITS, INSIDE DIAMETER _____ FT. DEPTH BELOW INLET _____ FT.
ABSORBENT AREA 1130 SQ. FT.

REMARKS 3/4/83 - DITCH DUG 12 FT LPOK OK
HOME OWNER LEFT NOTE ABOUT DEPTH OF DITCH
ADD STONE TO DITCH
3/4/83 STONE ADDED BUT ONLY ENOUGH
FOR 45 FT OF DITCH. BUT STILL DITCH
IS BIG ENOUGH

DATE SYSTEM APPROVED 3/4/83 INSPECTOR Raymond G. Hodge

671 River Road
Lykesville, Maryland 21781
March 5, 1983


Howard County
Department of Health
Ellicott City, Maryland 21043

Gentlemen:

This is to state that Tyack Septic Systems dug a trench
50' long and 12' deep and a 15' vertical hole that was dry.

Dated this 5th day of March 1983.

Catherine B. Fournier (Property Owner)
671 River Rd.
Lykesville, Md 21781

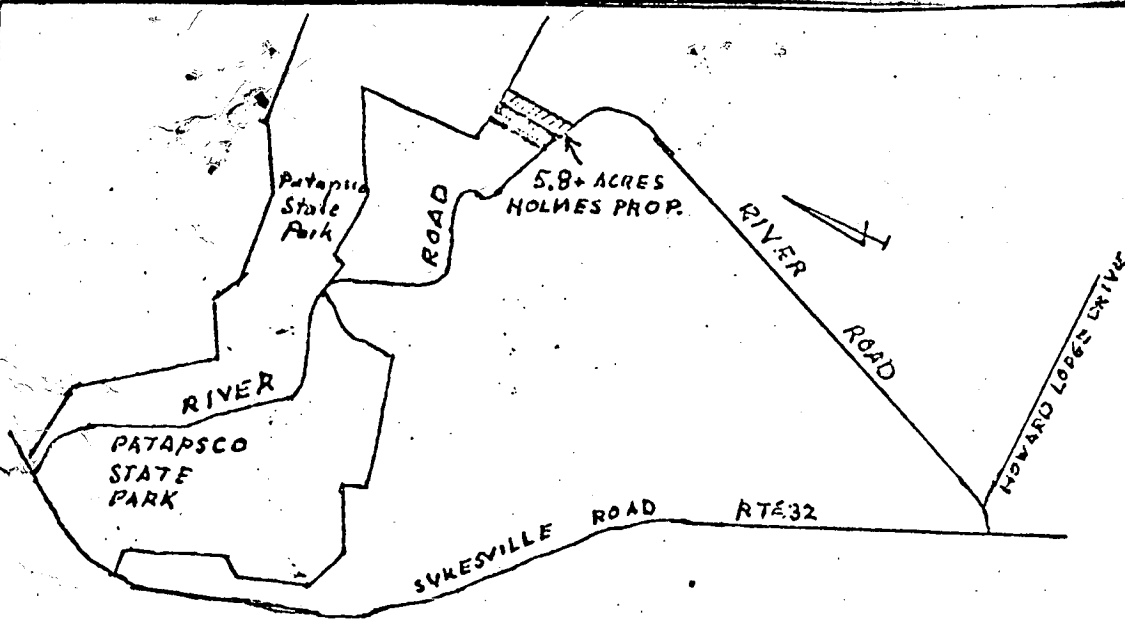

VICINITY MAP
1" = 2,000'

11-7-85
NO ONE HOME
UNABLE TO SEE SEPTIC
SYSTEM FROM DRIVEWAY
WELL LOCATED IN FRONT
S. AWE

TOTAL NO OF LOTS = 1
TOTAL AREA = 130,680.59 FT.
TOTAL AREA DEDICATED = 12,090

THE LOT SHOWN HEREON, COMPLIES
WITH MINIMUM OWNERSHIP, WIDTH AND
LOT AREA AS REQUIRED BY THE
MARYLAND STATE DEPARTMENT OF
HEALTH REGULATIONS


OWNERS: O. DAVID HOLMES and
CATHERINE HOLMES, wife
TITLE REF LIBER 490 FOLIO 424

WEST FRIENDSHIP HQ 3
HOWARD COUNTY
STATE TAX MAP - PARCEL NO 5

ZONED R-40

11/18/85
SEE OTHER SIDE
FOR COMMENTS

MARYLAND STATE PARK

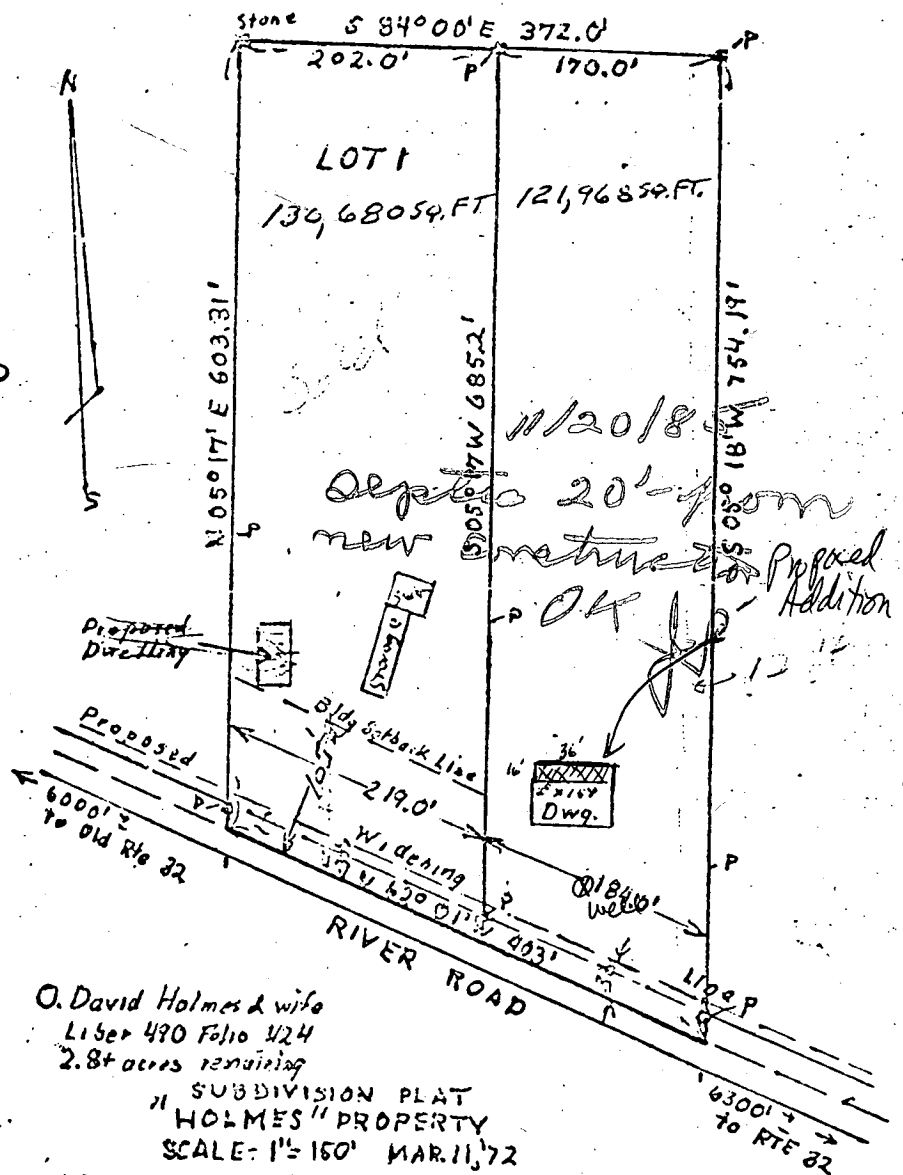

O. David Holmes & wife
Liber 490 Folio 424
2.8+ acres remaining
SUBDIVISION PLAT
"HOLMES" PROPERTY
SCALE: 1" = 150' MAR. 11, '72
APPROVED: PRIVATE WATER AND PRIVATE SEWER

COUNTY HEALTH OFFICER DATE
APPROVED: DIVISION OF LAND DEVELOPEMENT AND
TRANSPORTATION PLANNING

PLANNING DIRECTOR DATE

OWNERS CERTIFICATE

We, the undersigned owners of the property shown
hereon, our heirs or assigns, adopt this plan of
subdivision and do hereby establish the building
setback restriction line shown hereon in order to
comply with the general plan of Highways of
Howard County.

O. David Holmes

Catherine Holmes



ROBERT C. NORRIS #759
REGISTERED LAND SURVEYOR
OLD COURT ROAD, BALTO, MD 21207

Robert C. Norris #759, 3-11-72

11/18/85

NO ONE HOME NO SEWAGE SEEN.
NOWELL SEEN NO SEPTIC CLEWNOU
SEEN. LOOSE DOGS IN AREA
SUGGEST CONTACTING HOME OWNERS
THERE IS A POSSIBILITY THAT TANK
COULD BE TOO CLOSE TO ADDITION

BH