

4/25/83
P.M. please

REPAIR APPROVED
4-26-83 C. Williams

PERMIT

SEWAGE DISPOSAL SYSTEM

MARYLAND STATE DEPARTMENT OF HEALTH

HOWARD COUNTY

BUREAU OF ENVIRONMENTAL HEALTH

992-2330

ELLICOTT CITY

DISTRICT

DATE 4/25/83

INDEX

Jack Fyock

IS PERMITTED TO INSTALL ☐ ALTER ☒

ADDRESS 13775 Triadelphia Road, Glenelg, MD 21737 PHONE 988-9270

SUBDIVISION ROAD 12533 Route 216 LOT

PROPERTY OWNER Masters

ADDRESS 12533 Route 216, Highland, MD Phone: 854-3233

IF GARBAGE GRINDER IS USED INCREASE SEPTIC TANK CAPACITY BY 50% AND ABSORPTION AREA BY 22%.

GARBAGE GRINDER? YES ☐ NO ☐

SEPTIC TANK CAPACITY GALLONS NUMBER OF BEDROOMS

REPAIR-CALL FOR INSPECTION WHEN GROUND IS OPENED UP SO SANITARIAN CAN

RECOMMEND REPAIR.

PLANS APPROVED BY Palmer F. Wine DATE April 25, 1983

COVER NO WORK UNTIL INSPECTED AND APPROVED.

NEITHER THE HOWARD COUNTY COUNCIL NOR THE HEALTH DEPARTMENT IS RESPONSIBLE FOR THE SUCCESSFUL OPERATION OF ANY SYSTEM.

NOTE: IF TRENCH IS USED CALL FOR INSPECTION BEFORE AND AFTER PLACING GRAVEL IN TRENCH.

NOTE: NO DRY WELL SHALL EXCEED 15 FOOT IN DIAMETER. NO ABSORPTION TRENCH TO EXCEED 100 FEET IN LENGTH.

NOTE: ALL PIPE FROM HOUSE TO SEPTIC TANK MUST BE CAST IRON OR SCHEDULE 40 PVC OR ABS.

PERMIT VOID AFTER THREE YEARS.


NOTE: INSTALL STAND PIPE ON SEPTIC TANK AND DRY WELL. STAND PIPES MUST BE 6 INCHES IN DIAMETER. CAST IRON, CONCRETE OR TERRA COTTA, OR PVC OR ABS ACCEPTED. IF TOP OF SEPTIC TANK IS DEEPER THAN 3 FEET MANHOLE TO GRADE REQUIRED.

*INSTALLER IS RESPONSIBLE FOR OBTAINING FINAL APROVAL ON THIS PERMIT

*CALL 992-2330 FOR INSPECTION OF SEPTIC SYSTEMS.

EH - 2-1082

X P339690

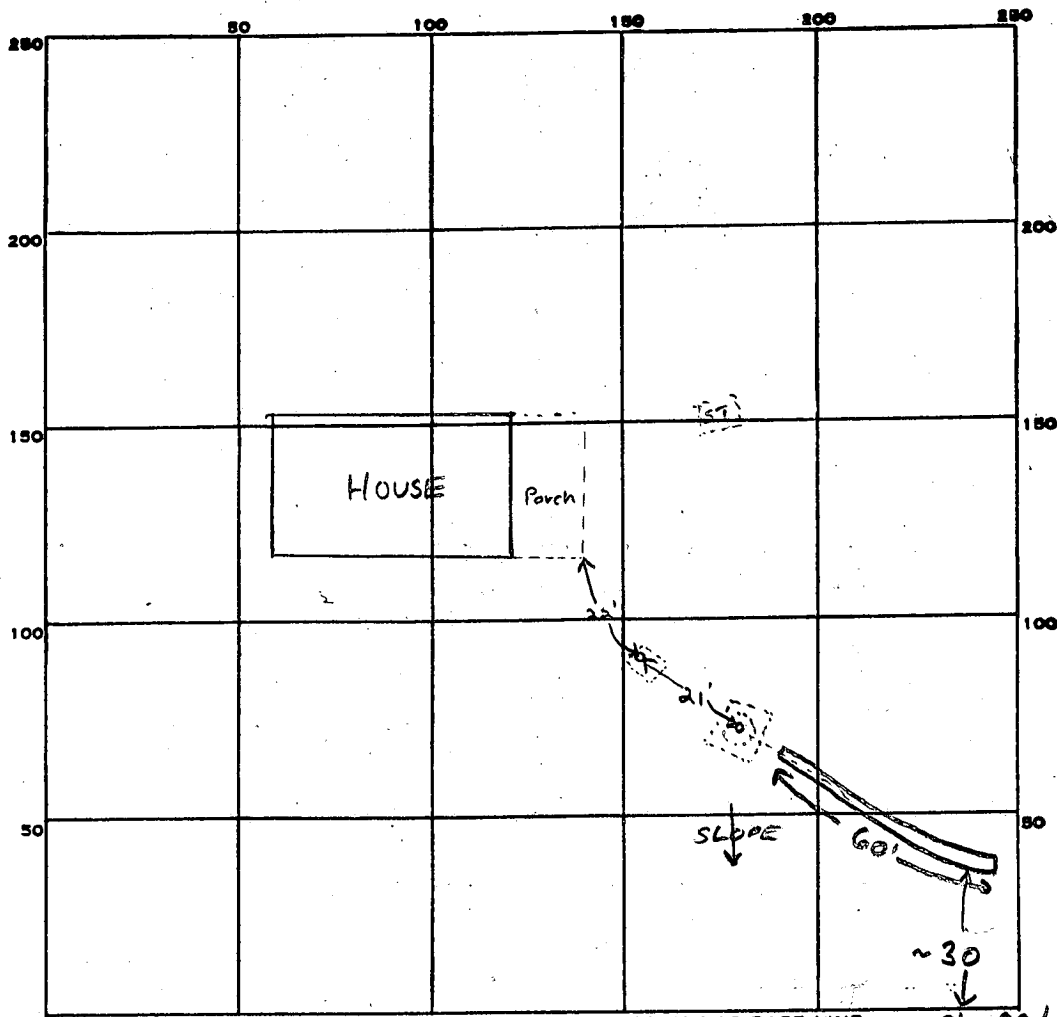

PERMIT CARD ☒

SEPTIC TANK, LEVEL existing

CLEANOUTS

S.T.

D.W.

existing

existing

DISTRIBUTION BOX, LEVEL n.a.

TILE FIELD, DEPTH 12 FT. TRENCH WIDTH 2 FT.

GRAVEL DEPTH 5 ^{6' avg.} 7 FT. TOTAL LENGTH 60 FT.

NUMBER OF TRENCHES 1

ONE SIDE WALL TOTAL BOTTOM AREA ± 360 ~~sq~~

SEEPAGE PITS, INSIDE DIAMETER _____ FT. DEPTH BELOW INLET _____ FT.

ABSORBENT AREA _____ SQ. FT.

REMARKS 4/25/83 ^{3:50 pm} Existing drywell for basement fixtures only & kitchen sink per owner. OK to finish trench & cover it as rain likely tonight F.S.

4-26-83 TRENCH COVERED. CW

DATE SYSTEM APPROVED

4-26-83

INSPECTOR

CW

April 25, 1983

I, the property owner, at 12533
Route 216, Highland, Maryland
certify that the trench dug by
Fryock Septic Service is 12 feet
deep.

Lydia B. Masters