

PERMIT

SEWAGE DISPOSAL SYSTEM

DEPARTMENT OF HEALTH AND MENTAL HYGIENE

HOWARD COUNTY HEALTH DEPARTMENT
BUREAU OF ENVIRONMENTAL HEALTH

~~XXXXXX~~ 410-313-2640

P 511001

A 31816

DISTRICT 5th

DATE 9-22-98

DATE SYSTEM APPROVED 10/2/98

INSPECTOR [Signature]

INDEXED

05-361265

BWT Inc.

IS PERMITTED TO INSTALL ☒ ALTER

ADDRESS 11974 Route 216 Fulton, MD 20759 PHONE (301) 498-6138

SUBDIVISION LOT ROAD 11960 Scaggsville Road

PROPERTY OWNER Ray Rosenbloom

ADDRESS

SEPTIC TANK CAPACITY ~~1000~~ 1500 gal. *Midstream used - 9/29/98* GALLONS

NUMBER OF BEDROOMS 3 *4' - 7' = 3' gravel depth*

180 SQUARE FEET PER BEDROOM *÷ 3 = 60 x 3 = 180*

LINEAR FEET OF TRENCH REQUIRED 135

TRENCHES - Trench to be 2 feet wide. Inlet 3 feet below original grade. Bottom maximum depth 7 feet below original grade. Effective area begins at 3 feet below original grade. 4 feet of stone below distribution pipe.

LOCATION - Place the distribution box 282 feet down the right lot line and 150 feet off this same lot line as seen when facing the lot from Scaggsville Road. Run trenches on contour towards the right lot line.

NOTES - No trench to exceed 100 feet in length. Provide 6" - 8" diameter cleanout and cap to grade or above on septic tank. *OK [Signature] 6-15-98*

PLANS APPROVED BY Donna K. Soe DATE 06/08/98

COVER NO WORK UNTIL INSPECTED AND APPROVED

NEITHER THE HOWARD COUNTY COUNCIL NOR THE HEALTH DEPARTMENT IS RESPONSIBLE FOR THE SUCCESSFUL OPERATION OF ANY SYSTEM

NOTE: CLEANOUT REQUIRED EVERY 70 FEET OF SEWER LINE AND/OR AT 90° SWEEPS IN LINES FROM HOUSE TO DRAIN FIELDS, 90° ELBOWS NOT ACCEPTABLE.

NOTE: ALL PARTS OF SEPTIC SYSTEMS (I.E. TANK, DISTRIBUTION BOX TRENCHES) TO BE 100 FEET FROM WELL (UNLESS OTHERWISE SPECIFICALLY AUTHORIZED)

NOTE: IF DEEP TRENCH(ES) ARE USED CALL FOR INSPECTION BEFORE AND AFTER PLACING GRAVEL IN TRENCH(ES)

NOTE: NO DRY WELL SHALL EXCEED 15 FOOT IN DIAMETER NO ABSORPTION TRENCH TO EXCEED 100 FEET IN LENGTH

NOTE: ALL PIPE FROM HOUSE TO SEPTIC TANK MUST BE CAST IRON OR SCHEDULE 35/40 PVC OR ABS

PERMIT VOID AFTER TWO YEARS

NOTE: INSTALL STAND PIPE ON SEPTIC TANK AND DRY WELL STAND PIPES MUST BE 6 INCHES IN DIAMETER CAST IRON, CONCRETE OR TERRA COTTA OR PVA OR ABS ACCEPTED. IF TOP OF SEPTIC TANK IS DEEPER THAN 3 FEET, MANHOLE TO GRADE REQUIRED.

NOTE: DISTRIBUTION BOXES MUST HAVE BAFFLES


*INSTALLER IS RESPONSIBLE FOR OBTAINING FINAL APPROVAL ON THIS PERMIT

HD-260(6-90)

*CALL 461-9933 FOR INSPECTION OF SEPTIC SYSTEM.

3/8/16

264

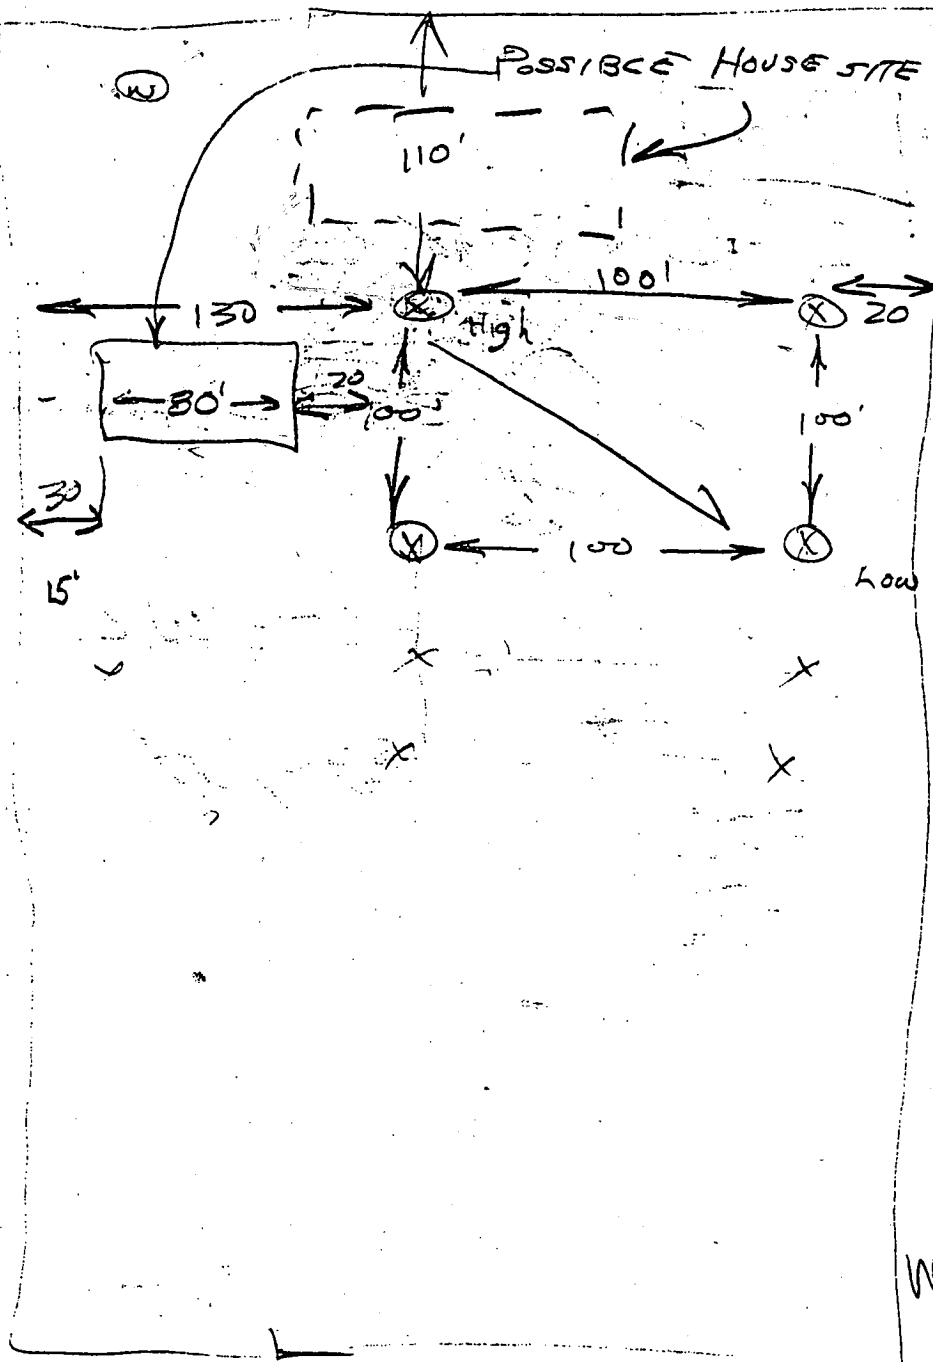

House must
be 20' from
Sew. disp. area.

5' 2' 0'

C. fee - 100.00

Digger - 150-200

Reynolds

Berry - #963-0648

Early Mon. or after dark

Murray back on 19th

264
ROAD

- INLET $2\frac{1}{2}$ -3' max. Below orig. grade

- TOTAL DEPTH MAX. 8 FT.

- LOCATION OF DRAIN FIELD TRENCHES

~ 110' from Back lot line

& 130' " left side line

(5' 2' 0')

WPR
9/30/98
afternoon

HOWARD COUNTY HEALTH DEPARTMENT
Bureau of Environmental Health
3525-H Ellicott Mills Drive
Ellicott City, MD 21043
461-9933

APPLICATION FOR PITLESS ADAPTER, WELL PUMP AND PRESSURE TANK INSTALLATION

New Installation ☒
Replacement ☐

Receipt #
Date 9/22/98

Name of Installer BWT INC.

Telephone 301 498 6138

License Number _____

Certified Well Pump Installer ☒ Well Driller _____ Registered Plumber _____

Name of Property Owner Ray Rosenblum Telephone 301 891-3997

Subdivision _____ Lot # 3 Well Tag # HO-94-1496

Site Address 11960 Rt 216 Fulton Md

Pump

1. Type

- a. Deep well jet _____
b. Shallow well jet _____
c. Submersible ☒

2. Make Panasonic

3. Model # _____

4. Capacity 8 GPM

5. Pump exceeds well capacity Yes _____ No ☒

6. If Yes, is low pressure cutoff switch installed? Yes ☒ No _____

7. What methods are used to protect the pump and electrical wiring from vibrations? Torque arrestors ☒ Cable guards ☒ Other _____

Motor

1. Horsepower 3/4

2. RPM _____

3. Voltage _____

a. 110 _____

b. 220 ☒

Pitless Adapter

1. Make Harvard

2. Model # _____

3. Depth 42

Tank

1. Capacity _____
2. Pressure relief valve? ☒

Piping

1. Type Copper Test

2. Size 1"

3. NSF and/or BOCA Code approved _____

4. Depth of supply line 42

Well data

1. Depth 300 ft.

2. Yield 10 GPM

3. Static water level 304 ft.

4. Will water supply be disinfected by installer? ☒

I understand that it is my responsibility to notify the Howard County Health Department when the installation is ready for inspection (otherwise this permit is null and void).

All information given above is true to the best of my knowledge.

Signature of Applicant: Bernard Eugene Thompson

Date: 9/22/98

Note: A sticker indicating approval/status of the installation will be placed on the well casing at the time of the inspection.

992-2330


N

Map. 41 Parcel 97
lot # 3

DEED - LIBER MWB 206

Folio 218

OCTOBER 1, 1948

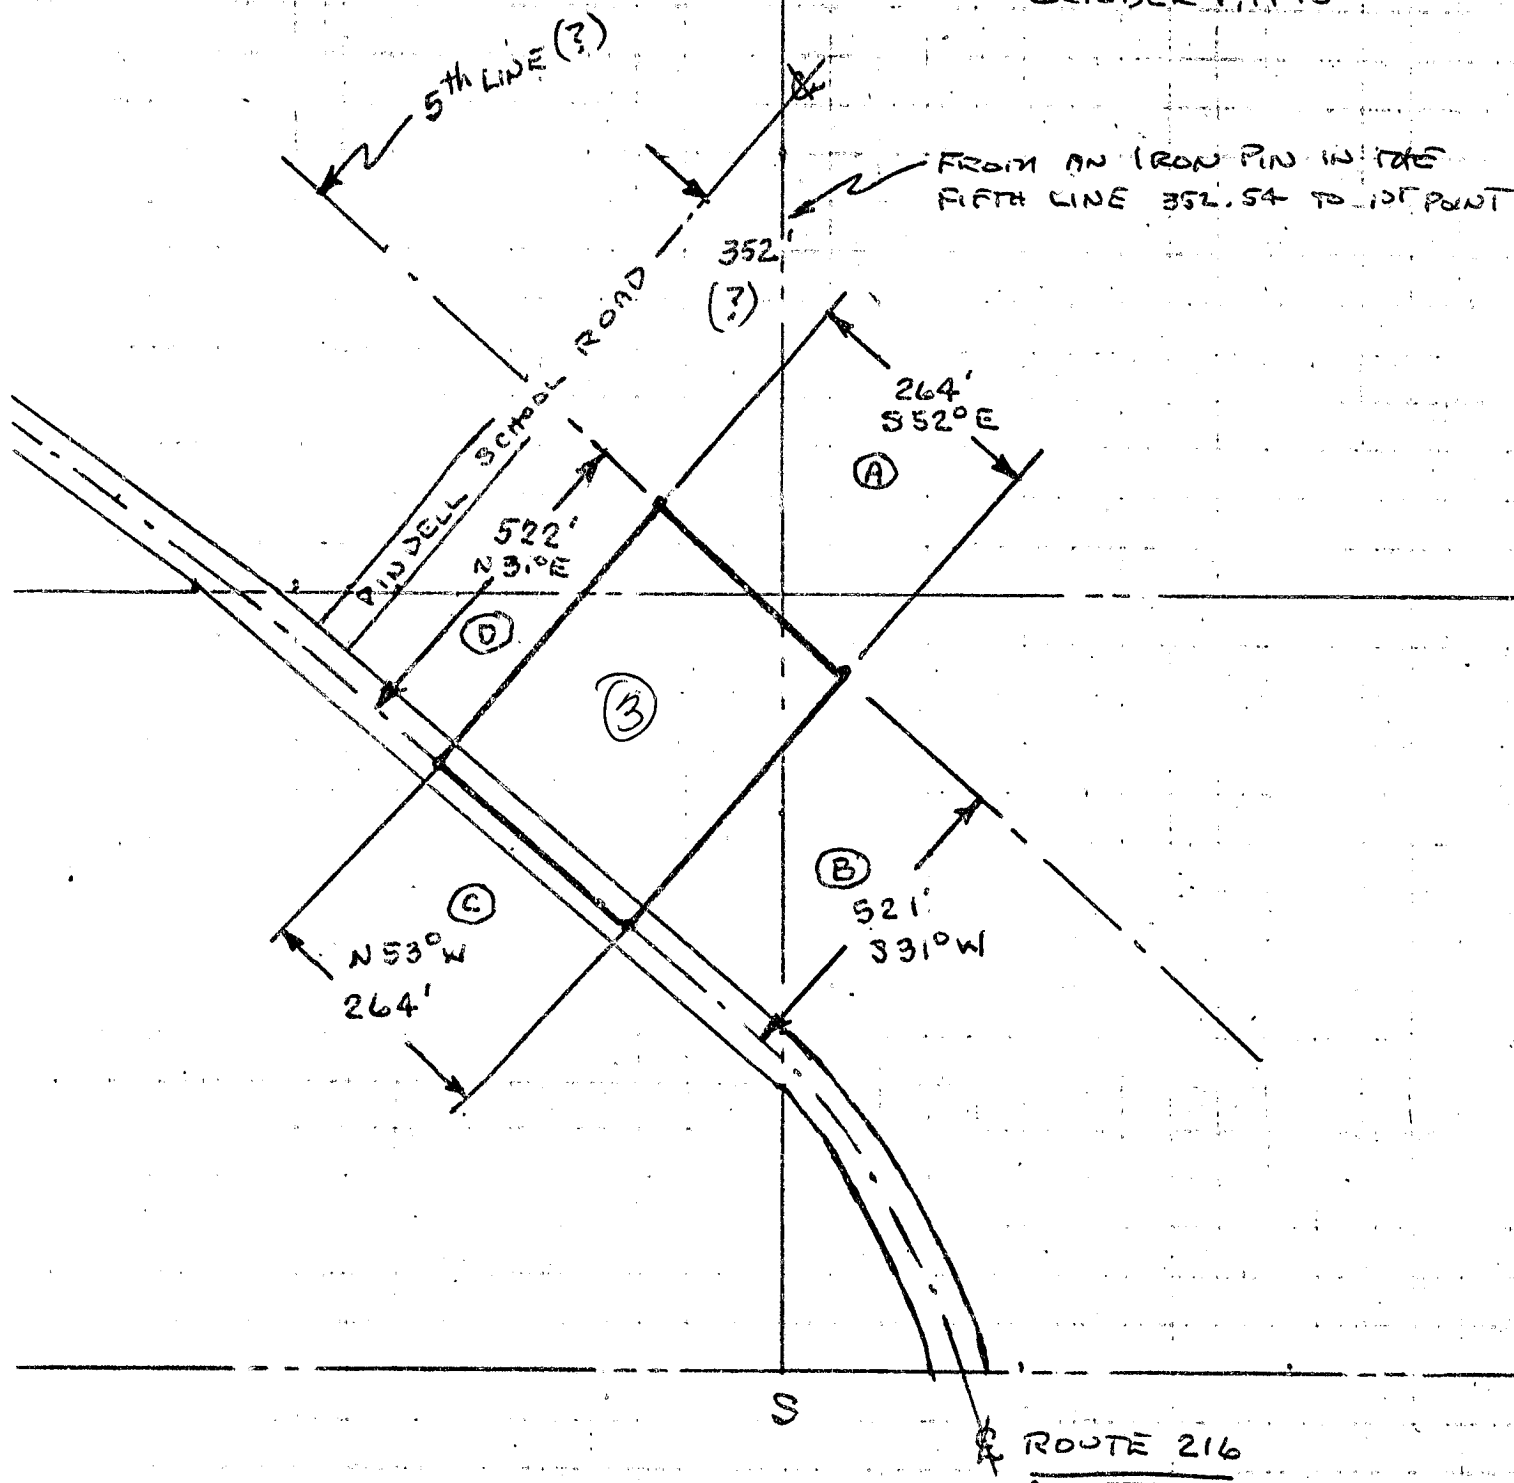

NOT TO SCALE

A = S 52° 55 MIN. 50 SEC. E - 264.54 FEET

B = S 31° 51 MIN. 22 SEC. W - 521.08 FEET

C = N 53° 19 MIN. 30 SEC. W - 264.54 FEET

D = N 31° 51 MIN. 20 SEC. E - 522.91 FEET

APPLICATION

SEWAGE DISPOSAL TESTING

STATE OF MARYLAND - DEPARTMENT OF HEALTH AND MENTAL HYGIENE

HOWARD COUNTY HEALTH DEPARTMENT
ENVIRONMENTAL HEALTH SERVICES

P. O. BOX 473 ELLICOTT CITY, MARYLAND 21043
TELEPHONE: 992-2330

A 31816

DISTRICT 5th

DATE 3/4/82

NO LOCATION PLAN
SUBMITTED AFTER PERC TEST COMPLETED
FIELD INSP OF 7/2/96
BY DKS UNABLE TO
CONFIRM TESTED AREA

WILL NEED SUBMISSION OF
PROPERTY BOUNDARY SURVEY
AND STAKE-OUT OF
APPROXIMATE TESTED
LOCATIONS TO
DETERMINE
IF OK TO
PROCEED

TO: THE COUNTY HEALTH OFFICER
ELLICOTT CITY, MARYLAND

I, HEREBY, APPLY FOR THE NECESSARY TEST IN ORDER TO CONSTRUCT (OR RECONSTRUCT) A SEWAGE DISPOSAL SYSTEM.

PROPERTY OWNER Melvin & Myra ROSENBLUM

ADDRESS 18 S. Morerick Ave. 21228 PHONE 747-1261

PROPERTY LOCATION:

Liber 206 Folio 218

SUBDIVISION _____ LOT NO. 3

ROAD AND DESCRIPTION Rt 216 east of Pindell Sch. Rd (11960 Scaggsville Rd)
house on either side, 3rd or 4th property from corner P. Sch. Rd,

SIZE OF LOT 3 AC. ± TYPE BLDG. S.F.D.
(NUMBER OF BEDROOMS)

THE SYSTEM INSTALLED UNDER THIS APPLICATION IS ACCEPTABLE ONLY UNTIL PUBLIC FACILITIES BECOME AVAILABLE. I FULLY UNDERSTAND THE

FEE CONNECTED WITH THE FILING OF THIS PERC TEST APPLICATION IS NON-REFUNDABLE UNDER ANY CIRCUMSTANCES. I ALSO AGREE TO COMPLY

WITH ALL M.O.S.H.A. REQUIREMENTS IN TESTING THIS LOT. Melvin & Myra
(SIGNATURE OF APPLICANT)

APPROVED BY Stacy FOR acquisition system DATE 4/14/82

REJECTED BY _____ FOR _____ DATE _____

HOLD PENDING FURTHER TESTS _____ DATE _____

REASONS FOR REJECTION OR HOLDING _____

LOCAL PERMIT SIGNED

DATE 6-8-98

Serial # B0110262
SFD-3Bum

LOCAL PERMIT SIGNED

AND RETURNED 11-2-92


Serial # B0107021
detached garage

THIS IS NOT A PERMIT

LOT 3

① ② ③
④ SOIL PROFILE

micaceous
sandy
loam
13'

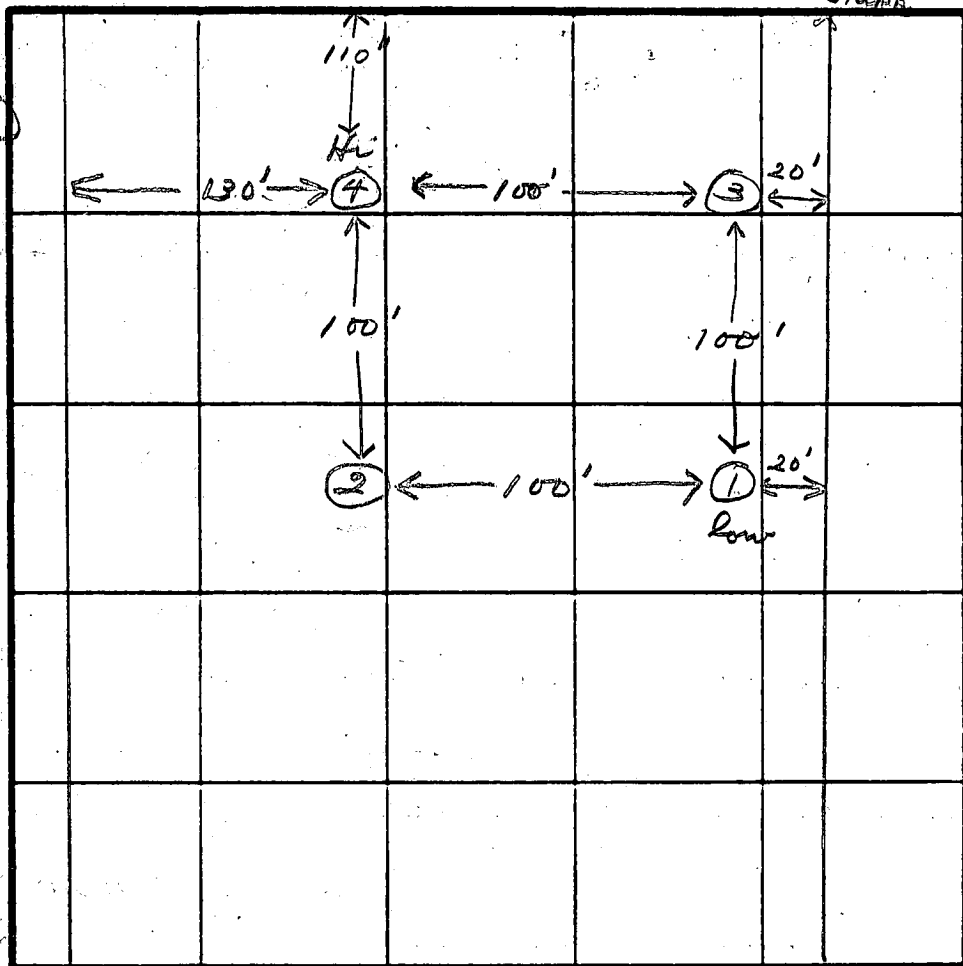

INDICATE NORTH - NAME ADJOINING ROADWAY AS BASE LINE.

RT 216

DATE	TEST NO.	DEPTH	PRE-WET		TEST - 1" DROP		TIME
			START	STOP	START	STOP	
4/5/82	1S	3	9:57	9:59	9:59	10:02	3
	1M	7	9:55	9:57	9:57	9:59	2
	2S	3	10:06	10:08	10:08	10:10	2
	2M	7	10:09	10:11	10:11	10:15	4
	3V	13					
	4S	3	10:50	10:52	10:52	10:55	3
	4M	7	10:54	10:55	10:55	10:57	2

REMARKS _____


TYPE OF SOIL _____

TESTED BY JS ALSO PRESENT Amundson

The plat is of benefit to a consumer only insofar as it is required by a lender or a title insurance company or its agent in connection with contemplated transfer, financing or re-financing;

The plat is not to be relied upon for the establishment or location of fences, garages, building, or other existing or future improvements; and

The plat does not provide for the accurate identification of property boundary lines, but such identification may not be required for the transfer of title or securing financing or re-financing.

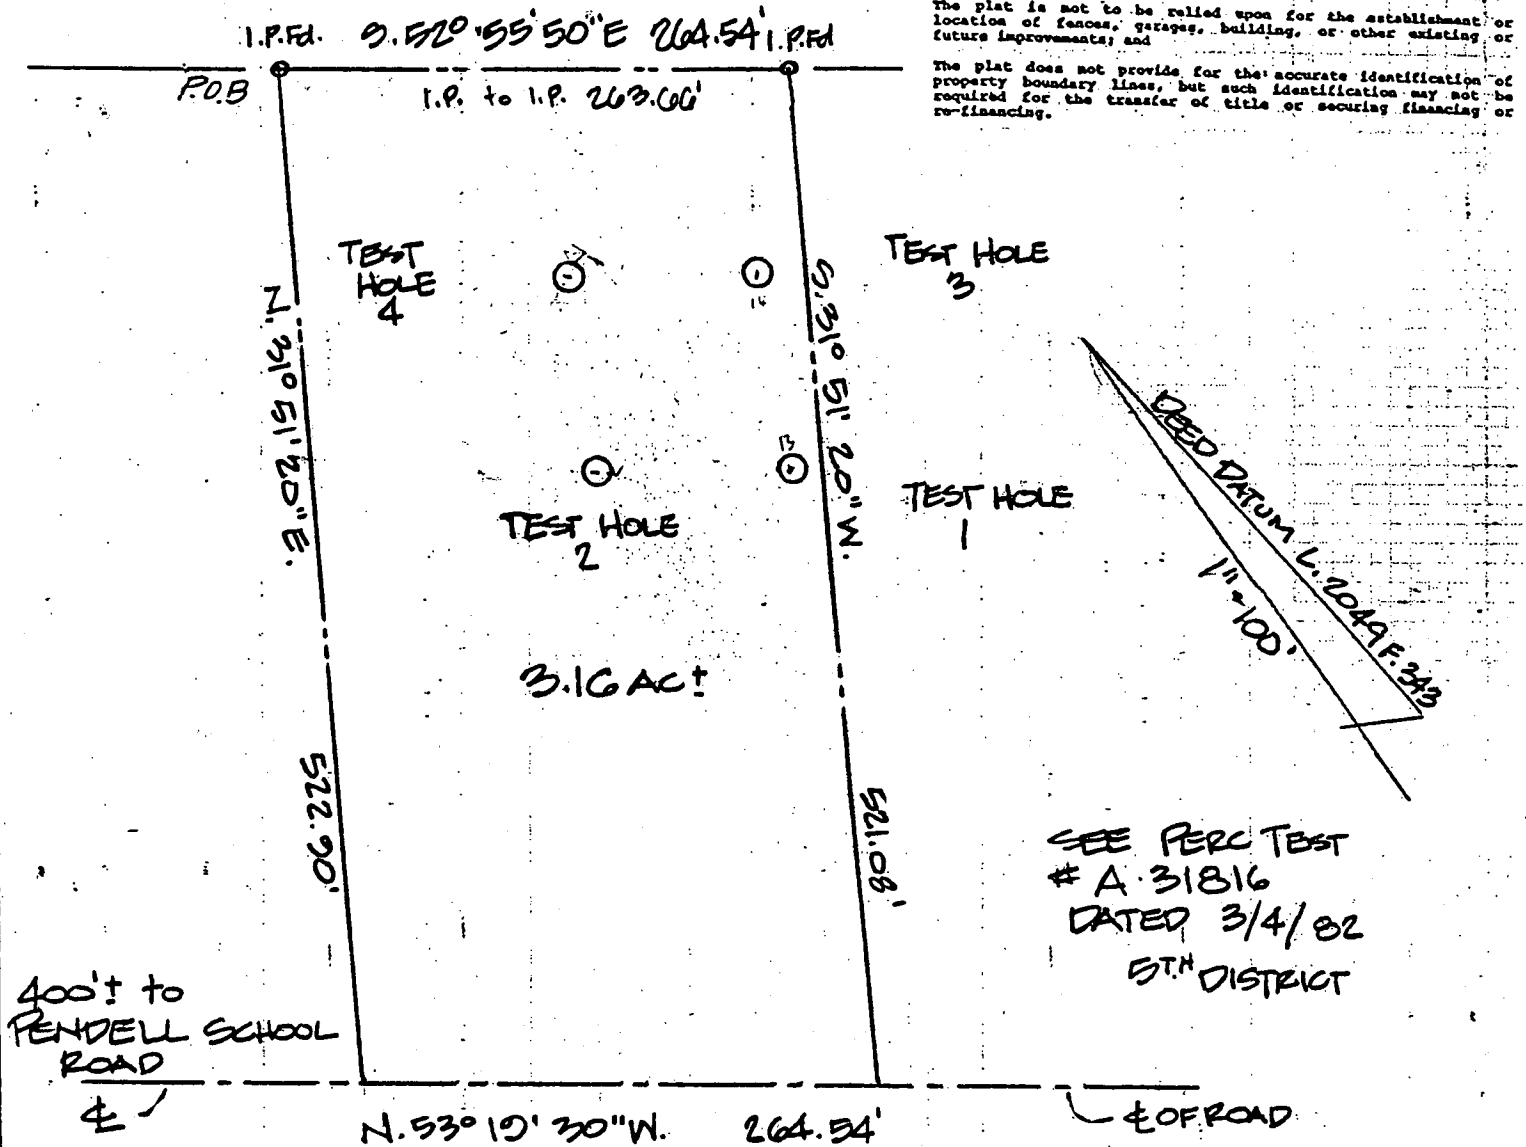

SEE PERC TEST
A 31816
DATED 3/4/82
5TH DISTRICT

MD. RTE 216 - SCAGGSVILLE ROAD

TM41 R. 97


NOTES

Not located in a H.U.D. designated Flood Hazard Zone as per FEMA Community Panel No.
Prepared without the benefit of a title report.
Information shown hereon should not be relied upon for construction of improvements.

F.B. 12882/22

I hereby certify that I have surveyed the property shown hereon for the purpose of locating the improvements only, and the improvements are located as shown. Exact property corners have not been established or set, unless otherwise noted. We assume no responsibility or liability for any rights-of-ways or easements recorded or unrecorded not appearing on the record plat.

Marwan F. Mustafa 9/12/96
MARWAN FARIS MUSTAFA
Reg. Prof. Land Surveyor, Md. 20007

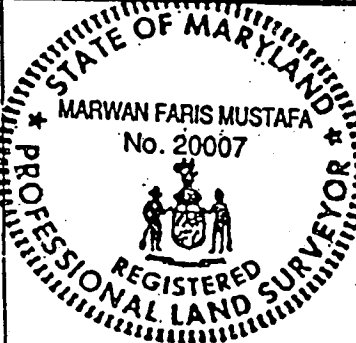

LOT IMPROVEMENT SURVEY
11074 SCAGGSVILLE ROAD
D. ANDERSON PROPERTY

GUILFORD Election District
HOWARD County, Maryland


LIGHT, ELLIOTT & ASSOCIATES, INC.
8508 Adelphi Road
Adelphi, Maryland 20783
Phone 301-422-8080
Fax 422-8086
• ENGINEERS
• PLANNERS
• SURVEYORS
953 Chandler Court
Waldorf, Maryland 20604
Phone 301-843-4927
Fax 843-4928
1-800-246-6081

Draft: KEC Ck: S	Plat Book / Page - -	Case No. -
Job No. N-5417	Liber / Folio 2049/343	File Number GH82481

Possible Well area

OPEN FIELD

The plat is of benefit to a consumer only insofar as it is required by a lender or a title insurance company or its agent in connection with contemplated transfer, financing or re-financing.
The plat is not to be relied upon for the establishment or location of fences, garages, buildings, or other existing or future improvements; and
The plat does not provide for the accurate identification of property boundary lines, but such identification may not be required for the transfer of title or securing financing or re-financing.

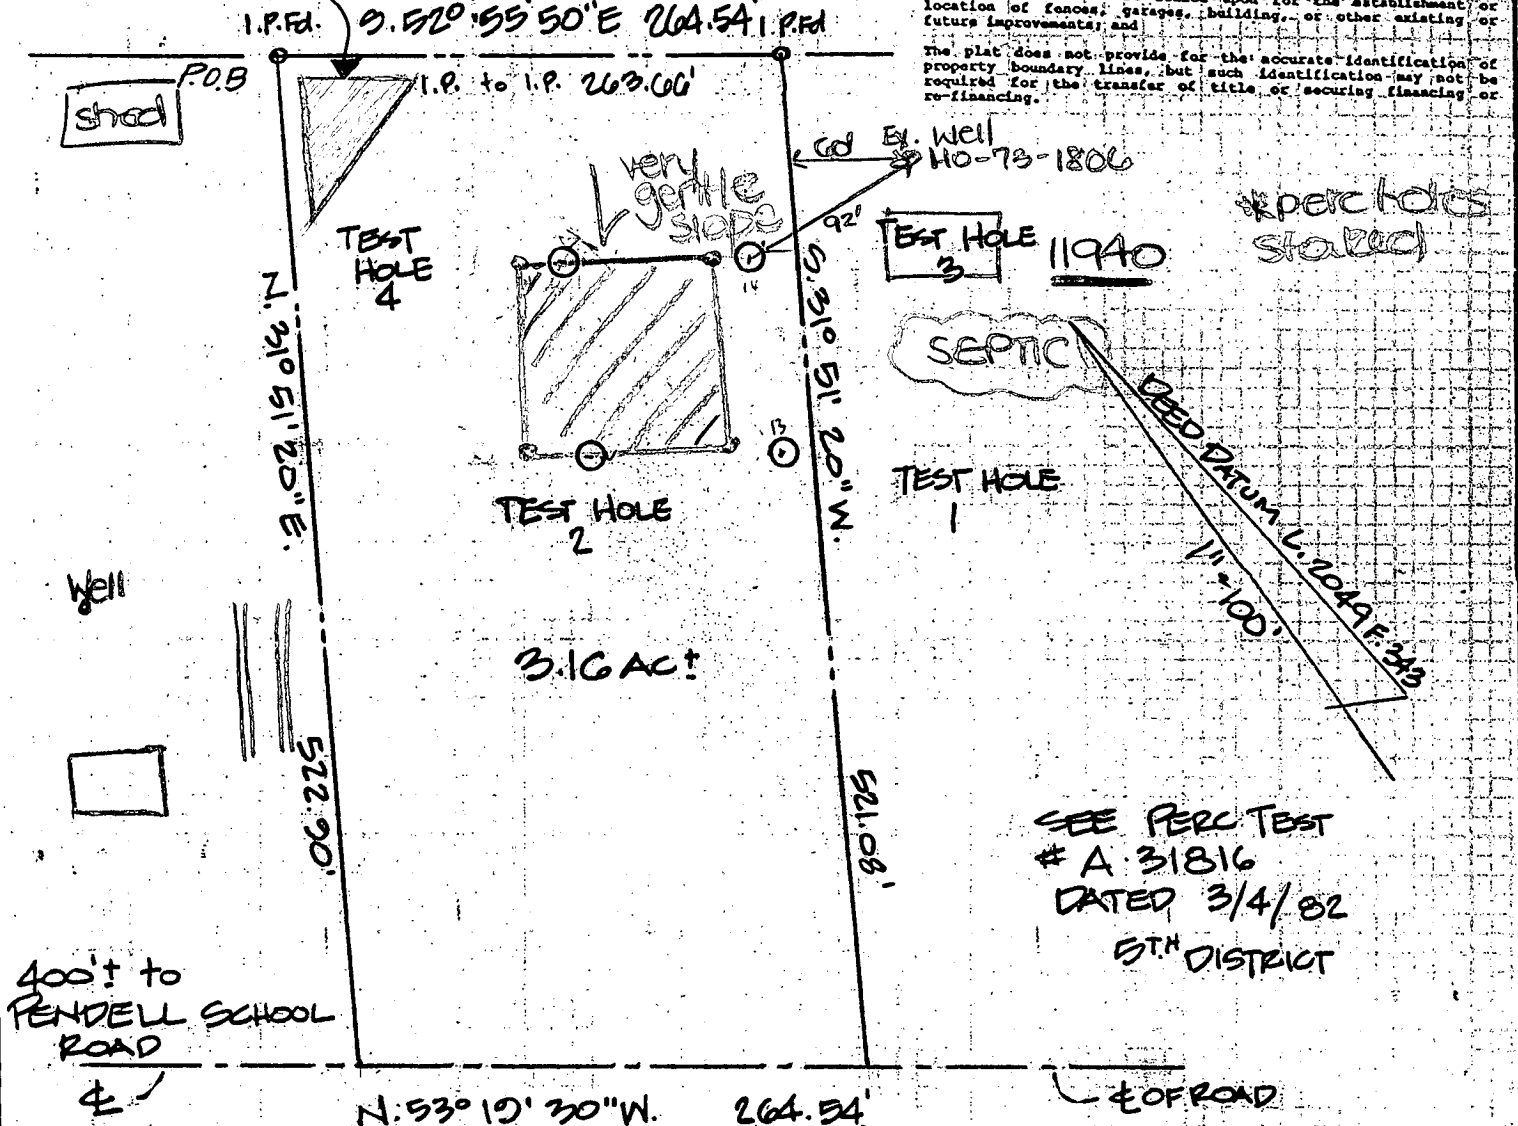

MD. RTE 216 - SCAGGSVILLE ROAD

* This plan officially accepted (in lieu of a Percolation Certification Plan) by Howard County Health Department. DONALD K. SER TM 41 P. 97


NOTES:

Not located in a HUD designated Flood Hazard Zone as per FEMA Community Panel No. Prepared without the benefit of a title report. Information shown hereon should not be relied upon for construction of improvements.

F.B. 12382/22

I hereby certify that I have surveyed the property shown hereon for the purpose of locating the improvements only, and the improvements are located as shown. Exact property corners have not been established or set, unless otherwise noted. We assume no responsibility or liability for any rights-of-ways or easements recorded or unrecorded not appearing on the record plat.

Marwan F. Mustafa 9/12/96
MARWAN FARIS MUSTAFA
Reg. Prof. Land Surveyor, Md. "20007"

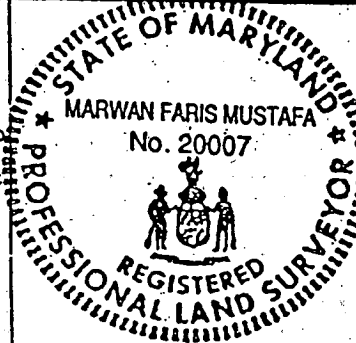

LOT IMPROVEMENT SURVEY
11974 SCAGGSVILLE ROAD
D. ANDERSON PROPERTY

GUILFORD Election District
HOWARD County, Maryland

LIGHT, ELLIOTT & ASSOCIATES, INC.
8508 Adelphi Road
Adelphi, Maryland 20783
Phone 301-422-8080
Fax 422-8086
• ENGINEERS
• PLANNERS
• SURVEYORS
1-800-246-6081
953 Chandler Court
Waldorf, Maryland 20604
Phone 301-843-4927
Fax 843-4928

Draft: KEC Ck: K	Plat Book / Page - -	Case No. -
Job No. N-5417	Liber / Folio 2040 / 343	File Number GH82481

C 05087

SEQUENCE NO.
(MDE USE ONLY)STATE OF MARYLAND
WELL COMPLETION REPORT
FILL IN THIS FORM COMPLETELY
PLEASE PRINT OR TYPETHIS REPORT MUST BE SUBMITTED WITHIN
45 DAYS AFTER WELL IS COMPLETED.COUNTY
NUMBER

A 31816

1 2 3 4 5 6
(THIS NUMBER IS TO BE PUNCHED
IN COLS. 3-6 ON ALL CARDS)

ST/CO USE ONLY

DATE Received
MM DD YV
8 13

DATE WELL COMPLETED

MM DD YV
05 19 98

Depth of Well

22 300 26
(TO NEAREST FOOT)PERMIT NO.
FROM "PERMIT TO DRILL WELL"
HO-94-1490
28 29 30 31 32 33 34 35 36 37

OWNER

STREET OR RFD

SUBDIVISION

Rosenbloom
last name Rte. 2160RAY
first name

TOWN

FISHON

SECTION

LOT

WELL LOG

Not required for driven wells

STATE THE KIND OF FORMATIONS PENETRATED, THEIR
COLOR, DEPTH, THICKNESS AND IF WATER BEARING

DESCRIPTION (Use additional sheets if needed)	FEET		check if water bearing
	FROM	TO	
top soil	0	3	
Shale	3	35	
red clay	35	50	
Shale	50	75	
green mica	75	89	
Brown mica	89	91	
gray mica	91	190	
Soft gray mica	190	200	
gray mica	200	240	
Soft gray mica	240	245	
gray mica	245	300	

GROUTING RECORD

WELL HAS BEEN GROUTED
(Circle Appropriate Box)yes no
Y N
44 44

TYPE OF GROUTING MATERIAL (Circle one)

CEMENT CM BENTONITE CLAY BC

NO. OF BAGS 36 NO. OF POUNDS 5600

GALLONS OF WATER 180

DEPTH OF GROUT SEAL (to nearest foot)

from 0 ft. to 40 ft.
(enter 0 if from surface)

CASING RECORD

casing
types
insert
appropriate
code
belowST
STEELCO
CONCRETEPL
PLASTICOT
OTHERMAIN
CASING
TYPENominal diameter
top (main) casing
(nearest inch)Total depth
of main casing
(nearest foot)ST 6 80
60 61 63 64 66 70

OTHER CASING (if used)

EACH CASING diameter depth (feet)
inch from toscreen type
or open hole
(insert
appropriate
code
below)

SCREEN RECORD

ST
STEELBR
BRASSHO
OPEN
HOLEPL
PLASTICOT
OTHER

C 2 DEPTH (nearest ft.)

1 140 78 300
EACH 8 9 11 15 17 21
2 23 24 26 30 32 36
3 38 39 41 45 47 51
SLOT SIZE 1 2 3DIAMETER
OF SCREEN (NEAREST
INCH)56 60
from toGRAVEL PACK
IF WELL DRILLED
WAS FLOWING WELL
INSERT F IN BOX 68

W Q

MDE USE ONLY
(NOT TO BE FILLED IN BY DRILLER)
T (E.R.O.S.) W Q70 72 74 75 76
TELESCOPE LOG
CASING INDICATOR OTHER DATA

C 3

PUMPING TEST

HOURS PUMPED (nearest hour)

3

PUMPING RATE (gal. per min.)

6.6

METHOD USED TO
MEASURE PUMPING RATE

Bucket

WATER LEVEL (distance from land surface)

BEFORE PUMPING 7 ft.

WHEN PUMPING 146 ft.

TYPE OF PUMP USED (for test)

A air P piston T turbine
C centrifugal R rotary O other
(describe below)
J jet S submersible

PUMP INSTALLED

DRILLER WILL INSTALL PUMP YES NO

IF DRILLER INSTALLS PUMP, THIS SECTION
MUST BE COMPLETED FOR ALL WELLS.TYPE OF PUMP INSTALLED
PLACE (A,C,J,P,R,S,T,O)
IN BOX 29CAPACITY:
GALLONS PER MINUTE
(to nearest gallon) 31 35

PUMP HORSE POWER 37 41

PUMP COLUMN LENGTH
(nearest-ft.) 43 47CASING HEIGHT (circle appropriate box
and enter casing height)P above LAND SURFACE
below 2 (nearest
foot)



LOCATION OF WELL ON LOT

SHOW PERMANENT STRUCTURE SUCH AS
BUILDING, SEPTIC TANKS, AND /OR
LANDMARKS AND INDICATE NOT LESS
THAN TWO DISTANCES
(MEASUREMENTS TO WELL)DRILLERS LIC. NO. 1 M W D 040
George A. Eustachy
DRILLERS SIGNATURE
(MUST MATCH SIGNATURE ON APPLICATION)

LIC. NO. 1 M W D 481

SITE SUPERVISOR (sign. of driller or journeyman
responsible for sitework if different from permittee)

COUNTY

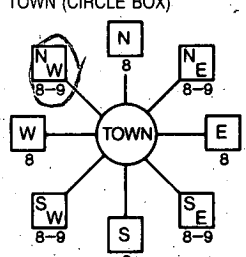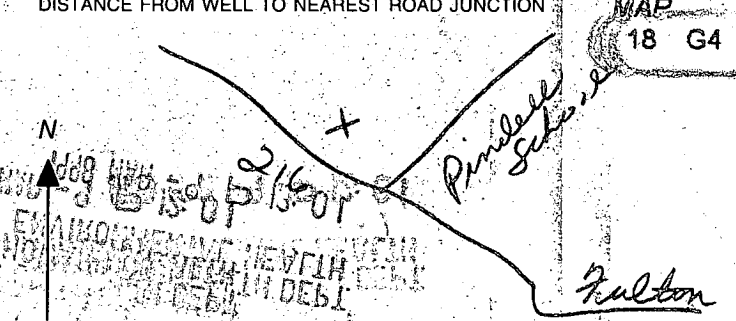B 1	5407	SEQUENCE NO. (MDE USE ONLY)	STATE OF MARYLAND PERMIT TO DRILL WELL please print or type	STATE PERMIT NUMBER 110-94-1496 fill in this form completely
1 2 3 4 5 6 (THIS NUMBER IS TO BE PUNCHED IN COLS. 3-6 ON ALL CARDS)				
Date Received (APA) 3/4/98 8 MM DD YY 13		OWNER INFORMATION RN 7385 Howard		
15 Last Name Rosenbloom Owner First Name Ray 34 36 P. O. Box 412 Street or RFD 55 Fulton, Md 20759		LOCATION OF WELL CC# 8 COUNTY 21 23 SUBDIVISION 42 SECTION 44 46 LOT 48 50 Fulton 52 NEAREST TOWN 71 MILES FROM TOWN (enter 0 if in town) 1 M I 73 76 77 78		
DRILLER INFORMATION George F. Easterday M WD 040 Driller's Name 76 License No. 81 L. Franklin Easterday, Inc. Firm Name 9265 Brown Church Rd., MT. Airy, Md. 21771 Address <i>George F. Easterday</i> 3/6/98 Signature Date		B 4 1 2 DIRECTION OF WELL FROM TOWN (CIRCLE BOX) 		
WELL INFORMATION APPROX. PUMPING RATE (GAL. PER MIN.) 5 8 12 AVERAGE DAILY QUANTITY NEEDED (GAL. PER DAY) 500 14 20		ON WHICH SIDE OF ROAD (CIRCLE APPROPRIATE BOX) 11 NEAR WHAT ROAD Scaggsville Rd (11960) 30 34 360 37 DISTANCE FROM ROAD 360 Ft. ENTER FT OR MI 38 39 TAX MAP: BLK. PARCEL		
USE FOR WATER (CIRCLE APPROPRIATE BOX) ☒ HOME (SINGLE OR DOUBLE HOUSEHOLD UNIT ONLY) ☐ FARMING (LIVESTOCK WATERING & AGRICULTURAL IRRIGATION) 22 ☐ INDUSTRIAL, COMMERCIAL, STATE AND FEDERAL GOV. OTHER (REQUIRES APPROPRIATION PERMIT) ☐ PUBLIC OR PRIVATE WATER COMPANY (REQUIRES APPROPRIATION PERMIT AND STATE APPROVAL) ☐ TEST, OBSERVATION, MONITORING (MAY REQUIRE APPROPRIATION PERMIT)		NOT TO BE FILLED IN BY DRILLER HEALTH DEPARTMENT APPROVAL Howard A 31816 COUNTY NAME COUNTY NO. STATE SIGNATURE INSERT S → DATE ISSUED 3/25/98 3/24/99 43 MM DD YY 48 CO SIGNATURE EXP. DATE NORTH GRID 481 000 EAST GRID 0820 000 50 55 57 63		
APPROXIMATE DEPTH OF WELL 300 FEET 24 28		SHOW MAJOR FEATURES OF BOX & LOCATE WELL WITH AN X SOURCES OF DRILLING WATER 1. wells 2. 3.		
APPROXIMATE DIAMETER OF WELL 6 INCH NEAREST INCH		WRITE THE BOX NUMBER FROM THE MAP HERE E 820 N 480		
METHOD OF DRILLING (circle one) 30 BORED (or Augered) JETTED Jetted & DRIVEN 37 <u>AIR-ROTARY</u> AIR-PERCussion ROTARY (Hydraulic Rotary) CABLE REVERSE-ROTARY Drive-POINT other		DRAW A SKETCH BELOW SHOWING LOCATION OF WELL IN RELATION TO NEARBY TOWNS AND ROADS AND GIVE DISTANCE FROM WELL TO NEAREST ROAD JUNCTION 		
REPLACEMENT OR DEEPENED WELLS (CIRCLE APPROPRIATE BOX) ☒ THIS WELL WILL NOT REPLACE AN EXISTING WELL ☐ THIS WELL WILL REPLACE A WELL THAT WILL BE ABANDONED AND SEALED 39 ☐ THIS WELL WILL REPLACE A WELL THAT WILL BE USED AS A STANDBY-CONTACT LOCAL APPROVING AUTHORITY FOR POLICY ON STANDBY WELLS ☐ THIS WELL WILL DEEPEEN AN EXISTING WELL PERMIT NUMBER OF WELL TO BE REPLACED OR DEEPEENED (IF AVAILABLE) 41 52		MAP 18 G4		
Not to be filled in by driller (MDE OR COUNTY USE ONLY)				
APPROX. PERMIT NUMBER 75 G A P 63 FORCE DS WRITE INITIALS IN BOX PERMIT NO. 110-94-1496 67 68 70 71 72 73 74 75 76 77 78 79				
SPECIAL CONDITIONS NOTE - APPROVING AUTHORITIES SHOULD USE SEPARATE SHEET IF NEEDED - (301) 891-3997				

Possible Well area

OPEN FIELD

The plat is of benefit to a consumer only insofar as it is required by a lender or a title insurance company or its agent in connection with contemplated transfer, financing, or re-financing;

The plat is not to be relied upon for the establishment or location of fences, garages, buildings, or other existing or future improvements; and

The plat does not provide for the accurate identification of property boundary lines, but such identification may not be required for the transfer of title or securing financing or re-financing.


1.P.Fd. 9.520' 55' 50" E 264.54' 1.P.Fd

P.O.B

1.P. to 1.P. 263.00'

shed

TEST HOLE 4

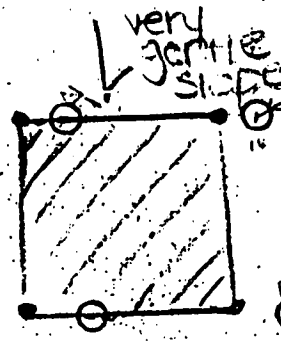

TEST HOLE 3 11940

*perc holes started

SEPTIC

TEST HOLE 1

TEST HOLE 2

3.16 AC±

OK TO PROCEED
BOO108621
UNPLUMBED
DETACHED
GARAGE -
NO IMPACT TO
WELL & SEPTIC
11/5/97 *Chiller*

SEE PERC TEST
A-31816
DATED 3/4/82
5TH DISTRICT

400'± to
RENDELL SCHOOL
ROAD

N. 53° 19' 30" W. 264.54'

EOFRD

MD. RTE 216 - SCAGGSVILLE ROAD

* This plan officially accepted (in lieu of a Percolation Certificate Plan) by Howard County Health Department. DONALD K. See TM41 P. 97


NOTES:

Not located in a HUD designated Flood Hazard Zone as per FEMA Community Panel No. Prepared without the benefit of a title report. Information shown hereon should not be relied upon for construction of improvements.

F.B. 12824/22

I hereby certify that I have surveyed the property shown hereon for the purpose of locating the improvements only, and the improvements are located as shown. Exact property corners have not been established or set, unless otherwise noted. We assume no responsibility or liability for any rights-of-ways or easements recorded or unrecorded not appearing on the record *7/15/97*.

Marwan F. Mustafa 9/12/96
MARWAN FARIS MUSTAFA
Reg. Prof. Land Surveyor, Md. #20007

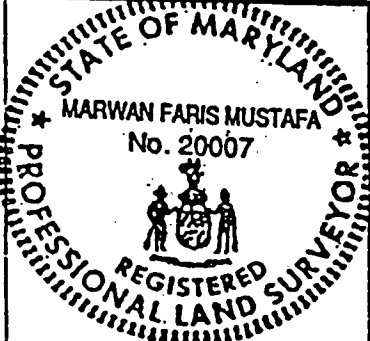

LOT IMPROVEMENT SURVEY
11974 SCAGGSVILLE ROAD
D. ANDERSON PROPERTY

GUILFORD Election District
HOWARD County, Maryland

LIGHT, ELLIOTT & ASSOCIATES, INC.
8508 Adelphi Road
Adelphi, Maryland 20783
Phone 301-422-6080
Fax 422-6086
1-800-246-6081



ENGINEERS
PLANNERS
SURVEYORS

953 Chandler Court
Waldorf, Maryland 20604
Phone 301-843-4927
Fax 843-4928

Draft: <i>KEC</i> Ck: <i>K</i>	Plat Book / Page - -	Case No. -
Job No. N-5417	Liber / Folio 2040 / 343	File Number GH82481