

2/19/81 FILE  
APPROVED  
P 31181 C.B.

# PERMIT

SEWAGE DISPOSAL SYSTEM

MARYLAND STATE DEPARTMENT OF HEALTH

HOWARD COUNTY

ELLICOTT CITY

DISTRICT 2nd.

DATE 2/18/81

INDEXED

Jenkins Brothers

IS PERMITTED TO INSTALL X ALTER

ADDRESS 10439 Frederick Road, Ellicott City, Md. 21043 PHONE 465-6646

SUBDIVISION \_\_\_\_\_ ROAD 9808 Route 108 LOT \_\_\_\_\_

PROPERTY OWNER Atherholt

ADDRESS 9808 Route 108

## SPECIFICATIONS

SEPTIC TANK CAPACITY 1000 GALLONS

DRAIN FIELD \_\_\_\_\_ DEPTH \_\_\_\_\_ FEET, BOTTOM AREA \_\_\_\_\_ SQ. FT.

DEEP TRENCH \_\_\_\_\_ DEPTH \_\_\_\_\_ FEET, BOTTOM AREA \_\_\_\_\_ SQ. FT.

SEEPAGE PITS \_\_\_\_\_ ABSORBENT SIDE-WALL AREA \_\_\_\_\_ SQ. FT.

INLET PIPE \_\_\_\_\_ FT. BELOW ORIGINAL GRADE. MAXIMUM DEPTH \_\_\_\_\_ FT. BELOW ORIGINAL GRADE

EFFECTIVE DEPTH AT \_\_\_\_\_ FT. BELOW ORIGINAL GRADE.

LOCATE DISPOSAL AREA \_\_\_\_\_ FT. FROM \_\_\_\_\_ LOT LINE AND \_\_\_\_\_ FT. FROM \_\_\_\_\_ LOT LINE AS SEEN WHEN  
FACING LOT FROM

REPAIR - CALL FOR INSPECTION WHEN GROUND IS OPENED UP SO SANITARIAN CAN RECOMMEND

REPAIR. 2/19/81 Replace metal septic tank with new  
concrete type and run 50' of trench off of  
septic tank as indicated. 2' wide, 10'-10 1/2' deep  
6' of stone under pipe. C.B.

PLANS APPROVED BY Palmer F. Wine DATE 2/18/81

COVER NO WORK UNTIL INSPECTED AND APPROVED.

NEITHER THE HOWARD COUNTY COUNCIL NOR THE HEALTH DEPARTMENT IS RESPONSIBLE FOR THE SUCCESSFUL OPERATION OF ANY SYSTEM.

NOTE: IF TRENCH IS USED CALL FOR INSPECTION BEFORE PLACING GRAVEL IN TRENCH.

NOTE: NO DRY WELL SHALL EXCEED 15 FOOT IN DIAMETER.


NOTE: ALL PIPE FROM HOUSE TO DISPOSAL AREA MUST BE CAST IRON.

PERMIT VOID AFTER THREE YEARS.

NOTE: INSTALL STAND PIPE ON SEPTIC TANK AND DRY WELL. STAND PIPES MUST BE 6 INCHES IN DIAMETER. CAST IRON, CONCRETE OR TERRA  
COTTA ACCEPTED.

\*INSTALLER IS RESPONSIBLE FOR OBTAINING FINAL APPROVAL ON THIS PERMIT.

31181

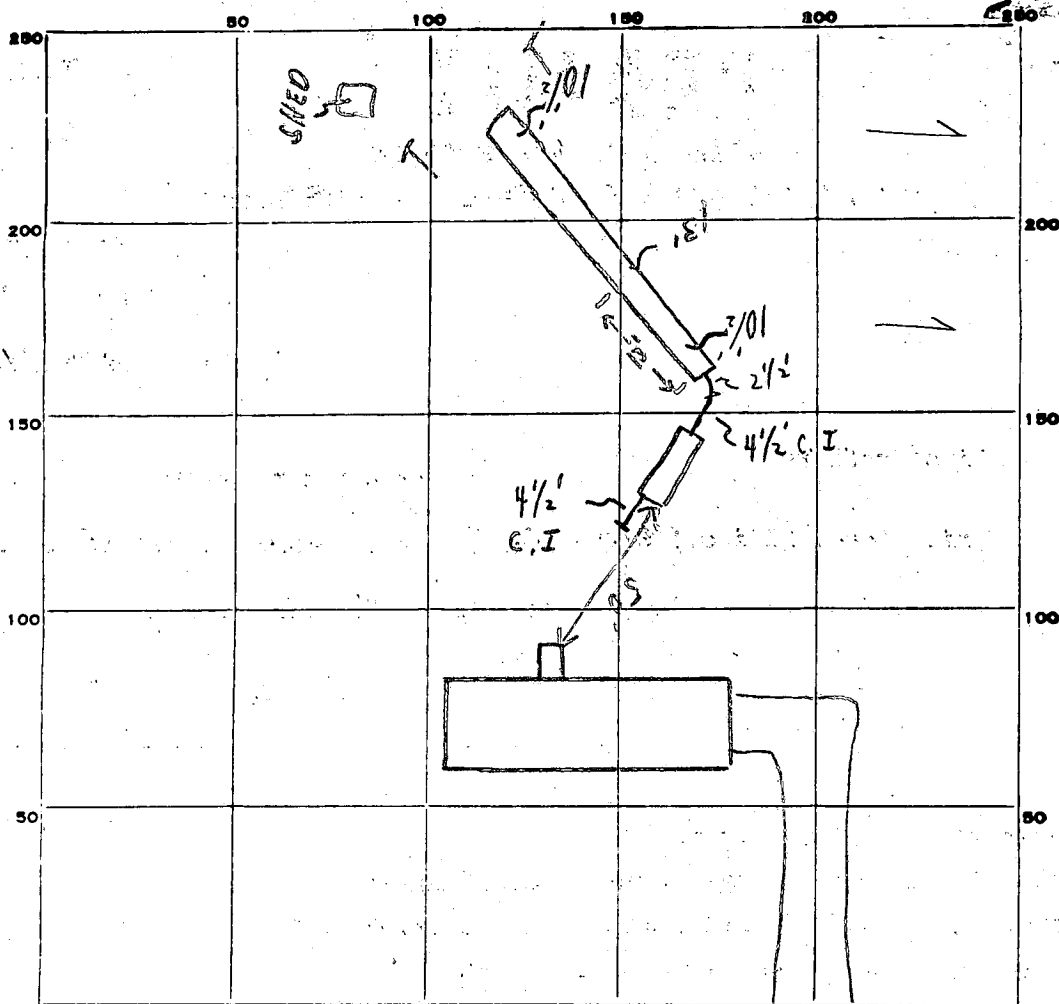

INDICATE NORTH. - NAME ADJOINING ROADWAY AS BASE LINE.

RT 108

PERMIT CARD ☒

SEPTIC TANK, LEVEL ☒

CLEANOUTS ☒ S.T.

DISTRIBUTION BOX, LEVEL \_\_\_\_\_

TILE FIELD, DEPTH 10 1/2 FT. TRENCH WIDTH 2 FT.

GRAVEL DEPTH 6.5 IN. TOTAL LENGTH 50 FT.

NUMBER OF TRENCHES 1 TOTAL BOTTOM AREA \_\_\_\_\_

SEEPAGE PITS, INSIDE DIAMETER \_\_\_\_\_ FT. DEPTH BELOW INLET \_\_\_\_\_ FT.

ABSORBENT AREA 32.5 SQ. FT.

REMARKS 4/17/81 (1) OK FOR TRENCH 50' LONG; 10 1/2' DEEP; 2' WIDE;  
(2) OK TO PUT STONE IN TRENCH; OK TO COVER TO 3' OF  
TRENCH. (3) System complete.  
C.B.S. C.B.S.

DATE SYSTEM APPROVED

2/19/81

INSPECTOR

C. B. A. Thesken

# APPLICATION

SEWAGE DISPOSAL TESTING

STATE OF MARYLAND - DEPARTMENT OF HEALTH AND MENTAL HYGIENE

HOWARD COUNTY HEALTH DEPARTMENT  
ENVIRONMENTAL HEALTH SERVICES

P.O. BOX 476 ELLICOTT, MARYLAND 21043  
TELEPHONE: 992-2330

*per*  
R 3/18/81

A Repair

DISTRICT 2nd.

DATE 2/17/81

TO: THE COUNTY HEALTH OFFICER  
ELLICOTT CITY, MARYLAND

I, HEREBY, APPLY FOR THE NECESSARY TEST IN ORDER TO CONSTRUCT (OR RECONSTRUCT) A SEWAGE DISPOSAL SYSTEM.

PROPERTY OWNER Atherholt

ADDRESS 9808 Route 108 PHONE \_\_\_\_\_

PROPERTY LOCATION:

SUBDIVISION \_\_\_\_\_ LOT NO. \_\_\_\_\_

ROAD AND DESCRIPTION Take Route 29 - right on Rte. 108 - Cross bridge - second house on right -  
brick rancher.

SIZE OF LOT \_\_\_\_\_ TYPE BLDG. \_\_\_\_\_

THE SYSTEM INSTALLED UNDER THIS APPLICATION IS ACCEPTABLE ONLY UNTIL PUBLIC FACILITIES BECOME AVAILABLE.

I FULLY UNDERSTAND THE FEE CONNECTED WITH THE FILING OF THIS PERC TEST APPLICATION IS NON-REFUNDABLE UNDER ANY CIRCUMSTANCES.

SIGNATURE OF APPLICANT \_\_\_\_\_

APPROVED BY \_\_\_\_\_ FOR \_\_\_\_\_ DATE \_\_\_\_\_

REJECTED BY \_\_\_\_\_ FOR \_\_\_\_\_ DATE \_\_\_\_\_

HOLD PENDING FURTHER TESTS \_\_\_\_\_ DATE \_\_\_\_\_


REASONS FOR REJECTION OR HOLDING 2/19/81 Existing house - 2 Bedrooms per Mr. Jenkins;

OK due to sandy loam soil for 50' trench  
2' wide, 10'-10 1/2' deep with 6' of stone under pipes.  
See attached permit C.B.O.

# THIS IS NOT A PERMIT

SOIL PROFILE

SEE  
EACH  
HOLE

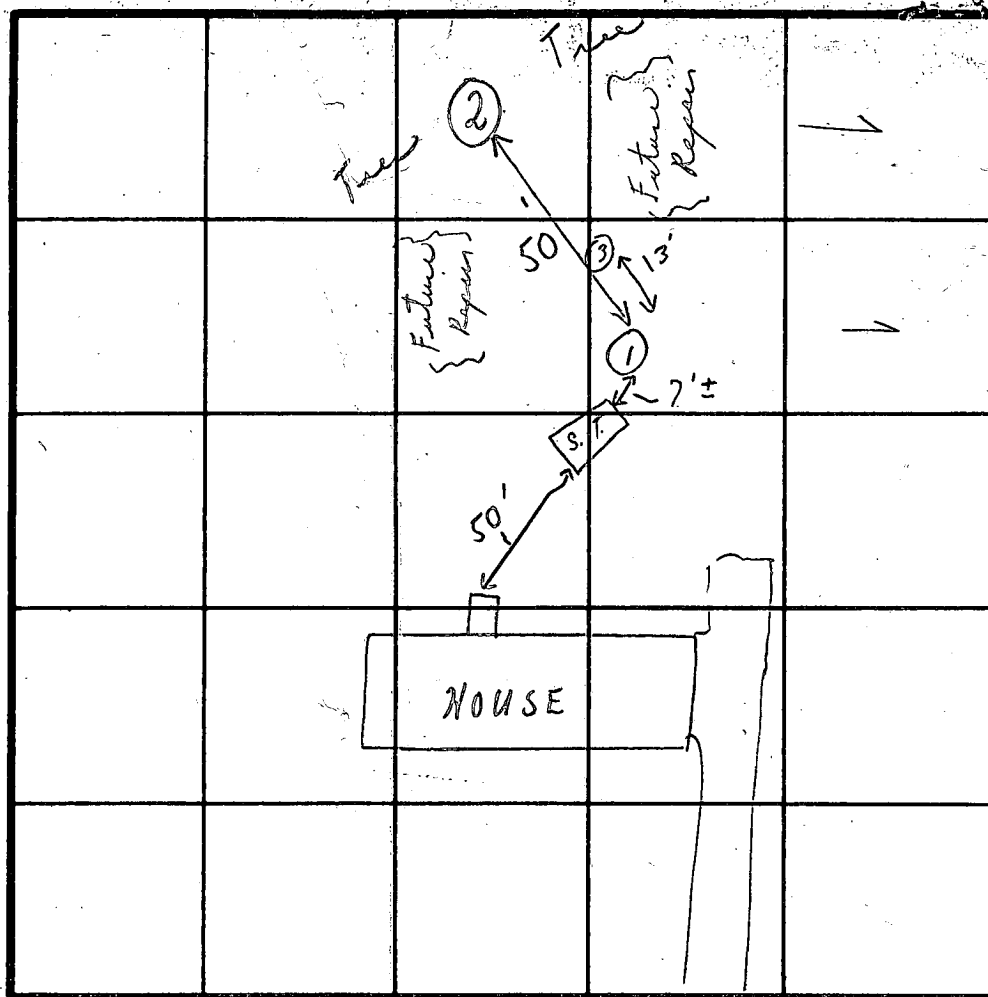

INDICATE NORTH - NAME ADJOINING ROADWAY AS BASE LINE.

RX 108

| SOIL PROFILE          | DATE    | Hole<br>TEST NO. | DEPTH   | PRE-WET |      | TEST - 1" DROP |      | TIME |
|-----------------------|---------|------------------|---------|---------|------|----------------|------|------|
|                       |         |                  |         | START   | STOP | START          | STOP |      |
| 1'-1 1/2' Clayish     | 2/19/81 | 1                | 10 1/2' |         |      |                |      |      |
| 2'-10 1/2' Sandy loam |         |                  |         |         |      |                |      |      |
| 1'-1 1/2' Clayish     |         | 2                | 10 1/2' |         |      |                |      |      |
| 2'-10 1/2' Sandy loam |         |                  |         |         |      |                |      |      |
| 1'-1 1/2' Clayish     |         | 3                | 13'     |         |      |                |      |      |
| 2'-13' Sandy loam     |         |                  |         |         |      |                |      |      |
|                       |         |                  |         |         |      |                |      |      |
|                       |         |                  |         |         |      |                |      |      |
Soil texture indicates  
minimum size  
system) // + Possible covering  
C.B.S. conditions

REMARKS

TYPE OF SOIL

TESTED BY

ALSO PRESENT

{ Existing house - repair - holes dug }  
@ time of stop!!  
C.B.S.  
{ WENKINS BROS.  
(2) KEN NATFIELD