

3/10/81
be ready
around 1:30 p.m.

PERMIT

SEWAGE DISPOSAL SYSTEM

MARYLAND STATE DEPARTMENT OF HEALTH

HOWARD COUNTY

P 31214

A Repair

APPROVED 3/10/81
RB/CW

ELLICOTT CITY

DISTRICT 1st.

INDEXED

DATE 3/9/81

Jenkins Bros.

IS PERMITTED TO INSTALL X ALTER

ADDRESS Route 144, Ellicott City, Md. PHONE 465-6646

SUBDIVISION _____ ROAD Route 1 LOT _____

PROPERTY OWNER Mr. Herman H. ~~Ferguson~~ Ferguson

ADDRESS Route 1, next to M & M Traylor Park

SPECIFICATIONS

SEPTIC TANK CAPACITY _____ GALLONS
DRAIN FIELD _____ DEPTH _____ FEET, BOTTOM AREA _____ SQ. FT.
DEEP TRENCH _____ DEPTH _____ FEET, BOTTOM AREA _____ SQ. FT.
SEEPAGE PITS _____ ABSORBENT SIDE-WALL AREA _____ SQ. FT.
INLET PIPE _____ FT. BELOW ORIGINAL GRADE, MAXIMUM DEPTH _____ FT. BELOW ORIGINAL GRADE
EFFECTIVE DEPTH AT _____ FT. BELOW ORIGINAL GRADE.
LOCATE DISPOSAL AREA _____ FT. FROM _____ LOT LINE AND _____ FT. FROM _____ LOT LINE AS SEEN WHEN
FACING LOT FROM

REPAIR - Minimum - 1500 gal. sealed septic tank with an alarm device.

Call for inspection before covering.

PLANS APPROVED BY R. Hodges/F. Frommelt DATE 3/9/81

COVER NO WORK UNTIL INSPECTED AND APPROVED.

NEITHER THE HOWARD COUNTY COUNCIL NOR THE HEALTH DEPARTMENT IS RESPONSIBLE FOR THE SUCCESSFUL OPERATION OF ANY SYSTEM.

NOTE: IF TRENCH IS USED CALL FOR INSPECTION BEFORE PLACING GRAVEL IN TRENCH.

NOTE: NO DRY WELL SHALL EXCEED 15 FOOT IN DIAMETER.


NOTE: ALL PIPE FROM HOUSE TO DISPOSAL AREA MUST BE CAST IRON.

PERMIT VOID AFTER THREE YEARS.

NOTE: INSTALL STAND PIPE ON SEPTIC TANK AND DRY WELL. STAND PIPES MUST BE 6 INCHES IN DIAMETER. CAST IRON, CONCRETE OR TERRA COTTA ACCEPTED.

***INSTALLER IS RESPONSIBLE FOR OBTAINING FINAL APPROVAL ON THIS PERMIT.**

PA 31214

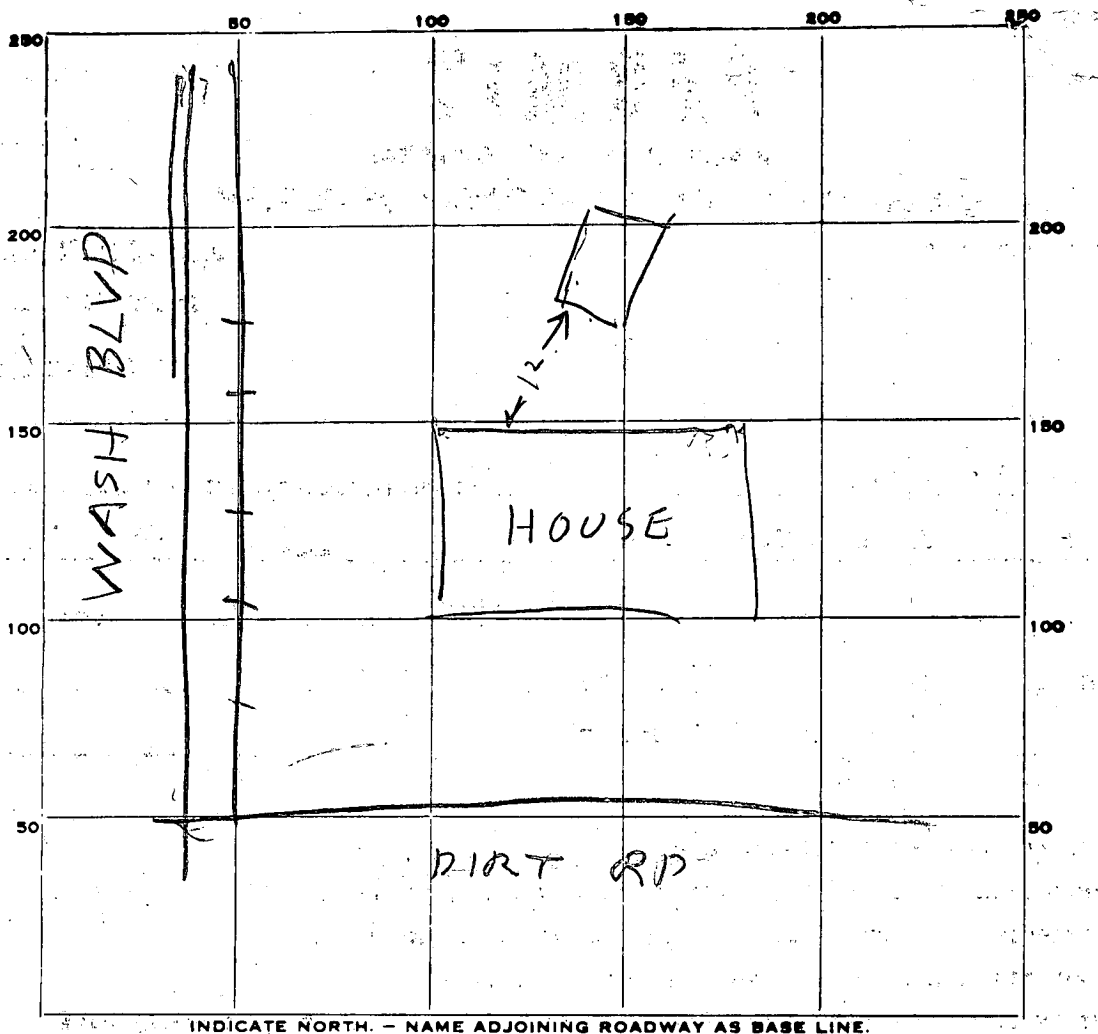

INDICATE NORTH. - NAME ADJOINING ROADWAY AS BASE LINE.

PERMIT CARD _____

SEPTIC TANK, LEVEL OK 1500

CLEANOUTS OK

DISTRIBUTION BOX, LEVEL _____

TILE FIELD, DEPTH _____ FT. TRENCH WIDTH _____ FT.

GRAVEL DEPTH _____ IN. TOTAL LENGTH _____ FT.

NUMBER OF TRENCHES _____ TOTAL BOTTOM AREA _____

SEEPAGE PITS, INSIDE DIAMETER _____ FT. DEPTH BELOW INLET _____ FT.

ABSORBENT AREA _____ SQ. FT.

REMARKS 3/10/81 - SEALED TANK WITH FLOAT
TYPE ALARM DEVICE INSTALLED
JENKINS WILL BRING PUMPING
CONTRACT TO HEALTH DEPT FOR
INSPECTION LATER

NO RECORD OF CONTACTS OF 7/17/95 - INDEX AS APPOINDED (CW)

DATE SYSTEM APPROVED 3/10/81 INSPECTOR RH/CW/T

APPLICATION

Repair perc
3/4/81
9:30 A.M.

SEWAGE DISPOSAL TESTING

STATE OF MARYLAND - DEPARTMENT OF HEALTH AND MENTAL HYGIENE

HOWARD COUNTY HEALTH DEPARTMENT
ENVIRONMENTAL HEALTH SERVICES

P.O. BOX 476 ELLICOTT, MARYLAND 21043
TELEPHONE: 992-2330

A _____

P Repair perc

DISTRICT _____

DATE 2/27/81

TO: THE COUNTY HEALTH OFFICER
ELLICOTT CITY, MARYLAND

I, HEREBY, APPLY FOR THE NECESSARY TEST IN ORDER TO CONSTRUCT (OR RECONSTRUCT) A SEWAGE DISPOSAL SYSTEM.

PROPERTY OWNER Mr. Ferguson (Tenant is Mrs. Estella Dull)

ADDRESS 8273 Washington Boulevard, Jessup, Md. PHONE _____

PROPERTY LOCATION: 992 2411

SUBDIVISION _____ LOT NO. _____

ROAD AND DESCRIPTION 8273 Washington Boulevard next to M & M Trailer Park

SIZE OF LOT ? TYPE BLDG. 1 BEDROOM Existing House on property

THE SYSTEM INSTALLED UNDER THIS APPLICATION IS ACCEPTABLE ONLY UNTIL PUBLIC FACILITIES BECOME AVAILABLE,

I FULLY UNDERSTAND THE FEE CONNECTED WITH THE FILING OF THIS PERC TEST APPLICATION IS NON-REFUNDABLE UNDER

ANY CIRCUMSTANCES.

SIGNATURE OF APPLICANT 465 6646
/s/ Jenkins Brothers for Mr. Ferguson

APPROVED BY _____ FOR _____ DATE _____

REJECTED BY BH FOR ALL DATE 3/4/81

HOLD/PENDING FURTHER TESTS _____ DATE _____

REASONS FOR REJECTION OR HOLDING 3/4/81 - HOLD FOR REVIEW WITH

FF HOLDING TANK MAY BE NEEDED RH: 3/4/81 FF

SAID CHECK WITH PUBLIC WORKS TO SEE IF SEWER AVAILABLE. 3/5/81 PUBLIC
WORKS SAID SEWER NOT AVAILABLE & WILL NOT BE AVAILABLE
IN NEAR FUTURE 3/9/81 FF DECIDED SEALED TANK

THIS IS NOT A PERMIT

3
SOIL PROFILE


QWAS 77B


WATER

HOLE
ELEVATION

①② = Low

③ = HIGH
ABOUT
8 FT
HIGHER
THAN
① ②

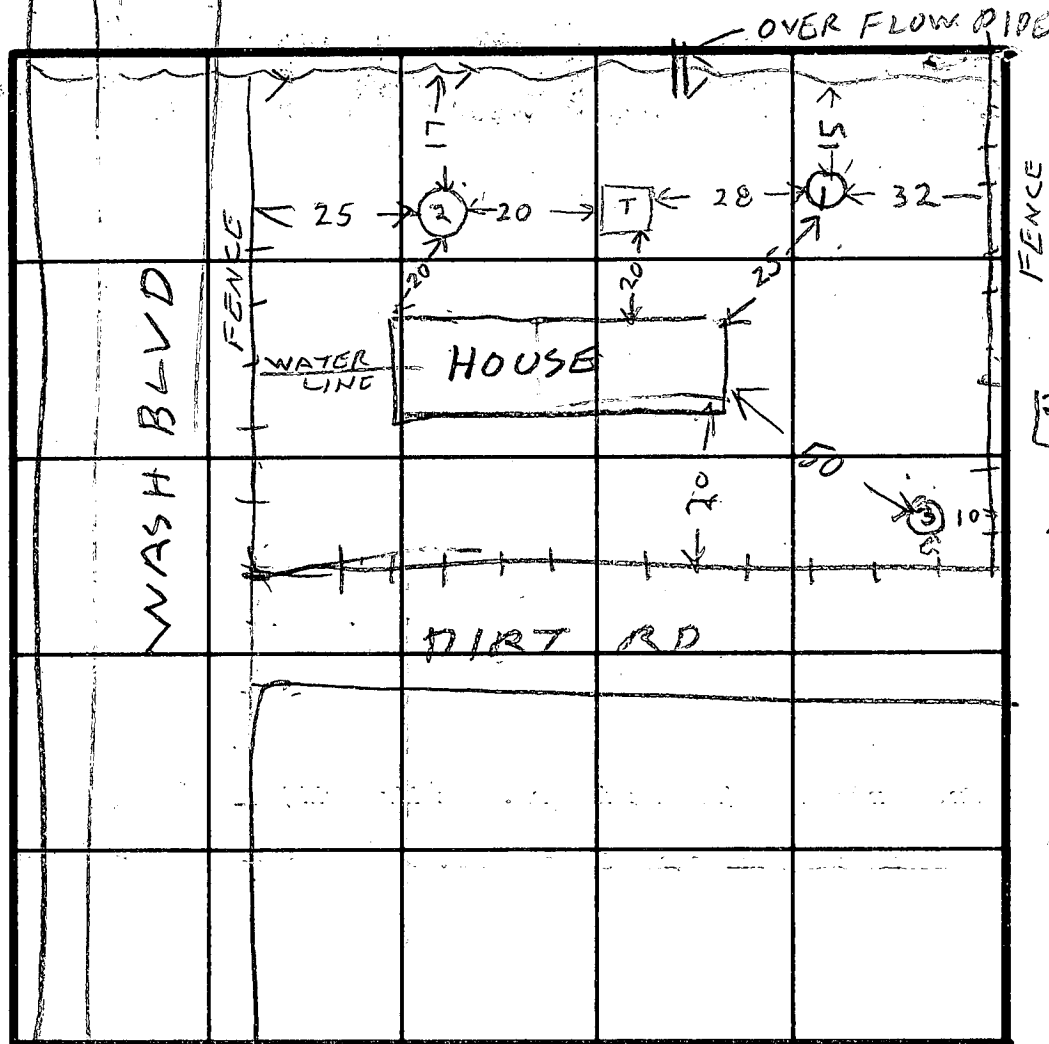


 = SMALL
 TANK
 EITHER
 SEPTIC
~~TANK OR~~
CESS POOL
 SMALL
 SPRING

INDICATE NORTH - NAME ADJOINING ROADWAY AS BASE LINE

[illegible]

REMARKS COMPLAINT PERC, CITY WATER HERE HOLE (3) IS ON A
HUMP. AC. 55, 757

TYPE OF SOIL

TESTED BY R HODGE

ALSO PRESENT OTIS KETTERMAN
BACK HOF

Proposal

Page No. 1

of 3

Pages

JENKINS BROS.

Septic Service & General Contractors
Old Fredrick Road Route 144
ELLCOTT CITY, MARYLAND 21043
Phone 465-6646

H.O.C. Rept.
Health Dept.

PROPOSAL SUBMITTED TO <i>Norman Ferguson</i>		PHONE	DATE <i>March 7, 1981</i>
STREET <i>2875 Mariottsville Rd.</i>		JOB NAME <i>sewer pumping</i>	
CITY, STATE AND ZIP CODE <i>Mariottsville Md.</i>		JOB LOCATION <i>Rental property</i>	
ARCHITECT	DATE OF PLANS <i>3-7-81</i>	JOB PHONE	

We hereby submit specifications and estimates for:
CONTRACT

pumping holding tank at above address, when float indicates such time, and cannot be allowed to run over at any time. Price for pumping per load forty dollars, contract good for one year and can only be terminated by lack of payment on owners part or with proof of poor service on our part.

We Propose hereby to furnish material and labor — complete in accordance with above specifications, for the sum of:

Forty + 00 dollars (\$ *40.00*).

Payment to be made as follows:

Forty dollars per load payable when pumping is done.

All material is guaranteed to be as specified. All work to be completed in a workmanlike manner according to standard practices. Any alteration or deviation from above specifications involving extra costs will be executed only upon written orders, and will become an extra charge over and above the estimate. All agreements contingent upon strikes, accidents or delays beyond our control. Owner to carry fire, tornado and other necessary insurance. Our workers are fully covered by Workmen's Compensation Insurance.

Authorized Signature *[Signature]*

Note: This proposal may be withdrawn by us if not accepted within *Five* days.

Acceptance of Proposal — The above prices, specifications and conditions are satisfactory and are hereby accepted. You are authorized to do the work as specified. Payment will be made as outlined above.

Date of Acceptance: _____

Signature *Jenkins Bros.*
Signature *Stella Rull*