

5/4/81, 5/5/81
A.M. if possible

approved 5/5/81
stayer P 31346

PERMIT

SEWAGE DISPOSAL SYSTEM

MARYLAND STATE DEPARTMENT OF HEALTH

HOWARD COUNTY

ELLICOTT CITY

DISTRICT _____

INDEXED

DATE 4th

4/28/81

IS PERMITTED TO INSTALL _____ ALTER _____

ADDRESS Bud Arnold PHONE _____ X

SUBDIVISION Jacobs Road, ~~WORTH~~ Mt. Airy, Md. 21771 ROAD X 795-7873 LOT

PROPERTY OWNER 1025 St. Michael's Road

ADDRESS Robert Harrison

SPECIFICATIONS St. Michael's Road

SEPTIC TANK CAPACITY _____ GALLONS
DRAIN FIELD _____ DEPTH _____ FEET, BOTTOM AREA _____ SQ. FT.
DEEP TRENCH _____ DEPTH _____ FEET, BOTTOM AREA _____ SQ. FT.
SEEPAGE PITS _____ ABSORBENT SIDE-WALL AREA _____ SQ. FT.
INLET PIPE _____ FT. BELOW ORIGINAL GRADE. MAXIMUM DEPTH _____ FT. BELOW ORIGINAL GRADE
EFFECTIVE DEPTH AT _____ FT. BELOW ORIGINAL GRADE.
LOCATE DISPOSAL AREA _____ FT. FROM _____ LOT LINE AND _____ FT. FROM _____ LOT LINE AS SEEN WHEN
FACING LOT FROM

REPAIR - Call for an appointment when ground is opened up and Sanitarian will
recommend repair system.

PLANS APPROVED BY _____ DATE _____

COVER NO WORK UNTIL INSPECTED AND APPROVED.
Palmer P. Wine

4/29/81

NEITHER THE HOWARD COUNTY COUNCIL NOR THE HEALTH DEPARTMENT IS RESPONSIBLE FOR THE SUCCESSFUL OPERATION OF ANY SYSTEM.

NOTE: IF TRENCH IS USED CALL FOR INSPECTION BEFORE PLACING GRAVEL IN TRENCH.

OLD PERMIT SIGNED

NOTE: NO DRY WELL SHALL EXCEED 15 FOOT IN DIAMETER.

AND RETURNED 4-27-98

NOTE: ALL PIPE FROM HOUSE TO DISPOSAL AREA MUST BE CAST IRON.

Serial # B10111233

PERMIT VOID AFTER THREE YEARS.

enclose deck for summary

NOTE: INSTALL STAND PIPE ON SEPTIC TANK AND DRY WELL. STAND PIPES MUST BE 6 INCHES IN DIAMETER. CAST IRON, CONCRETE OR TERRA
COTTA ACCEPTED.


*INSTALLER IS RESPONSIBLE FOR OBTAINING FINAL APPROVAL ON THIS PERMIT.

OLD PERMIT SIGNED

AND RETURNED 3/5/90

Serial # 31350
Addition - Kitchen

P 31346

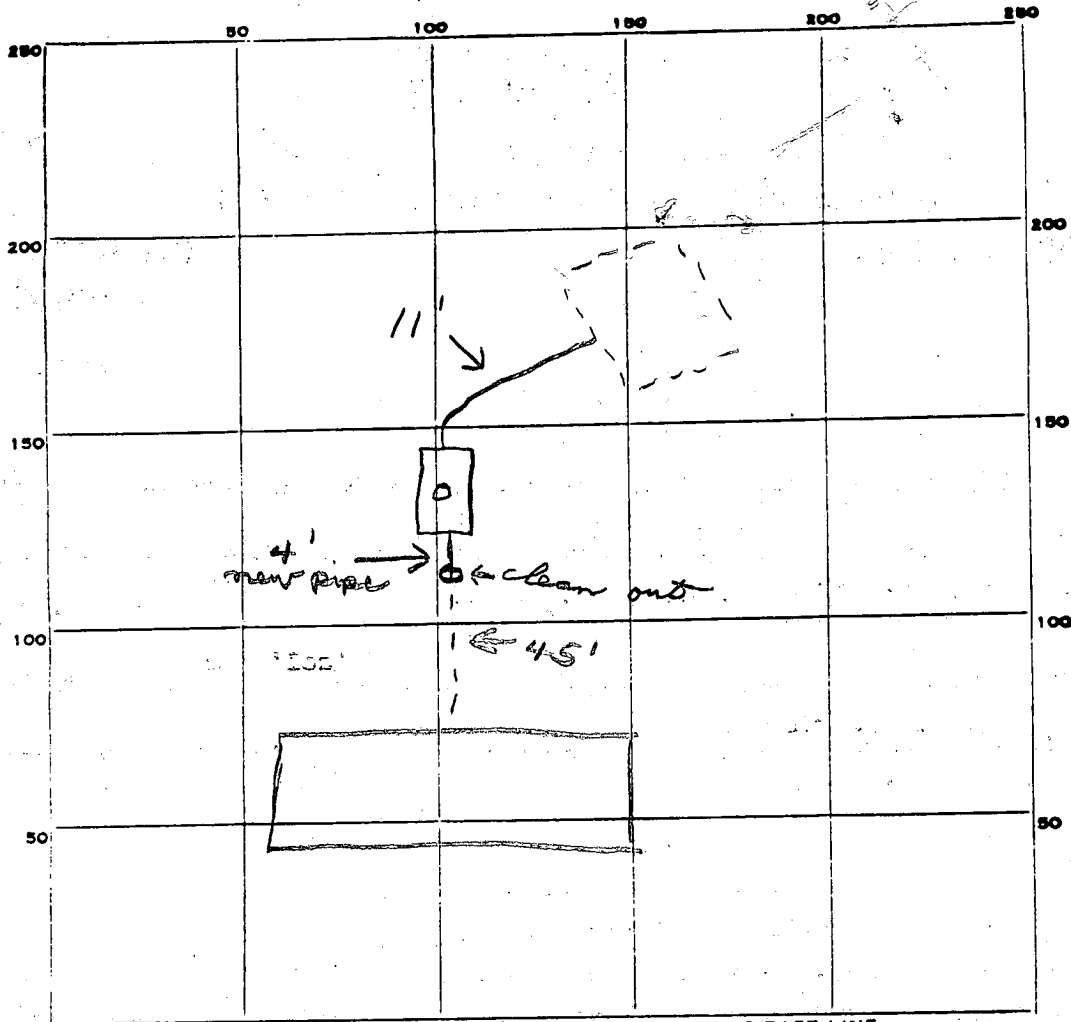

INDICATE NORTH. - NAME ADJOINING ROADWAY AS BASE LINE.

ST. Michaels Rd

PERMIT CARD ☒

SEPTIC TANK, LEVEL ☒

CLEANOUTS *ST* ☒

DISTRIBUTION BOX, LEVEL ☐

TILE FIELD, DEPTH _____ FT. TRENCH WIDTH _____ FT.

GRAVEL DEPTH _____ IN. TOTAL LENGTH _____ FT.

NUMBER OF TRENCHES _____ TOTAL BOTTOM AREA _____

SEEPAGE PITS, INSIDE DIAMETER _____ FT. DEPTH BELOW INLET _____ FT.


ABSORBENT AREA _____ SQ. FT.

REMARKS *5/5/81 OK to cover all work. JS*
(Replaced septic tank + 15' of cast iron pipe)

DATE SYSTEM APPROVED *5/5/81* INSPECTOR *Stayer*

103.1

194

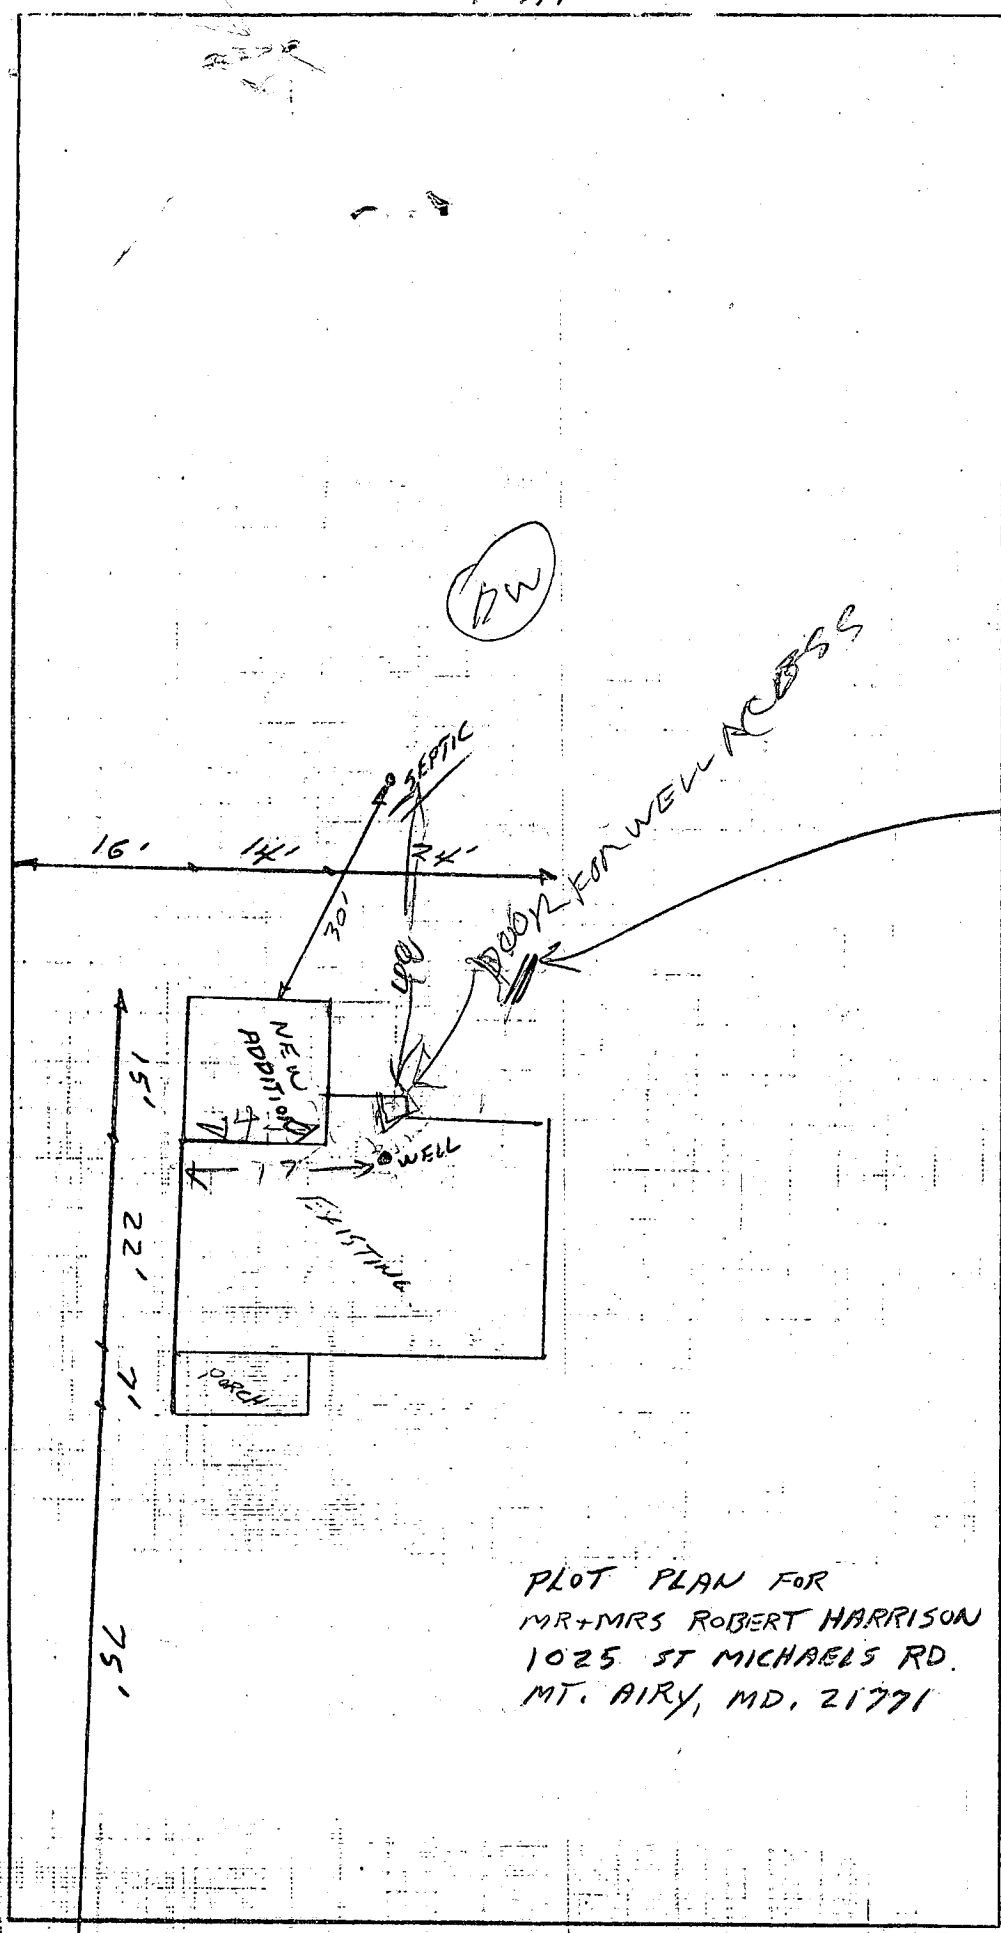

194

3/12/89
DO NOT
SIGN UNTIL
WASH WATER
OVERFLOW
IS FIXED
BH

3/13/90
CORRECTED PER
R.K. VINYL

103.1

ST. MICHAELS RD.

ST. Michaels Rd.

Robert C & Maggie A Hamm
1055 St Michaels Rd
Rt 3 Mc King Md 21771

21771

P. 31346

105'-0"

Drive way

66'-0"

28'-0"

Existing house

ALCOVE

DOOR FOR WELL ACCESS

Well

DECK

DECK

10' x 11' 2"

EXISTING DECK

Existing porch
10' x 22'

24' 48"

4-22-98

VERLEY WELL LOCATION

HOMECOMER SAYS THAT
A KITCHEN, SINK &
REMODELING WAS DONE
6 YRS AGO.

4/24/98

SITE INSP.

DECK/WELL HAS

ENCLOSURE OF EXISTING DECK

TO CREATE SUNROOM ACCESS

UNDERPACH AND TO WELL WILL

BE UNCHANGED IMPACT TO

WELL SHOULD BE UNCHANGED

RECOMMEND APPROVAL

Sh. Bny

202'-0"

103'-6"