

12/3/01 12/4/01
a.m.
AM

PERMIT

Approved: 12/4/01
36 Kill

P 31499

A Repair

SEWAGE DISPOSAL SYSTEM

MARYLAND STATE DEPARTMENT OF HEALTH

HOWARD COUNTY

02-283875

ELLICOTT CITY

DISTRICT 1st

INDEX

DATE 12/3/01

SEPTIC ABANDONED PROPERLY
ON 4/26/2000

Paul Schissler - South Carroll Backhoe Service IS PERMITTED TO INSTALL ALTER X

ADDRESS 7311 Brangles Road, Marriottsville, Md. 21104 PHONE 795-2642

SUBDIVISION ROAD 11032 Route 144 LOT

PROPERTY OWNER Charles Fisher

ADDRESS 11032 Route 144

SPECIFICATIONS

SEPTIC TANK CAPACITY GALLONS

DRAIN FIELD DEPTH FEET, BOTTOM AREA SQ. FT.

DEEP TRENCH DEPTH FEET, BOTTOM AREA SQ. FT.

SEEPAGE PITS ABSORBENT SIDE-WALL AREA SQ. FT.

INLET PIPE FT. BELOW ORIGINAL GRADE, MAXIMUM DEPTH FT. BELOW ORIGINAL GRADE

EFFECTIVE DEPTH AT FT. BELOW ORIGINAL GRADE

LOCATE DISPOSAL AREA FT. FROM LOT LINE AND FT. FROM LOT LINE AS SEEN WHEN
FACING LOT FROM

REPAIR - Call for an appointment when ground is opened up and Sanitarian will recommend

the repair system. Trench 90' long, 2' wide, inlet 10" 2 1/2', max length 7-7 1/2'

PLANS APPROVED BY Palmer F. Wine DATE 12/3/01

COVER NO WORK UNTIL INSPECTED AND APPROVED

NEITHER THE HOWARD COUNTY COUNCIL NOR THE HEALTH DEPARTMENT IS RESPONSIBLE FOR THE SUCCESSFUL OPERATION OF ANY SYSTEM.

NOTE: IF TRENCH IS USED CALL FOR INSPECTION BEFORE PLACING GRAVEL IN TRENCH.

NOTE: NO DRY WELL SHALL EXCEED 15 FOOT IN DIAMETER.

NOTE: ALL PIPE FROM HOUSE TO DISPOSAL AREA MUST BE CAST IRON.


PERMIT VOID AFTER THREE YEARS.

NOTE: INSTALL STAND PIPE ON SEPTIC TANK AND DRY WELL. STAND PIPES MUST BE 6 INCHES IN DIAMETER. CAST IRON, CONCRETE OR TERRA
COTTA ACCEPTED.

*INSTALLER IS RESPONSIBLE FOR OBTAINING FINAL APPROVAL ON THIS PERMIT.

31499

ROY & MARY'S
FRIENDLY INN

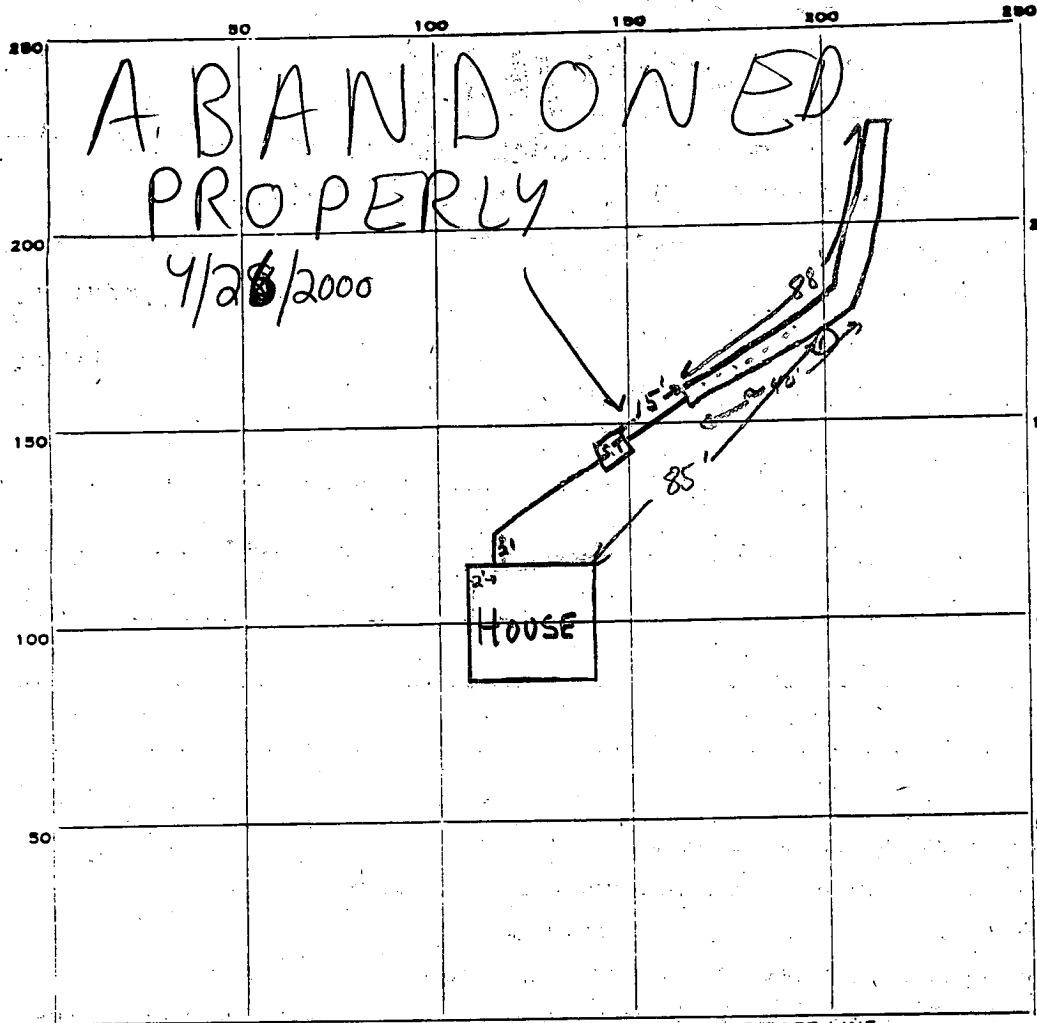

INDICATE NORTH - NAME ADJOINING ROADWAY AS BASE LINE.
West Md Rte 144 East

PERMIT CARD ☒ WORK O.K. CONTINUE

SEPTIC TANK, LEVEL ☒

CLEANOUTS

S.T.

yes

DISTRIBUTION BOX, LEVEL NA.

TILE FIELD, DEPTH 7 1/2 FT. TRENCH WIDTH 2 FT.

GRAVEL DEPTH 5 FT. TOTAL LENGTH 88 FT.

NUMBER OF TRENCHES 1

ONESIDE

TOTAL BOTTOM AREA

440 #

SEEPAGE PITS, INSIDE DIAMETER — FT. DEPTH BELOW INLET — FT.

ABSORBENT AREA — SQ. FT.

REMARKS O.K. to cover from house to septic tank; Call for final inspection before covering trench. F.S. 12/4/81 gravel + pipe in paper mat on, but at site. gave final approval. Time 9:20, had 9:30 p.m. ST

4/28/2000 - SEPTIC SYSTEM PROPERLY ABANDONED - DRS (SRU)

DATE SYSTEM APPROVED

12/4/81

INSPECTOR

Stephen A. Keel

88
5
440

WATER WELL ABANDONMENT-SEALING REPORT FORM

SUBMIT COPIES OF COMPLETED FORM TO:

- * COUNTY ENVIRONMENT AGENCY (contact MDE, WMA if address needed)
- * WELL OWNER
- * MDE, WATER MANAGEMENT ADMINISTRATION, WELL PROGRAM

DATE WELL ABANDONED: 4/28/00 (month/day/year)

* PERMIT NUMBER OF ABANDONED WELL (if any):

* PERMIT NUMBER OF REPLACEMENT WELL:

* PERSON ABANDONING WELL: Associated Excavators - Mike Johnson/Sam Ellis

WELL DRILLERS LICENSE NUMBER: N/A
CIRCLE: MWD/MSD/MGD


* OWNER'S NAME: Charles F. Fischer Jr.

* WELL LOCATION: (11032 Frederick Road (RT. 144) Ellicott City, MD 21042) Address of Well location

COUNTY: Howard
NEAREST TOWN: Ellicott City
TAX MAP 16 BLOCK 23 PARCEL 100
SUBDIVISION: N/A
SECTION: N/A LOT: N/A

MARYLAND GRID COORDINATES

BOX NUMBER E 830
N 530

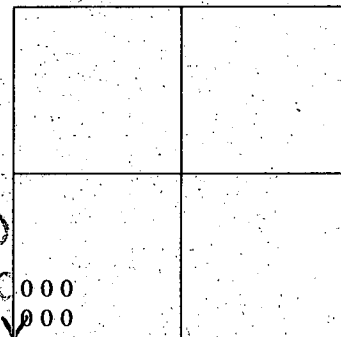

SHOW WELL LOCATION
BY X WITHIN BOX

* TYPE OF WELL BEING ABANDONED:

☐ DRILLED ☐ JETTED
☐ BORED/AUGURED ☒ HAND DUG
☐ OTHER (specify) _____

* USE CODE:

☒ DOMESTIC ☐ MUNICIPAL/PUBLIC
☐ IRRIGATION ☐ INDUSTRIAL
☐ TEST/OBSERVATION

* TYPE OF CASING:

☐ STEEL ☒ PLASTIC
☐ CONCRETE ☒ OTHER (specify) terracotta

* SIZE OF CASING: 2' INCHES IN DIAMETER

* DEPTH OF WELL: 19 FEET DEEP

* WAS ANY CASING REMOVED? ☒ YES ☐ NO AND plumbing removed
if yes, length removed, in feet: 3'

* WAS CASING RIPPED OR PERFORATED? ☐ YES ☒ NO

LOG OF SEALING MATERIAL

MATERIAL	FEET	
	FROM	TO
Clean Fill	0'	3'
Concrete	3'	19'

SIGNATURE Steven R. Krieg LICENSE # 1002(SIT) CIRCLE ONE MWD/MSD/MGD DATE 4/28/00

WATER WELL ABANDONMENT-SEALING REPORT FORM

02-263875

SUBMIT COPIES OF COMPLETED FORM TO:

- * COUNTY ENVIRONMENT AGENCY (contact MDE, WMA if address needed)
- * WELL OWNER
- * MDE, WATER MANAGEMENT ADMINISTRATION, WELL PROGRAM

DATE WELL ABANDONED: 4/28/00 (month/day/year)

* PERMIT NUMBER OF ABANDONED WELL (if any)

* PERMIT NUMBER OF REPLACEMENT WELL

Associated Excavators -

* PERSON ABANDONING WELL: Mike Johnson/Sam Ellis WELL DRILLERS LICENSE NUMBER: N/A
CIRCLE: MWD/MSD/MGD


* OWNER'S NAME: Charles F. Fischer Jr.

* WELL LOCATION: (11032 Frederick Road (RT. 144)) Address of
Ellicott City, MD 21042 Well location

COUNTY: Howard
NEAREST TOWN: Ellicott City
TAX MAP 16 BLOCK 23 PARCEL 100
SUBDIVISION: N/A
SECTION: N/A LOT: N/A

MARYLAND GRID COORDINATES

BOX NUMBER E 830
N 530

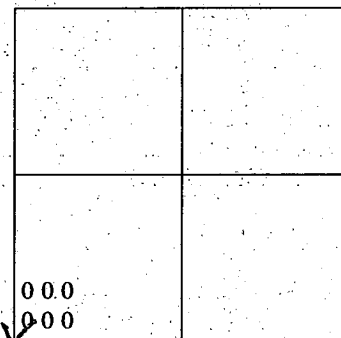

SHOW WELL LOCATION
BY X WITHIN BOX

* TYPE OF WELL BEING ABANDONED:

☒ DRILLED in pit and pump house shack
☐ BORED/AUGURED
☐ JETTED
☐ HAND DUG
☐ OTHER (specify) _____

* USE CODE:

☒ DOMESTIC
☐ IRRIGATION
☐ TEST/OBSERVATION
☐ MUNICIPAL/PUBLIC
☐ INDUSTRIAL

* TYPE OF CASING:

☒ STEEL
☐ CONCRETE
☐ PLASTIC
☐ OTHER (specify) _____

* SIZE OF CASING: 6 INCHES IN DIAMETER

* DEPTH OF WELL: 170 FEET DEEP

* WAS ANY CASING REMOVED? YES ☒ NO (Plumbing removed)
if yes, length removed, in feet: _____

* WAS CASING RIPPED OR PERFORATED? YES ☒ NO

LOG OF SEALING MATERIAL

MATERIAL	FEET	
	FROM	TO
Clean fill/Crushed Debris Concrete	0'	3'
	3'	170'

SIGNATURE - MASTER WELL DRILLER OR SUPERVISING SANITARIAN: Steven R. Krieg LICENSE # 1002(SIT) CIRCLE ONE: MWD/MSD/MGD DATE: 4/28/00

WELL AND SEPTIC ABANDONMENT

(11032 FREDERICK ROAD) →

P 31499

- ① Drilled Well in old pump house shack
(Served 11032)
→ Abandonment Insp. Requested 4/28/2000 12:30-1pm
Abandonment/Sealing done 4/28/2000 - (SRK)
- ② Old Hand dug well
(Probably served motel ruins)
→ Abandonment Insp. Requested 4/28/2000 12:30-1pm
Abandonment/Sealing done 4/28/2000 - (SRK)
- ③ Septic Tank
(Served 11032)
→ Abandonment Insp. Requested 4/26/2000 10:30-11
Abandonment done 4/26/2000 - (DKS) (SRK)
- ④ AREA OF BURIED TRASH/DRAINAGE
(Served motel ruins)

DRAWING BY DKS & SRK

