

PERMIT

APPROVED
11/18/81
RH

P 31704
A Repair

SEWAGE DISPOSAL SYSTEM

MARYLAND STATE DEPARTMENT OF HEALTH

HOWARD COUNTY

ELLICOTT CITY

DISTRICT 6th

DATE 11/16/81

INDEX

Jack Fyock

IS PERMITTED TO INSTALL ALTER X

ADDRESS 13775 Triadelphia Road, Glenelg, Md. 21737 PHONE 988-9270

SUBDIVISION ROAD 8406 Washington Boulevard LOT

PROPERTY OWNER Robinson's Country Inn (formerly Red Rooster Inn)

ADDRESS 8406 Washington Boulevard, Jessup, Md. 20794 Phone: 792-4939

SPECIFICATIONS

SEPTIC TANK CAPACITY GALLONS

DRAIN FIELD DEPTH FEET, BOTTOM AREA SQ. FT.

DEEP TRENCH DEPTH FEET, BOTTOM AREA SQ. FT.

SEEPAGE PITS ABSORBENT SIDE-WALL AREA SQ. FT.

INLET PIPE FT. BELOW ORIGINAL GRADE. MAXIMUM DEPTH FT. BELOW ORIGINAL GRADE

EFFECTIVE DEPTH AT FT. BELOW ORIGINAL GRADE.

LOCATE DISPOSAL AREA FT. FROM LOT LINE AND FT. FROM LOT LINE AS SEEN WHEN

FACING LOT FROM

LEACHING BED - 4 ft. deep below original grade, 40 ft. wide, 60 ft. LONG, filled with 2 ft. of stone, with 2 inches over the distribution pipes and 1 1/2 ft. under the distribution pipe. Inlet to bed to be 2 ft. below original grade. Place bed between perc hole 2 and perc hole 3 and perc hole 6. Perc hole 3 is located 131 ft. from the back of the building and 10 ft. from the left side of the lot as seen when facing the lot from Washington Boulevard. Perc hole 2 is located 200 ft. from the back of the building and 10 ft. from the left side of the lot as seen when facing the lot from Washington Boulevard. Perc hole is located 140 ft. from the back of the building

PLANS APPROVED BY DATE

COVER NO WORK UNTIL INSPECTED AND APPROVED.

NEITHER THE HOWARD COUNTY COUNCIL NOR THE HEALTH DEPARTMENT IS RESPONSIBLE FOR THE SUCCESSFUL OPERATION OF ANY SYSTEM.

NOTE: IF TRENCH IS USED CALL FOR INSPECTION BEFORE PLACING GRAVEL IN TRENCH.


NOTE: NO DRY WELL SHALL EXCEED 15 FOOT IN DIAMETER.

NOTE: ALL PIPE FROM HOUSE TO DISPOSAL AREA MUST BE CAST IRON.

PERMIT VOID AFTER THREE YEARS.

NOTE: INSTALL STAND PIPE ON SEPTIC TANK AND DRY WELL. STAND PIPES MUST BE 6 INCHES IN DIAMETER. CAST IRON, CONCRETE OR TERRA COTTA ACCEPTED.

*INSTALLER IS RESPONSIBLE FOR OBTAINING FINAL APPROVAL ON THIS PERMIT.

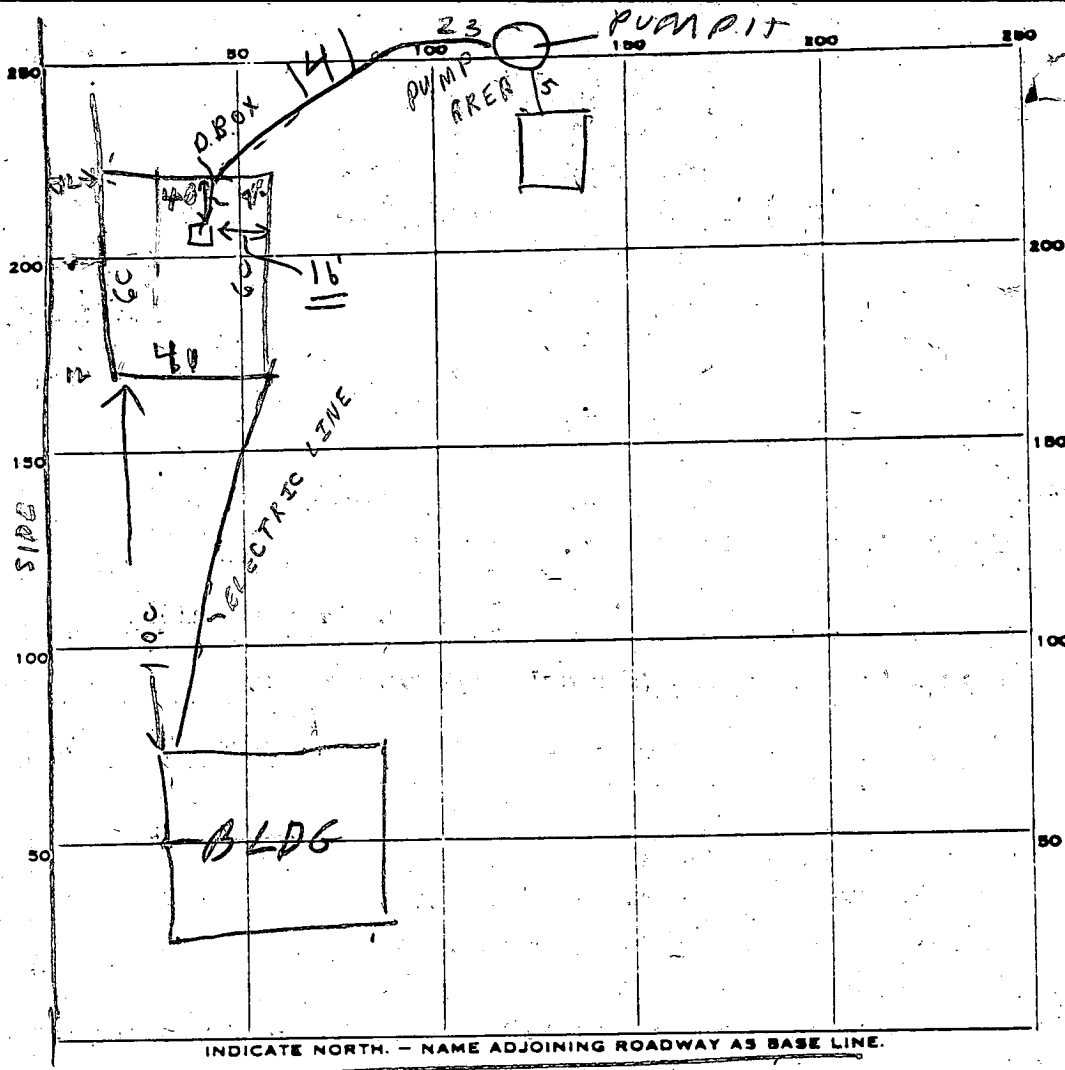

INDICATE NORTH. - NAME ADJOINING ROADWAY AS BASE LINE.

WASH BLVD

PERMIT CARD

SEPTIC TANK, LEVEL

CLEANOUTS

DISTRIBUTION BOX, LEVEL

BED TILE FIELD, DEPTH 4 FT. TRENCH WIDTH 40 FT.

GRAVEL DEPTH 2 1/2" avg. TOTAL LENGTH 60 FT.

NUMBER OF TRENCHES

TOTAL BOTTOM AREA

SEEPAGE PITS, INSIDE DIAMETER FT. DEPTH BELOW INLET FT.

ABSORBENT AREA 2400 SQ. FT.

REMARKS 11/16/81 BED OK, ADD STONE PIPE & CALL RH

11/17/81 OK TO COVER STONE IN TRENCH & OR SEEPAGE BED ONLY; NEED C.B.P.

TO SEE PUMP WORKING & EFFLUENT INTO DISTRIBUTION BOX + LINE C.B.P.

FROM PUMP TO DISTRIBUTION BOX

11/18/81 OK TO COVER PIPE FROM PUMP PIT TO D.B. PUMP NOT READY C.B.P.

11/19/81 1130 - PUMP TESTED OK, OK TO BACK FILL SYSTEM

DATE SYSTEM APPROVED

11/18/81

INSPECTOR

Raymond Hodge

*DECIDED NOT TO PUT INSPECTION CLEANOUT IN BED BECAUSE IN PARKING LOT

PERMIT

SEWAGE DISPOSAL SYSTEM

MARYLAND STATE DEPARTMENT OF HEALTH

HOWARD COUNTY

ELLICOTT CITY

DISTRICT 6th

DATE 11/16/81

Jack Fyock

IS PERMITTED TO INSTALL ALTER X

ADDRESS _____ PHONE _____

SUBDIVISION _____ ROAD 8406 Washington Boulevard LOT _____

PROPERTY OWNER Robinson's Country Inn (formerly Red Rooster Inn)

ADDRESS _____

SPECIFICATIONS

SEPTIC TANK CAPACITY _____ GALLONS

DRAIN FIELD _____ DEPTH _____ FEET, BOTTOM AREA _____ SQ. FT.

DEEP TRENCH _____ DEPTH _____ FEET, BOTTOM AREA _____ SQ. FT.

SEEPAGE PITS _____ ABSORBENT SIDE-WALL AREA _____ SQ. FT.

INLET PIPE _____ FT. BELOW ORIGINAL GRADE. MAXIMUM DEPTH _____ FT. BELOW ORIGINAL GRADE

EFFECTIVE DEPTH AT _____ FT. BELOW ORIGINAL GRADE.

LOCATE DISPOSAL AREA _____ FT. FROM _____ LOT LINE AND _____ FT. FROM _____ LOT LINE AS SEEN WHEN

^{FACING LOT FROM}
and 60 ft. ~~from the left side of the lot as seen when facing the lot from Washington Boulevard.~~ Distribution box in bed needed. Distribution pipes to be 10 ft. apart. Two inspections of the bed are needed, before the stone is added and after the stone is added. A sewage pump will be needed if the existing septic tank is used. Install the pump in a pump pit down stream from the tank. If a new tank is used, it must hold 2000 gallons. Install the tank between the bed and the building. The pipe from the pump to the bed must be run through a sleeve pipe because the pipe goes under a parking lot. Cast iron pipe or plastic can be used. The plastic pipe must be Schedule 40 with ASTM 2661-74 for ABS pipe or ASTM 2665-74 for PVC pipe.

PLANS APPROVED BY Raymond Hodges DATE 11/12/81

COVER NO WORK UNTIL INSPECTED AND APPROVED.

NEITHER THE HOWARD COUNTY COUNCIL NOR THE HEALTH DEPARTMENT IS RESPONSIBLE FOR THE SUCCESSFUL OPERATION OF ANY SYSTEM.

NOTE: IF TRENCH IS USED CALL FOR INSPECTION BEFORE PLACING GRAVEL IN TRENCH.

NOTE: NO DRY WELL SHALL EXCEED 15 FOOT IN DIAMETER.

NOTE: ALL PIPE FROM HOUSE TO DISPOSAL AREA MUST BE CAST IRON.

PERMIT VOID AFTER THREE YEARS.

NOTE: INSTALL STAND PIPE ON SEPTIC TANK AND DRY WELL. STAND PIPES MUST BE 6 INCHES IN DIAMETER. CAST IRON, CONCRETE OR TERRA COTTA ACCEPTED.

***INSTALLER IS RESPONSIBLE FOR OBTAINING FINAL APPROVAL ON THIS PERMIT.**

250	50	100	150	200	250
200					200
150					150
100					100
50					50

INDICATE NORTH. - NAME ADJOINING ROADWAY AS BASE LINE.

PERMIT CARD _____

SEPTIC TANK, LEVEL _____

CLEANOUTS _____

DISTRIBUTION BOX, LEVEL _____

TILE FIELD, DEPTH _____ FT. TRENCH WIDTH _____ FT.

GRAVEL DEPTH _____ IN. TOTAL LENGTH _____ FT.

NUMBER OF TRENCHES _____ TOTAL BOTTOM AREA _____

SEEPAGE PITS, INSIDE DIAMETER _____ FT. DEPTH BELOW INLET _____ FT.

ABSORBENT AREA _____ SQ. FT.

REMARKS _____

DATE SYSTEM APPROVED _____ INSPECTOR _____

Repair perc
11/5/81
10:00 A.M.

APPLICATION

SEWAGE DISPOSAL TESTING

A Repair perc

STATE OF MARYLAND - DEPARTMENT OF HEALTH AND MENTAL HYGIENE

P _____

HOWARD COUNTY HEALTH DEPARTMENT
ENVIRONMENTAL HEALTH SERVICES

DISTRICT _____

P. O. BOX 473 ELLICOTT CITY, MARYLAND 21043
TELEPHONE: 992-2330

LEACHING BED 4 FT DEEP 800 FT 11/4/81

40 FT WIDE 60 FT LONG FILLED WITH 2 FT OF
STONE WITH 2 INCHES OVER THE DISTRIBUTION PIPES &
1 1/2 FT UNDER THE DISTRIBUTION PIPE INLET TO BED TO BE 2 FT. B.O.G.
PLACE BED BETWEEN PERC HOLE ② & PERC HOLE ③ & PERC HOLE ⑥

TO: THE COUNTY HEALTH OFFICER SEE ATTACHED SHEET FOR SPECS
ELLICOTT CITY, MARYLAND

I, HEREBY, APPLY FOR THE NECESSARY TEST IN ORDER TO CONSTRUCT (OR RECONSTRUCT) A SEWAGE DISPOSAL SYSTEM.

Robinson's Country Inn
792-4939

PROPERTY OWNER Robinson's Country Inn (formerly Red Rooster Inn)

ADDRESS 8406 Washington Boulevard, Jessup, Md. 20794 PHONE Fyock - 988-9270

PROPERTY LOCATION:

SUBDIVISION _____ LOT NO. _____

ROAD AND DESCRIPTION 8406 Washington Boulevard

SIZE OF LOT (?) TYPE BLDG. Restaurant
(NUMBER OF BEDROOMS)

THE SYSTEM INSTALLED UNDER THIS APPLICATION IS ACCEPTABLE ONLY UNTIL PUBLIC FACILITIES BECOME AVAILABLE. I FULLY UNDERSTAND THE
FEE CONNECTED WITH THE FILING OF THIS PERC TEST APPLICATION IS NON-REFUNDABLE UNDER ANY CIRCUMSTANCES. I ALSO AGREE TO COMPLY
WITH ALL M.O.S.H.A. REQUIREMENTS IN TESTING THIS LOT/s/ Jack Fyock for Robinson's Country Inn
(SIGNATURE OF APPLICANT)

APPROVED BY _____ FOR _____ DATE _____

REJECTED BY _____ FOR _____ DATE _____

HOLD PENDING FURTHER TESTS _____ DATE _____


REASONS FOR REJECTION OR HOLDING _____

THIS IS NOT A PERMIT

SOIL PROFILE

ALL CLAY

7 1/2

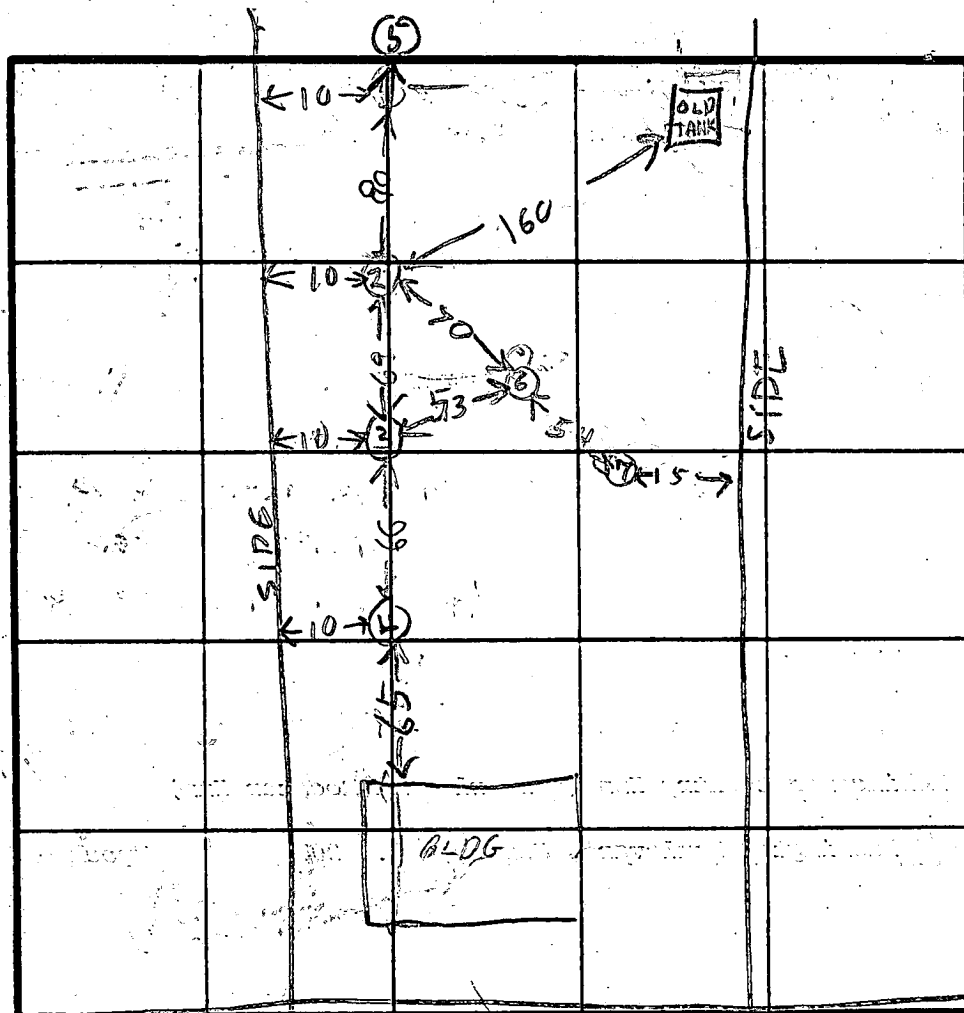

271 500
13 20 100
129 50
02 10

INDICATE NORTH - NAME ADJOINING ROADWAY AS BASE LINE.

WASH BLVD

DATE	TEST NO.	DEPTH	PRE-WET		TEST - 1" DROP		TIME
			START	STOP	START	STOP	
11/5/87	1	7 1/2	1035	1100	Little	pen	FAIL
	2V	8	TOP 4FT	3FT SAND	CLAY MID	1FT CLAY	
	3S	4	1142	1143	1143	1144	11
	3V	8 1/2	TOP 2FT	CLAY MID 5FT	SAND		
	4V	9	ALL	CLAY			
	5V	7	TOP 4FT	CLAY	3FT	CLAY IS H & SANDY	
	6V	9	TOP 3FT	CLAY			
	7V	6	TOP 2FT	FILL			
			BOT 4FT	CLAY			


Hole in wood see other sheet

REMARKS Observed Water Meter Bell 160000 and Max to Aug 1777 gal per Day But had leak at time

75 Seats 5 Bedroom House

TESTED BY R HODGES

ALSO PRESENT J. FYOCK & SKIP BECKY

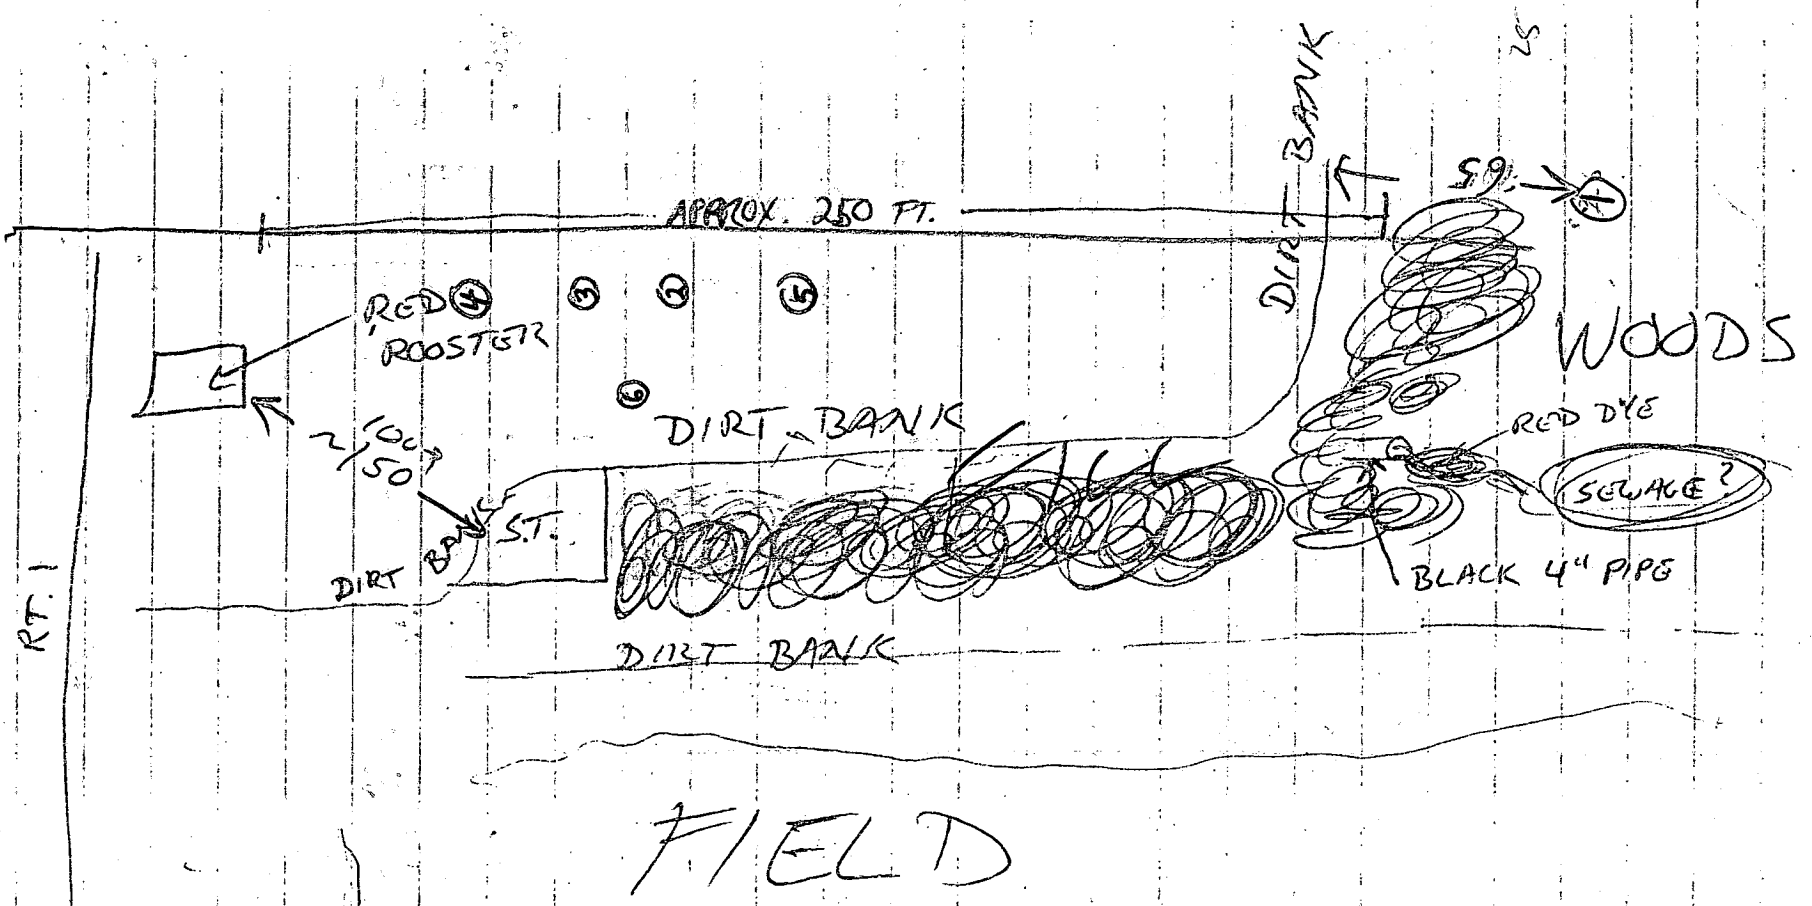

B. 1133

1777
 90/160,000
 90
 700
 630
 700
 630
 700

10 gal / person / day Restaurant
3 gal / pers / meal

92
30

122

ROBINSONS COUNTRY INN (FORMERLY RED ROOSTER)
8406 WASH BLVD

131
69
200

SPECIFICATIONS - CONTINUED

PERC HOLE (3) IS LOCATED 131 FT FROM THE BACK OF THE BUILDING AND 10 FT FROM THE LEFT SIDE OF THE LOT AS SEEN WHEN FACING THE LOT FROM WASH BLVD. PERC HOLE (2) IS LOCATED 200 FT FROM THE BACK OF THE BUILDING AND 10 FT FROM THE LEFT SIDE OF THE LOT AS SEEN WHEN FACING THE LOT FROM WASH BLVD. PERC HOLE IS LOCATED 140 FT FROM THE BACK OF THE BUILDING AND 60 FT FROM THE LEFT SIDE OF THE LOT AS SEEN WHEN FACING THE LOT FROM WASH. BLVD.

(D) DISTRIBUTION BOX IN BED NEEDED

DISTRIBUTION PIPES TO BE 10 FT APART

TWO INSPECTIONS OF THE BED ARE NEEDED, BEFORE THE STONE IS ADDED & AFTER THE STONE IS ADDED.

A SEWAGE PUMP WILL BE NEEDED IF THE EXISTING SEPTIC TANK IS USED. INSTALL THE PUMP IN A PUMP PIT DOWN STREAM FROM THE TANK.

IF A NEW TANK IS USED, IT MUST HOLD 2000 GAL. INSTALL THE TANK BETWEEN THE BED & THE BUILDING.

THE PIPE FROM THE PUMP TO THE BED MUST BE RUN THROUGH A SLEEVE PIPE BECAUSE THE PIPE GOES UNDER A PARKING LOT. CAST IRON PIPE OR PLASTIC CAN BE USED. THE PLASTIC PIPE MUST BE SCHEDULE 40 WITH ASTM 2661-74 FOR ABS PIPE OR ASTM 2665-74 FOR PVC PIPE.