

PERMIT

SEWAGE DISPOSAL SYSTEM

MARYLAND STATE DEPARTMENT OF HEALTH

HOWARD COUNTY

ELLICOTT CITY

DISTRICT

DATE 4/2/82

INDEXED

Cecil Crenshaw

IS PERMITTED TO INSTALL ALTER X

ADDRESS 5454 Water Loo Road, Col., Md.

PHONE 465-4772

SUBDIVISION

ROAD 6701 Surry Lane

LOT 58, SEC. 3

PROPERTY OWNER Mr. Eaton

ADDRESS 6701 Surry Lane, Clarksville, Maryland 21029

SPECIFICATIONS

SEPTIC TANK CAPACITY GALLONS

DRAIN FIELD DEPTH FEET, BOTTOM AREA SQ. FT.

DEEP TRENCH DEPTH FEET, BOTTOM AREA SQ. FT.

SEEPAGE PITS ABSORBENT SIDE-WALL AREA SQ. FT.

INLET PIPE FT. BELOW ORIGINAL GRADE. MAXIMUM DEPTH FT. BELOW ORIGINAL GRADE

EFFECTIVE DEPTH AT FT. BELOW ORIGINAL GRADE.

LOCATE DISPOSAL AREA FT. FROM LOT LINE AND FT. FROM LOT LINE AS SEEN WHEN
FACING LOT FROM

REPAIR - CALL FOR INSEPCION WHEN GROUND IS OPENED UP SO SANITARIAN CAN
RECOMMEND REPAIR

PLANS APPROVED BY Palmer F. Wine

DATE April 2, 1982

COVER NO WORK UNTIL INSPECTED AND APPROVED.

NEITHER THE HOWARD COUNTY COUNCIL NOR THE HEALTH DEPARTMENT IS RESPONSIBLE FOR THE SUCCESSFUL OPERATION OF ANY SYSTEM.

NOTE: IF TRENCH IS USED CALL FOR INSPECTION BEFORE PLACING GRAVEL IN TRENCH.

NOTE: NO DRY WELL SHALL EXCEED 15 FOOT IN DIAMETER.


NOTE: ALL PIPE FROM HOUSE TO DISPOSAL AREA MUST BE CAST IRON.

PERMIT VOID AFTER THREE YEARS.

NOTE: INSTALL STAND PIPE ON SEPTIC TANK AND DRY WELL. STAND PIPES MUST BE 6 INCHES IN DIAMETER. CAST IRON, CONCRETE OR TERRA
COTTA ACCEPTED.

*INSTALLER IS RESPONSIBLE FOR OBTAINING FINAL APPROVAL ON THIS PERMIT.

A 00345

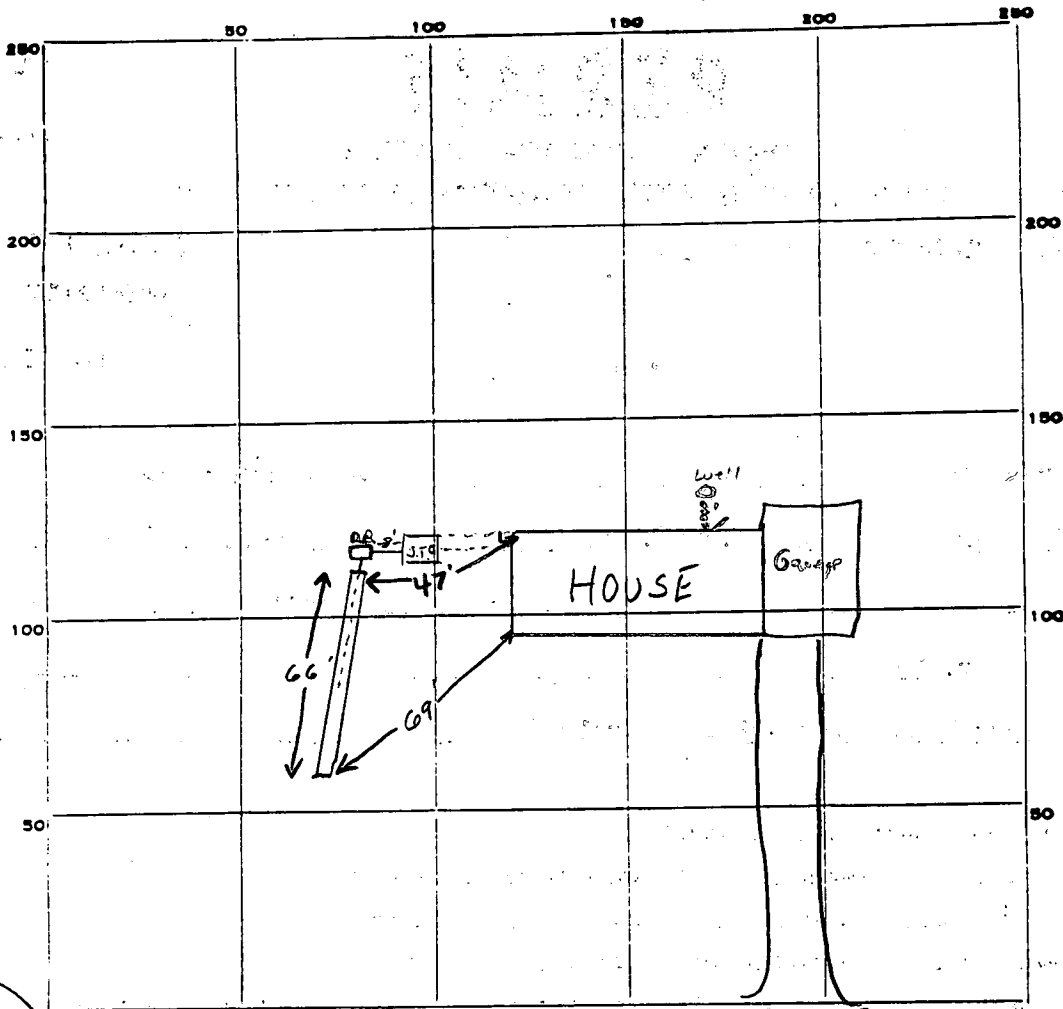

INDICATE NORTH. NAME ADJOINING ROADWAY AS BASE LINE.

Surrey Lane

PERMIT CARD

S.T. trench

SEPTIC TANK, LEVEL existing

CLEANOUTS existing n.a.

DISTRIBUTION BOX, LEVEL O.K.

TILE FIELD, DEPTH 11 FT. TRENCH WIDTH 2 FT.

GRAVEL DEPTH 8 FT. TOTAL LENGTH 66 FT.

NUMBER OF TRENCHES 1 ONE SIDE TOTAL BOTTOM AREA ± 462 SQ. FT.

66
7
462

SEEPAGE PITS, INSIDE DIAMETER — FT. DEPTH BELOW INLET 7 FT.

ABSORBENT AREA ± 462 SQ. FT.

REMARKS 4/12/82 Trench dug to 11 ft for Mrs. Eaton, trench is 65 ft long. 11 ft deep, top of gravel is 23 ft. below grade S.S.

DATE SYSTEM APPROVED

4/12/82

INSPECTOR

F. Skimer

4/2/82
1000

FILE Septic System Check DATE REPORTED 4/1/82
PROPERTY OWNER Eaton CLARKSVILLE RIDGE LOT 5850
P.O. ADDRESS 6701 Surrey Lane TELEPHONE _____
DIRECTIONS TO PROPERTY Clarksville Ridge 2 BR & DEN

INFORMANT

51
7
357

360

CONDITION FOUND 4/1/82 - MET WITH OWNER
& BACKHOLE MAN SEE OTHER SIDE
DECIDE DEEP DITCH 11 FT DEEP
WITH INLET AT 4 FT AND 7 FT OF
STONE & 2 FT WIDE, & 51 FT
LONG DITCH RUN DITCH OFF
DISTRIBUTION BOX TOWARD SURREY LANE
ACTION TAKEN 360 SQ FT ONE SIDE WALL
AREA. REQUIRED IN THE REPAIR
DITCH

FINAL DISPOSITION

$$\begin{array}{r} 51 \\ 7 \overline{) 360} \\ \underline{35} \\ 10 \end{array}$$

