

PERMIT

SEWAGE DISPOSAL SYSTEM

MARYLAND STATE DEPARTMENT OF HEALTH

HOWARD COUNTY

ELLICOTT CITY

DISTRICT 8th 2nd

DATE 4/30/82

INDEX

A Repair

Jack Fyock

IS PERMITTED TO INSTALL ALTER X

ADDRESS 13775 Triadelphia Road, Glenelg, Md. 21737 PHONE 988-9270

SUBDIVISION _____ ROAD 11490 Route 144 LOT _____

PROPERTY OWNER Otis Oursler

ADDRESS 11490 Route 144, Ellicott City, Md. 21043

SPECIFICATIONS

SEPTIC TANK CAPACITY _____ GALLONS

DRAIN FIELD _____ DEPTH _____ FEET, BOTTOM AREA _____ SQ. FT.

DEEP TRENCH _____ DEPTH _____ FEET, BOTTOM AREA _____ SQ. FT.

SEEPAGE PITS _____ ABSORBENT SIDE-WALL AREA _____ SQ. FT.

INLET PIPE _____ FT. BELOW ORIGINAL GRADE. MAXIMUM DEPTH _____ FT. BELOW ORIGINAL GRADE

EFFECTIVE DEPTH AT _____ FT. BELOW ORIGINAL GRADE.

LOCATE DISPOSAL AREA _____ FT. FROM _____ LOT LINE AND _____ FT. FROM _____ LOT LINE AS SEEN WHEN
FACING LOT FROM

REPAIR - Call for an appointment when ground is opened up and Sanitarian will

recommend the repair system.

PLANS APPROVED BY Palmer F. Wine DATE 4/20/82

COVER NO WORK UNTIL INSPECTED AND APPROVED.

NEITHER THE HOWARD COUNTY COUNCIL NOR THE HEALTH DEPARTMENT IS RESPONSIBLE FOR THE SUCCESSFUL OPERATION OF ANY SYSTEM.

NOTE: IF TRENCH IS USED CALL FOR INSPECTION BEFORE PLACING GRAVEL IN TRENCH.


NOTE: NO DRY WELL SHALL EXCEED 15 FOOT IN DIAMETER.

NOTE: ALL PIPE FROM HOUSE TO DISPOSAL AREA MUST BE CAST IRON.

PERMIT VOID AFTER THREE YEARS.

NOTE: INSTALL STAND PIPE ON SEPTIC TANK AND DRY WELL. STAND PIPES MUST BE 6 INCHES IN DIAMETER. CAST IRON, CONCRETE OR TERRA
COTTA ACCEPTED.

***INSTALLER IS RESPONSIBLE FOR OBTAINING FINAL APPROVAL ON THIS PERMIT.**

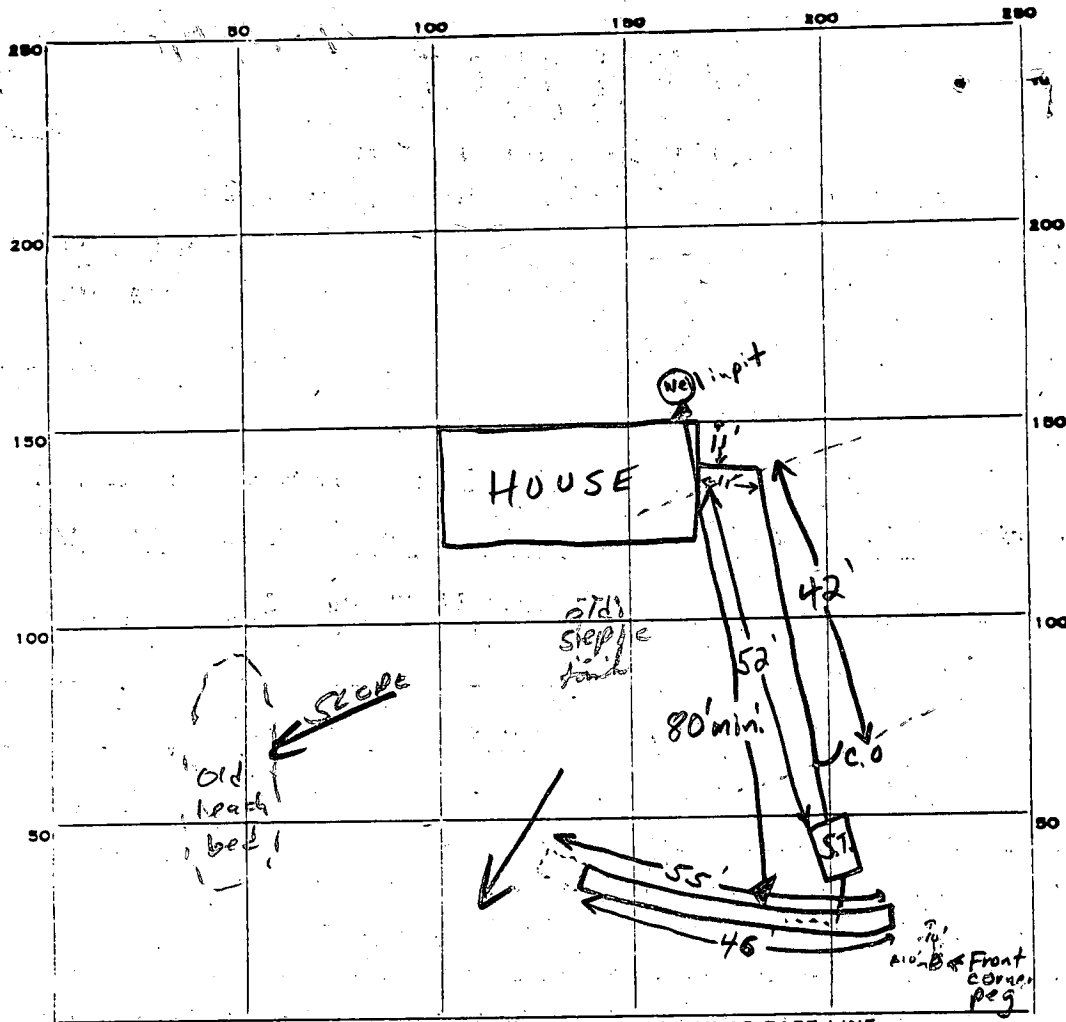

INDICATE NORTH. NAME ADJOINING ROADWAY AS BASE LINE.

Rte. 144

PERMIT CARD verbal OK to proceed to J. Ryack

SEPTIC TANK, LEVEL ✓

S.T.	trench
✓	n.a.

DISTRIBUTION BOX, LEVEL n.o.

TILE FIELD, DEPTH 10 FT. TRENCH WIDTH 2 FT.

GRAVEL DEPTH 8 FT. TOTAL LENGTH 55 FT.

NUMBER OF TRENCHES 1 ONE SIDE TOTAL BOTTOM AREA ±41.2

SEEPAGE PITS, INSIDE DIAMETER — FT. DEPTH BELOW INLET 7.5 FT.

ABSORBENT AREA ±41.2 SQ. FT.

REMARKS 5/11/82 Schedule 40 Plastic pipe used for S. new 1000 gal. tank used as old tank is very deep in ground OK to gravel tank for S.
5/12/82 Verbal OK to cover all work

DATE SYSTEM APPROVED

5/12/82

INSPECTOR

F. Skinner

9/13/62

PERMIT

approved 9/13/62

P 05731
A 05155

SEWAGE DISPOSAL SYSTEM

MARYLAND STATE DEPARTMENT OF HEALTH

HOWARD COUNTY

ELLICOTT CITY

INDEXED

DISTRICT 3

DATE 9/6/62

INDEXED

Excavating Contractors

IS PERMITTED TO INSTALL ALTER

ADDRESS

PHONE

A SEWAGE DISPOSAL SYSTEM LOCATED AT

Rt 144 - 1800 feet west
of Marriottsville Rd.

SUBDIVISION

ROAD

LOT

PROPERTY OWNER

John Overster

ADDRESS

SPECIFICATIONS

DRAIN FIELD DEPTH FEET, BOTTOM AREA SQ. FT.

SEEPAGE PITS ABSORBENT SIDE-WALL AREA SQ. FT.

SEPTIC TANK CAPACITY 750 GALLONS

FOR GARBAGE GRINDER, INCREASE DISPOSAL AREA 22% & TANK CAPACITY 50%.

OTHER

Leaching Bed - 15' by 31' long. Locate the 15 foot side 30 feet from the property line holding Rt 144 with the other 15 ft. side 61/2 ft from the property line. The 31 ft. side (side farthest from house) is to be located 60 ft from the 150 property line. Total depth of bed 5 feet on shallow side. 2 effluent

PLANS APPROVED BY

J E Hennigan

DATE


5/16/62

FILL SEPTIC TANK AND DISTRIBUTION BOX WITH WATER BEFORE CALLING FOR AN INSPECTION. COVER NO WORK UNTIL INSPECTED AND APPROVED.

NEITHER THE HOWARD COUNTY COMMISSIONERS NOR THE HEALTH DEPARTMENT IS RESPONSIBLE FOR THE SUCCESSFUL OPERATION OF ANY SYSTEM.

lines in bed, on centers

A 05155

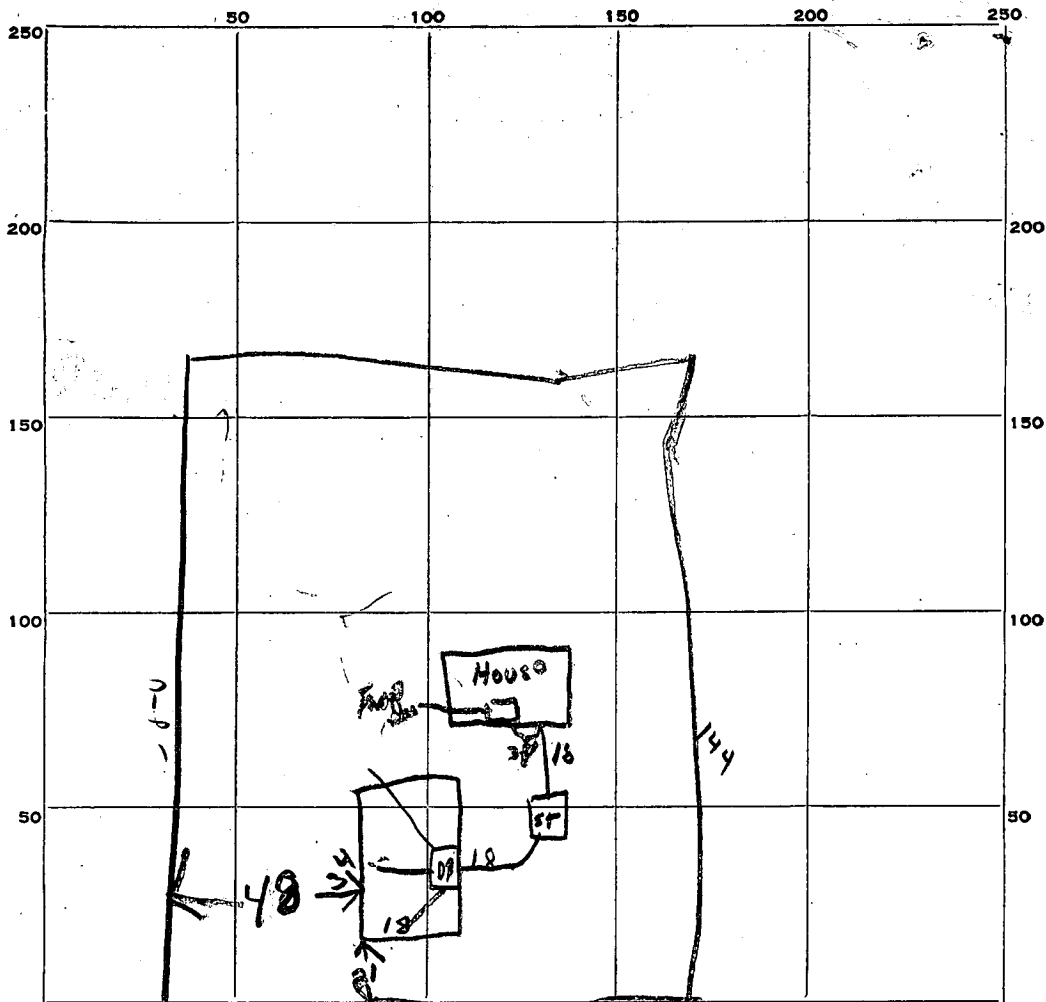

PERMIT CARD

SEPTIC TANK, LEVEL

CLEANOUTS

DISTRIBUTION BOX, LEVEL

TILE FIELD, DEPTH 568 FT. TRENCH WIDTH 18 FT.

GRAVEL DEPTH 36 IN. TOTAL LENGTH 34 FT.

NUMBER OF TRENCHES TOTAL BOTTOM AREA 512 sq. ft.

SEEPAGE PITS, INSIDE DIAMETER FT. DEPTH BELOW INLET FT.

ABSORBENT AREA SQ. FT.

REMARKS

9/13/67
Disturb from front line to back line
Disturb from left side (15' wide) to right side (15' wide)
Should be 60 ft
needs relief

DATE SYSTEM APPROVED

9/13/67

INSPECTOR

See Monaghan

APPLICATION

A 05155

P

SEWAGE DISPOSAL TESTING

MARYLAND STATE DEPARTMENT OF HEALTH

HOWARD COUNTY

ELLICOTT CITY

DISTRICT

3

DATE May 14, 1962

Leaching bed 15 ft wide by 31 ft long. Locate the 15 ft side 30 ft from the property line bordering RT. 144 with the other 15 ft side 61 ft from this property line. The 31 ft side, also known as the shallow side or side farthest from the house, will be located 60 ft. from the 150 ft property line or property line farthest west. ^{which is side farthest west.} ^{2 effluent lines in bed, on contour.} ^{75 gal septic tank}

TO: THE COUNTY HEALTH OFFICER
ELLICOTT CITY, MARYLAND

I, HEREBY, APPLY FOR THE NECESSARY TESTS IN ORDER TO CONSTRUCT (OR RECONSTRUCT) A SEWAGE DISPOSAL SYSTEM.

PROPERTY OWNER

ADDRESS

PHONE

PROPERTY LOCATION:

SUBDIVISION

LOT NO.

ROAD AND DESCRIPTION

OCCUPANT

PHONE

PERSON TO CONSTRUCT SYSTEM

ADDRESS

PHONE

SIZE OF LOT

TYPE BLDG.

NUMBER OF BEDROOMS

IF NOT SINGLE RESIDENCE DESCRIBE

SIGNATURE OF APPLICANT

APPROVED BY

FOR

(KIND OF SYSTEM)

DATE

REJECTED BY

FOR

(KIND OF SYSTEM)


DATE

HOLD PENDING FURTHER TESTS

DATE

REASONS FOR REJECTION OR HOLDING

THIS IS NOT A PERMIT

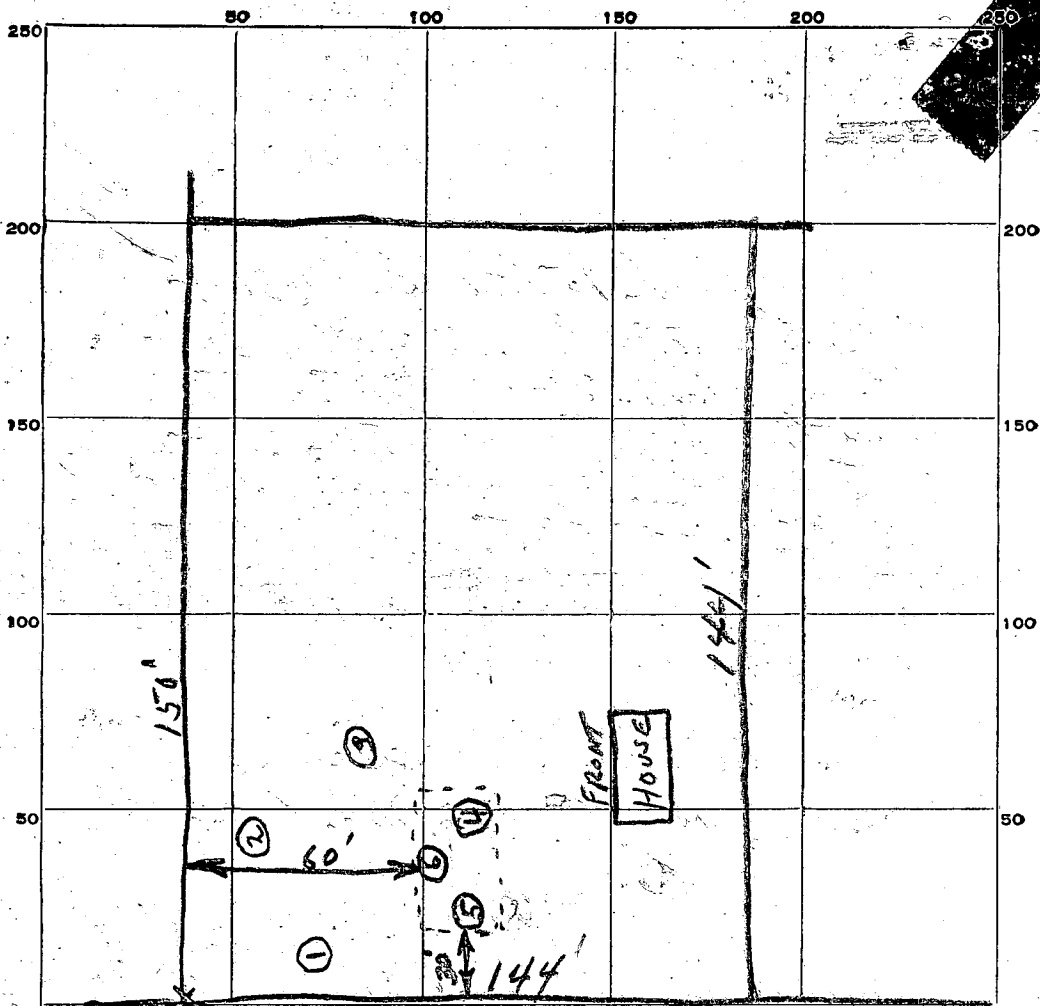

INDICATE NORTH. - NAME ADJOINING ROADWAY AS BASE LINE.

BT. 144.

DATE	TEST NO.	DEPTH	PRE-WET		TEST - 1" DROP		TIME
			START	STOP	START	STOP	
5-16-62	1	3 FT	1:43	1:49	1:49	2:01	11 Min.
	2		1:45	1/2" in		45 Min.	
	3		2:02	1/2" in		1 hr	
	4	3 1/2	2:32	2:35	2:35	2:39	4 Min.
	5	3	3:12	3:38	3:38	4:17	39 Min.
	6	3 1/2	3:14	3:19	3:19	3:28	9 Min.

SOIL AUGER FINDING Shallow end of bed depth. 5 FT total.

TESTED BY J. Hennigan

REMARKS

5-16-62 Mrs. John O. Owsler

LOT NO.