

PERMIT

SEWAGE DISPOSAL SYSTEM

MARYLAND STATE DEPARTMENT OF HEALTH

HOWARD COUNTY

01-176757

ELLICOTT CITY

DISTRICT

DATE 5/14/82

INDEX

P 31931

A REPAIR PERC

Mr. Neubauer

IS PERMITTED TO INSTALL ☒ ALTER ☒

ADDRESS

PHONE

SUBDIVISION

ROAD 7550 Washington Blvd., E.C. LOT

PROPERTY OWNER Blue Stream Partnership

1465-2020

ADDRESS P.O. Box 416, Ellicott City, Md.

SPECIFICATIONS #3 Bedrooms Existing house on property.

SEPTIC TANK CAPACITY GALLONS

DRAIN FIELD DEPTH FEET, BOTTOM AREA SQ. FT.

DEEP TRENCH DEPTH FEET, BOTTOM AREA SQ. FT.

SEEPAGE PITS ABSORBENT SIDE-WALL AREA SQ. FT.

INLET PIPE FT. BELOW ORIGINAL GRADE, MAXIMUM DEPTH FT. BELOW ORIGINAL GRADE

EFFECTIVE DEPTH AT FT. BELOW ORIGINAL GRADE.

LOCATE DISPOSAL AREA FT. FROM LOT LINE AND FT. FROM LOT LINE AS SEEN WHEN
FACING LOT FROM

* REPAIR - CALL FOR INSEPCION WHEN GROUND IS OPENED UP SO SANITARIAN CAN
RECOMMEND REPAIR.

FS APPROVED 2000 GAL TANK WITH
MANHOLE & FULL LEVEL WARNING DEVICE R

PLANS APPROVED BY Palmer F. Wine

DATE 5/14/82

COVER NO WORK UNTIL INSPECTED AND APPROVED.

NEITHER THE HOWARD COUNTY COUNCIL NOR THE HEALTH DEPARTMENT IS RESPONSIBLE FOR THE SUCCESSFUL OPERATION OF ANY SYSTEM.

NOTE: IF TRENCH IS USED CALL FOR INSPECTION BEFORE PLACING GRAVEL IN TRENCH.


NOTE: NO DRY WELL SHALL EXCEED 15 FOOT IN DIAMETER.

NOTE: ALL PIPE FROM HOUSE TO DISPOSAL AREA MUST BE CAST IRON.

PERMIT VOID AFTER THREE YEARS.

NOTE: INSTALL STAND PIPE ON SEPTIC TANK AND DRY WELL. STAND PIPES MUST BE 6 INCHES IN DIAMETER. CAST IRON, CONCRETE OR TERRA
COTTA ACCEPTED.

*INSTALLER IS RESPONSIBLE FOR OBTAINING FINAL APPROVAL ON THIS PERMIT.

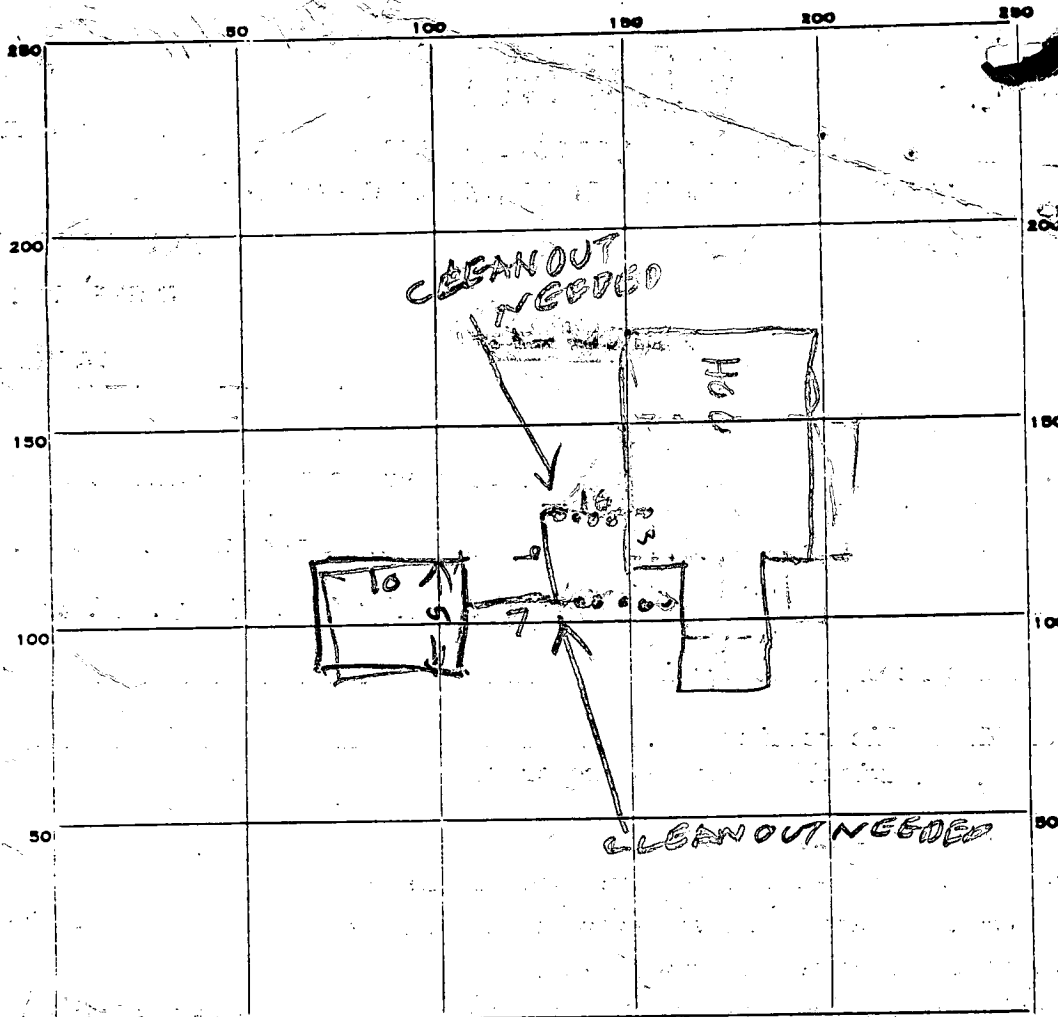

PERMIT CARD ✓ Signed ST
 SEPTIC TANK, LEVEL OK 2000 CLEANOUTS MANHOLE
 DISTRIBUTION BOX, LEVEL N.A.
 TILE FIELD, DEPTH FT. TRENCH WIDTH FT.
 GRAVEL DEPTH IN. TOTAL LENGTH FT.
 NUMBER OF TRENCHES TOTAL BOTTOM AREA
 SEEPAGE PITS, INSIDE DIAMETER FT. DEPTH BELOW INLET FT.
 ABSORBENT AREA SQ. FT.
 REMARKS 6/25/82 TANK 10 LONG 5 WIDE 10 DEEP
WITH MANHOLE & WARNING DEVICE NEED 2
CLEANOUTS AT TWO SHARP BENDS IN HOUSE
SEWER R.H. 6/28/82 Cleanouts installed @ bends on F.S.
 DATE SYSTEM APPROVED 6/28/82 INSPECTOR F. Skinner

PERMIT

P 31931

A ~~REPAIR~~ PERC

SEWAGE DISPOSAL SYSTEM

MARYLAND STATE DEPARTMENT OF HEALTH

HOWARD COUNTY

ELLICOTT CITY

DISTRICT _____

DATE 5/14/82

Mr. Neubauer IS PERMITTED TO INSTALL ALTER Y

ADDRESS _____ PHONE _____

SUBDIVISION _____ ROAD 7550 Washington Blvd., Ellicott

PROPERTY OWNER Blue Stream Partnership

ADDRESS P.O. Box 416, Ellicott City, Md.

SPECIFICATIONS #3 Bedrooms Existing house on property.

SEPTIC TANK CAPACITY _____ GALLONS

DRAIN FIELD _____ DEPTH _____ FEET, BOTTOM AREA _____ SQ. FT.

DEEP TRENCH _____ DEPTH _____ FEET, BOTTOM AREA _____ SQ. FT.

SEEPAGE PITS _____ ABSORBENT SIDE-WALL AREA _____ SQ. FT.

INLET PIPE _____ FT. BELOW ORIGINAL GRADE. MAXIMUM DEPTH _____ FT. BELOW ORIGINAL GRADE

EFFECTIVE DEPTH AT _____ FT. BELOW ORIGINAL GRADE.

LOCATE DISPOSAL AREA _____ FT. FROM _____ LOT LINE AND _____ FT. FROM _____ LOT LINE AS SEEN WHEN
FACING LOT FROM

REPAIR - CALL FOR INSEPCION WHIENGGROUND IS OPENED UP SO SANITARIAN CAN
RECOMMEND REPAIR.

PLANS APPROVED BY Palmer F. Wine DATE 5/14/82

COVER NO WORK UNTIL INSPECTED AND APPROVED.

NEITHER THE HOWARD COUNTY COUNCIL NOR THE HEALTH DEPARTMENT IS RESPONSIBLE FOR THE SUCCESSFUL OPERATION OF ANY SYSTEM.

NOTE: IF TRENCH IS USED CALL FOR INSPECTION BEFORE PLACING GRAVEL IN TRENCH.

NOTE: NO DRY WELL SHALL EXCEED 15 FOOT IN DIAMETER.


NOTE: ALL PIPE FROM HOUSE TO DISPOSAL AREA MUST BE CAST IRON.

PERMIT VOID AFTER THREE YEARS.

NOTE: INSTALL STAND PIPE ON SEPTIC TANK AND DRY WELL. STAND PIPES MUST BE 6 INCHES IN DIAMETER. CAST IRON, CONCRETE OR TERRA
COTTA ACCEPTED.

*INSTALLER IS RESPONSIBLE FOR OBTAINING FINAL APPROVAL ON THIS PERMIT.

A 31931

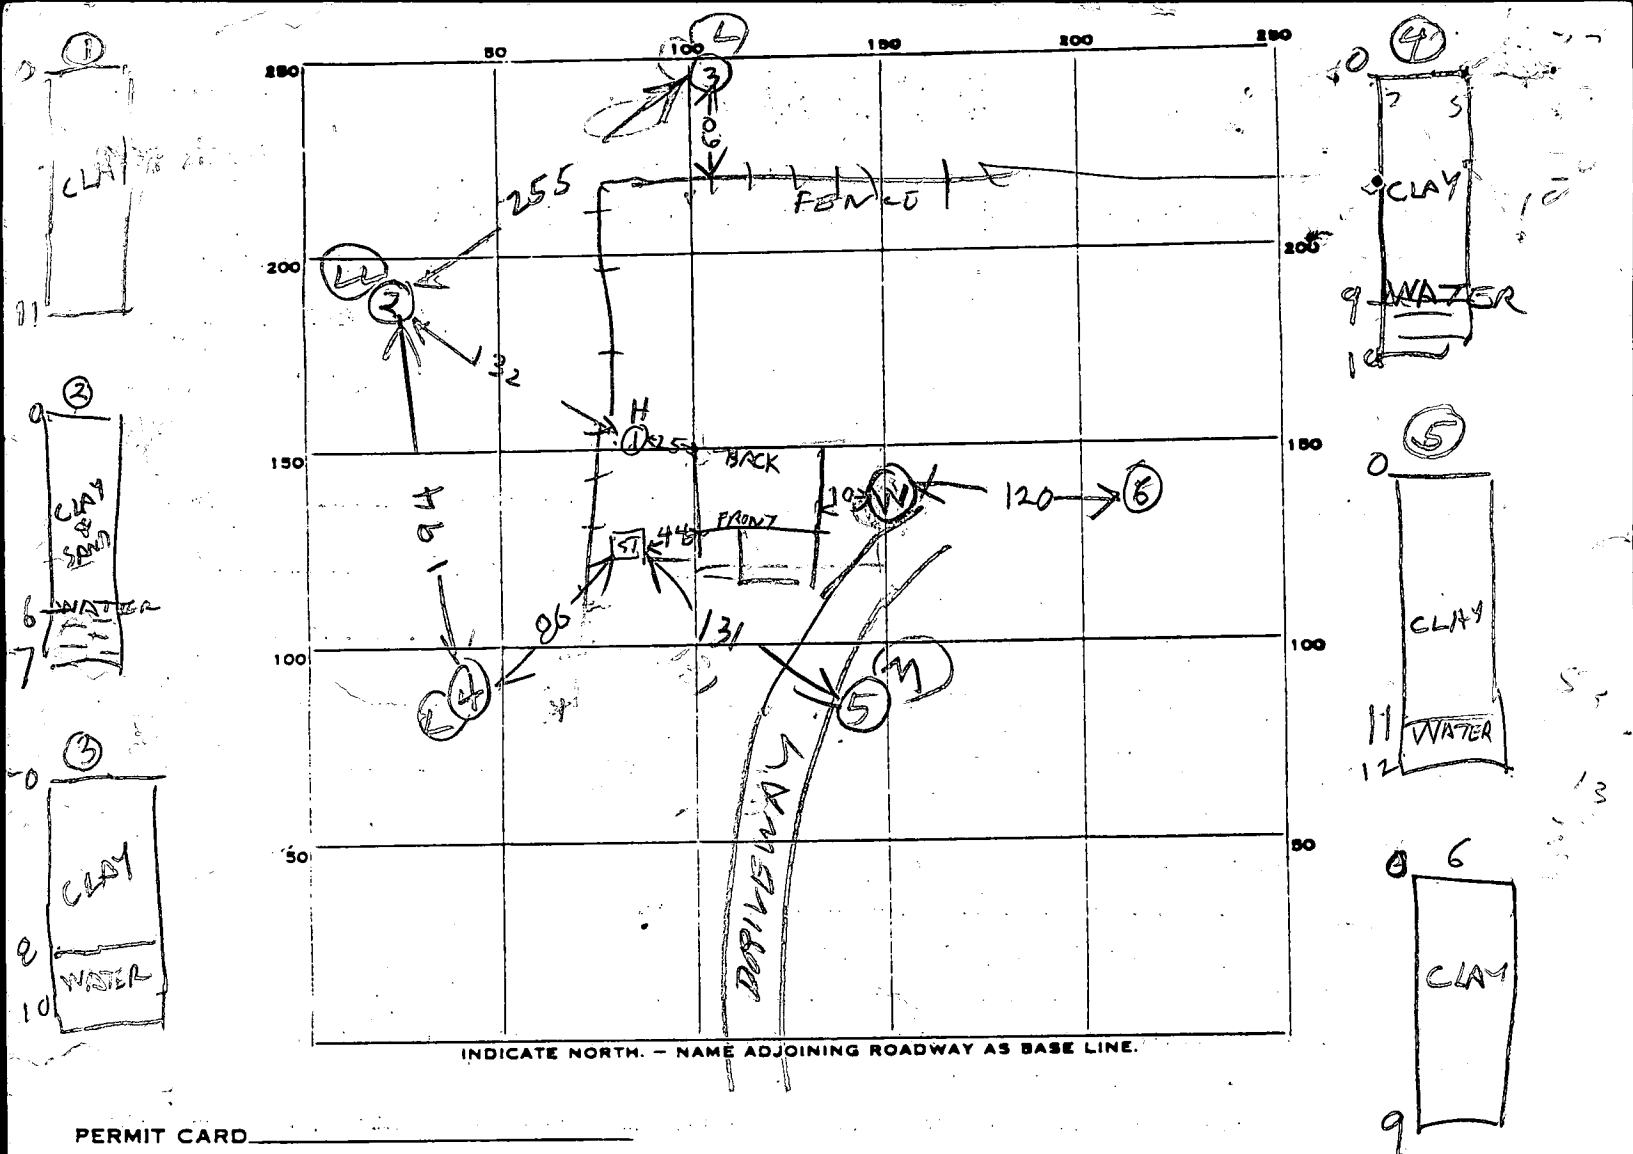

PERMIT CARD _____

SEPTIC TANK, LEVEL _____

CLEANOUTS _____

DISTRIBUTION BOX, LEVEL _____

TILE FIELD, DEPTH _____ FT. TRENCH WIDTH _____ FT.

GRAVEL DEPTH _____ IN. TOTAL LENGTH _____ FT.


NUMBER OF TRENCHES _____ TOTAL BOTTOM AREA _____

SEEPAGE PITS, INSIDE DIAMETER _____ FT. DEPTH BELOW INLET _____ FT.

ABSORBENT AREA _____ SQ. FT.

REMARKS 5/19/82 - ALL HOLES UNSATISFACTORY. NEUBAUER DUG
HOLES R.H. DISCUSSED WITH DO, MU

DATE SYSTEM APPROVED _____ INSPECTOR _____

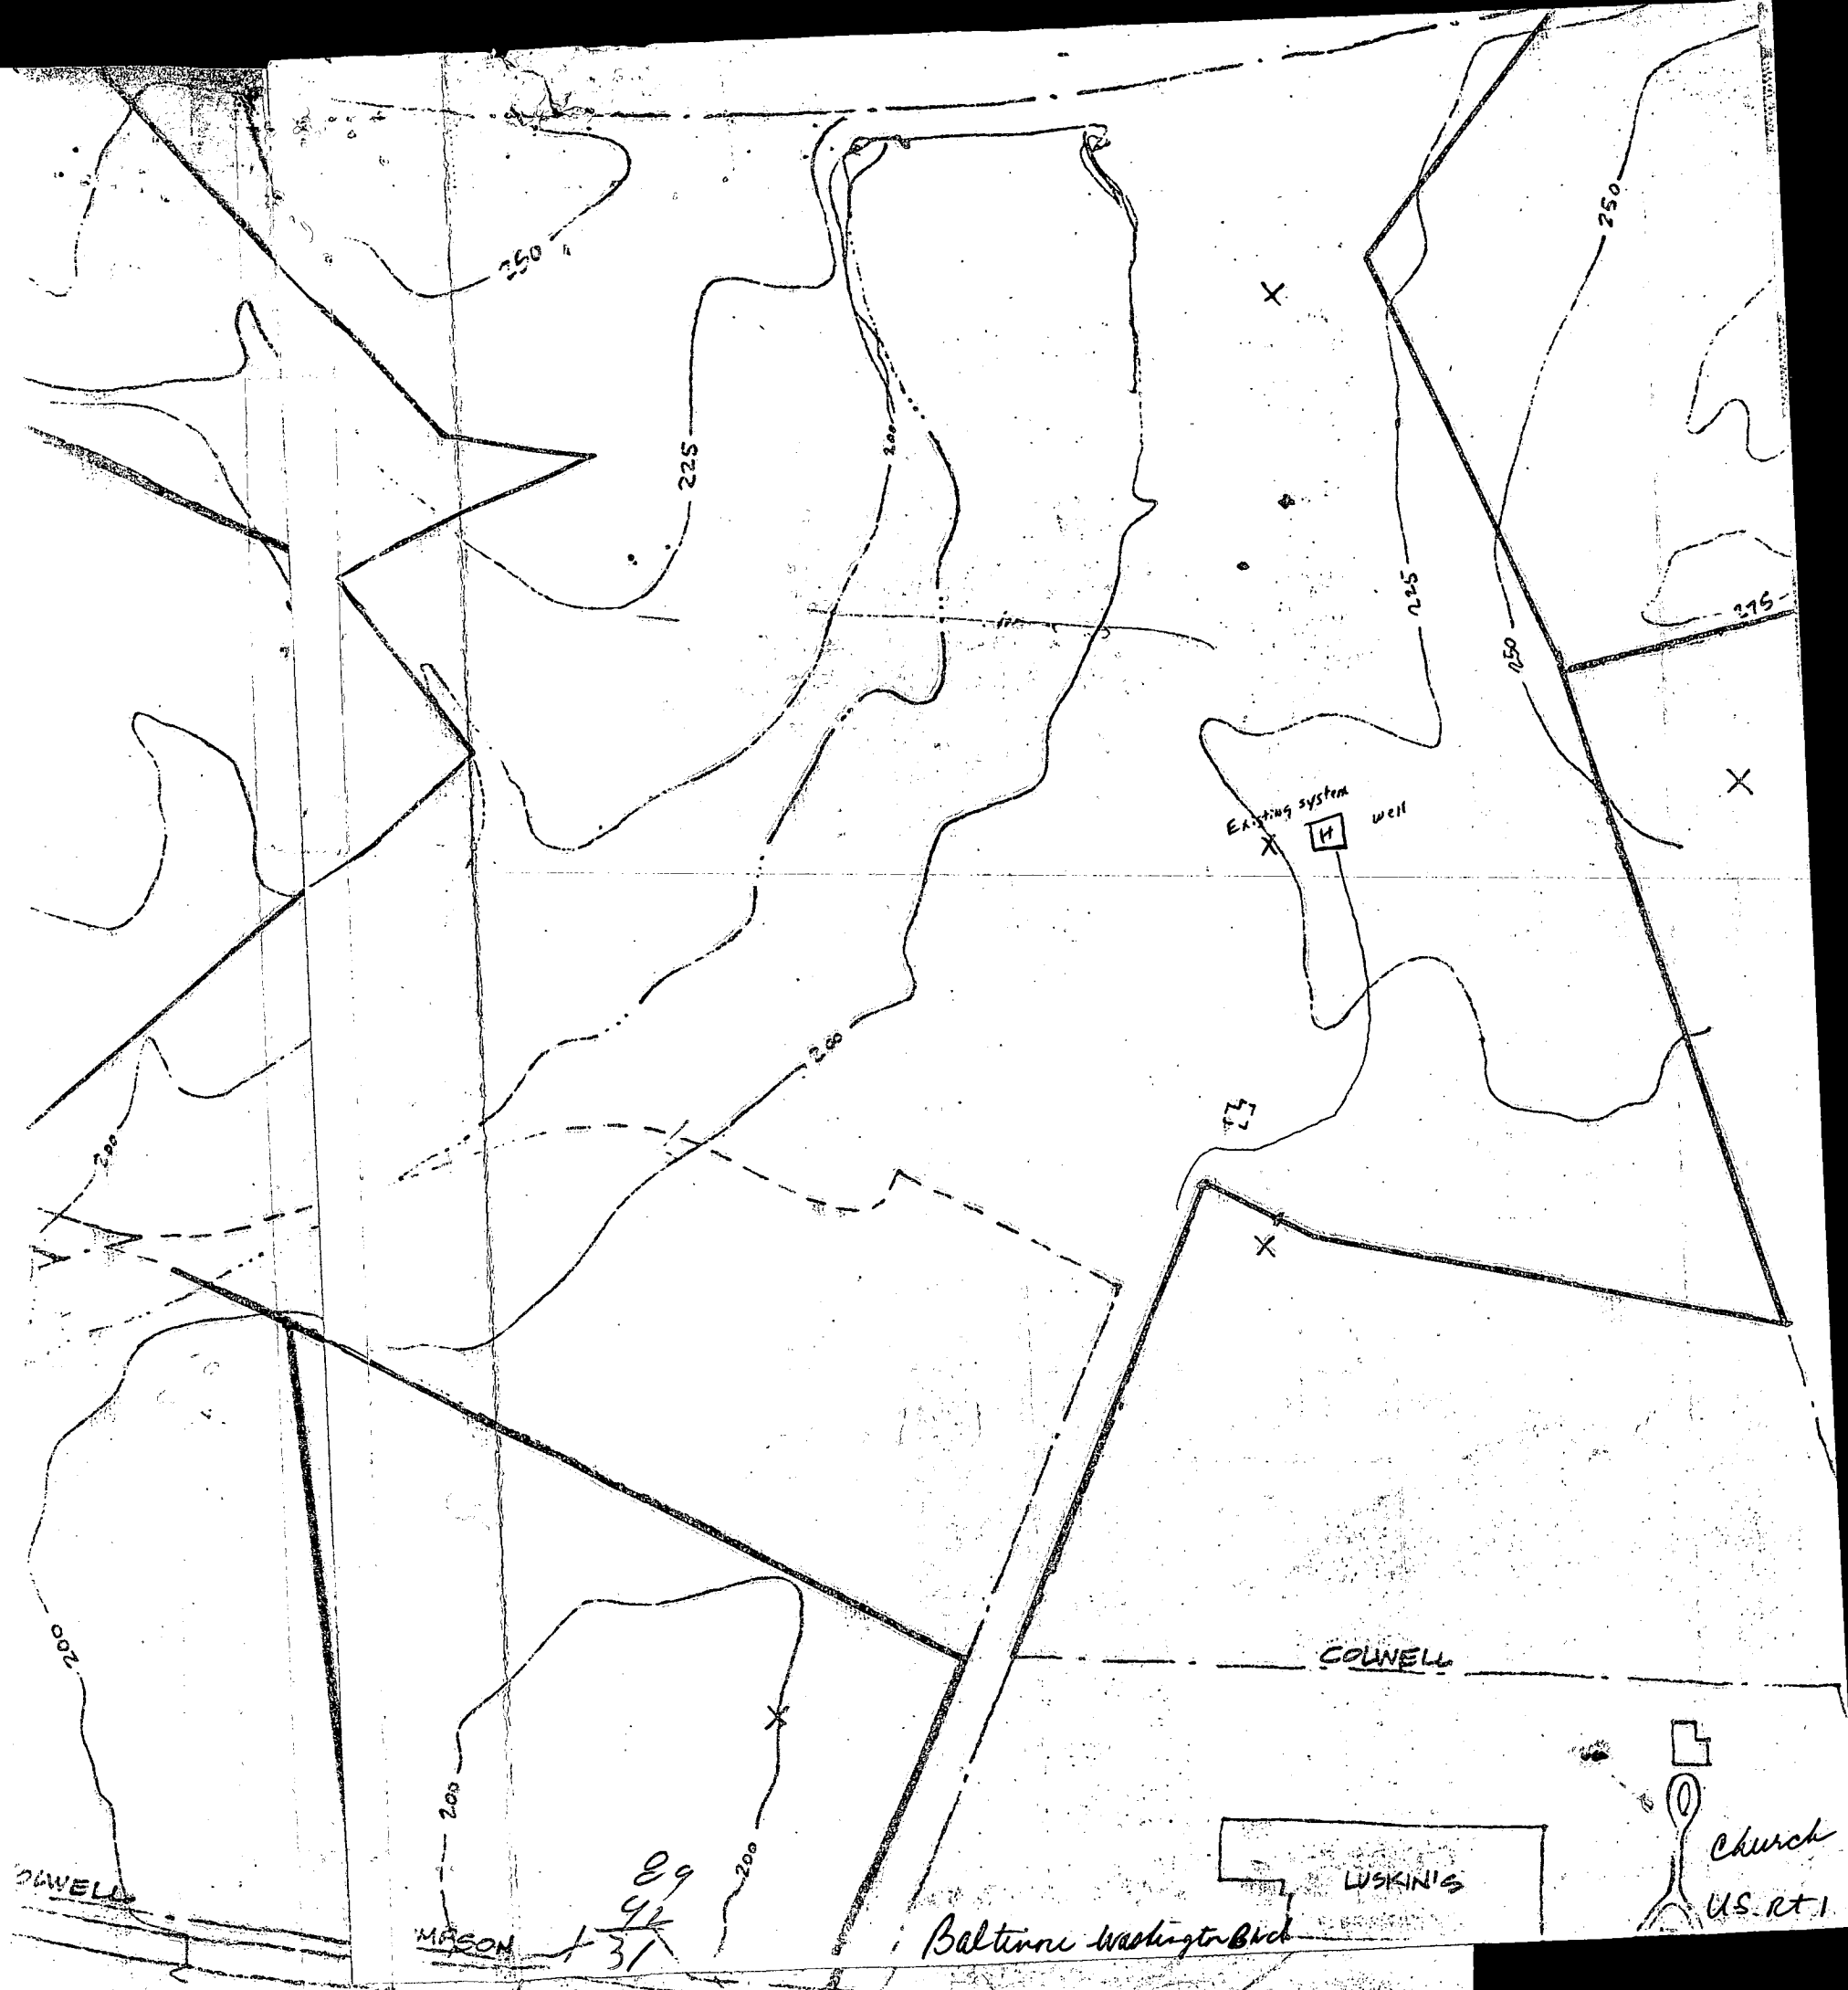

Existing system
well

COLWELL

LUSKIN'S

Church
U.S. Rt. 1

MASON

89
42
131

Baltimore Washington Blvd

HOLDING TANK EXEMPTION CERTIFICATE APPLICATION

Provide the following information in full and submit the completed application to:

Compliance Monitoring Coordinator
Little Patuxent Wastewater Treatment Plant
8900 Greenwood Place
Savage, Maryland 20763

APPLICANT'S NAME⁽¹⁾ Blue Stream Partnership (Mailing Address)
ADDRESS: 7350 Wash. Blvd. (P.O. Box 416 Ell City Md. 21043)
Baltimore road 21227

TELEPHONE NO. 465 2020

HOLDING TANK SIZE 2000 GALLONS

Describe source(s) of waste discharged to holding tank:


Toilet Kitchen Bath.

Provide frequency at which holding tank is emptied by waste hauler
(example: 1 time/week, 2 times/month, etc.) 1 Month

Provide sketch below showing holding tank location:

EXAMPLE:

PUT YOUR SKETCH HERE:

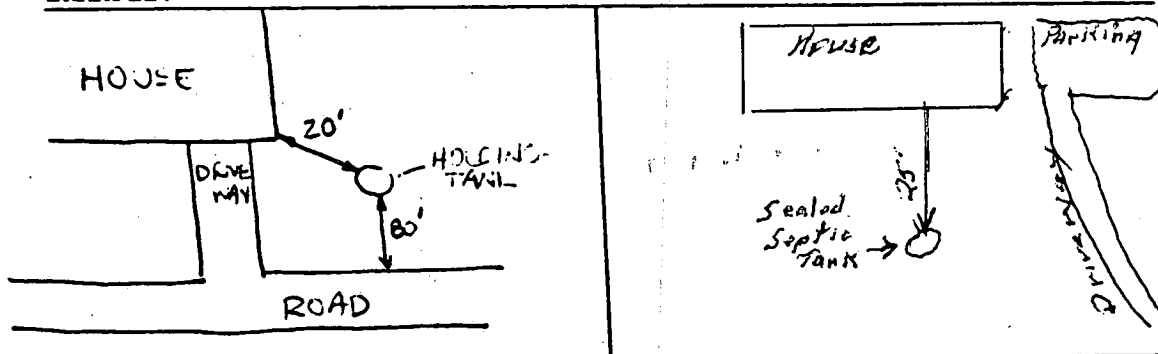

DO NOT WRITE BELOW THIS LINE

NOTES: (1) Applicant must be property owner.

☒ APPROVED ☐ DENIED BY HEALTH DEPT., REVIEWER RH DATE 1/19/90

IF DENIED, STATE REASON