

LAYOUT 11am 6/5 INSP 4 _____
INSP 2 11am 6/6 INSP 5 _____
INSP 3 _____ INSP 6 _____

ISSUE DATE: 5/22/2003

APPROVAL DATE: 6/6/03

**PERMIT
INDEXED**

04-366158

P 518983

A 50225-GG

**ON-SITE SEWAGE DISPOSAL SYSTEM
HOWARD COUNTY HEALTH DEPARTMENT
BUREAU OF ENVIRONMENTAL HEALTH**

TAXID #04-366158

Fogles Septic Clean, Inc IS PERMITTED TO INSTALL ☒ ALTER ☐

ADDRESS: 580 Obrecht Road, Sykesville PHONE NUMBER: 410-795-5670

SUBDIVISION: Vineyards at Cattail Creek LOT NUMBER: 28

ADDRESS: 3707 Sofia Court PROPERTY OWNER: Stephen Borrer

SEPTIC TANK CAPACITY (GALLONS): 1250 OUTLET BAFFLE FILTER REQUIRED ☐

PUMP CHAMBER CAPACITY (GALLONS): N/A COMPARTMENTED TANK REQUIRED ☐

NUMBER OF BEDROOMS: 4

SQUARE FEET PER BEDROOM: 180

$$\frac{180 \times 4}{4} = 180$$

LINEAR FEET OF TRENCH REQUIRED: 240 200' total length of trenches

TRENCHES:	Trench to be 2 feet wide. Inlet 3.0 feet below original grade. Bottom maximum depth $7\frac{1}{2}$ feet below original grade. Effective area begins at 3.0 feet below original grade. $4\frac{1}{2}$ feet of stone below distribution pipe.
LOCATION:	Place distrib. box at high, middle point of SDA 15' off property line.
NOTES:	1. 14' Visual - ensure low % rock below 11 $\frac{1}{2}$, if any (perc notes say "no rock" @ 11 $\frac{1}{2}$ -12')

PLANS APPROVED: John Boris / KN ALTERED DATE: 1/29/2003

SPECS ON SITE


- NOTE: PERMIT VOID AFTER 2 YEARS
- NOTE: CONTRACTOR RESPONSIBLE FOR SCHEDULING A PRE-CONSTRUCTION INSPECTION FOR ALL INSTALLATIONS
- NOTE: WATERTIGHT SEPTIC TANKS REQUIRED
- NOTE: ALL PARTS OF SEPTIC SYSTEM SHALL BE 100 FEET FROM ANY WATER WELL
- NOTE: MANHOLE RISERS REQUIRED ON ALL SEPTIC TANKS AND PUMP CHAMBERS UNLESS SPECIFICALLY AUTHORIZED

**NEITHER THE HOWARD COUNTY COUNCIL NOR THE HEALTH DEPARTMENT IS RESPONSIBLE FOR THE SUCCESSFUL OPERATION OF ANY SYSTEM
BUILDING PERMITTEE RESPONSIBLE FOR OBTAINING FINAL APPROVAL ON THIS PERMIT
AND RETURNED CALL 410-313-2640 FOR INSPECTION OF SEPTIC SYSTEM**

923-04 800150486-2 DELK

A 50225-GG

NOT TO SCALE

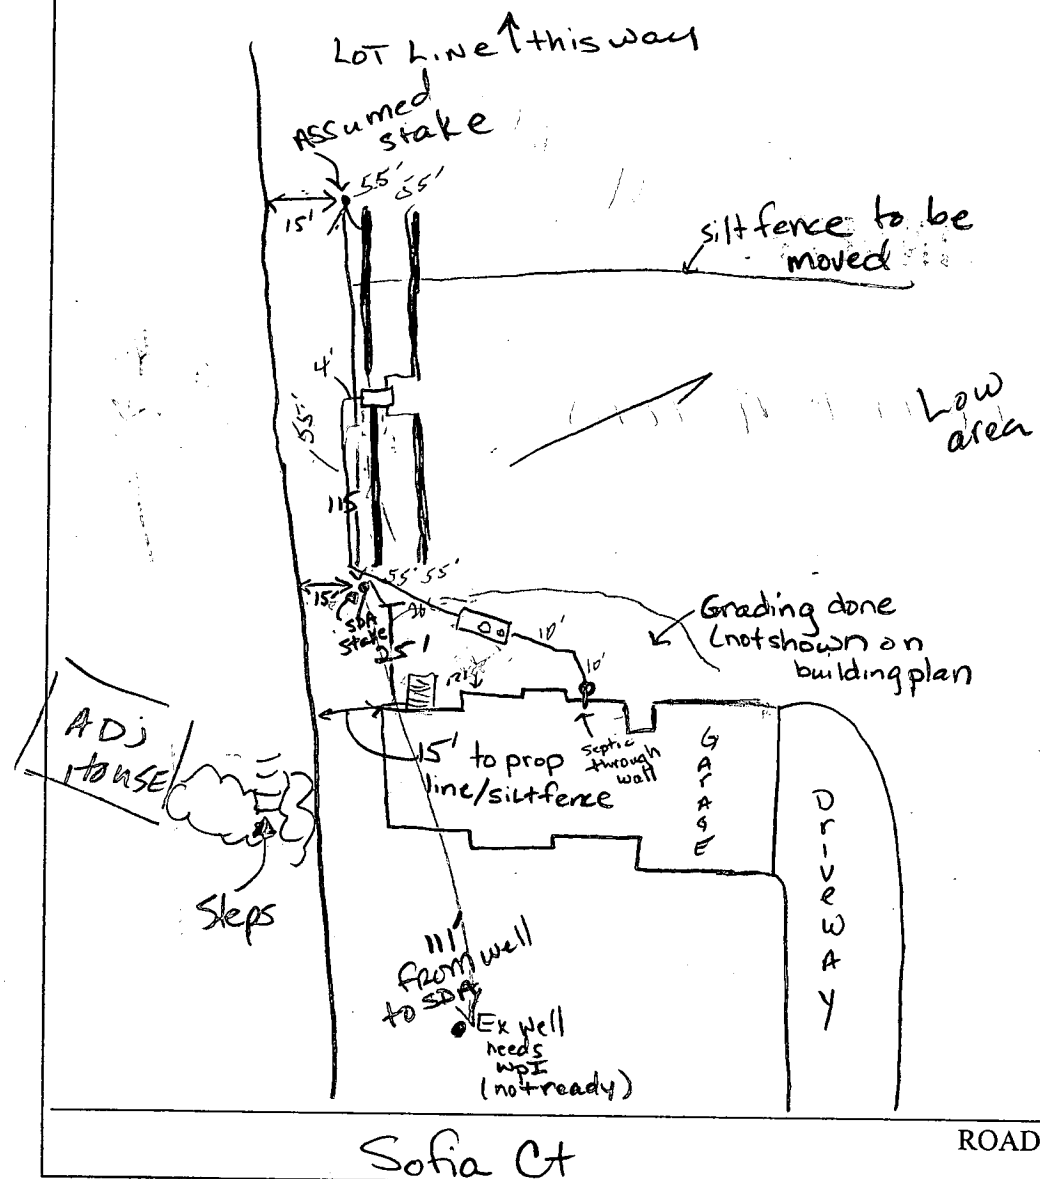

TRENCH/DRAINFIELD DATA		
WIDTH	INLET	BOTTOM
2'	3'	2'
NUMBER OF TRENCHES		4
TOTAL LENGTH		228'
ABSORPTION AREA		820 4
DISTRIBUTION BOX LEVEL		✓
DISTRIBUTION BOX BAFFLE		✓
DISTRIBUTION BOX PORT		✓

SEPTIC TANK DATA	
SEPTIC TANK 1 LEVEL	
CAPACITY	1250 GAL
SEAM LOC	Top
TANK LID DEPTH	1.5-2'
BAFFLES	✓
BAFFLE FILTER	✓
MANHOLE LOC	Center
6" PORT LOC	Front
WATERTIGHT TEST	
SEPTIC TANK 2 LEVEL	
CAPACITY	GAL
SEAM LOC	
TANK LID DEPTH	
BAFFLES	
BAFFLE FILTER	
MANHOLE LOC	
6" PORT LOC	
WATERTIGHT TEST	

PRE-CONSTRUCTION 6/5/23 Area NOT STAKED. Topo 90% accurate - shot topo in field w/ contractor. Only one stake found and location per plan; INSTALLATION located other ^{missing} stake sites from the one staked. Grading done in field near house but not on building plan. READJUSTED trench lengths & d box location. (more SDA USED with 4-55' trenches). trench bottoms lowered for sidewalk USEAGE - good soils - loam. OK TO BEGIN WORK (KN) 6/6/23 Tank set, 3 trenches installed (SD) 6/6/23 OK to cover all work (SD)

FINAL INSPECTOR [Signature] DATE OF APPROVAL 6/6/23

OWNER: STEPHEN DOKROK

MOUNTAIN VIEW CONSTRUCTION, LLC

6030 DAYBREAK CIRCLE SUITE 150

CLARKSVILLE, MD. 21029

410-489-7995

Septic System Plan
County Health Department

[Signature]
Signature

1/24/03
Date

Total linear feet of trench required 240 feet
Width of trench(es) 3 feet
Depth of trench(es) 5 feet
Depth of stone required below distribution pipe 2 feet

LOT 1

LOT 28

LOT 27

480

SEPTIC # 15

HOUSE INV. 494.0
S.T. INV. 493.0
OUT 492.75
S.T. GRADE 496.0
DIST BDX INV. 492.0

Non-USEABLE CORNER

6/5/03
House is 17' off left lot line, not 22'

DIST BDX
SEPTIC TANK

HOUSE
FF 499
FB 489

31' REAR GAR.

DRIVEWAY

SOFIA COURT

- 2 1/2" COMPACT ASPHALT
- 6" #2 STONE
- 6" CR6 STONE
- 7% DRIVEWAY GRADE
- TOPOGRAPHY FROM HEALTH DEPT. AERIALS

1/8" = 6'

**HOWARD COUNTY HEALTH DEPARTMENT
BUREAU OF ENVIRONMENTAL HEALTH
WATER AND SEWERAGE PROGRAM
TEL: (410)313-2640 FAX: (410)313-2648**

Information Form for the Installation of the Well Pump, Pitless Adapter, and Supply Piping

NOTE: The installer is responsible for requesting an inspection prior to 9 am on the day of the desired inspection. No work is to be covered until approved by the Health Department. All installations must comply with the National Standard Plumbing Code (NSPC, as amended locally) and COMAR 26.04.04 (MD Well Construction Regulations). Submission of a complete form is required prior to Use and Occupancy approval.

Company Name: Michael P. Gartland, Inc. Telephone #: 410 549-1755
Address: 6984 Runkles Rd
P.O. Box 1771

(Must circle one) Licensed Plumber Licensed Well Driller Licensed Well Pump Installer

License # and name of individual responsible for the field installation:
Name (Print): Michael Gartland

License # 6353

*A licensed individual must perform the actual installation. Apprentices must be under the direct supervision of a licensed journeyman or master plumber, pump installer or well driller. Licenses may be subjected to field verification.

Name of Property Owner: Stephen A. Brown Telephone #: 410 442-1269
Subdivision: Vineyards at Cotton 1 Lot #: 2B Well Tag #: HO-94-3554
Site Address: 3707 Seaside Ct.
Glenwood, Md. 21738

Submersible Pump Data

Make: Jazzwell
Model #: 75471265216
Pump Capacity 7 GPM
Well Yield: GPM

Pitless Adapter

Make: Howard
Model #: PT 400
Depth: 42 (36" min)
NSF approved:

Well Cap and Electric Conduit

Two piece watertight cap: Yes
Screened, vented well cap: Yes
Cap secured to casing: Yes
Conduit min 18" B.G.: Yes
Conduit secured to well cap: Yes

Depth of well encountered at time of pump installation: 270 (feet)

If pump capacity exceeds well yield, a low water cut off switch is required by NSPC 1990 Section 17.8.4

Backflow arrestors or Cable guards are required - Must circle one

Safety rope, if used, attached to inside of well casing with eye bolt NO

Piping to house

Type: Plastic
PSI: 160 (160 psi min)
Depth of supply line: 42 (36" min)

House Connection

PVC sleeved to undisturbed soil at wall penetration: Yes
Approximate length of sleeve: 6
Sleeve caulked and sealed properly: Yes

The water supply line is required to be at least ten feet from the septic tank, pump chamber, sewage piping, distribution box, drainfields, and sewage reserve area. If this cannot be accomplished, contact this office for approval prior to installation.

Signature of company representative responsible for installation: Michael Gartland

date: 10/9/03

For Health Department Use Only - Not to be completed by Installer

Date Insp. Requested: 6/10/03

Date Insp. Approved: 6/10/03

Inspection Data: Pitless adapter and water supply line at least 36" below grade

Two piece cap installed and attached to casing securely

Elec. conduit extends at least 18" below grade/attached to cap properly

Safety rope installed inside of well casing

Correct well tag attached properly and casing 8" above finished grade

Water supply line sleeved adequately at house connection

Adequate grout observed below pitless adapter

50
BR

C 1 14308		SEQUENCE NO. (MDE USE ONLY)		STATE OF MARYLAND WELL COMPLETION REPORT FILL IN THIS FORM COMPLETELY PLEASE TYPE		THIS REPORT MUST BE SUBMITTED WITHIN 45 DAYS AFTER WELL IS COMPLETED.	
(THIS NUMBER IS TO BE PUNCHED IN COLS 3-6 ON ALL CARDS)		DATE WELL COMPLETED MM <u>11</u> DD <u>18</u> YY <u>02</u>		Depth of Well 22 <u>225</u> 26 (TO NEAREST FOOT)		COUNTY <u>5022506</u> NUMBER <u>5022866</u>	
ST/CO USE ONLY DATE RECEIVED MM <u>8</u> DD <u>13</u> YY <u>03</u>		DATE WELL COMPLETED MM <u>11</u> DD <u>18</u> YY <u>02</u>		Depth of Well 22 <u>225</u> 26 (TO NEAREST FOOT)		PERMIT NO. FROM "PERMIT TO DRILL WELL" <u>HO-94-3554</u>	
OWNER <u>MANNARELLI</u> STREET OR RFD <u>3061A COURT</u> SUBDIVISION <u>VINEYARDS AT CATTAIL CREEK</u>		last name <u>3061A COURT</u> first name <u>GLENWOOD</u>		TOWN <u>GLENWOOD</u>		LOT <u>28</u>	
WELL LOG Not required for driven wells		GROUTING RECORD WELL HAS BEEN GROUTED (Circle appropriate box) Y N 44 44		C 3 1 2		PUMPING TEST	
STATE THE KIND OF FORMATIONS PENETRATED, THEIR COLOR, DEPTH, THICKNESS AND IF WATER BEARING		TYPE OF GROUTING MATERIAL (Circle one) CEMENT CM BENTONITE CLAY BC		HOURS PUMPED (nearest hour) <u>03</u>		PUMPING RATE (gal. per min.) <u>9.25</u>	
DESCRIPTION (Use additional sheets if needed)		NO. OF BAGS <u>14</u> NO. OF POUNDS <u>1316</u>		METHOD USED TO MEASURE PUMPING RATE <u>196L</u>		WATER LEVEL (distance from land surface)	
FROM TO check if water bearing		GALLONS OF WATER <u>84</u>		BEFORE PUMPING <u>60</u> ft.		WHEN PUMPING <u>120</u> ft.	
Brown Sandstone 0 50		DEPTH OF GROUT SEAL (to nearest foot) from <u>0</u> ft. to <u>45</u> ft. (enter 0 if from surface)		TYPE OF PUMP USED (for test)		PUMP INSTALLED	
Gray Limestone 50 70		OTHER CASING (if used) diameter inch from to		A air P piston T turbine		DRILLER INSTALLED PUMP (CIRCLE) (YES or NO) YES NO	
Brown 70 71 ✓		MAIN CASING TYPE <u>ST</u> Nominal diameter top (main) casing (nearest inch) <u>06</u> Total depth of main casing (nearest foot) <u>55</u>		C centrifugal R rotary O other (describe below)		IF DRILLER INSTALLS PUMP, THIS SECTION MUST BE COMPLETED FOR ALL WELLS.	
Gray Limestone 71 160		SCREEN RECORD screen type or open hole (insert appropriate code below) ST BR HO STEEL BRASS OPEN HOLE		CAPACITY GALLONS PER MINUTE (to nearest gallon) 31 35		PUMP HORSE POWER 37 41	
White 160 161 ✓		DEPTH (nearest foot) <u>225</u>		PUMP COLUMN LENGTH (nearest ft.) 43 47		CASING HEIGHT (circle appropriate box and enter casing height)	
Gray Limestone 161 225		C 2		C 2		above below } LAND SURFACE <u>02</u> (nearest foot)	
NUMBER OF UNSUCCESSFUL WELLS <u>0</u>		WELL HYDROFRACTURED Y N		C 2		LOCATION OF WELL ON LOT	
CIRCLE APPROPRIATE LETTER A A WELL WAS ABANDONED AND SEALED WHEN THIS WELL WAS COMPLETED E ELECTRIC LOG OBTAINED P TEST WELL CONVERTED TO PRODUCTION WELL		I HEREBY CERTIFY THAT THIS WELL HAS BEEN CONSTRUCTED IN ACCORDANCE WITH COMAR 26.04.04 "WELL CONSTRUCTION" AND IN CONFORMANCE WITH ALL CONDITIONS STATED IN THE ABOVE CAPTIONED PERMIT, AND THAT THE INFORMATION PRESENTED HEREIN IS ACCURATE AND COMPLETE TO THE BEST OF MY KNOWLEDGE.		D 2		SHOW PERMANENT STRUCTURE SUCH AS BUILDING, SEPTIC TANKS, AND/OR LANDMARKS AND INDICATE NOT LESS THAN TWO DISTANCES (MEASUREMENTS TO WELL)	
DRILLERS LIC. NO. <u>M 50 009</u>		DRILLERS SIGNATURE <u>Ally</u>		LIC. NO. <u>D</u>		SITE SUPERVISOR (sign of driller or journeyman responsible for sitework if different from permittee)	
TELESCOPE CASING		LOG INDICATOR		OTHER DATA		COUNTY	

B 1	7487	SEQUENCE NO. (MDE USE ONLY)	STATE OF MARYLAND APPLICATION FOR PERMIT TO DRILL WELL 517980 please type	STATE PERMIT NUMBER HO-94-3554 fill in this form completely
Date Received (APA) 10 30 02 8 MM DD YY 13		OWNER INFORMATION		
15 Last Name Mario Mammarelli		34 First Name + Sons		
36 Street or RFD 2929 Summit Circle		55		
57 Town Ellicott City Md		76 Zip 21043		
DRILLER INFORMATION				
76 Driller's Name Allen Compton		81 License No. MSD 009		
Firm Name Eagles Well Drilling				
Address 580 Obrecht RD				
Signature <i>[Signature]</i>		Date 10-18-02		
B 2	WELL INFORMATION			
1 2	APPROX. PUMPING RATE (GAL. PER MIN.)			
		8 12 5		
AVERAGE DAILY QUANTITY NEEDED (GAL. PER DAY)		14 20 500		
USE FOR WATER (CIRCLE APPROPRIATE BOX)				
☒ DOMESTIC POTABLE SUPPLY & RESIDENTIAL IRRIGATION				
☐ FARMING (LIVESTOCK WATERING & AGRICULTURAL IRRIGATION)				
☐ INDUSTRIAL, COMMERCIAL, DEWATERING				
☐ PUBLIC WATER SUPPLY WELL				
☐ TEST, OBSERVATION, MONITORING				
☐ GEO-THERMAL				
APPROXIMATE DEPTH OF WELL 24 300 28 FEET		NEAREST INCH 6		
METHOD OF DRILLING (circle one)				
BORED (or Augered)		JETTED		
30 AIR-ROTARY		37 JETTED & DRIVEN		
37 CABLE		ROTARY (Hydraulic Rotary)		
other		DRIVE-POINT		
REPLACEMENT OR DEEPEMED WELLS (CIRCLE APPROPRIATE BOX)				
☒ THIS WELL WILL NOT REPLACE AN EXISTING WELL				
☐ THIS WELL WILL REPLACE A WELL THAT WILL BE ABANDONED AND SEALED				
☐ THIS WELL WILL REPLACE A WELL THAT WILL BE USED AS A STANDBY-CONTACT LOCAL APPROVING AUTHORITY FOR POLICY ON STANDBY WELLS				
☐ THIS WELL WILL DEEPEMED AN EXISTING WELL				
PERMIT NUMBER OF WELL TO BE REPLACED OR DEEPEMED (IF AVAILABLE) 41 _____ 52 _____				
Not to be filled in by driller (MDE OR COUNTY USE ONLY)				
APPROX. PERMIT NUMBER _____ G _____				
PERMIT No. HO-94-3554 70 71 72 73 74 75 76 77 78 79				
SPECIAL CONDITIONS NOTE - APPROVING AUTHORITIES SHOULD USE SEPARATE SHEET IF NEEDED				

LOCATION OF WELL

Howard

8 COUNTY **Howard** 21

23 SUBDIVISION **VINEYARDS AT CATTAIL CREEK** 42

SECTION **44** 46 LOT **28/9** 48 50

Glenwood

52 NEAREST TOWN 71

MILES FROM TOWN (enter 0 if in town) **4** 73 76 77 78

Sofia Ct

11 NEAR WHAT ROAD 30

ON WHICH SIDE OF ROAD (CIRCLE APPROPRIATE BOX)

NORTH
N
WEST
W
S
E
EAST
SOUTH

34 **40** 37 DISTANCE FROM ROAD FT. 38 39

ENTER FT OR MI **FT**

TAX MAP: **21** BLK: **8** PARCEL **225**

DIRECTION OF WELL FROM TOWN (CIRCLE BOX)

NOT TO BE FILLED IN BY DRILLER
HEALTH DEPARTMENT APPROVAL

HOWARD **5022566**

COUNTY NAME COUNTY NO.

STATE SIGNATURE _____ INSERT S _____ 41

DATE ISSUED **10-31-02** **Steven R. Krug** **10/31/02**

43 MM DD YY 48 CO SIGNATURE EXP. DATE

NORTH GRID **523** 000 EAST GRID **787** 000

50 55 57 63

SHOW MAJOR FEATURES OF BOX & LOCATE WELL WITH AN X

SOURCES OF DRILLING WATER

1. _____

2. _____

3. _____

WRITE THE BOX NUMBER FROM THE MAP HERE

E **7807**

N **5203**

000 000

DRAW A SKETCH BELOW SHOWING LOCATION OF WELL IN RELATION TO NEARBY TOWNS AND ROADS AND GIVE DISTANCE FROM WELL TO NEAREST ROAD JUNCTION


Willow Birch

Cattail Creek

92

LOT 28 (OLD LOT 9)
SOFIA CT.
GLENWOOD, MD
21738
LOT 27 (OLD LOT 10)

COURT

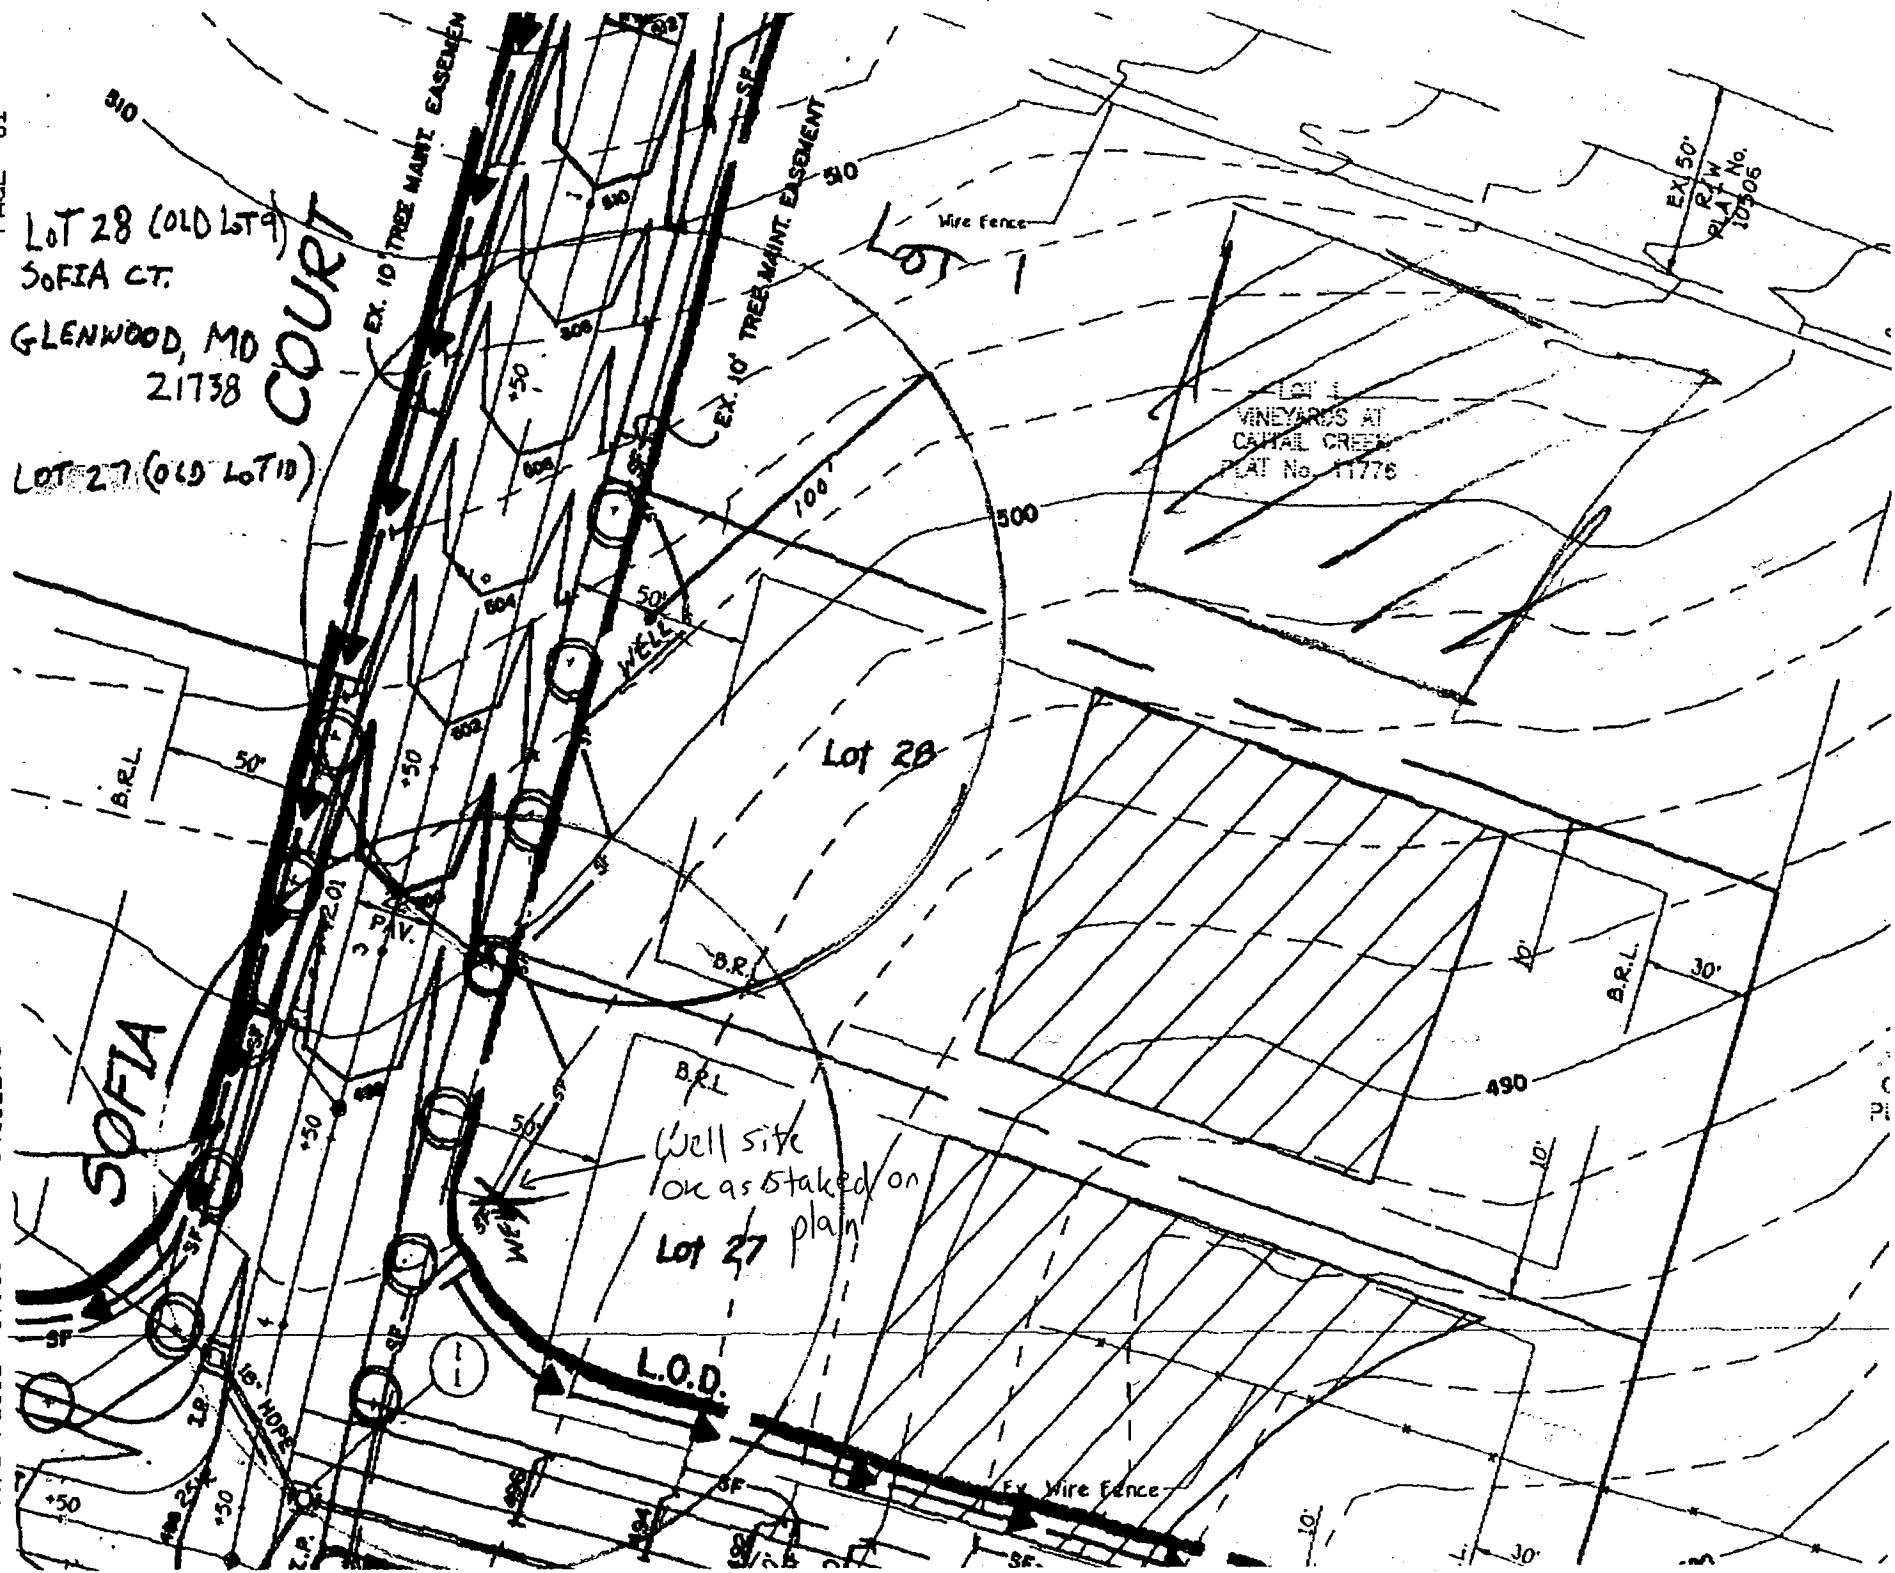

N. # 150225 GG LOT 28 ^{LOT 29} ²⁸ ²⁹ ³⁰ ³¹ ³² ³³ ³⁴ ³⁵ ³⁶ ³⁷ ³⁸ ³⁹ ⁴⁰ ⁴¹ ⁴² ⁴³ ⁴⁴ ⁴⁵ ⁴⁶ ⁴⁷ ⁴⁸ ⁴⁹ ⁵⁰ ⁵¹ ⁵² ⁵³ ⁵⁴ ⁵⁵ ⁵⁶ ⁵⁷ ⁵⁸ ⁵⁹ ⁶⁰ ⁶¹ ⁶² ⁶³ ⁶⁴ ⁶⁵ ⁶⁶ ⁶⁷ ⁶⁸ ⁶⁹ ⁷⁰ ⁷¹ ⁷² ⁷³ ⁷⁴ ⁷⁵ ⁷⁶ ⁷⁷ ⁷⁸ ⁷⁹ ⁸⁰ ⁸¹ ⁸² ⁸³ ⁸⁴ ⁸⁵ ⁸⁶ ⁸⁷ ⁸⁸ ⁸⁹ ⁹⁰ ⁹¹ ⁹² ⁹³ ⁹⁴ ⁹⁵ ⁹⁶ ⁹⁷ ⁹⁸ ⁹⁹ ¹⁰⁰

COUNTY #
LOT 28
SOIL PROFILE


0'-4'
Clay
4'
LOAM
11'

HOLE ②

0'-4'-8"
Clay
4'-8"
LOAM
10'-2"

HOLE ③

0'-5'-8"
Clay
5'-8"
LOAM
10'-2"

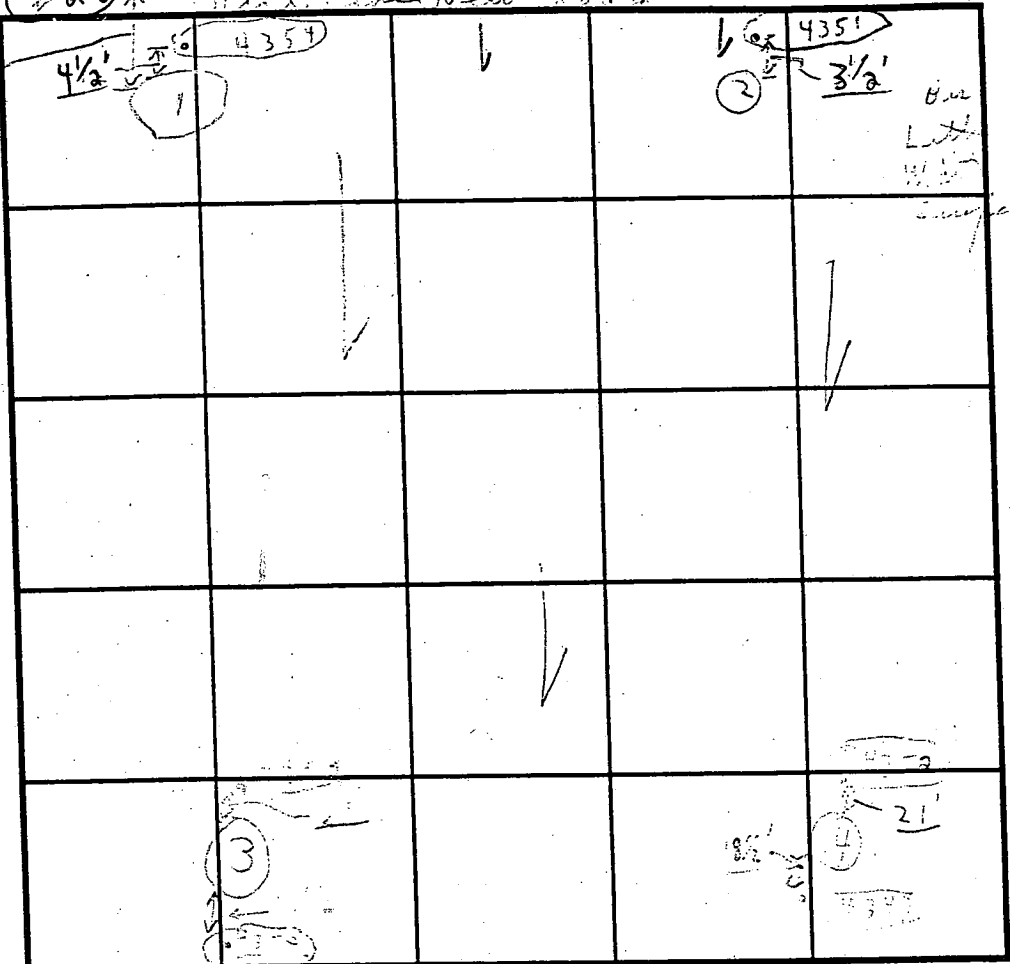

SOIL PROFILE
HOLE ④

0'-5'-3"
Clay
5'-3"
LOAM
11'

INDICATE NORTH - NAME ADJOINING ROADWAY AS BASE LINE.

DATE	TEST NO.	DEPTH	PRE-WET		TEST - 1" DROP		TIME
			START	STOP	START	STOP	
8/2/97	①	4'	10:22	10:24	10:24	10:31	7 min
	②	11'					
	③	4'-8"	10:26	10:28	10:28	10:30	2 min
	④	10'-2"					
	⑤	5'-8"	10:11	10:13	10:13	10:20	7 min
	⑥	10'-2"					
	⑦	5'-3"	10:06	10:08	10:08	10:12	4 min
	⑧	11'					

Note wells on lot 9, 10 Set II are less than 100 ft from edge of parcel SDA #

REMARKS: 8/29 Test in area between Holes 2 & 3
TYPE OF SOIL:
TESTED BY:
ALSO PRESENT:
TRENCH DESIGN DATA: AVERAGE PERCOLATION TIME: TRENCH WIDTH:
INLET DEPTH: MAXIMUM BOTTOM DEPTH: SQ. FT./BEDROOM:

AS0225CC

COUNTY #


LOT 25

SOIL PROFILE

③ 4345

Now 27

④ 4344

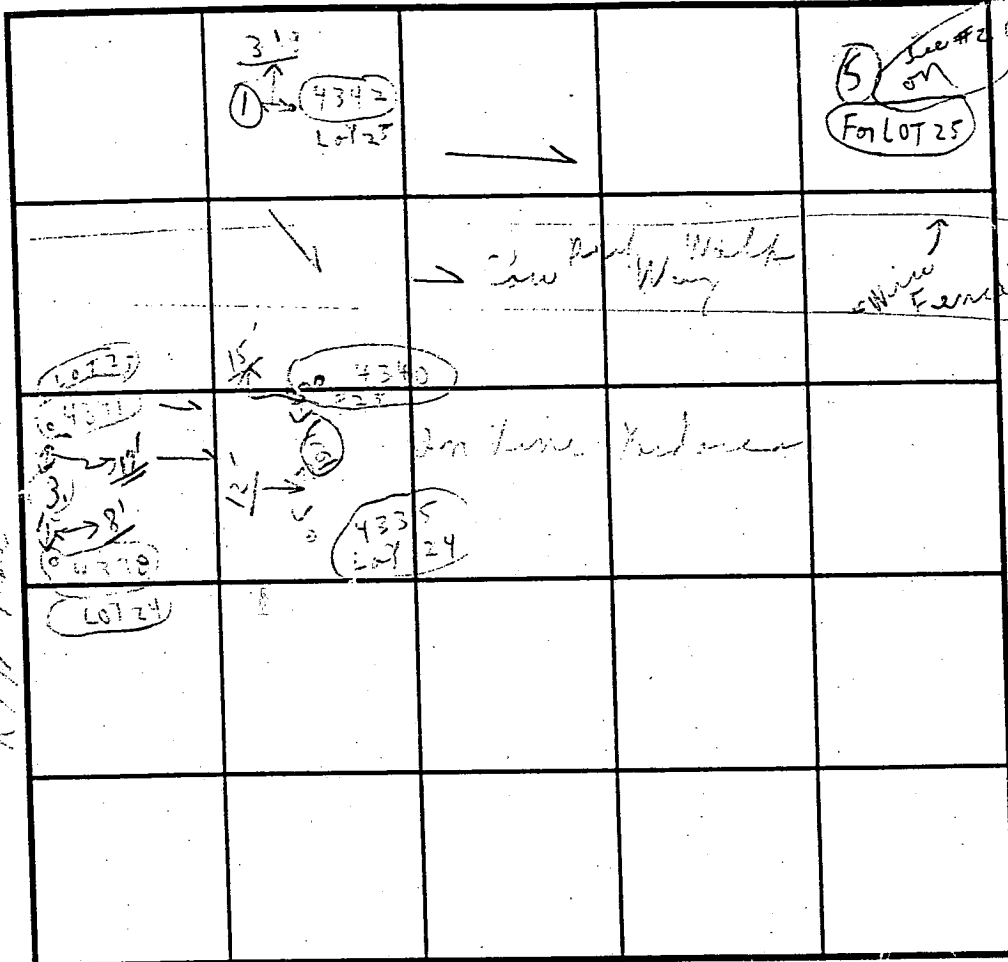

INDICATE NORTH - NAME ADJOINING ROADWAY AS BASE LINE.

DATE	TEST NO.	DEPTH	PRE-WET		TEST - 1" DROP		TIME
			START	STOP	START	STOP	
8/31/94	⑤	4 1/2'	10:22	10:25	10:25	10:30	5 min
		9 1/2'		on	Loam	no rock	
	①	4'-4"	10:33	10:35	10:35	10:37	2 min
	④ 4342	10' 3"	on	No rock			
	4340	4 1/2'	10:54	10:56	10:56	10:58	2 min
	②	9' 6"	No	rock	Loam		
	4335	4'	11:02	11:04	11:04	11:06	2 min
8/31/94	③	11'			Loam	No rock	

REMARKS

Tests on field (Go by stake #s)

TYPE OF SOIL

Loam

TESTED BY

C. J.

ALSO PRESENT

TRENCH DESIGN DATA: AVERAGE PERCOLATION TIME

TRENCH WIDTH

INLET DEPTH


4 1/2'

MAXIMUM BOTTOM DEPTH

SQ. FT/BEDROOM

SP-96-11

LOT 1
49,387 Sq. Ft.
PLAT No. 11778
A50225GG

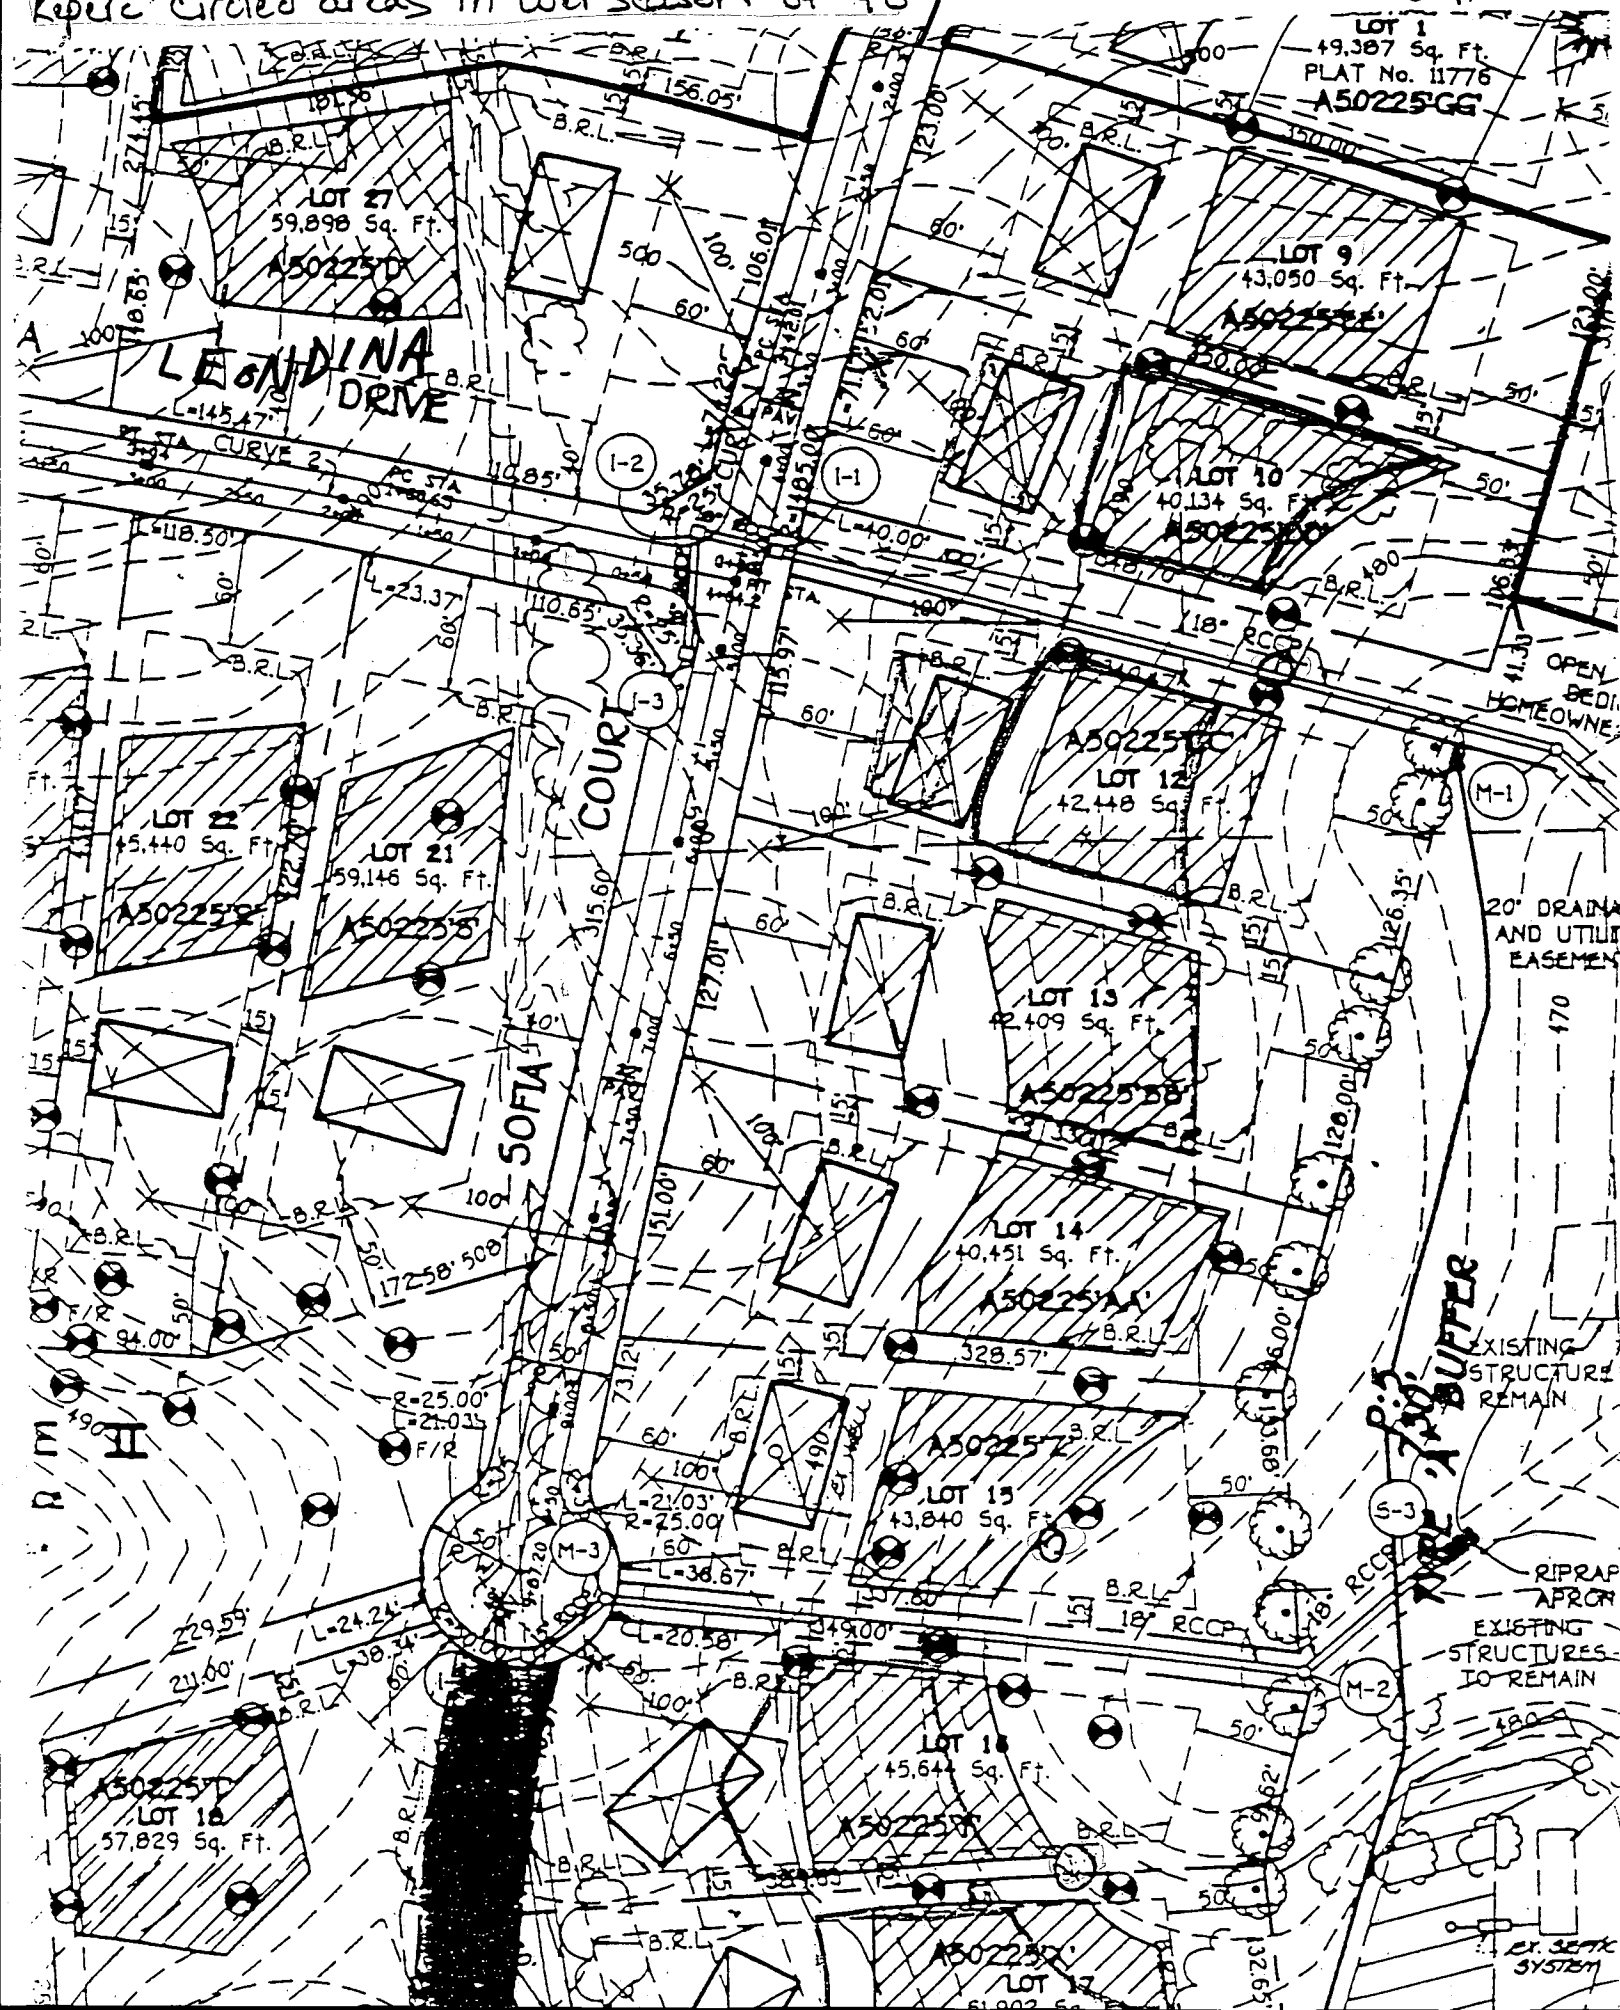

CATTAIL CREEK COUNTRY CLUB
SECTION 2
PLAY No. 71050

LOT 9
YARDS AT
HILL CREEK
No. 12645

2236

LOT 10
VINEYARDS AT
CAJAL CREEK
PLAT No. 12645

LOT 1
VINEYARDS AT
CAITAIL CREEK
PLAT No. 11776

VINEYARD
CAPITAL
PLAT No.

Lot 28

43,050 Sq.Ft.

279

40,134 Sq.Ft.±

Lot 25

1808) 42,448 Sq. Ft. ±

Lot 23

59,146 Sq.Ft.±

Lot 22

**Part Of
Bulk Parcel 'D'**
Area This Sheet = 2.205 Ac.*
For Total Area See Sheet 4

Part Of Bu
Preservation

Area This Sheet =
For Total Area S

- Match Line Only -
Not A Lot Line

N50°45'45"E
56.83' —

Match Line Only -
Not A Lot Line -

Line

See

Sheet

4

the Requirements §3-108, The Real Property Article, Annotated Code

Reservation Of Public Utility And Forest Conservation Easements
 as to the Property Hereinto Its Successors And Assigns, All

6 JAPANESE HYDRANGEAS
1 DRAGON LADY HOLLY
14 DW. JUNE BERRY HOLLY

WELL

REAR PORCH

11/24/87

DECK

DECK

SPRINKLER

LAWN

LAWN

LAWN

BOULDERS

PAVING

SPA

PAVING

- DIANTHUS 'BORDER PINKS'
- SPEDUM 'MATRONA' - STONECROP
- 1 DRAGON LADY HOLLY
- 9 CARYOPTERIS - BLUE BEARD
- 7 RUDBECKIA - BLACK EYED SUSANS
- 3 BUPPLEIA - BUTTERFLY BUSH

BUTTERFLY GARDEN

- SALVIA 'MAY KNIGHT'
- SNOW FOUNTAIN WEeping CHERRY TREE
- DIANTHUS - BORDER PINKS
- 3 BLUE STAR JUNIPER
- ROSY CLOW SPERM.

SEPTIC TREATMENT

- NEPETA 'WALKERS LOW'
- DW. STASIA DASY
- 4 BLUE PRINCESS HOLLY
- PURPLE CORAL BELLS
- 2 COLUMNAR HORNBREAM TREES

- 10 DW. CHERRY LAUREL
- 1 FESTIVE HOLLY
- MIXED DAISIES
- 1 JAPANESE Zelkova TREE
- NEPETA 'WALKERS LOW'
- 3 SHROBANA SPIREA
- 3 WINTERHUR VIBURNUM
- 9 SHROBANA SPIREA
- SIBERIAN FRIS

APPROVED
WALK-THRU BUILDING PERMIT
BP# 00150486 A# 50245-66
APP. SAN KN DATE: 9/23/04
DESC. OF WORK: Deck & stairs