

PERMIT

SEWAGE DISPOSAL SYSTEM

MARYLAND STATE DEPARTMENT OF HEALTH

HOWARD COUNTY

ELLCOTT CITY

DISTRICT 7th

DATE 4/8/76

INDEXED

Liberty Leashes Service
EIGHTH STREET

IS PERMITTED TO INSTALL ☒ ALTER

ADDRESS 7311 Brangles Road, Marriottsville, Md. 21104 PHONE 792-8612

A SEWAGE DISPOSAL SYSTEM LOCATED AT

SUBDIVISION

ROAD

LOT

PROPERTY OWNER Richard Trutt

ADDRESS c/o Mrs. Jennie Oliver, 2316 East Gate Drive, Silver Spring, Md. 20906

PHONE: 911-5000 or 911-5001

SPECIFICATIONS 6 bedrooms

DRAIN FIELD DEPTH FEET. BOTTOM AREA SQ. FT.

SEWAGE PITS ADJACENT SIDEWALL AREA SQ. FT.

SEPTIC TANK CAPACITY 1550 GALLONS

FOR GARBAGE GRINDER, INCREASE DISPOSAL AREA AND TANK CAPACITY 500.

OTHER DRY WELL - The dry well will be located 270 ft. in from the side of the road (Route 216) and 25 ft. in from the front property line as shown from the road. The invert will enter the dry well at 6 ft. below original grade. There will be 12 ft. of 12" or equivalent diameter pipe below with a minimum depth of 2 ft. above the original grade.

NOTE: ALL PIPE FROM HOUSE TO DISPOSAL AREA MUST BE CAST IRON.

PERMIT VALID AFTER THREE YEARS.

NOTE: INSTALL STAND PIPE OF SEPTIC TANK AND DRY WELL. STAND PIPES MUST BE 6 INCHES IN DIAMETER. CAST IRON, CONCRETE, OR TERRA COTTA ACCEPTED.

PLANS APPROVED BY Robert T. Macfiefield DATE 12/16/75

FILL SEPTIC TANK AND DISTRIBUTION BOX WITH WATER BEFORE CALLING FOR AN INSPECTION. COVER HD WORK UNTIL INSPECTED AND APPROVED.

NEITHER THE HOWARD COUNTY COMMISSIONERS NOR THE HEALTH DEPARTMENT IS RESPONSIBLE FOR THE SUCCESSFUL OPERATION OF ANY SYSTEM.

BLDG. PERMIT SIGNED

AND RETURNED 4/24/77

Serial # B010 3688 - detached garage

BLDG. PERMIT SIGNED

AND RETURNED 2/19/77

Serial # B010 4070 - addition to kitchen

BLDG. PERMIT SIGNED

AND RETURNED 11/3/77

Serial # B010 4070

3 car garage

BLDG. PERMIT SIGNED

AND RETURNED 8/1/77

Serial # B010 53773

Permit


BLDG. PERMIT SIGNED

AND RETURNED 7-29-78

Serial # B010 113288 - 2nd floor

A 50350B

20897

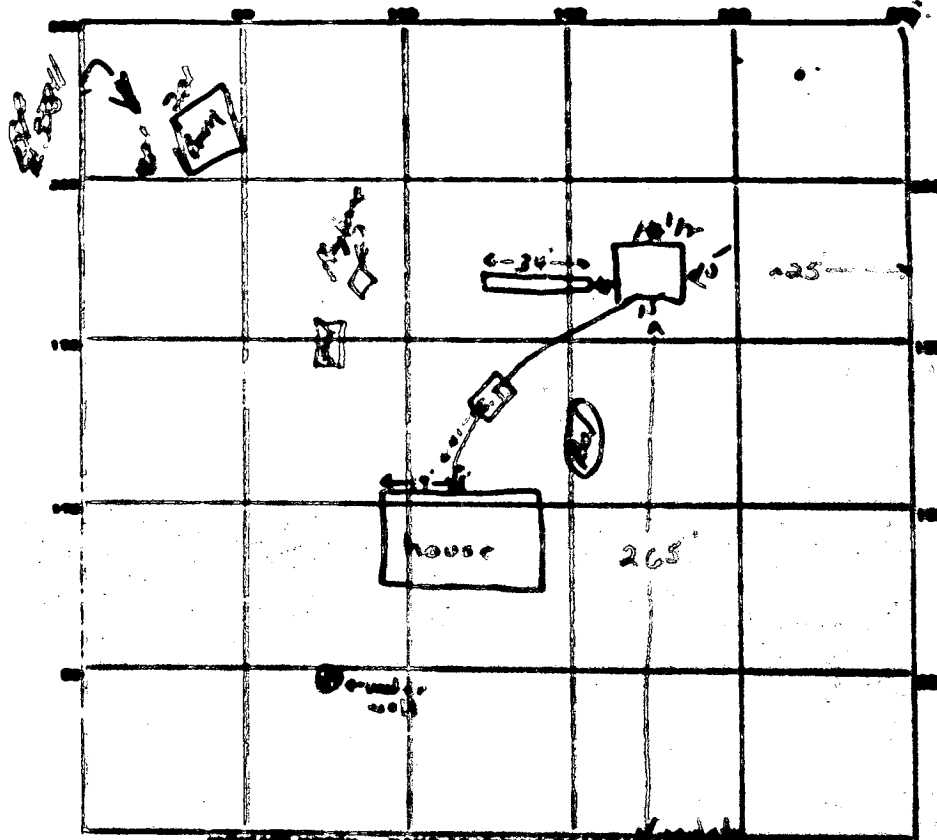

OK
P55193

REMARKS: NAME OF HOME RECORD AS SHOWN ON

PERMIT CARD 49/1/15

SEPTIC TANK LEVEL 1500 gal

CLEANOUT ST. OK

DISTRIBUTION BOX LEVEL

TILE FIELD DEPTH 12 FT. TRENCH WIDTH 2 FT.

GRAVEL DEPTH 7 FT. TOTAL LENGTH 34 FT.

NUMBER OF TRENCHES 1 TOTAL SYSTEM AREA 238

SEEPAGE PITS. INCHES DEEP 60 FT. DEPTH BELOW INLET 7 FT.

ABSORBENT AREA ADU SQ. FT.

REMARKS: 5/1/15 OK lead good, no leak, and found no gas in soil
5/1/15 soil report 1200 ft. x 125 ft. tank 650 sq ft

DATE SYSTEM APPROVED INSPECTOR

THE
11/13/74
9:30 P.M.
HOW

Richard Trott

P_____

STATE OF MARYLAND - DEPARTMENT OF HEALTH AND MENTAL HYGIENE

DISTRICT 5th

DATE 11/7/74

TELEPHONE: 465-0000, EXT. 230 *27 - 100 yd. 300 / 400 100 yd.*

The dry well will be located 270 ft. N. from the edge of the road (or 210) and 25 ft. W. from the right property line as seen from the road. The vent will enter the dry well at 4 ft. below O.G. There will be 134 sq. ft. of chamber sidewall area per below with a max. depth of 10 ft. below O.C.

I, HERSEY, APPLY FOR THE NECESSARY TEST IN ORDER TO CONSTRUCT (OR RECONSTRUCT) A SEWAGE TREATMENT SYSTEM.

PROPERTY OWNER William L. Swann / Richard Trott

ADDRESS 12979 Clarksville Pike, Highland, Md.

~~SECRET~~ 286-2608

PROPERTY LOCATION: Silver Spring 20906

871-6456 or 460-3038

SUBDIVISION: _____ LOT NO. 3

ROAD AND DESCRIPTION	Route 216

SIZE OF LOT 2.077 acres 3 or 4 bedrooms

IF NOT SINGLE RESIDENCE DESCRIBE _____

THE SYSTEM INSTALLED UNDER THIS APPLICATION IS ACCEPTABLE ONLY UNTIL PUBLIC FACILITIES BECOME AVAILABLE.

SIGNATURE OF APPLICANT /s/ William L. Swann

APPROVED BY Ch. M. [Signature] FOR Dag Wall DATE 2/16/74
(NAME OF SYSTEM)

REJECTED BY _____ FOR _____ DATE _____


HOLD PENDING FURTHER TESTS _____ **DATE** _____

REASONS FOR REJECTION OR HOLDING _____

**WFOE PERMIT SIGNED
AND RETURNED** *12/1/96*

THIS IS NOT A PERMIT

2.077 new

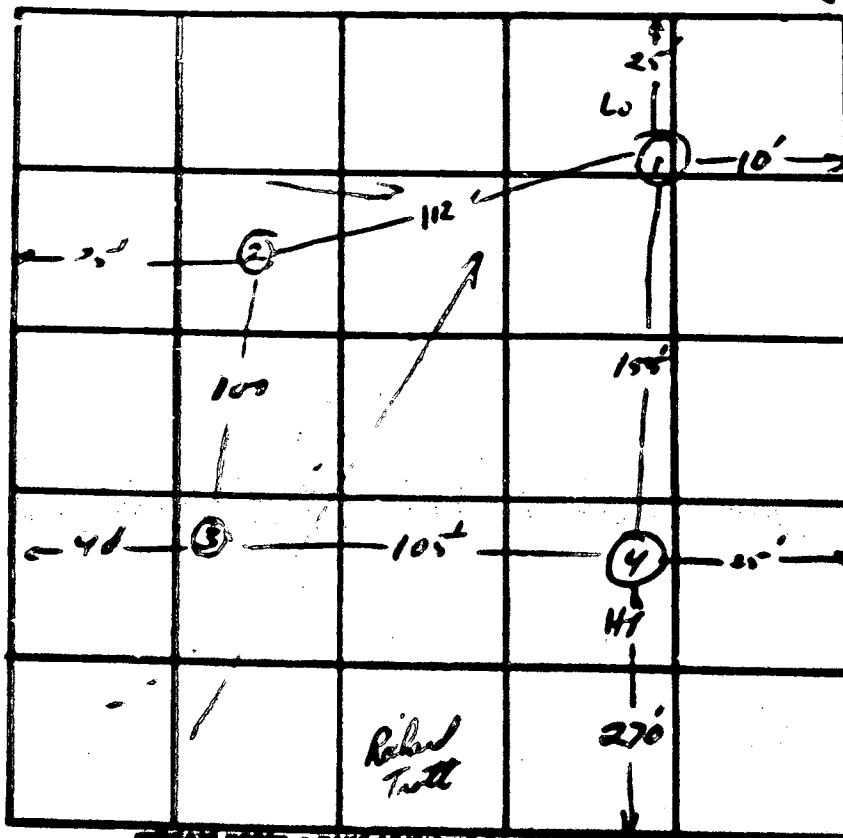

#12636 ← Rt. 216 →

DATE	TEST NO.	POINTS	PRE-TEST		POST-TEST		TIME
			START	STOP	START	STOP	
11/12	4	4	10 ⁴⁵	11 ⁰²	11 ⁰²	11 ⁴²	19
	12	12	10 ⁴⁶	10 ⁴⁷	10 ⁴⁷	10 ⁵²	5
	2	4	10 ⁵³	10 ⁵²	10 ⁵²	10 ⁵⁷	2
	26	12	10 ⁵⁸	10 ⁵⁹	10 ⁵⁸	11 ⁰⁰	4
	3	12	Vii		Same		
	4	4	11 ⁰²	11 ⁰⁴	11 ⁰²	11 ¹¹	7
	48	12	11 ⁰²	11 ⁰²	11 ⁰²	11 ¹²	6

REMARKS _____

TYPE OF SOIL _____

TESTED BY _____ **ALSO PRESENT:** *rd S. & L.*

Ernst

1954年10月16日

Page 200

FBI

LEON BROS

1/24/97

Proposed location
of detached garage
OK as shown.

Starkel

WILLIAM L. SWANN

WATER ELECTRIC CO. HOWARD COUNTY

HIGHLAND, MARYLAND

Section 100 FT March 12, 197

Note: The lot shown herein complies with the minimum ownership and lot size as required by the Maryland State Health Department.

Approved: Private Water, and Private Sander

Can. 11-12-13

1706- KODGE 2/6
1706- ANN ADE 2077
1706- ANN ADE 2077

ADDITION
ON BACK OF
EXISTING
HOUSE

DOOR

KITCHEN

3

41X12

15 Story
on Addition
Deck

SCALE IN 100 FT. March 12, 1974

7/24/08
Proposed
Swim Room
Location
OK as
shown

NOTE: This letter should be in compliance with the
in company, UNIVERSITY and interest as required
by the Department of Health Department.
Approved: [Signature] and [Signature]