

PERMIT

SEWAGE DISPOSAL SYSTEM

DEPARTMENT OF HEALTH AND MENTAL HYGIENE

P 571335

A 50368-R

DISTRICT _____

DATE 1-5-99

DATE SYSTEM APPROVED 2/16/99

INSPECTOR TKS

HOWARD COUNTY HEALTH DEPARTMENT

BUREAU OF ENVIRONMENTAL HEALTH

~~XXXXXX~~

410-313-2640

#360397
INDEXED

Walter King Plumbing & Heating Constructors, Inc., IS PERMITTED TO INSTALL X ALTER _____

ADDRESS 5305 King's Court, Frederick, Maryland 21703-6981 PHONE 301-662-6990

SUBDIVISION Riggs Property LOT 22 ROAD 1941 Sycamore Spring Court

PROPERTY OWNER Ryan Homes James & Suzanne Shaw

ADDRESS _____

SEPTIC TANK CAPACITY 1250 GALLONS

NUMBER OF BEDROOMS 4

180 SQUARE FEET PER BEDROOM

LINEAR FEET OF TRENCH REQUIRED 240

TRENCHES - Trench to be 3 feet wide. Inlet 3.0 feet below original grade. Bottom maximum depth 4.5 feet below original grade. Effective area begins at 4.0 feet below original grade. 2.0 feet of stone below distribution pipe.

LOCATION - Begin trenches 230 feet down the left 378.48' lot line and 70 feet off that same lot line as seen when facing the lot from Sycamore Spring Court. Run trenches on contour in both directions.

NOTES - No trench to exceed 100 feet in length. Provide 6" - 8" diameter cleanout and cap to grade or above on septic tank.

OK KM 12/14/98

PLANS APPROVED BY Amy McMillen DATE 12/09/98

COVER NO WORK UNTIL INSPECTED AND APPROVED

NEITHER THE HOWARD COUNTY COUNCIL NOR THE HEALTH DEPARTMENT IS RESPONSIBLE FOR THE SUCCESSFUL OPERATION OF ANY SYSTEM

NOTE: CLEANOUT REQUIRED EVERY 70 FEET OF SEWER LINE AND/OR AT 90° SWEEPS IN LINES FROM HOUSE TO DRAIN FIELDS. 90° ELBOWS NOT ACCEPTABLE.

NOTE: ALL PARTS OF SEPTIC SYSTEMS (I.E. TANK, DISTRIBUTION BOX TRENCHES) TO BE 100 FEET FROM WELL (UNLESS OTHERWISE SPECIFICALLY AUTHORIZED)

NOTE: IF DEEP TRENCH(ES) ARE USED CALL FOR INSPECTION BEFORE AND AFTER PLACING GRAVEL IN TRENCH(ES)

NOTE: NO DRY WELL SHALL EXCEED 15 FOOT IN DIAMETER NO ABSORPTION TRENCH TO EXCEED 100 FEET IN LENGTH

NOTE: ALL PIPE FROM HOUSE TO SEPTIC TANK MUST BE CAST IRON OR SCHEDULE 35/40 PVC OR A2S

PERMIT VOID AFTER TWO YEARS


NOTE: INSTALL STAND PIPE ON SEPTIC TANK AND DRY WELL STAND PIPES MUST BE 6 INCHES IN DIAMETER CAST IRON, CONCRETE OR TERRA COTTA OR PVA OR ABS ACCEPTED. IF TOP OF SEPTIC TANK IS DEEPER THAN 3 FEET, MANHOLE TO GRADE REQUIRED.

NOTE: DISTRIBUTION BOXES MUST HAVE BAFFLES

*INSTALLER IS RESPONSIBLE FOR OBTAINING FINAL APPROVAL ON THIS PERMIT

*CALL 461-9933 FOR INSPECTION OF SEPTIC SYSTEM.

50368-R

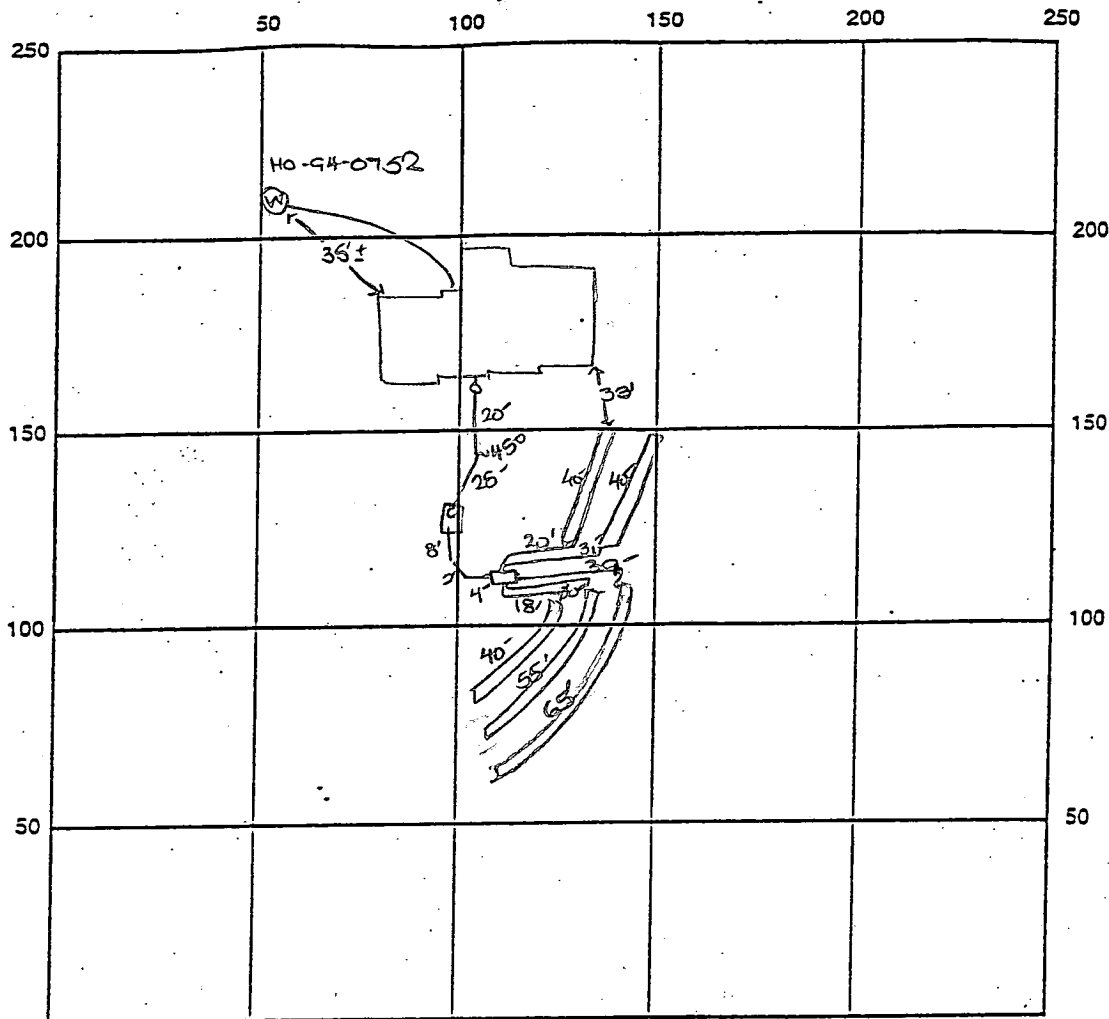

INDICATE NORTH - NAME ADJOINING ROADWAY AS BASE LINE

SEPTIC TANK LEVEL OL -125 @ 1 CLEANOUTS one at house, one on st.

DISTRIBUTION BOX LEVEL OL -baffle in

DRAIN FIELD/TITLE DEPTH 4.5 FT. TRENCH WIDTH 3 FT. INLET DEPTH 3.0 FT.

EFFECTIVE GRAVEL DEPTH 1.5 FT. TOTAL LENGTH 3x40 1x55 1x65 1x240 FT.

NUMBER OF TRENCHES 5 ONE SIDEWALL/BOTTOM AREA 720 SQ. FT.

DRYWALL INSIDE DIAMETER - FT. EFFECTIVE DEPTH BELOW INLET - FT.

ABSORBENT AREA - SQ. FT.

REMARKS: 1/22/99 OK to come into trench @ 3.0' below grade & install 1.5' of stone
giving 6" of stone makes gravity service for the basement AW
2/16/99 FINAL INSP - OL to cover all work. DKS

DATE SYSTEM APPROVED

2/16/99

INSPECTOR

[Signature]

Inv. into trench	677.5
Inv. out of septic tank	678.0
Inv. into septic tank	678.3
Inv. out of house	679.3

Approved Septic System Plan
Howard County Health Department


Amey M. Mello 12/9/98
Signature Date

Total linear feet of trench
required 240 feet

Width of trench(es) 3.0 feet

Depth of trench(es) 4.5 feet

Depth of stone required below
distribution pipe 2.0 feet

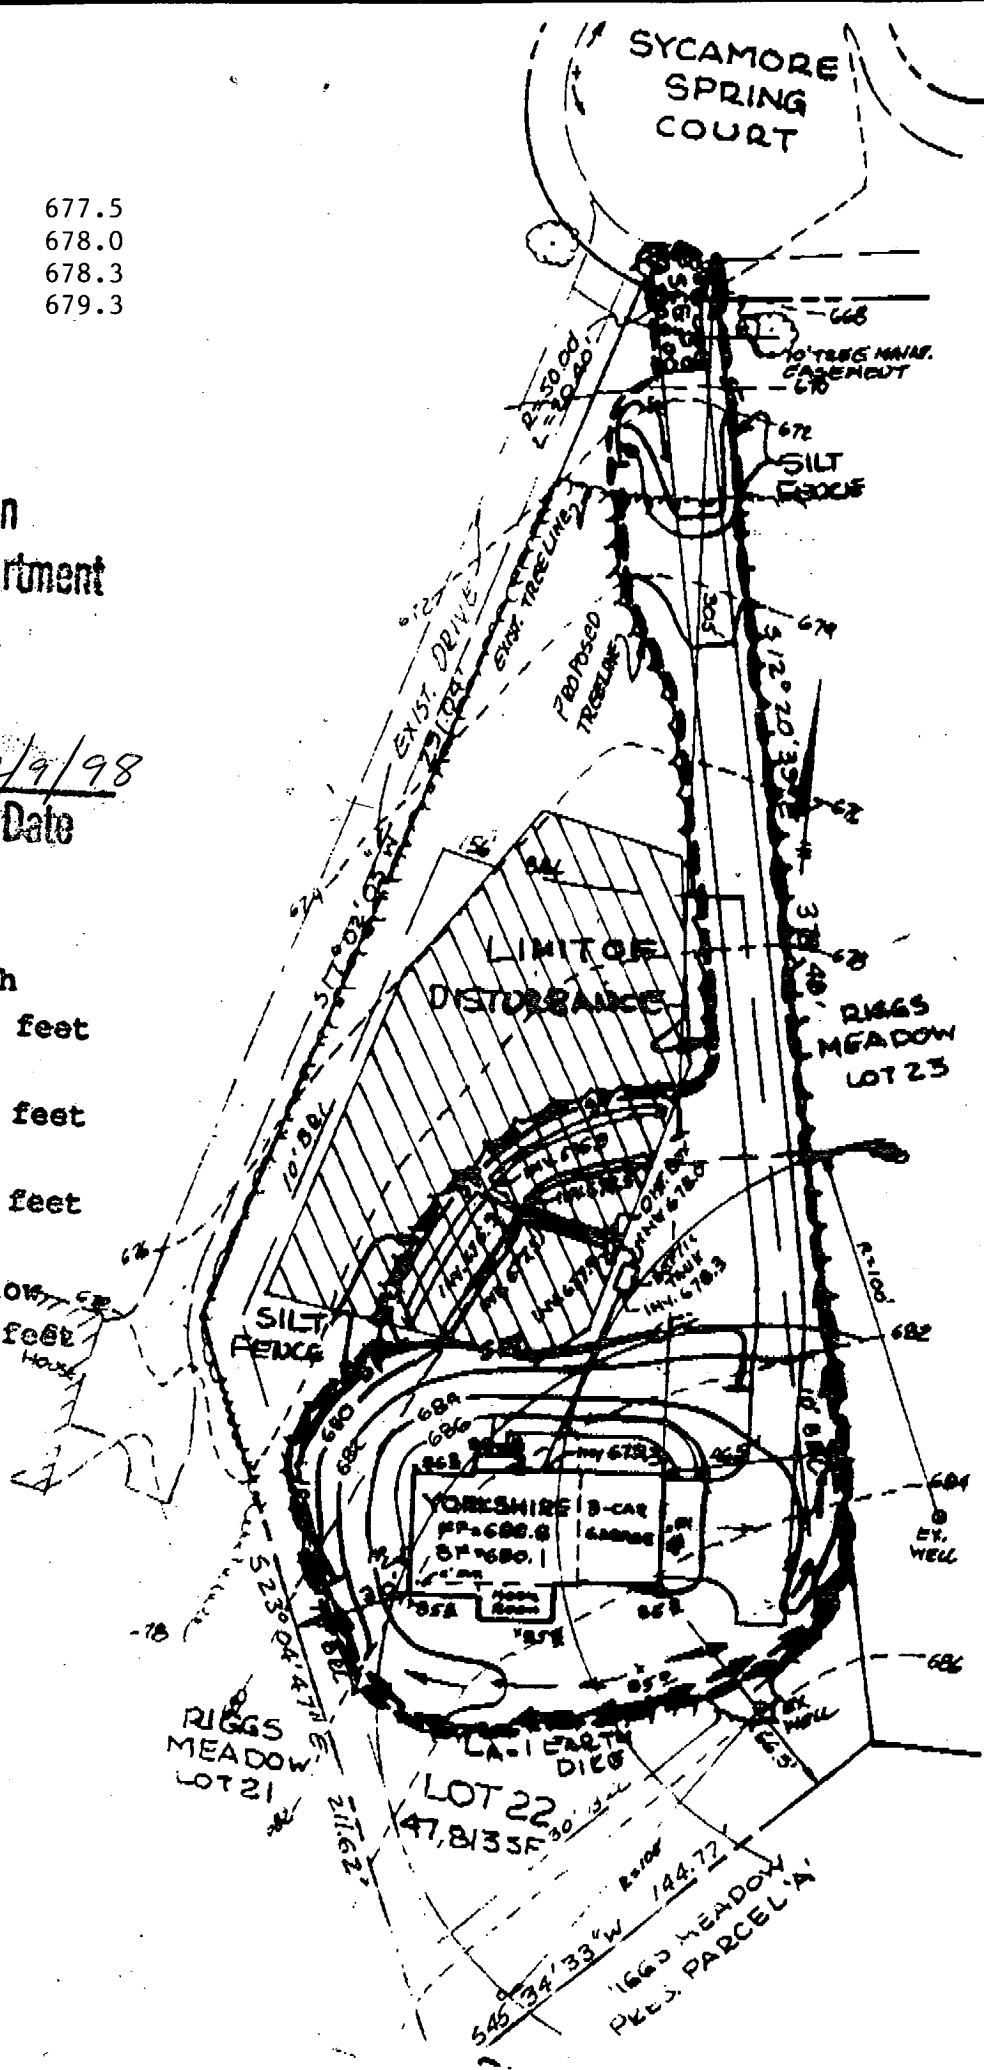

C1	4193	SEQUENCE NO. (MDE USE ONLY)	STATE OF MARYLAND WELL COMPLETION REPORT FILL IN THIS FORM COMPLETELY PLEASE PRINT OR TYPE		THIS REPORT MUST BE SUBMITTED WITHIN 45 DAYS AFTER WELL IS COMPLETED.		
					COUNTY NUMBER	A-50368-X	
ST/CO USE ONLY DATE Received		DATE WELL COMPLETED		Depth of Well		PERMIT NO. FROM "PERMIT TO DRILL WELL"	
8 13		15 20		22 26		28 29 30 31 32 33 34 35 36 37	
		122396		320		H0-94-0752	

OWNER	SDC		last name	R.D. B North		first name			TOWN	COOKSVILLE		
STREET OR RFD												
SUBDIVISION	BIGGS PROPERTY		SECTION	1		LOT	22					

WELL LOG		
Not required for driven wells		
STATE THE KIND OF FORMATIONS PENETRATED, THEIR COLOR, DEPTH, THICKNESS AND IF WATER BEARING		
DESCRIPTION (Use additional sheets if needed)	FEET FROM TO	check if water bearing
Sand	0 16	
Gray mica rock	16 320	✓
Dupwell #40 filled in with cement & drilling materials		

GROUTING RECORD		
WELL HAS BEEN GROUTED (Circle Appropriate Box)		
TYPE OF GROUTING MATERIAL (Circle one)		
CEMENT ☒ CM	BENTONITE CLAY ☒ BC	
NO. OF BAGS 6	NO. OF POUNDS 364	
GALLONS OF WATER 36		
DEPTH OF GROUT SEAL (to nearest foot)		
from 0 ft. to 20 ft.		
(enter 0 if from surface)		
CASING RECORD		
casing types insert appropriate code below		
STEEL ☒ ST	CONCRETE ☒ CO	
PLASTIC ☒ PL	OTHER ☒ OT	
MAIN CASING TYPE	Nominal diameter top (main) casing (nearest inch)!	Total depth of main casing (nearest foot)
ST	6	22
OTHER CASING (if used)	diameter inch	depth (feet) from to
SCREEN RECORD		
screen type or open hole insert appropriate code below		
STEEL ☒ ST	BRASS BRONZE ☒ BR	OPEN HOLE ☒ HO
PLASTIC ☒ PL	OTHER ☒ OT	

C3		
PUMPING TEST		
HOURS PUMPED (nearest hour)	3	
PUMPING RATE (gal. per min.)	005.5	
METHOD USED TO MEASURE PUMPING RATE Bucket		
WATER LEVEL (distance from land surface)		
BEFORE PUMPING	32 ft.	
WHEN PUMPING	179 ft.	
TYPE OF PUMP USED (for test)		
A air	P piston	T turbine
C centrifugal	R rotary	O other (describe below)
J jet	S submersible	

PUMP INSTALLED	
DRILLER WILL INSTALL PUMP (CIRCLE) (YES or NO)	YES NO
IF DRILLER INSTALLS PUMP, THIS SECTION MUST BE COMPLETED FOR ALL WELLS.	
TYPE OF PUMP INSTALLED PLACE (A,C,J,P,R,S,T,O) IN BOX 29	
CAPACITY: GALLONS PER MINUTE (to nearest gallon)	
PUMP HORSE POWER	
PUMP COLUMN LENGTH (nearest ft.)	
CASING HEIGHT (circle appropriate box and enter casing height)	
+ above	LAND SURFACE
- below	2 (nearest foot)

NUMBER OF UNSUCCESSFUL WELLS: 1	
WELL HYDROFRACTURED yes ☒ Y no ☒ N	
CIRCLE APPROPRIATE LETTER	
A A WELL WAS ABANDONED AND SEALED WHEN THIS WELL WAS COMPLETED	
E ELECTRIC LOG OBTAINED	
P TEST WELL CONVERTED TO PRODUCTION WELL	
I HEREBY CERTIFY THAT THIS WELL HAS BEEN CONSTRUCTED IN ACCORDANCE WITH COMAR 26.04.04 "WELL CONSTRUCTION" AND IN CONFORMANCE WITH ALL CONDITIONS STATED IN THE ABOVE CAPTIONED PERMIT, AND THAT THE INFORMATION PRESENTED HEREIN IS ACCURATE AND COMPLETE TO THE BEST OF MY KNOWLEDGE.	
TYPE: MWD/MSD/MGD	DRILLERS LIC. NO. 24
DRILLERS SIGNATURE Joseph L. Mayne	
LIC. NO. 27	DRILLERS SIGNATURE (MUST MATCH SIGNATURE ON APPLICATION)
SITE SUPERVISOR (sign. of driller or journeyman responsible for sitework if different from permittee)	

C2	
DEPTH (nearest ft.)	
H020320	
SLOT SIZE 1 2 3	
DIAMETER OF SCREEN 56 60	
GRAVEL PACK IF WELL DRILLED WAS FLOWING WELL INSERT F IN BOX 68	
MDE USE ONLY (NOT TO BE FILLED IN BY DRILLER) (E.R.O.S.)	
T	W Q
70	72
TELESCOPE CASING	LOG INDICATOR
OTHER DATA	

LOCATION OF WELL ON LOT	
SHOW PERMANENT STRUCTURE SUCH AS BUILDING, SEPTIC TANKS, AND /OR LANDMARKS AND INDICATE NOT LESS THAN TWO DISTANCES (MEASUREMENTS TO WELL)	
See Attached location	

B 1 3032 (THIS NUMBER IS TO BE PUNCHED IN COLUMNS 3-6 ON ALL CARDS)	SEQUENCE NO. (MDE USE ONLY)	STATE OF MARYLAND PERMIT TO DRILL WELL please print or type	STATE PERMIT NUMBER H0-94-0752 fill in this form completely
Date Received (APA) 040996 OWNER INFORMATION SDC BCX417 ELLICOTT CITY MD 21041		B 3 LOCATION OF WELL HOWARD RIGGS PROPERTY COOKSVILLE LOT 22 1 MI	
DRILLER INFORMATION Driller Name: <u>Joseph L. Mayne</u> Firm Name: <u>Joseph L. Mayne Well Drilling</u> Address: <u>5512 Ridge Rd. Mt. Airy Md 21771</u> Signature: <u>Joseph L. Mayne</u> Date: <u>4/9/96</u>		B 4 DIRECTION OF WELL FROM TOWN (CIRCLE BOX) NEAR WHAT ROAD <u>Road B North</u> ON WHICH SIDE OF ROAD (CIRCLE APPROPRIATE BOX) 400 DISTANCE FROM ROAD ENTER FT. OR MI: <u>FT</u> TAX MAP: 14 BLK: PARCEL 96	
B 2 WELL INFORMATION APPROX. PUMPING RATE (GAL. PER MIN.): <u>5</u> AVERAGE DAILY QUANTITY NEEDED (GAL. PER DAY): <u>500</u>		USE FOR WATER (CIRCLE APPROPRIATE BOX) ☒ HOME (SINGLE OR DOUBLE HOUSEHOLD UNIT ONLY) ☐ FARMING (LIVESTOCK WATERING & AGRICULTURAL IRRIGATION) ☐ INDUSTRIAL, COMMERCIAL, STATE AND FEDERAL GOV. OTHER (REQUIRES APPROPRIATION PERMIT) ☐ PUBLIC OR PRIVATE WATER COMPANY (REQUIRES APPROPRIATION PERMIT AND STATE HEALTH DEPARTMENT APPROVAL) ☒ TEST, OBSERVATION, MONITORING (MAY REQUIRE APPROPRIATION PERMIT)	
APPROXIMATE DEPTH OF WELL <u>280</u> FEET APPROXIMATE DIAMETER OF WELL <u>6</u> INCH		NOT TO BE FILLED IN BY DRILLER HEALTH DEPARTMENT APPROVAL <u>HOWARD COUNTY</u> <u>A-50368-X</u> COUNTY NAME COUNTY NO. STATE SIGNATURE _____ DATE ISSUED <u>04/11/96</u> INSERT S <u>41</u> CO SIGNATURE <u>A. McMullen</u> EXP. DATE <u>4/11/97</u> NORTH GRID <u>549000</u> EAST GRID <u>0788000</u>	
METHOD OF DRILLING (circle one) BORED (or Augered) <u>JETTED</u> <u>DRIVEN</u> AIR-ROTARY <u>AIR-PERCussion</u> <u>ROTARY</u> (Hydraulic Rotary) CABLE <u>REVERSE-ROTARY</u> <u>DRIVE-POINT</u> other _____		SHOW MAJOR FEATURES OF BOX & LOCATE WELL WITH AN X SOURCES OF DRILLING WATER 1. <u>WELL</u> 2. _____ 3. _____ WRITE THE BOX NUMBER FROM THE MAP HERE 7288 53040	
REPLACEMENT OR DEEPEENED WELLS (CIRCLE APPROPRIATE BOX) ☒ THIS WELL WILL NOT REPLACE AN EXISTING WELL ☐ THIS WELL WILL REPLACE A WELL THAT WILL BE ABANDONED AND SEALED ☐ THIS WELL WILL REPLACE A WELL THAT WILL BE USED AS A STANDBY-CONTACT LOCAL APPROVING AUTHORITY FOR POLICY ON STANDBY WELLS ☐ THIS WELL WILL DEEPEEN AN EXISTING WELL PERMIT NUMBER OF WELL TO BE REPLACED OR DEEPEENED (IF AVAILABLE) _____		DRAW A SKETCH BELOW SHOWING LOCATION OF WELL IN RELATION TO NEARBY TOWNS AND ROADS AND GIVE DISTANCE FROM WELL TO NEAREST ROAD JUNCTION 	
Not to be filled in by driller (MDE OR COUNTY USE ONLY) APPROX. PERMIT NUMBER <u>GAP</u> FORCE <u>AM</u> WRITE INITIALS IN BOX PERMIT No. <u>H0-94-0752</u> SPECIAL CONDITIONS NOTE - APPROVING AUTHORITIES SHOULD USE SEPARATE SHEET IF NEEDED			

SERV
ATION EAST

LOT 17
59,659 SQ. FT.
1.37 Acres

LOT 16
48,868 SQ. FT.
1.12 Acres

LOT 15
43,588 SQ. FT.
1.00 Acres

LOT 24
42,541 SQ. FT.
0.98 Acres

LOT 25
42,541 SQ. FT.
0.98 Acres

LOT 26
42,541 SQ. FT.
0.98 Acres

LOT 27
42,541 SQ. FT.
0.98 Acres

LOT 28
42,541 SQ. FT.
0.98 Acres

LOT 22
47,813 SQ. FT.
1.10 Acres

LOT 23
43,629 SQ. FT.
1.00 Acres

4/11/96
NO SITE INSPECTION
SURVEYOR PER
WELL SITE OF
STAKE SET
10/4/96
and well site
OK as staked
align

(2) 24" PIPE SLOPE
DRAIN TO CONVEY
CLEAN WATER

SILT
FENCE

N. ROAD
LIMIT OF
DISTURBANCE

DRAINAGE AND
UTILITY EASEMENT

LIMIT OF
DISTURBANCE

APPLICATION

PERCOLATION TESTING

HOWARD COUNTY HEALTH DEPARTMENT
BUREAU OF ENVIRONMENTAL HEALTH
PO BOX 476 ELLICOTT CITY, MARYLAND 21043
TELEPHONE 461-9933

A 50368 ~~28~~ R

P _____

DISTRICT 4th

DATE 9/30/94

TO: THE COUNTY HEALTH OFFICER
ELLICOTT CITY, MARYLAND

I HEREBY APPLY FOR THE NECESSARY TEST IN ORDER TO CONSTRUCT OR RECONSTRUCT A SEWAGE DISPOSAL SYSTEM

PROPERTY OWNER Amalia Riggs, c/o SDC Group, Inc. RYAN HOMES

ADDRESS 8480 N Baltimore - National Pike
PO BOX 417, Ellicott City, MD 21041 PHONE (410) 465-6125

PROSPECTIVE BUYER _____

ADDRESS _____ PHONE _____

PROPERTY LOCATION:

SUBDIVISION Riggs Property LOT NO. Grd. 1 22

ROAD AND DESCRIPTION Located @ SW Corner of the intersection of

Roxbury Mill (Rte. 97) & Frederick Rd (Rte 144)

TAX MAP 8814 PARCEL # 96 (1941 SYCAMORE SPRING CT) BLDG. PERMIT SIGNED

SIZE OF LOT 55000 ± S.F. TYPE BLDG Single Family Dwelling - 4 Br

AND RETURNED 12-9-95
Sealed & Brought to 553
(SINGLE FAMILY DWELLING OR COMMERCIAL)

THE SYSTEM INSTALLED UNDER THIS APPLICATION IS ACCEPTABLE ONLY UNTIL PUBLIC FACILITIES BECOME AVAILABLE. I FULLY UNDERSTAND THE

FEE CONNECTED WITH THE FILING OF THIS PERC TEST APPLICATION IS NON-REFUNDABLE UNDER ANY CIRCUMSTANCES. I ALSO AGREE TO COMPLY

WITH ALL M.O.S.H.A. REQUIREMENTS IN TESTING THIS LOT. James R. Morley, III V. Pos.

(SIGNATURE OF APPLICANT)

APPROVED BY _____ FOR _____ DATE _____

REJECTED BY _____ FOR _____ DATE _____

HOLD PENDING FURTHER TESTS _____ DATE _____

REASONS FOR REJECTION OR HOLDING _____

THIS IS NOT A PERMIT

COUNTY #

SOIL PROFILE


914 4'

red
brn
clm4' reddish
brn
micaceous
silum
some
sand
5%
2"-3" dia
rock
brags
OK

11.5 581

brn
orange
sacilm4' pink
sasilm
50%
rock
brags9' yellow
orange
sacilm

11 575

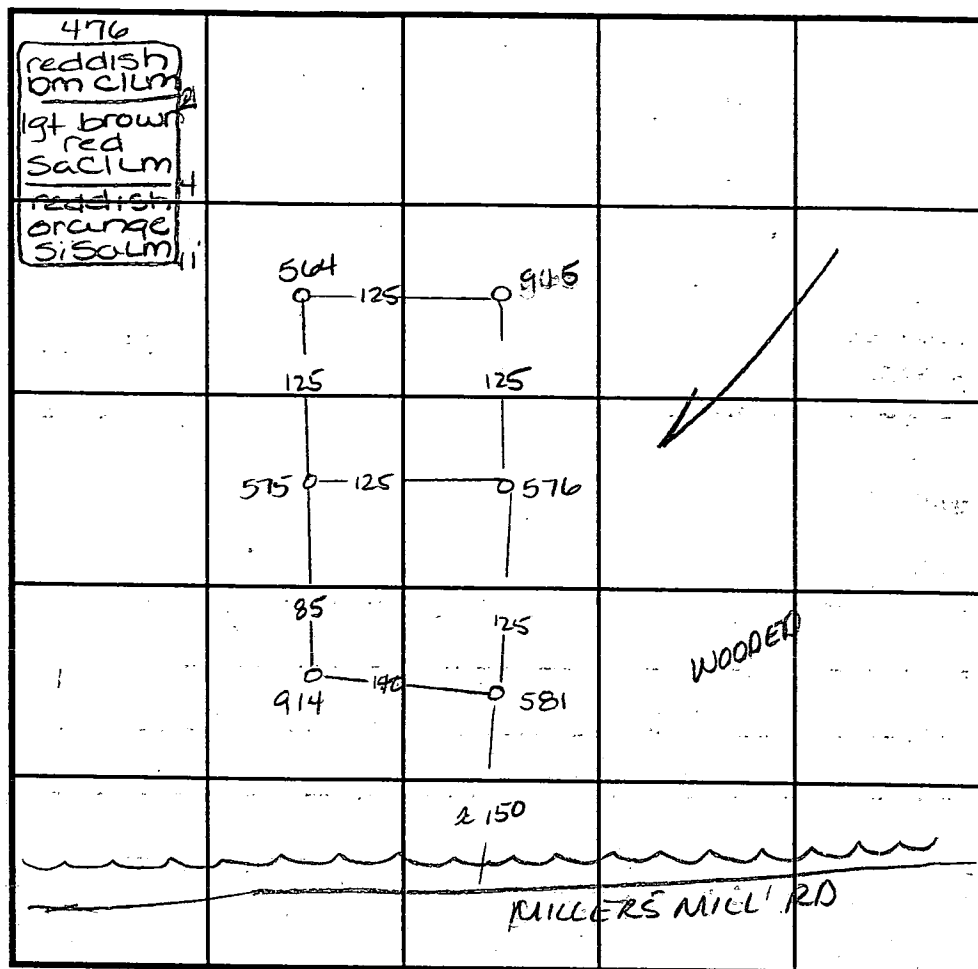lgt red
sacilm4' lgt red
sacilm
gravelly
very
friable
and
dry
10-15%
saprolite

INDICATE NORTH - NAME ADJOINING ROADWAY AS BASE LINE.

SOIL PROFILE

564
0' tan
csalm
5' orange
sasilm
some
saprolite
OK
8.5' -pocket
of rock
stay 4'
off
shallow
system
only

11.5 915
orange
brown
silum
3' red
silum
10%
rock brags
refusal

DATE	TEST NO.	DEPTH	PRE-WET		TEST - 1" DROP		TIME
			START	STOP	START	STOP	
4-26-95	914	Visual	to 11.5	—	see profile -		OK
11-17-94	581	4.5 VII	8:28 ³⁰	8:29 ³⁰	8:29 ³⁰	8:31 ³⁰	2min
	576	4.5 VII	6:21	6:22 ³⁰	6:22 ³⁰	6:28 ³⁰	6min
	575	4.5 VII	7:40 ¹⁵	7:40 ⁴⁵	7:40 ⁴⁵	7:46	5 1/4 min
	564	3.5 VII.5	9:54	9:58	9:58	10:01	3min
4-26-95	915	Visual	to 11.0	—	—		OK

REMARKS

TYPE OF SOIL

TESTED BY

Amy McMillen

ALSO PRESENT


TRENCH DESIGN DATA: AVERAGE PERCOLATION TIME


TRENCH WIDTH

INLET DEPTH

MAXIMUM BOTTOM DEPTH

SQ. FT/BEDROOM

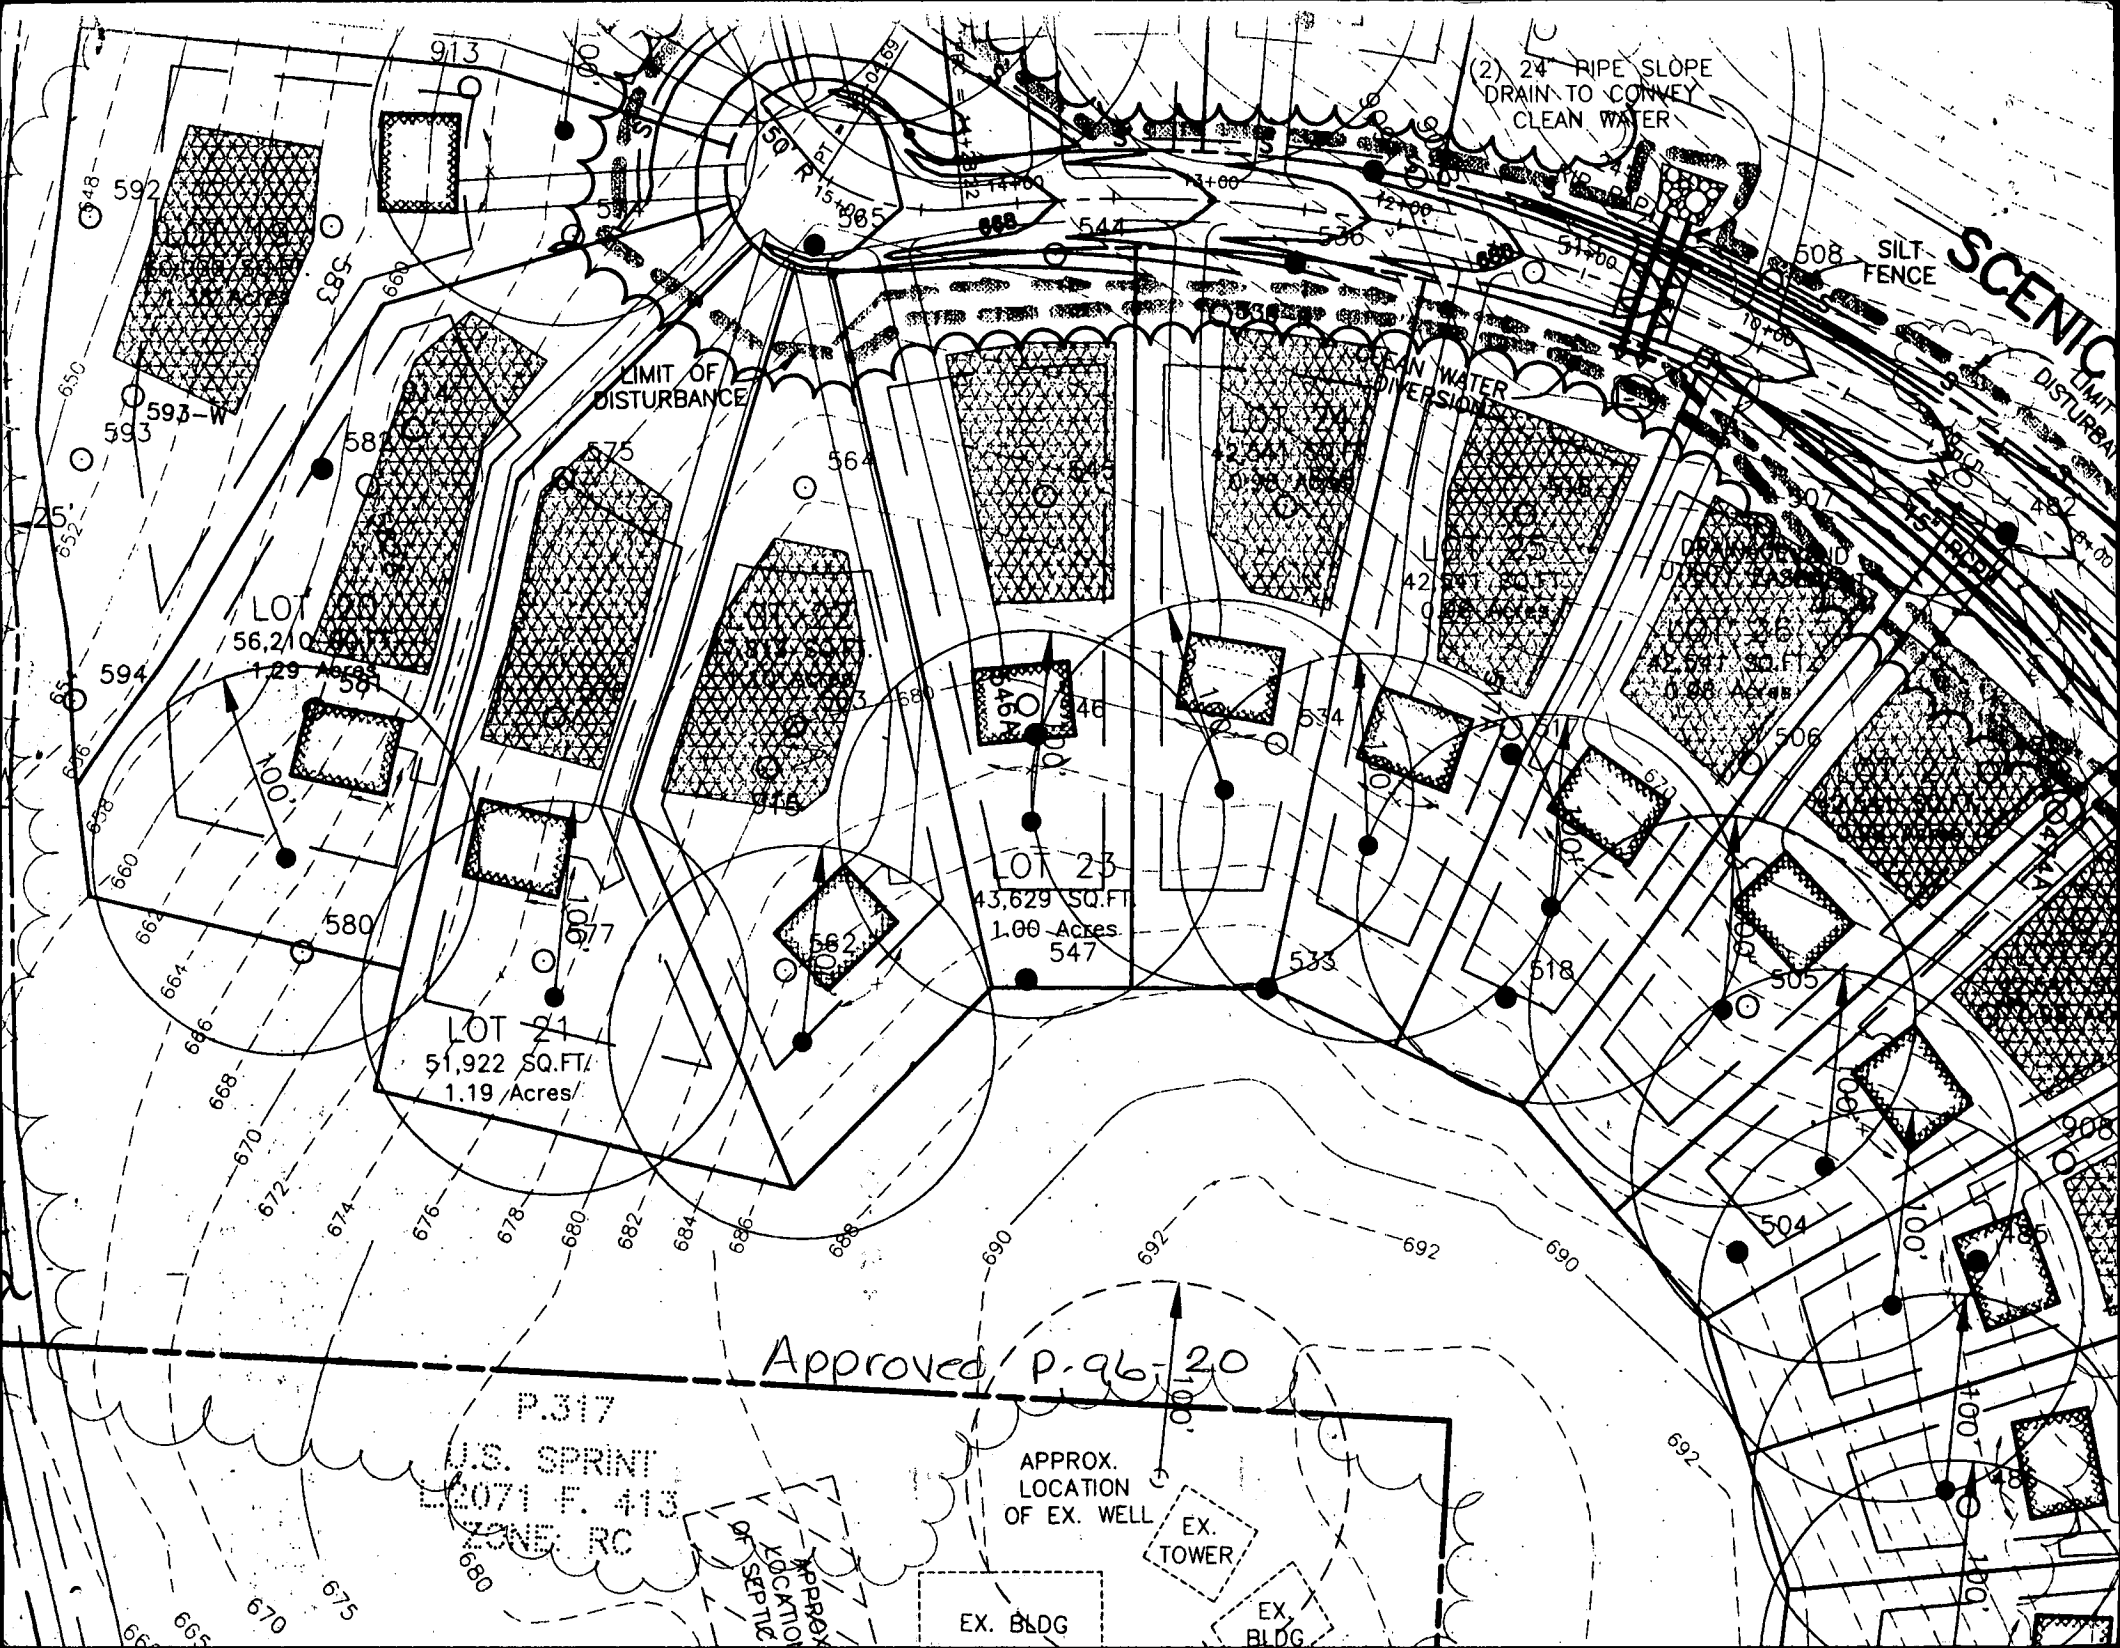

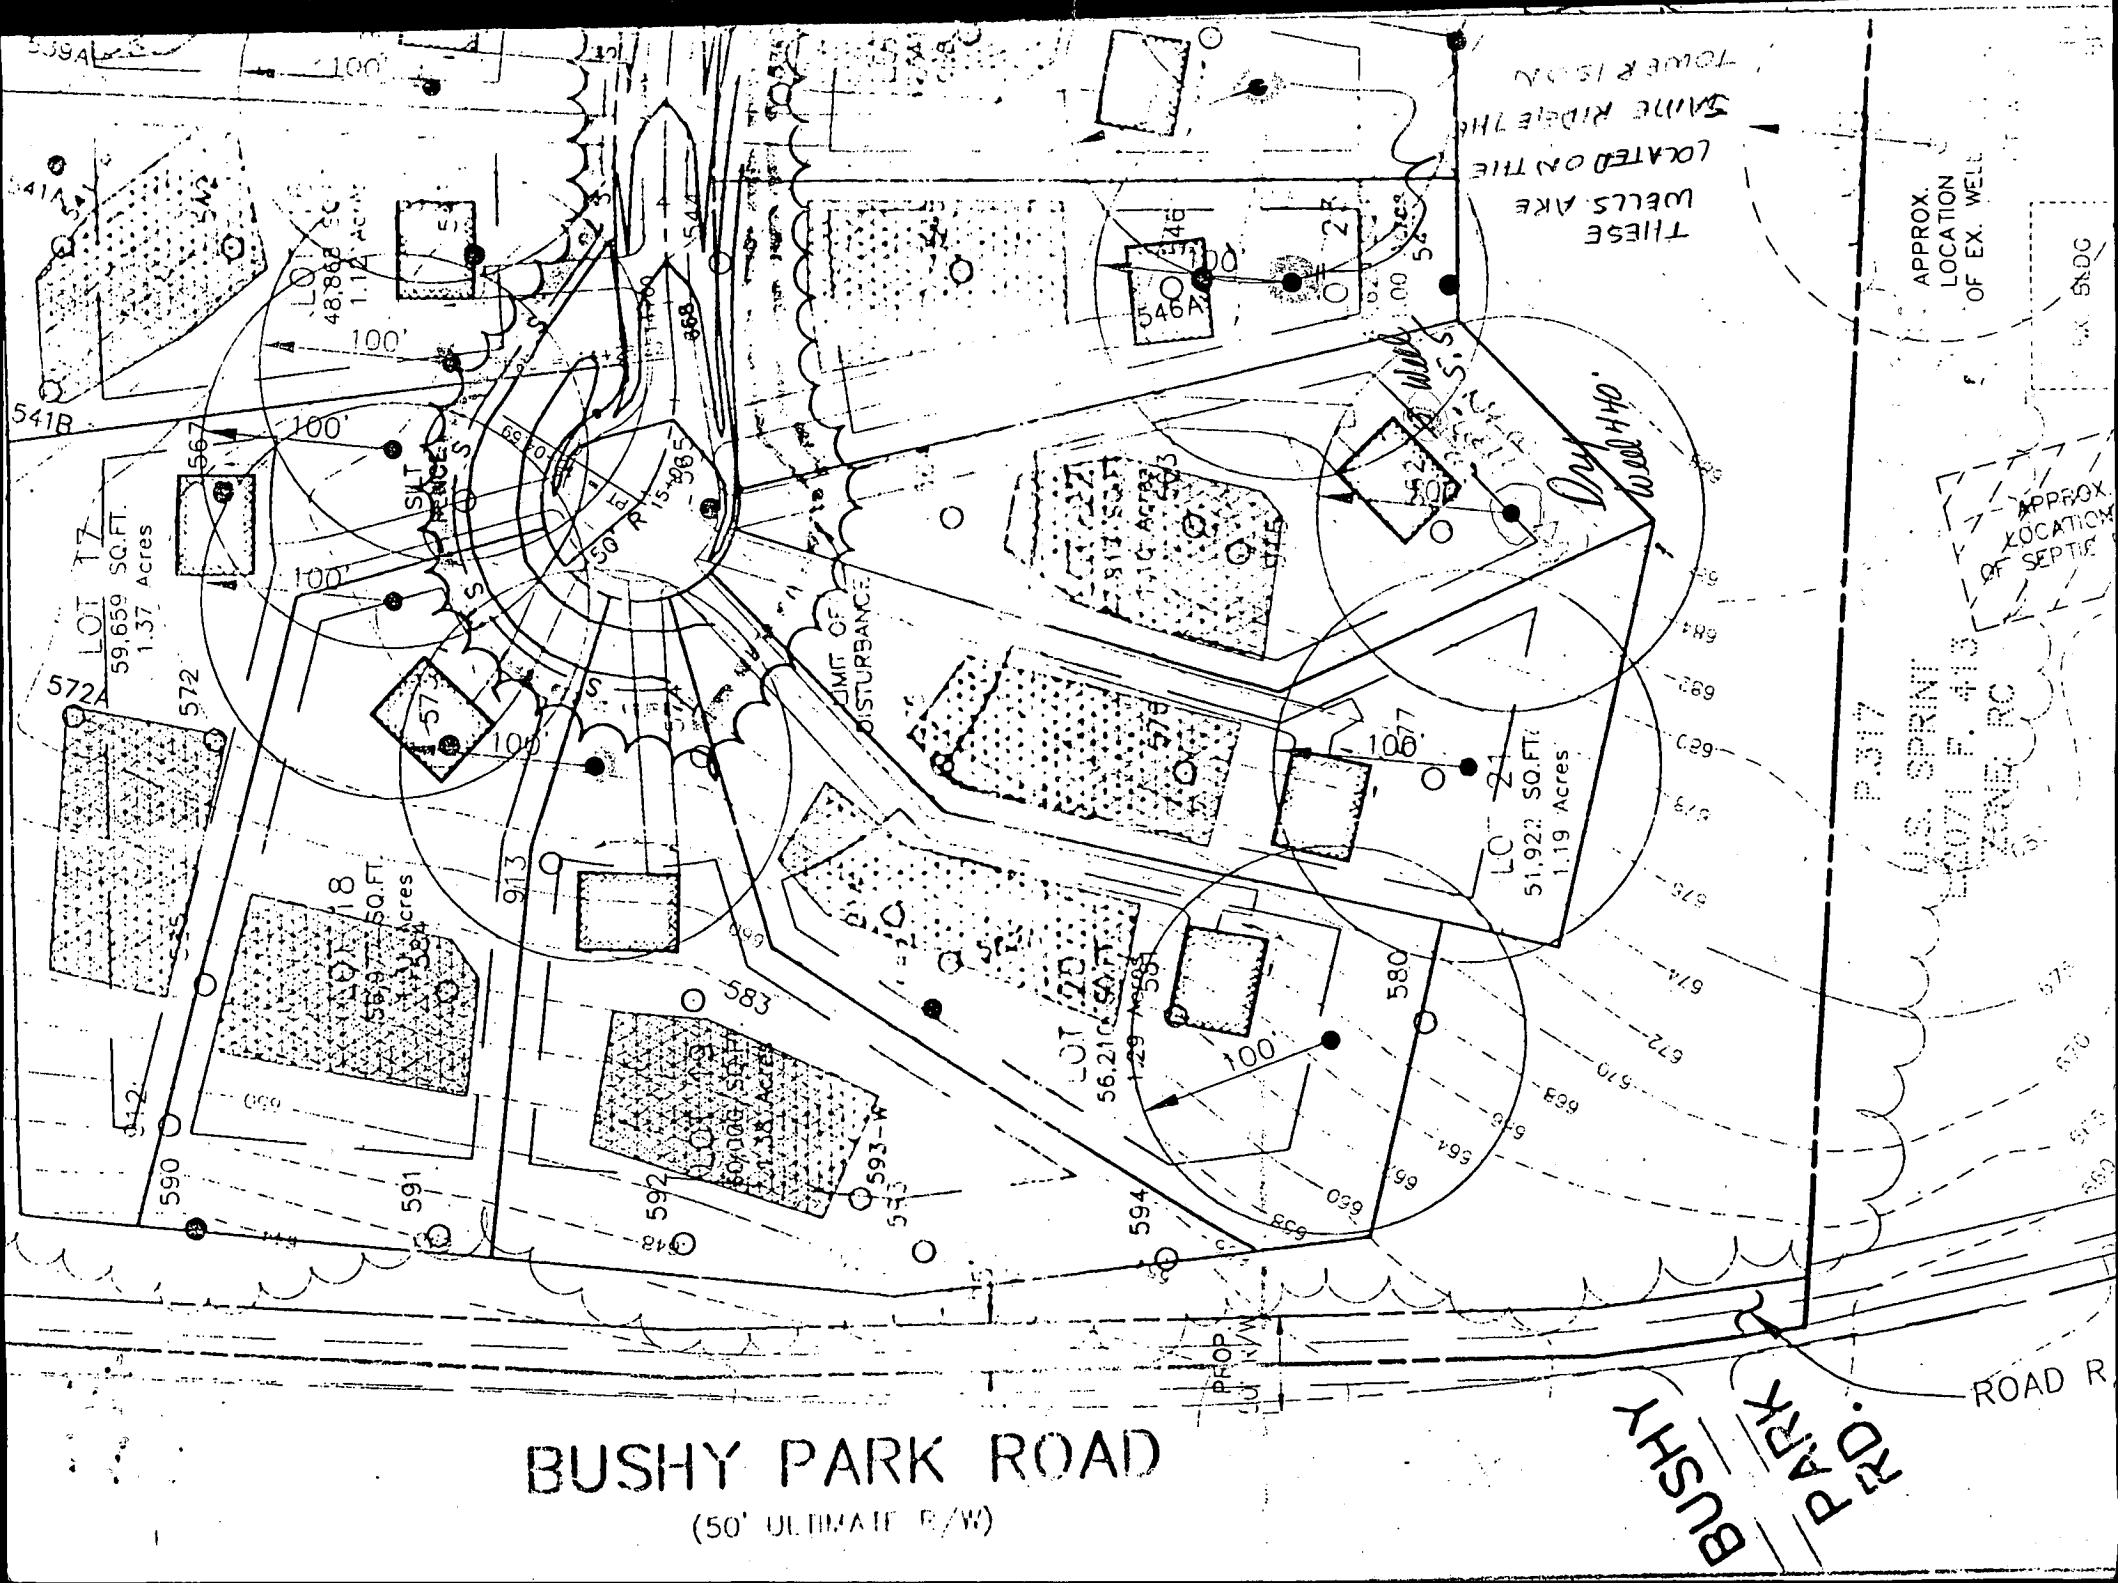

BUSHY PARK ROAD
(50' ULTIMATE R/W)

BUSHY
PARK
RD.

ROAD R

LOCATED ON THE
SLOPE RIDGE THE
THESE ARE
WELLS ARE

APPROX.
LOCATION
OF EX. WELL

APPROX.
LOCATION
OF SEPTIC

P.317
U.S. SPRING
2007 F. 413
ZONE RC

410-254-7601

10/7

RM 0022

A.F. STAKE DRIVE


SCOTT 10/71

ATTN:
ANDY

BOO124256
PROPOSED ROCK OK
ADEQUATE CLEARANCE
TO WELL & SEPTIC PROVIDED
5/17/00 C. WILLY
HOW TO HEALTH

RECEIVED
HOWARD COUNTY HEALTH DEPT.
ENVIRONMENTAL HEALTH
2000 MAY 17 PM 2:12

BOO124573
PROPOSED 8' x 8'
HOT TUB
OK
42' TO WELL ±
MR 6/1/00

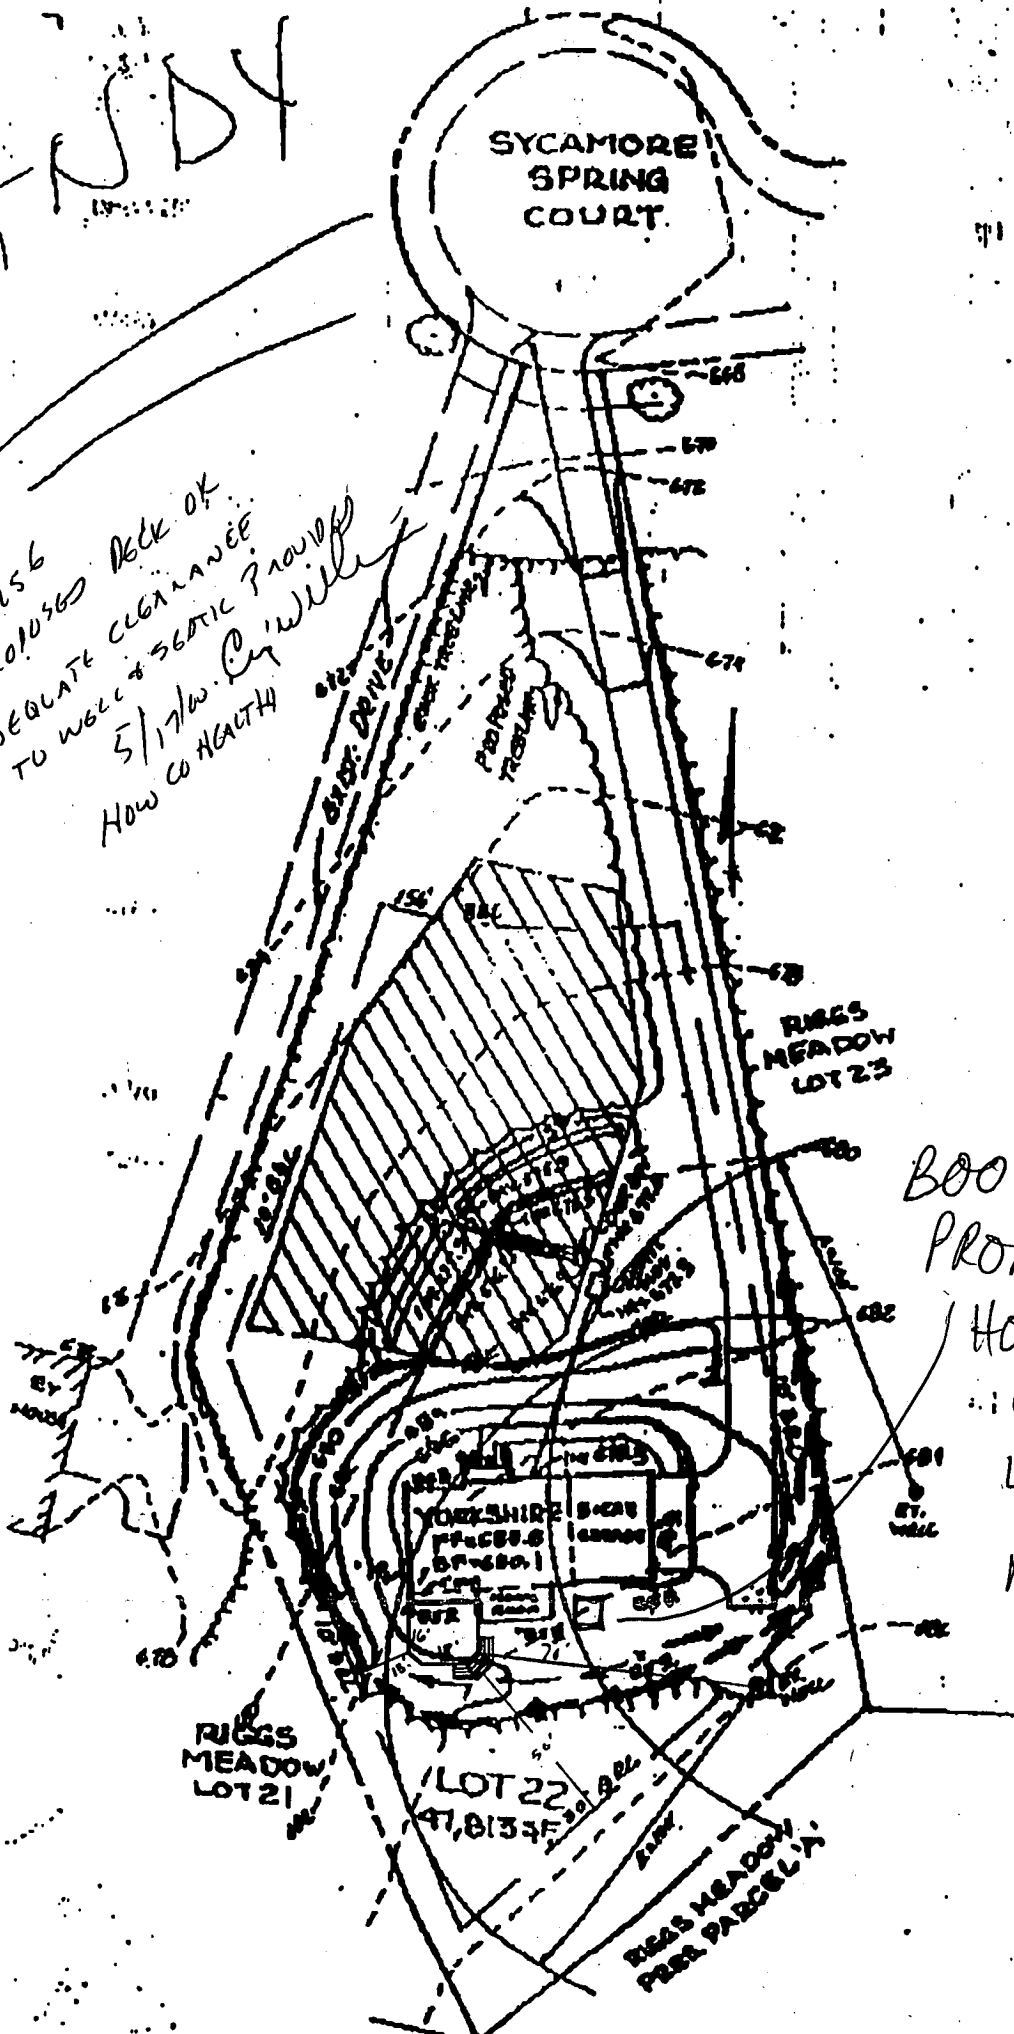

PLAN
SCALE 1" = 50'

DEPARTMENT OF INSPECTIONS, LICENSES AND PERMITS 3430 COURT HOUSE DRIVE ELLICOTT CITY, MD 21043 PERMITS (410)313-2466 INSPECTIONS (410)313-1810 AUTOMATED INFORMATION (410) 313-3800	HOWARD COUNTY PERMIT APPLICATION	PERMIT NUMBER B00124256
---	-------------------------------------	----------------------------

Building Address <u>1911 Spicamore Springs Ct</u> <u>Cookville MD 21723</u>	Property Owner's Name <u>James Shaw</u> Address <u>1911 Spicamore Springs Ct</u> City <u>Cookville</u> State <u>MD</u> Zip Code <u>21723</u> Home Phone <u>410-942-2982</u> Work Phone <u>410-951-4144</u> Applicant's Name & Mailing Address, (if other than stated hereon): <u>6503 R BELAIR RD</u> <u>BALTO, MD 21206</u> Phone <u>410-254-7260</u> Fax <u>410-254-7601</u>
Suite/Apt. #: _____ SDP/WP/Petition #: _____ Census Tract _____ Subdivision <u>Ridge Manor</u> Section _____ Area _____ Lot <u>21</u> Tax Map _____ Parcel _____ Grid _____ Zoning _____ Map Coordinates _____ Lot size _____	Contractor Company <u>AMERICAN DECK FARM</u> Contact Person <u>David A Lombardi</u> Address <u>6503 R BELAIR RD</u> City <u>BALTO</u> State <u>MD</u> Zip Code <u>21206</u> License No. <u>35565</u> Phone <u>410-254-7260</u> Fax <u>410-254-7601</u>
Existing Use <u>SFD</u> Proposed Use <u>SFD - deck on porch</u> Estimated Construction Cost \$ <u>5000.00</u> Description of Work <u>Construct 16'x18' x 4' Ht</u> <u>wood deck on rear of SFD</u> <u>of steps to grade</u>	Engineer or Architect Company _____ Contact Person _____ Address _____ City _____ State _____ Zip Code _____ Phone _____ Fax _____
Occupant or Tenant Contact Name <u>SAIME</u> Address _____ City _____ State _____ Zip Code _____ Phone _____ Fax _____	

BUILDING DESCRIPTION - COMMERCIAL		BUILDING DESCRIPTION - RESIDENTIAL	
Building Characteristics Height: _____ No. of stories: _____ Gross area, sq. ft. per floor: _____ Use group: _____ Construction type: ☐ Reinforced Concrete ☐ Structural Steel ☐ Masonry ☐ Wood Frame ☐ State Certified Modular	Utilities Water Supply: _____ ☐ Public ☐ Private Sewage Disposal: _____ ☐ Public ☐ Private Electric Yes ☐ No ☐ Gas Yes ☐ No ☐ Heating System: Electric ☐ Oil ☐ Natural Gas ☐ Propane Gas ☐ Sprinkler system: N/A ☐ ☐ Full ☐ Partial ☐ Other Suppression ☐ # of Heads	Building Characteristics SF Dwelling ☐ SF Townhouse ☐ <u>Depth</u> <u>Width</u> 1st floor: _____ 2nd floor: _____ Basement: _____ Finished Basement ☐ Unfinished Basement ☐ Crawl space ☐ Slab on Grade ☐ No. of Bedrooms: _____ Multi-family dwellings: No. of efficiency units: _____ No. of 1 BR units: _____ No. of 2 BR units: _____ No. of 3 BR units: _____ Other Structure: _____ Dimensions: _____ Footings: <u>18" x 18"</u> Roof: _____ ☐ State Certified Modular ☐ Manufactured Home	Utilities Water Supply: _____ ☐ Public ☒ Private Sewage Disposal: _____ ☐ Public ☒ Private Electric Yes ☐ No ☐ Gas Yes ☐ No ☐ Heating System: Electric ☐ Oil ☐ Natural Gas ☐ Propane Gas ☐ Sprinkler system: N/A ☐ ☐ NFPA #13D ☐ NFPA #13R ☐ Other

THE UNDERSIGNED HEREBY CERTIFIES AND AGREES AS FOLLOWS: (1) THAT HE/SHE IS AUTHORIZED TO MAKE THIS APPLICATION; (2) THAT THE INFORMATION IS CORRECT; (3) THAT HE/SHE WILL COMPLY WITH ALL REGULATIONS OF HOWARD COUNTY WHICH ARE APPLICABLE THERETO; (4) THAT HE/SHE WILL PERFORM NO WORK ON THE ABOVE REFERENCED PROPERTY NOT SPECIFICALLY DESCRIBED IN THIS APPLICATION; (5) THAT HE/SHE GRANTS COUNTY OFFICIALS THE RIGHT TO ENTER ONTO THIS PROPERTY FOR THE PURPOSE OF INSPECTING THE WORK PERMITTED AND POSTING NOTICES.

Applicant's Signature <u>[Signature]</u> Title/Company <u>Project Manager</u>	Print Name <u>David A Lombardi</u> Date <u>5/17/2000</u>
--	---

Checks payable to: DIRECTOR OF FINANCE OF HOWARD COUNTY ** PLEASE WRITE NEATLY AND LEGIBLY ** - FOR OFFICE USE ONLY -	
AGENCY ☒ Land Development, DPZ ☒ State Highways ☒ Building Official <u>[Signature]</u> ☒ Dev. Engineering, DPZ ☒ Health <u>5/17/00</u> <u>[Signature]</u> ☒ Fire Protection Is Sediment Control approval required prior to issuance? YES ☐ NO ☐	SIGNATURE APPROVAL DPZ SETBACK INFORMATION Front: _____ Rear: _____ Side: _____ Side St.: _____ All minimum setbacks met? YES ☐ NO ☐ Is Entrance Permit required? YES ☐ NO ☐ Historic District? YES ☐ NO ☐ Lot Coverage for NewTown Zone _____ SDP/Red-line approval date _____
DATE <u>5/17/00</u>	PROPERTY ID# <u>38750</u> Filing fee \$ _____ Permit fee \$ <u>75</u> Excise tax \$ _____ Sub-total paid \$ _____ Add'l permit fee \$ _____ TOTAL FEES \$ <u>75</u> Balance due \$ _____ Check # <u>6764</u> Validation # <u>31071</u>
CONTINGENCY CONSTRUCTION START: ☐ ONE STOP SHOP: ☐	
Accepted by <u>[Signature]</u>	