

PERMIT

SEWAGE DISPOSAL SYSTEM

DEPARTMENT OF HEALTH AND MENTAL HYGIENE

P 511394

A 50368-X

DISTRICT _____

DATE 02-05-99

DATE SYSTEM APPROVED 5/19/99

INSPECTOR S.R.K.

HOWARD COUNTY HEALTH DEPARTMENT

BUREAU OF ENVIRONMENTAL HEALTH

~~XXXXXX~~ 410-313-2640

INDEXED

Walter W. King Plumbing & Heating IS PERMITTED TO INSTALL ☒ ALTER ☐

ADDRESS 5305 King's Court, Frederick, Maryland 21703-6990 PHONE 301-662-6990

SUBDIVISION Riggs Property LOT 27 ROAD 1921 Sycamore Spring Court

PROPERTY OWNER Ryan Homes

ADDRESS _____

SEPTIC TANK CAPACITY 1250 GALLONS

NUMBER OF BEDROOMS 4

180 SQUARE FEET PER BEDROOM

LINEAR FEET OF TRENCH REQUIRED 240

TRENCHES - Trench to be 3 feet wide. Inlet 3.5 feet below original grade. Bottom maximum depth 5.5 feet below original grade. Effective area begins at 3.5 feet below original grade. 2.0 feet of stone below distribution pipe.

LOCATION - Start the first trench 160 feet down the left lot line and 50 feet off that same lot line as seen when facing the lot from Seenie Drive. Run trenches on contour in both directions.

NOTES - No trench to exceed 100 feet in length. Provide 6" - 8" diameter cleanout and cap to grade or above on septic tank.

OK Km 10/21/98

PLANS APPROVED BY Amy McMillen REVISED DATE 10-07-98

COVER NO WORK UNTIL INSPECTED AND APPROVED

NEITHER THE HOWARD COUNTY COUNCIL NOR THE HEALTH DEPARTMENT IS RESPONSIBLE FOR THE SUCCESSFUL OPERATION OF ANY SYSTEM

NOTE: CLEANOUT REQUIRED EVERY 70 FEET OF SEWER LINE AND/OR AT 90° SWEEPS IN LINES FROM HOUSE TO DRAIN FIELDS, 90° ELBOWS NOT ACCEPTABLE.

NOTE: ALL PARTS OF SEPTIC SYSTEMS (I.E. TANK, DISTRIBUTION BOX TRENCHES) TO BE 100 FEET FROM WELL (UNLESS OTHERWISE SPECIFICALLY AUTHORIZED)

NOTE: IF DEEP TRENCH(ES) ARE USED CALL FOR INSPECTION BEFORE AND AFTER PLACING GRAVEL IN TRENCH(ES)

NOTE: NO DRY WELL SHALL EXCEED 15 FOOT IN DIAMETER NO ABSORPTION TRENCH TO EXCEED 100 FEET IN LENGTH

NOTE: ALL PIPE FROM HOUSE TO SEPTIC TANK MUST BE CAST IRON OR SCHEDULE 35/40 PVC OR ABS

PERMIT VOID AFTER TWO YEARS


NOTE: INSTALL STAND PIPE ON SEPTIC TANK AND DRY WELL STAND PIPES MUST BE 6 INCHES IN DIAMETER CAST IRON, CONCRETE OR TERRA COTTA OR PVA OR ABS ACCEPTED. IF TOP OF SEPTIC TANK IS DEEPER THAN 3 FEET, MANHOLE TO GRADE REQUIRED.

NOTE: DISTRIBUTION BOXES MUST HAVE BAFFLES

*INSTALLER IS RESPONSIBLE FOR OBTAINING FINAL APPROVAL ON THIS PERMIT

*CALL 461-9933 FOR INSPECTION OF SEPTIC SYSTEM.

A-50368-X

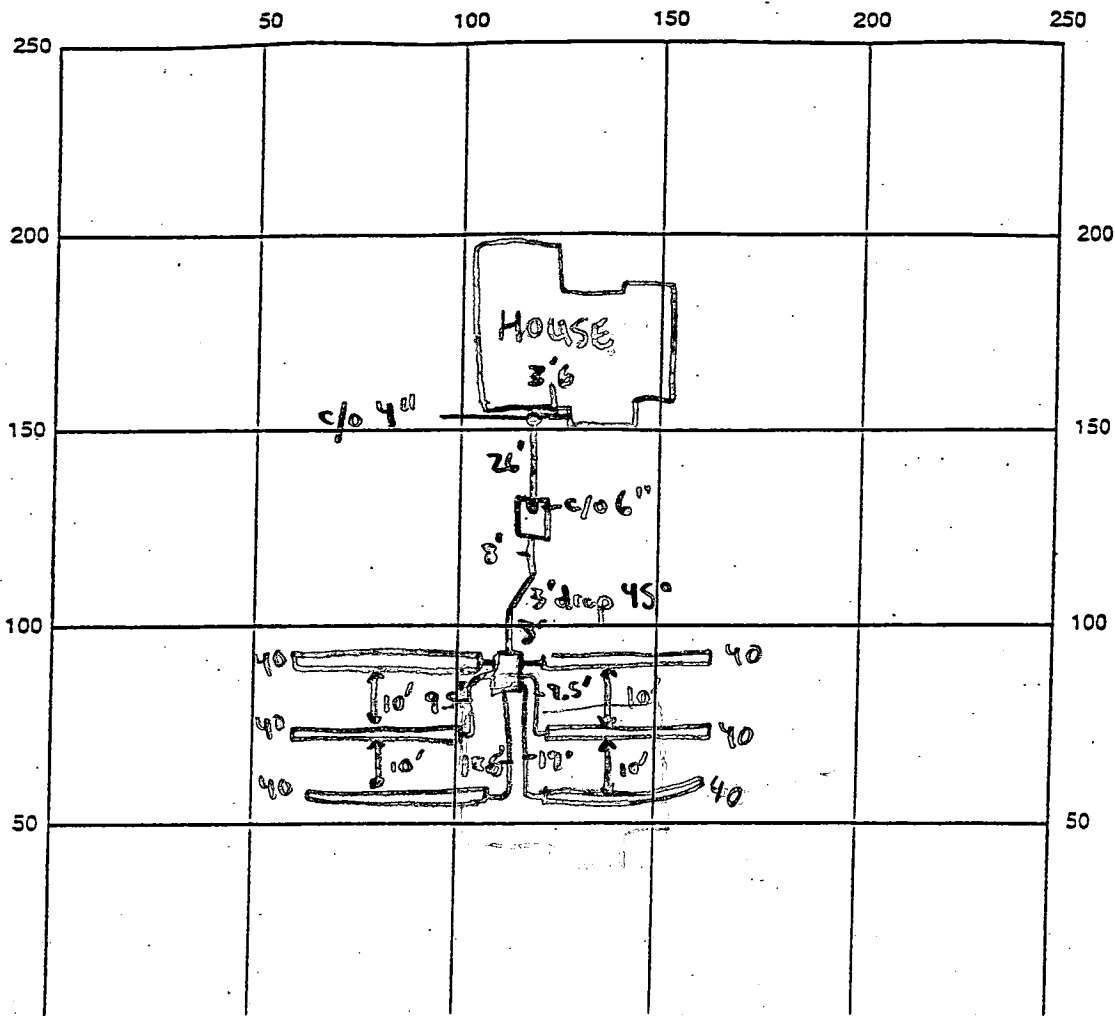

INDICATE NORTH - NAME ADJOINING ROADWAY AS BASE LINE

SYCAMORE SPRING COURT

SEPTIC TANK LEVEL 1250 midsection tank CLEANOUTS 4" cleanout @ house, 6" cleanout @ tank

DISTRIBUTION BOX LEVEL ✓ Baffle is in

DRAIN FIELD/TITLE DEPTH 5.5 FT. TRENCH WIDTH 3 FT. INLET DEPTH 3.5 FT.

EFFECTIVE GRAVEL DEPTH 2 FT. TOTAL LENGTH 240 FT.

NUMBER OF TRENCHES 6 ~~ONE SIDEWALL~~ BOTTOM AREA 720 SQ. FT.

DRYWALL INSIDE DIAMETER N/A FT. EFFECTIVE DEPTH BELOW INLET N/A FT.

ABSORBENT AREA N/A SQ. FT.

REMARKS: 5/19/99 - HOUSE CONNECTION MADE, OK TO COVER WORK - SRK

DATE SYSTEM APPROVED 5/19/99 INSPECTOR Steven R. Krueger

APPLICATION

PERCOLATION TESTING

HOWARD COUNTY HEALTH DEPARTMENT
BUREAU OF ENVIRONMENTAL HEALTH
P.O. BOX 476 ELLICOTT CITY, MARYLAND 21043
TELEPHONE 461-9933

DISTRICT

4th

DATE

9/30/94

A 50368-00 X

P _____

TO: THE COUNTY HEALTH OFFICER
ELLICOTT CITY, MARYLAND

I HEREBY APPLY FOR THE NECESSARY TEST IN ORDER TO CONSTRUCT (OR RECONSTRUCT) A SEWAGE DISPOSAL SYSTEM

PROPERTY OWNER

Amalia Riggs, c/o SDC Group, Inc. RYAN HOMES
8480 Baltimore - National Pk

ADDRESS

PO BOX 417, Ellicott City, MD 21041 PHONE (410) 465-6105

PROSPECTIVE BUYER

ADDRESS

PHONE

PROPERTY LOCATION:

SUBDIVISION

Riggs Property

LOT NO.

Grd. 1 27

ROAD AND DESCRIPTION

Located @ SW Corner of the intersection of
Roxbury Mill (Rte. 97) & Frederick Rd (Rte 144)

TAX MAP

8 & 14

PARCEL #

96

SIZE OF LOT

55000 ± S.F.

TYPE BLDG

BLDG. PERMIT SIGNED

AND RETURNED 10-8-98

Serial # 81014438

Single Family Dwelling 4Bm
(SINGLE FAMILY DWELLING OR COMMERCIAL)

THE SYSTEM INSTALLED UNDER THIS APPLICATION IS ACCEPTABLE ONLY UNTIL PUBLIC FACILITIES BECOME AVAILABLE. I FULLY UNDERSTAND THE

FEE CONNECTED WITH THE FILING OF THIS PERC TEST APPLICATION IS NON-REFUNDABLE UNDER ANY CIRCUMSTANCES. I ALSO AGREE TO COMPLY

WITH ALL M.O.S.H.A. REQUIREMENTS IN TESTING THIS LOT.

James R. Morley, III V. Pos

(SIGNATURE OF APPLICANT)

APPROVED BY

FOR

DATE

REJECTED BY

FOR

DATE

HOLD PENDING FURTHER TESTS

DATE

REASONS FOR REJECTION OR HOLDING

THIS IS NOT A PERMIT

COUNTY #

SOIL PROFILE

0' 506 483

bright
red
clm

3.5

lgt
orange
silm

8.0

lgt
tan
salm

11.5

474

bright
red
clay

4'

lgt
orange
tan silm

6

pocket of
50% rock

10

lgt
orange
tan
silm

11


484

brn
orange
clay
loam

3.5

orange
salm
20%
rock
frags

11

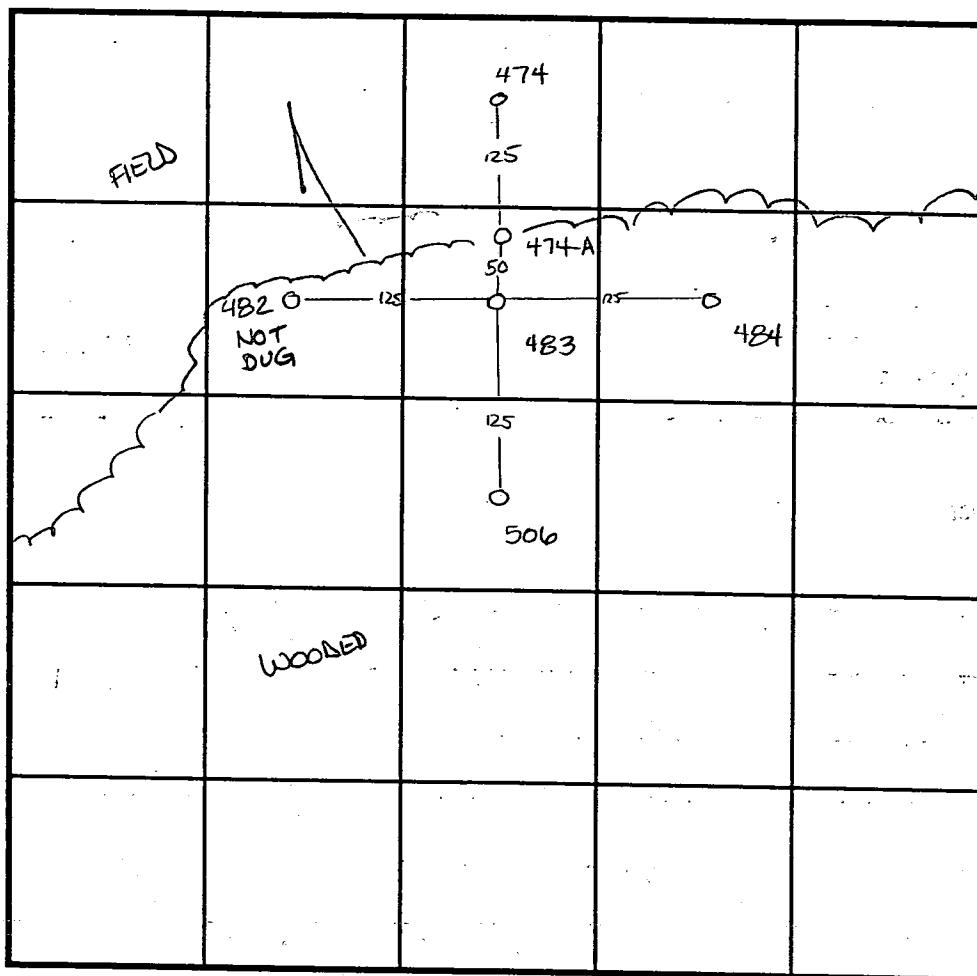

SOIL PROFILE

0'

INDICATE NORTH - NAME ADJOINING ROADWAY AS BASE LINE.

DATE	TEST NO.	DEPTH	PRE-WET		TEST - 1" DROP		TIME
			START	STOP	START	STOP	
11-10-94	506	5' VII.0	5:53	5:55 ³⁰	5:55 ³⁰	6:00	4 1/2 min
	483	4.0 VII.5	5:45 ⁴⁵	5:48	5:48	5:51 ³⁰	3 1/2 min
11-15-94	474	4' VII.0	8:06 ³⁰	8:11	8:11	8:18	7 min
11-10-94	484	3.5 VII	5:41 ³⁰	5:42	5:42	5:43 ³⁰	1 1/2 min

REMARKS

TYPE OF SOIL

TESTED BY

Amy McMiller

ALSO PRESENT


TRENCH DESIGN DATA: AVERAGE PERCOLATION TIME


TRENCH WIDTH

INLET DEPTH

MAXIMUM BOTTOM DEPTH

SQ. FT./BEDROOM

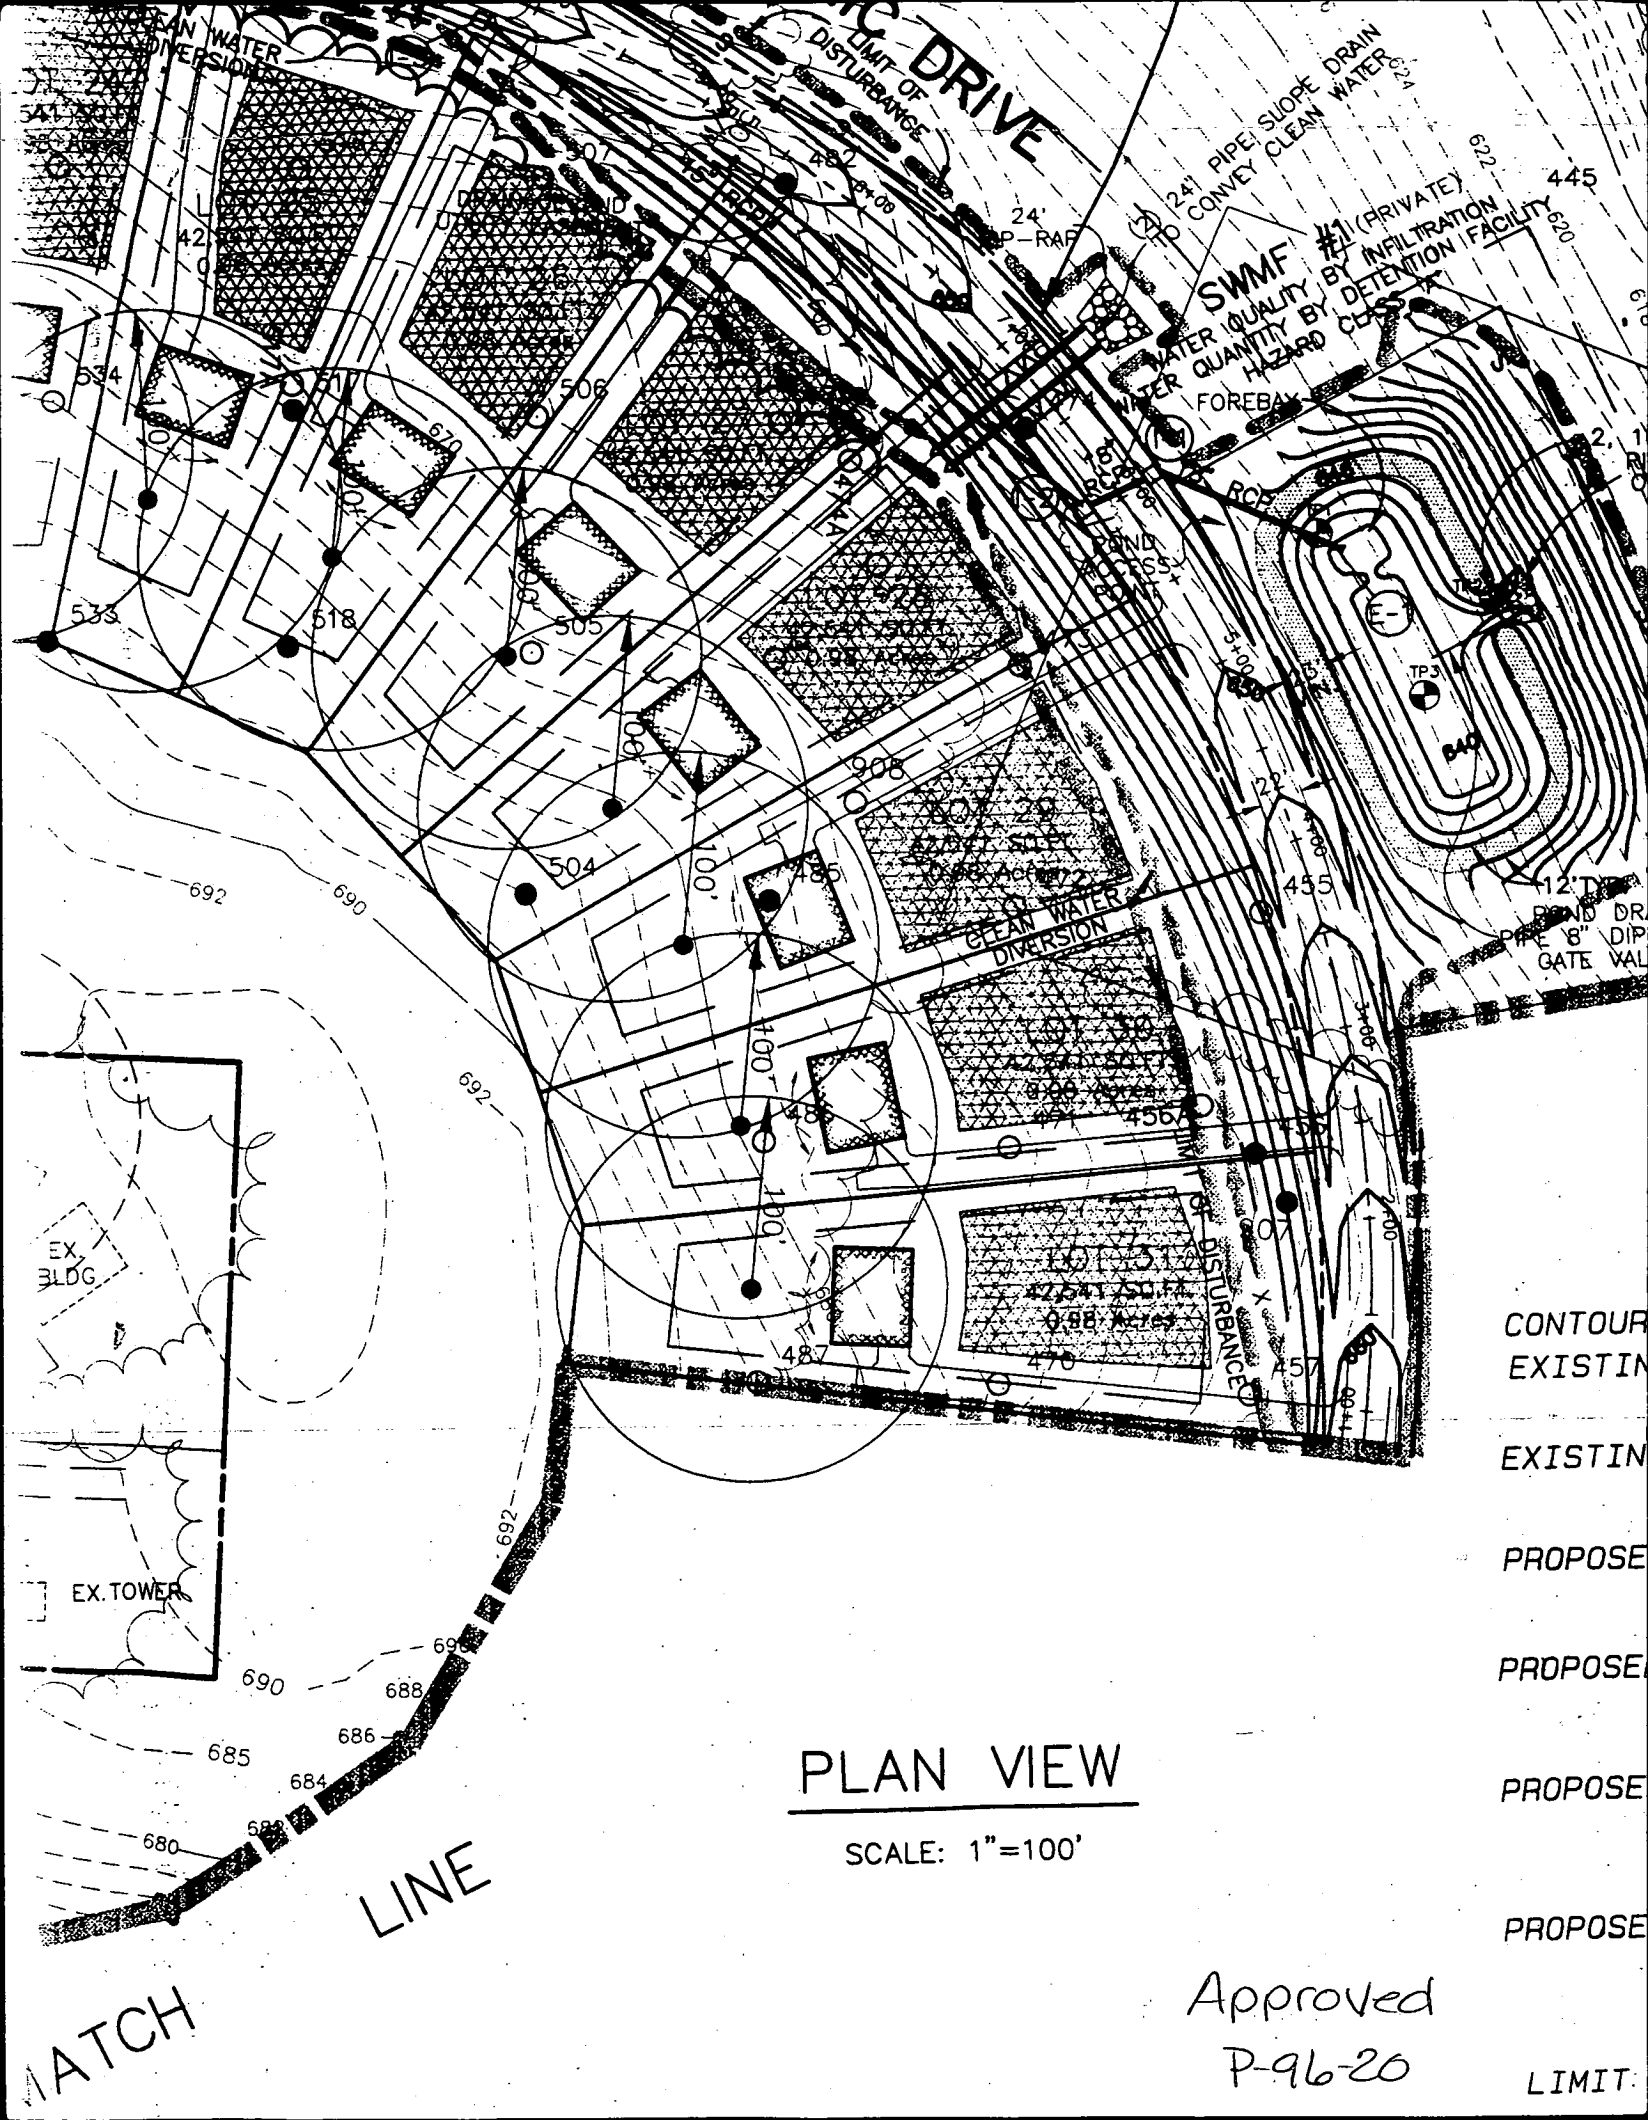

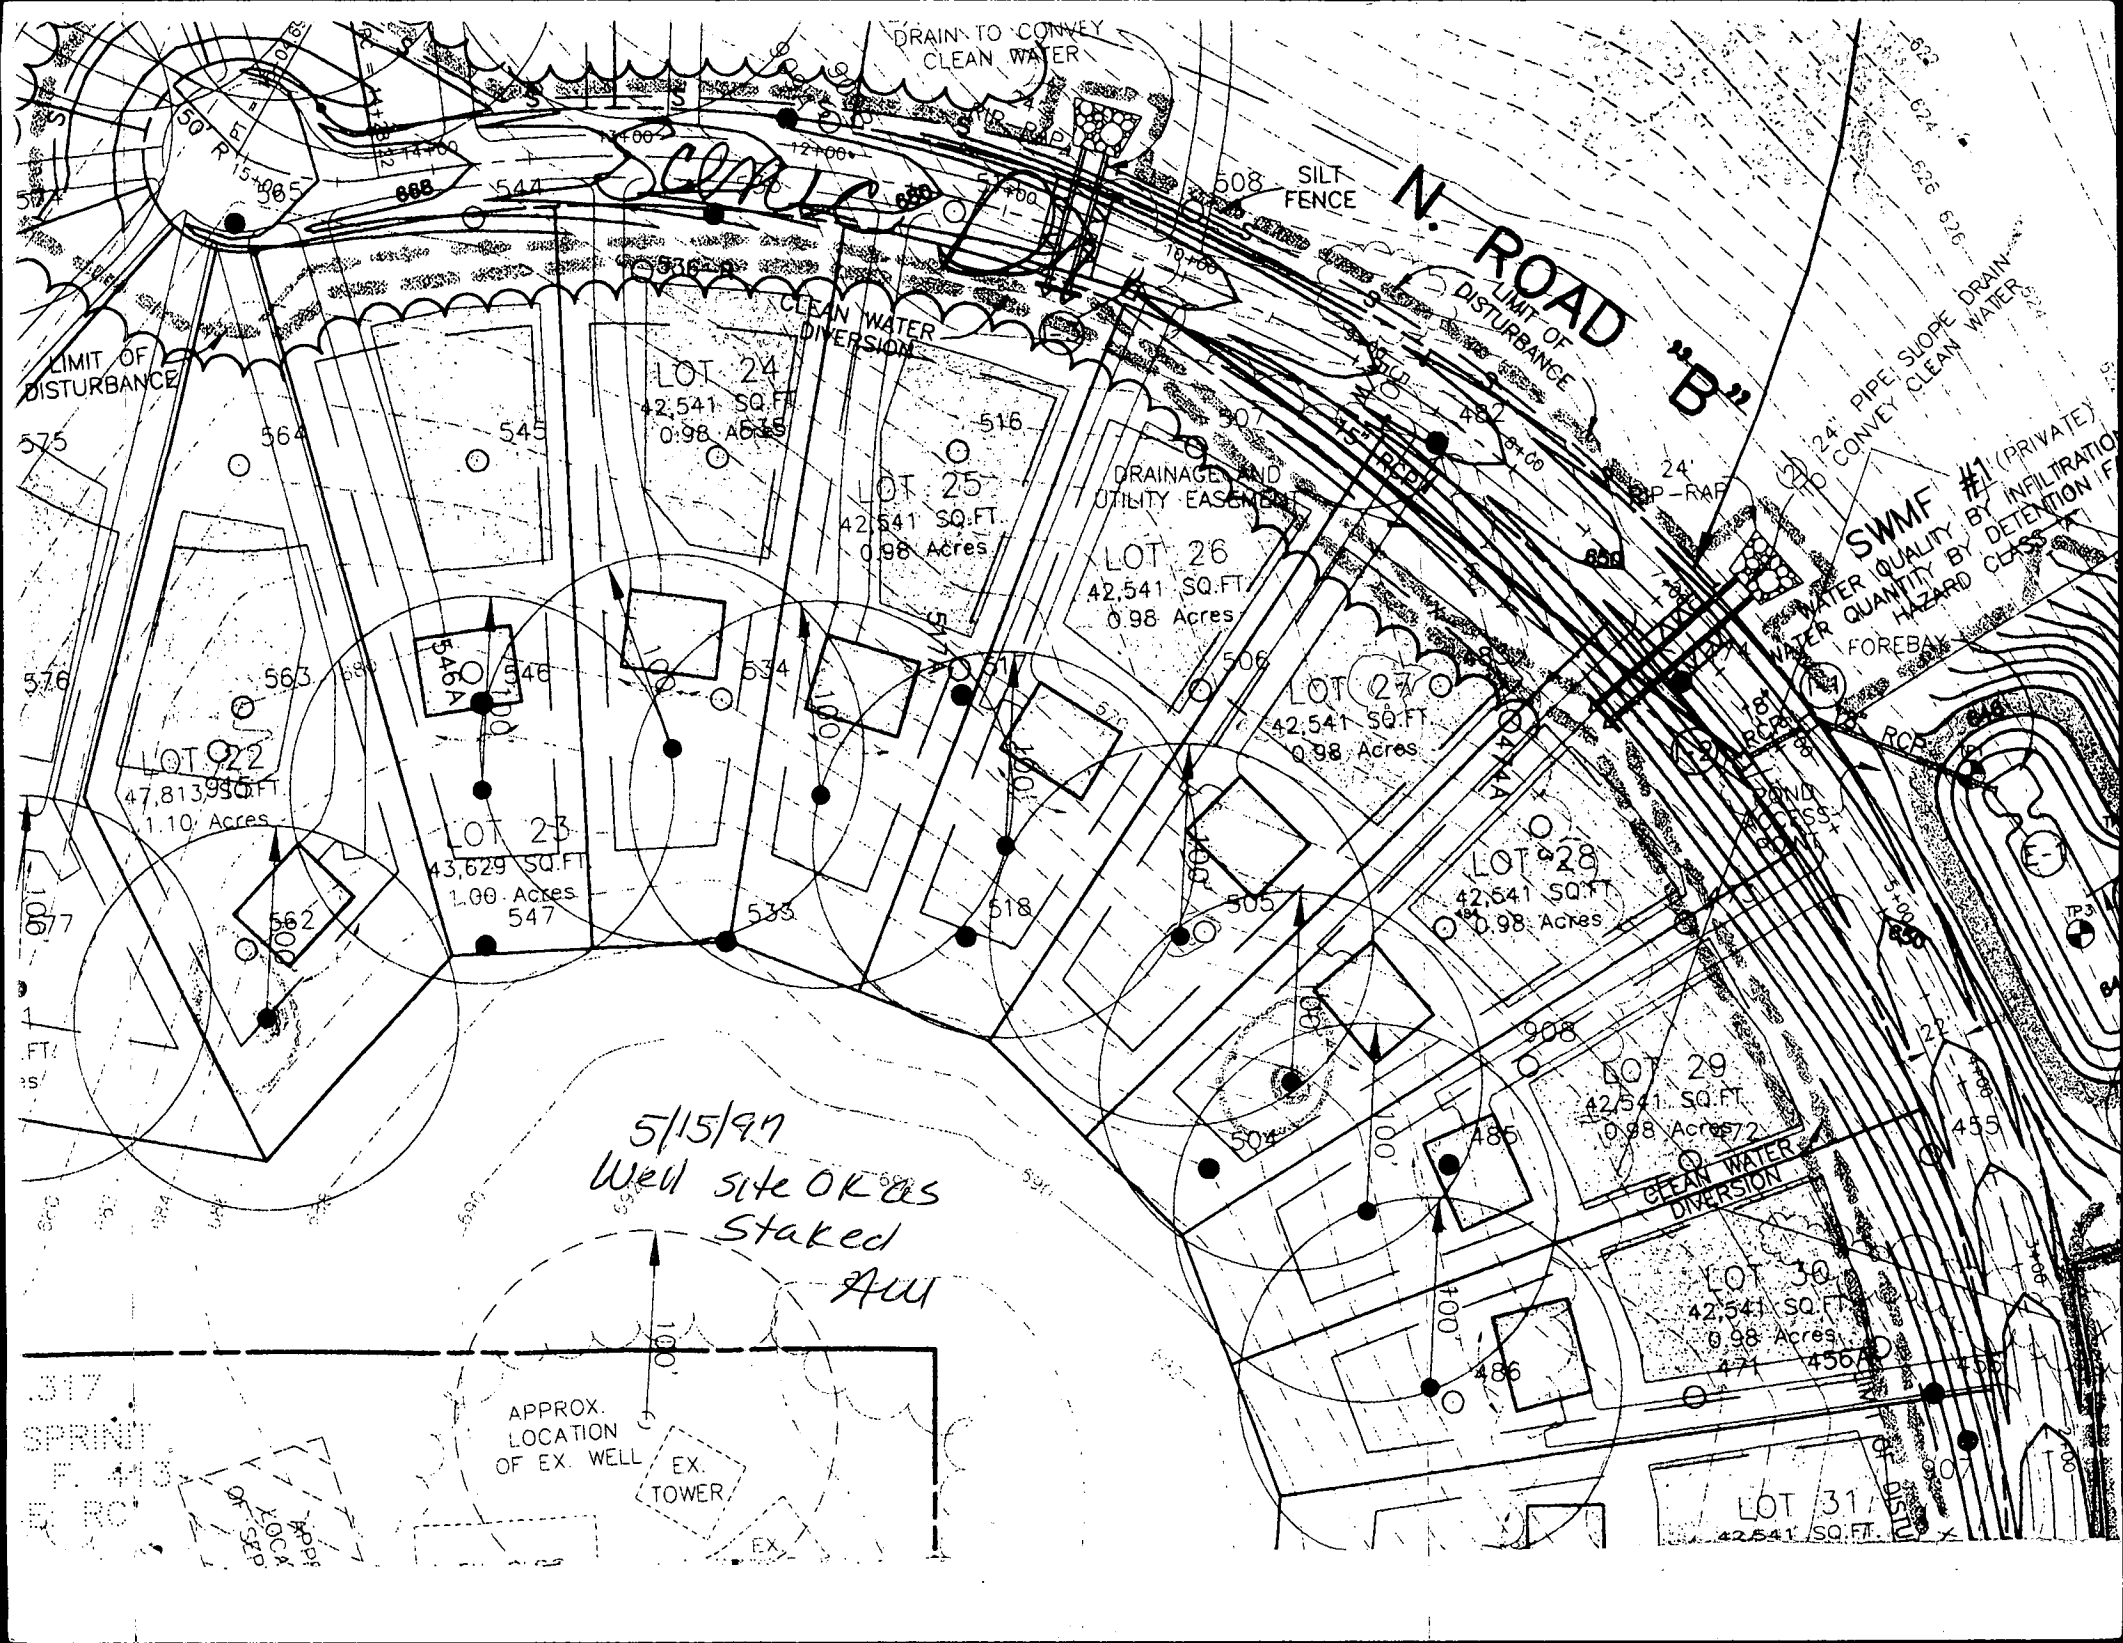

DRAIN TO CONVEY
CLEAN WATER

SILT
FENCE

N. ROAD
"B"

SWMF #1 (PRIVATE)
WATER QUALITY BY INFILTRATION
HAZARD CLASS
FOREBAY

24" PIPE SLOPE DRAIN
CONVEY CLEAN WATER

LOT 24
42,541 SQ. FT.
0.98 Acres

LOT 25
42,541 SQ. FT.
0.98 Acres

LOT 26
42,541 SQ. FT.
0.98 Acres

LOT 27
42,541 SQ. FT.
0.98 Acres

LOT 28
42,541 SQ. FT.
0.98 Acres

LOT 29
42,541 SQ. FT.
0.98 Acres


LOT 30
42,541 SQ. FT.
0.98 Acres

LOT 31
42,541 SQ. FT.
0.98 Acres

5/15/97
Well site OK as
Staked
AUU

APPROX.
LOCATION
OF EX. WELL
EX. TOWER

SPRINT
F. 413
OR GP
KOCX
TOP

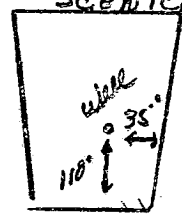C 1		9728		SEQUENCE NO. (MDE USE ONLY)		STATE OF MARYLAND WELL COMPLETION REPORT FILL IN THIS FORM COMPLETELY PLEASE PRINT OR TYPE		THIS REPORT MUST BE SUBMITTED WITHIN 45 DAYS AFTER WELL IS COMPLETED.			
1 2 3 4 5 6 (THIS NUMBER IS TO BE PUNCHED IN COLUMNS 3-6 ON ACL CARDS)								COUNTY NUMBER A50368			
ST/CO USE ONLY DATE RECEIVED MM DD YY 01/24/97		DATE WELL COMPLETED MM DD YY 06 11 97		Depth of Well 325 (TO NEAREST FOOT)				PERMIT NO. FROM "PERMIT TO DRILL WELL" HO - 94 - 1152			
8 13		15 20		22 26				28 29 30 31 32 33 34 35 36 37			
OWNER S D C STREET OR RFD Scenic DR. TOWN COOKSVILLE SUBDIVISION Riggs Property SECTION 27 LOT 27											
WELL LOG Not required for driven wells				GROUTING RECORD				C 3		PUMPING TEST	
STATE THE KIND OF FORMATIONS PENETRATED, THEIR COLOR, DEPTH, THICKNESS AND IF WATER BEARING				WELL HAS BEEN GROUTED (Circle Appropriate Box) Y N				1 2		HOURS PUMPED (nearest hour) 6	
DESCRIPTION (Use additional sheets if needed)				TYPE OF GROUTING MATERIAL (Circle one) CEMENT CM BENTONITE CLAY BC				PUMPING RATE (gal. per min.) 2		METHOD USED TO MEASURE PUMPING RATE Bucket	
Brown Shale 0 37 Gray Mica 37 325 Rock				NO. OF BAGS 11 NO. OF POUNDS 7034				WATER LEVEL (distance from land surface) BEFORE PUMPING 56 ft. WHEN PUMPING 270 ft. TYPE OF PUMP USED (for test) A air P piston T turbine C centrifugal R rotary O other (describe below) J jet S submersible			
				GALLONS OF WATER 66							
				DEPTH OF GROUT SEAL (to nearest foot) from 0 TOP 52 ft. to 37 BOTTOM 58 ft. (enter 0 if from surface)							
				Casing types insert appropriate code below ST STEEL CO CONCRETE PL PLASTIC OT OTHER							
MAIN CASING TYPE ST Nominal diameter top (main) casing (nearest inch) 6 Total depth of main casing (nearest foot) 41				OTHER CASING (if used) diameter inch depth (feet) from to				PUMP INSTALLED DRILLER WILL INSTALL PUMP (CIRCLE) (YES or NO) NO IF DRILLER INSTALLS PUMP, THIS SECTION MUST BE COMPLETED FOR ALL WELLS. TYPE OF PUMP INSTALLED PLACE (A,C,J,P,R,S,T,O) IN BOX 29. CAPACITY: GALLONS PER MINUTE (to nearest gallon) 31 35 PUMP HORSE POWER 37 41 PUMP COLUMN LENGTH (nearest ft.) 43 47 CASING HEIGHT (circle appropriate box and enter casing height) + above - below 2 (nearest foot)			
SCREEN RECORD screen type or open hole (insert appropriate code below) ST STEEL BR BRASS HO OPEN HOLE PL PLASTIC OT OTHER											
DEPTH (nearest ft.) HO 39 325											
SLOT SIZE 1 2 3											
Diameter of screen (nearest inch) 56 60				LOCATION OF WELL ON LOT SHOW PERMANENT STRUCTURE SUCH AS BUILDING, SEPTIC TANKS, AND /OR LANDMARKS AND INDICATE NOT LESS THAN TWO DISTANCES (MEASUREMENTS TO WELL) Scenic DR. 							
GRAVEL PACK IF WELL DRILLED WAS FLOWING WELL INSERT F IN BOX 68											
MDE USE ONLY (NOT TO BE FILLED IN BY DRILLER) T (E.R.O.S.) W Q											
70 72 74 75 76 TELESCOPE Casing LOG INDICATOR OTHER DATA											
NUMBER OF UNSUCCESSFUL WELLS: 0				COUNTY							
WELL HYDROFRACTURED Y N											
CIRCLE APPROPRIATE LETTER A A WELL WAS ABANDONED AND SEALED WHEN THIS WELL WAS COMPLETED E ELECTRIC LOG OBTAINED P TEST WELL CONVERTED TO PRODUCTION WELL											
I HEREBY CERTIFY THAT THIS WELL HAS BEEN CONSTRUCTED IN ACCORDANCE WITH COMAR 26.04.04 "WELL CONSTRUCTION" AND IN CONFORMANCE WITH ALL CONDITIONS STATED IN THE ABOVE CAPTIONED PERMIT, AND THAT THE INFORMATION PRESENTED HEREIN IS ACCURATE AND COMPLETE TO THE BEST OF MY KNOWLEDGE.											
DRILLERS LIC. NO. MS DO 24 Joseph L. Mayne DRILLERS SIGNATURE (MUST MATCH SIGNATURE ON APPLICATION) LIC. NO. M D											
SITE SUPERVISOR (sign. of driller or journeyman responsible for sitework if different from permittee)											

B 1 7464		SEQUENCE NO. (MDE USE ONLY)		STATE OF MARYLAND PERMIT TO DRILL WELL please print or type		STATE PERMIT NUMBER <div style="border: 1px solid black; padding: 2px; display: inline-block;">H0-94-1152</div> <small>70 fill in this form completely 79</small>	
Date Received (APA) <div style="border: 1px solid black; padding: 2px; display: inline-block;">033197</div> OWNER INFORMATION <div style="border: 1px solid black; padding: 2px; display: inline-block;">Soc</div> <div style="border: 1px solid black; padding: 2px; display: inline-block;">15 Last Name</div> <div style="border: 1px solid black; padding: 2px; display: inline-block;">Owner</div> <div style="border: 1px solid black; padding: 2px; display: inline-block;">First Name</div> <div style="border: 1px solid black; padding: 2px; display: inline-block;">36</div> <div style="border: 1px solid black; padding: 2px; display: inline-block;">417</div> <div style="border: 1px solid black; padding: 2px; display: inline-block;">55</div> <div style="border: 1px solid black; padding: 2px; display: inline-block;">70 State 72</div> <div style="border: 1px solid black; padding: 2px; display: inline-block;">Zip</div> <div style="border: 1px solid black; padding: 2px; display: inline-block;">76</div> <div style="border: 1px solid black; padding: 2px; display: inline-block;">ELLICOTT CITY MD 21041</div>				B 3 LOCATION OF WELL <div style="border: 1px solid black; padding: 2px; display: inline-block;">8 COUNTY</div> <div style="border: 1px solid black; padding: 2px; display: inline-block;">21</div> <div style="border: 1px solid black; padding: 2px; display: inline-block;">RIGGS PROPERTY</div> <div style="border: 1px solid black; padding: 2px; display: inline-block;">42</div> <div style="border: 1px solid black; padding: 2px; display: inline-block;">23 SUBDIVISION</div> <div style="border: 1px solid black; padding: 2px; display: inline-block;">LOT</div> <div style="border: 1px solid black; padding: 2px; display: inline-block;">27</div> <div style="border: 1px solid black; padding: 2px; display: inline-block;">44</div> <div style="border: 1px solid black; padding: 2px; display: inline-block;">46</div> <div style="border: 1px solid black; padding: 2px; display: inline-block;">48</div> <div style="border: 1px solid black; padding: DRILLER INFORMATION CIRCLE: MSD/MGD/MWD <div style="border: 1px solid black; padding: 2px; display: inline-block;">Joseph L. Mayne</div> <div style="border: 1px solid black; padding: 2px; display: inline-block;">024</div> Driller's Name <div style="border: 1px solid black; padding: 2px; display: inline-block;">77 License No. 80</div> Firm Name <div style="border: 1px solid black; padding: 2px; display: inline-block;">Joseph L. Mayne Well Drilling</div> Address <div style="border: 1px solid black; padding: 2px; display: inline-block;">5512 Ridge Rd. Mt. Airy Md. 21771</div> Signature <div style="border: 1px solid black; padding: 2px; display: inline-block;">Joseph L. Mayne</div> Date <div style="border: 1px solid black; padding: 2px; display: inline-block;">3/3/97</div>				B 4 <div style="border: 1px solid black; padding: 2px; display: inline-block;">11</div> <div style="border: 1px solid black; padding: 2px; display: inline-block;">30</div> DIRECTION OF WELL FROM TOWN (CIRCLE BOX) <div style="text-align: center;"><div style="display: flex; justify-content: space-around;"><div>N 8-9</div><div>N 8</div><div>N 8-9</div></div><div style="display: flex; justify-content: space-around;"><div>W 8-9</div><div>TOWN</div><div>E 8</div></div><div style="display: flex; justify-content: space-around;"><div>S 8-9</div><div>S 8</div><div>S 8-9</div></div></div> NEAR WHAT ROAD <div style="border: 1px solid black; padding: 2px; display: inline-block;">Scenic Dr.</div> ON WHICH SIDE OF ROAD (CIRCLE APPROPRIATE BOX) <div style="display: flex; justify-content: space-around;"><div>WEST</div><div style="border: 1px solid black; padding: 2px; display: inline-block;">200</div><div>EAST</div></div> DISTANCE FROM ROAD ENTER FT OR MI <div style="border: 1px solid black; padding: 2px; display: inline-block;">FT</div> TAX MAP: _____ BLK: _____ PARCEL: _____			
B 2 WELL INFORMATION APPROX. PUMPING RATE (GAL. PER MIN.) <div style="border: 1px solid black; padding: 2px; display: inline-block;">5</div> <div style="border: 1px solid black; padding: 2px; display: inline-block;">8</div> <div style="border: 1px solid black; padding: 2px; display: inline-block;">12</div> AVERAGE DAILY QUANTITY NEEDED (GAL. PER DAY) <div style="border: 1px solid black; padding: 2px; display: inline-block;">500</div> <div style="border: 1px solid black; padding: 2px; display: inline-block;">14</div> <div style="border: 1px solid black; padding: 2px; display: inline-block;">20</div> USE FOR WATER (CIRCLE APPROPRIATE BOX) <div style="border: 1px solid black; padding: 2px; display: inline-block;">D</div> HOME (SINGLE OR DOUBLE HOUSEHOLD UNIT ONLY) <div style="border: 1px solid black; padding: 2px; display: inline-block;">F</div> FARMING (LIVESTOCK WATERING & AGRICULTURAL IRRIGATION) <div style="border: 1px solid black; padding: 2px; display: inline-block;">I</div> INDUSTRIAL, COMMERCIAL, STATE AND FEDERAL GOV. OTHER (REQUIRES APPROPRIATION PERMIT) <div style="border: 1px solid black; padding: 2px; display: inline-block;">P</div> PUBLIC OR PRIVATE WATER COMPANY (REQUIRES APPROPRIATION PERMIT AND STATE HEALTH DEPARTMENT APPROVAL) <div style="border: 1px solid black; padding: 2px; display: inline-block;">T</div> TEST, OBSERVATION, MONITORING (MAY REQUIRE APPROPRIATION PERMIT)				NOT TO BE FILLED IN BY DRILLER HEALTH DEPARTMENT APPROVAL <div style="border: 1px solid black; padding: 2px; display: inline-block;">Howard Co.</div> <div style="border: 1px solid black; padding: 2px; display: inline-block;">A50368</div> COUNTY NAME <div style="border: 1px solid black; padding: 2px; display: inline-block;">COUNTY NO.</div> STATE SIGNATURE _____ INSERT S <div style="border: 1px solid black; padding: 2px; display: inline-block;">41</div> DATE ISSUED <div style="border: 1px solid black; padding: 2px; display: inline-block;">05/15/97</div> <div style="border: 1px solid black; padding: 2px; display: inline-block;">A McMiller</div> <div style="border: 1px solid black; padding: 2px; display: inline-block;">5/15/98</div> 43 CO SIGNATURE <div style="border: 1px solid black; padding: 2px; display: inline-block;">540000</div> <div style="border: 1px solid black; padding: 2px; display: inline-block;">55</div> <div style="border: 1px solid black; padding: 2px; display: inline-block;">57</div> <div style="border: 1px solid black; padding: 2px; display: inline-block;">63</div> NORTH GRID <div style="border: 1px solid black; padding: 2px; display: inline-block;">540000</div> EAST GRID <div style="border: 1px solid black; padding: 2px; display: inline-block;">0792000</div>			
APPROXIMATE DEPTH OF WELL <div style="border: 1px solid black; padding: 2px; display: inline-block;">260</div> <div style="border: 1px solid black; padding: 2px; display: inline-block;">24</div> <div style="border: 1px solid black; padding: 2px; display: inline-block;">28</div> FEET APPROXIMATE DIAMETER OF WELL <div style="border: 1px solid black; padding: 2px; display: inline-block;">6</div> NEAREST INCH. METHOD OF DRILLING (circle one) <div style="border: 1px solid black; padding: 2px; display: inline-block;">BORED (or Augered)</div> <div style="border: 1px solid black; padding: 2px; display: inline-block;">JETTED</div> <div style="border: 1px solid black; padding: 2px; display: inline-block;">Jetted & DRIVEN</div> <div style="border: 1px solid black; padding: 2px; display: inline-block;">AIR-ROTARY</div> <div style="border: 1px solid black; padding: 2px; display: inline-block;">AIR-PERCussion</div> <div style="border: 1px solid black; padding: 2px; display: inline-block;">ROTARY (Hydraulic Rotary)</div> <div style="border: 1px solid black; padding: 2px; display: inline-block;">CABLE</div> <div style="border: 1px solid black; padding: 2px; display: inline-block;">REVERSE-ROTARY</div> <div style="border: 1px solid black; padding: 2px; display: inline-block;">DRIVE-POINT</div> other _____				SHOW MAJOR FEATURES OF BOX & LOCATE WELL WITH AN X SOURCES OF DRILLING WATER 1. Well 2. 3. WRITE THE BOX NUMBER FROM THE MAP HERE <div style="border: 1px solid black; padding: 2px; display: inline-block;">7902</div> DRAW A SKETCH BELOW SHOWING LOCATION OF WELL IN RELATION TO NEARBY TOWNS AND ROADS AND GIVE DISTANCE FROM WELL TO NEAREST ROAD JUNCTION <div style="text-align: center;">N ↑</div> <div style="text-align: center;">Scenic Dr. x well</div> <div style="text-align: center;">Cooksville</div> <div style="text-align: center;">MEADOW TREE OF SYCAMORE SPRING</div> <div style="text-align: center;">MO 97</div>			
REPLACEMENT OR DEEPEENED WELLS (CIRCLE APPROPRIATE BOX) <div style="border: 1px solid black; padding: 2px; display: inline-block;">N</div> THIS WELL WILL NOT REPLACE AN EXISTING WELL <div style="border: 1px solid black; padding: 2px; display: inline-block;">Y</div> THIS WELL WILL REPLACE A WELL THAT WILL BE ABANDONED AND SEALED <div style="border: 1px solid black; padding: 2px; display: inline-block;">S</div> THIS WELL WILL REPLACE A WELL THAT WILL BE USED AS A STANDBY-CONTACT LOCAL APPROVING AUTHORITY FOR POLICY ON STANDBY WELLS <div style="border: 1px solid black; padding: 2px; display: inline-block;">D</div> THIS WELL WILL DEEPEEN AN EXISTING WELL PERMIT NUMBER OF WELL TO BE REPLACED OR DEEPEENED (IF AVAILABLE) <div style="border: 1px solid black; padding: 2px; display: inline-block;">41</div> <div style="border: 1px solid black; padding: 2px; display: inline-block;">52</div>				Not to be filled in by driller (MDE OR COUNTY USE ONLY) APPROX. PERMIT NUMBER <div style="border: 1px solid black; padding: 2px; display: inline-block;">54</div> <div style="border: 1px solid black; padding: 2px; display: inline-block;">63</div> FORCE <div style="border: 1px solid black; padding: 2px; display: inline-block;">AM</div> WRITE INITIALS IN BOX <div style="border: 1px solid black; padding: 2px; display: inline-block;">70</div> <div style="border: 1px solid black; padding: 2px; display: inline-block;">71</div> <div style="border: 1px solid black; padding: 2px; display: inline-block;">72</div> <div style="border: 1px solid black; padding: 2px; display: inline-block;">73</div> <div style="border: 1px solid black; padding: 2px; display: inline-block;">74</div> <div style="border: 1px solid black; padding: 2px; display: inline-block;">75</div> <div style="border: 1px solid black; padding: 2px; display: inline-block;">76</div> <div style="border: 1px solid black; padding: 2px; display: inline-block;">77</div> <div style="border: 1px solid black; padding: 2px; display: inline-block;">78</div> <div style="border: 1px solid black; padding: 2px; display: inline-block;">79</div> PERMIT No. <div style="border: 1px solid black; padding: 2px; display: inline-block;">H0-94-1152</div>			
SPECIAL CONDITIONS NOTE - APPROVING AUTHORITIES SHOULD USE SEPARATE SHEET, IF NEEDED							