

PERMIT

SEWAGE DISPOSAL SYSTEM

DEPARTMENT OF HEALTH AND MENTAL HYGIENE

P 5110310

A 50388-J

DISTRICT 4th

DATE 10-8-98

DATE SYSTEM APPROVED 12-3-98

INSPECTOR *[Signature]*

HOWARD COUNTY HEALTH DEPARTMENT

BUREAU OF ENVIRONMENTAL HEALTH

~~XXXXXX~~ 410-313-2640

INDEXED

360842

Olen Ketterman

IS PERMITTED TO INSTALL ☒ ALTER ☐

ADDRESS 14960 Rt. 144 Woodbine, MD 21797 PHONE (410) 442-1336

SUBDIVISION Ridge View Hunt LOT 14 ROAD 15262 Ridge Hunt Drive

PROPERTY OWNER Selfridge Builders *JOE & PATTY MUNKWARD*

ADDRESS

SEPTIC TANK CAPACITY 1500 GALLONS

NUMBER OF BEDROOMS 5

180 SQUARE FEET PER BEDROOM

LINEAR FEET OF TRENCH REQUIRED 300

TRENCHES - Trench to be 3 feet wide. Inlet 3.0 feet below original grade. Bottom maximum depth 5.0 feet below original grade. Effective area begins at 4.0 feet below original grade. 2.0 feet of stone below distribution pipe.

LOCATION - Begin trenches 245 feet down the left (337.25') and 70 feet off that same lot line as seen when facing the lot from Ridge Hunt Drive. Run trenches on contour toward the left (337.25') lot line.

NOTES - No trench to exceed 100 feet in length. Provide 6" - 8" diameter cleanout and cap to grade or above on septic tank.

PLANS APPROVED BY Amy McMillen DATE 8-25-98

COVER NO WORK UNTIL INSPECTED AND APPROVED

NEITHER THE HOWARD COUNTY COUNCIL NOR THE HEALTH DEPARTMENT IS RESPONSIBLE FOR THE SUCCESSFUL OPERATION OF ANY SYSTEM

NOTE: CLEANOUT REQUIRED EVERY 70 FEET OF SEWER LINE AND/OR AT 90° SWEEPS IN LINES FROM HOUSE TO DRAIN FIELDS, 90° ELBOWS NOT ACCEPTABLE.

NOTE: ALL PARTS OF SEPTIC SYSTEMS (I.E. TANK, DISTRIBUTION BOX TRENCHES) TO BE 100 FEET FROM WELL (UNLESS OTHERWISE SPECIFICALLY AUTHORIZED)

NOTE: IF DEEP TRENCH(ES) ARE USED CALL FOR INSPECTION BEFORE AND AFTER PLACING GRAVEL IN TRENCH(ES)

NOTE: NO DRY WELL SHALL EXCEED 15 FOOT IN DIAMETER NO ABSORPTION TRENCH TO EXCEED 100 FEET IN LENGTH

NOTE: ALL PIPE FROM HOUSE TO SEPTIC TANK MUST BE CAST IRON OR SCHEDULE 35/40 PVC OR ABS

PERMIT VOID AFTER TWO YEARS

NOTE: INSTALL STAND PIPE ON SEPTIC TANK AND DRY WELL STAND PIPES MUST BE 6 INCHES IN DIAMETER CAST IRON, CONCRETE OR TERRA COTTA OR PVA OR ABS ACCEPTED. IF TOP OF SEPTIC TANK IS DEEPER THAN 3 FEET, MANHOLE TO GRADE REQUIRED.

NOTE: DISTRIBUTION BOXES MUST HAVE BAFFLES

*INSTALLER IS RESPONSIBLE FOR OBTAINING FINAL APPROVAL ON THIS PERMIT

*CALL 461-9933 FOR INSPECTION OF SEPTIC SYSTEM.


LOG. PERMIT SIGNED

AND RETURNED 4-16-99

Serial # 250117104

Rich

P-880000

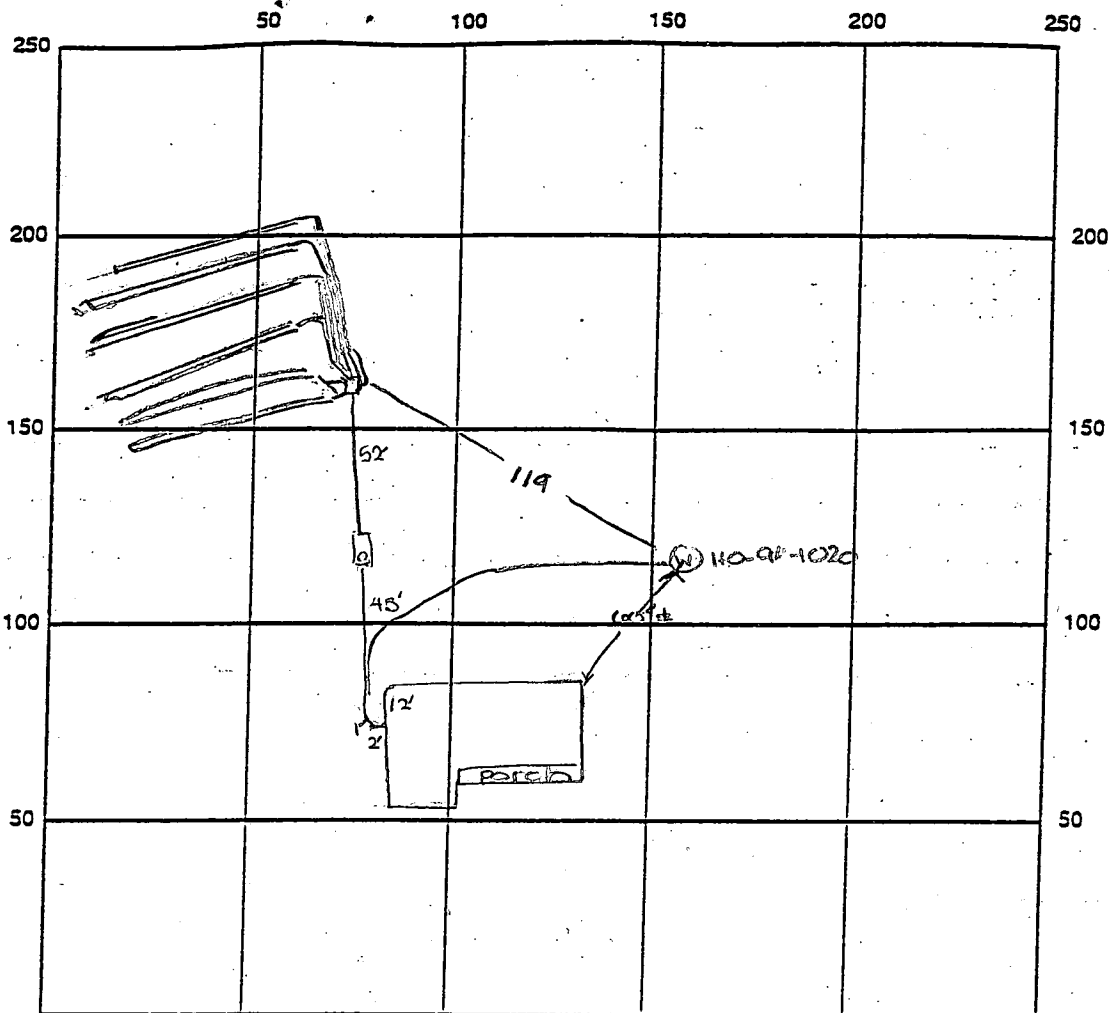

INDICATE NORTH - NAME ADJOINING ROADWAY AS BASE LINE

Ridge Hunt Drive

SEPTIC TANK LEVEL OK - 1500 gal CLEANOUTS one on s.t.

DISTRIBUTION BOX LEVEL OK

DRAIN FIELD/TITLE DEPTH 5 FT. TRENCH WIDTH 3 FT. INLET DEPTH 3 FT.

EFFECTIVE GRAVEL DEPTH 2 FT. TOTAL LENGTH 571/4 FT. 5/6 = 300

NUMBER OF TRENCHES 6 ONE SIDEWALL/BOTTOM AREA 900 SQ. FT.

DRYWALL INSIDE DIAMETER FT. EFFECTIVE DEPTH BELOW INLET FT.

ABSORBENT AREA SQ. FT.

REMARKS: 12/1/98 OK to cover from house to dist. box and
continue. DKS

12-3-98 5 TRENCHES COMPLETED. FINAL TRENCH BEING DONE CORAL WORK WHEN COMPLETED

DATE SYSTEM APPROVED 12/3/98

INSPECTOR [Signature]

1
46
48
52
59
196
57
253
360
253
97

APPLICATION

PERCOLATION TESTING

A 50388.T

P _____

HOWARD COUNTY HEALTH DEPARTMENT

BUREAU OF ENVIRONMENTAL HEALTH

3525-H ELLICOTT MILLS DRIVE/ELLICOTT CITY, MARYLAND 21043
TELEPHONE: 313-2640

DISTRICT _____

DATE 11/10/94

TO: THE COUNTY HEALTH OFFICER
ELLICOTT CITY, MARYLAND

I HEREBY APPLY FOR THE NECESSARY TEST PRIOR TO APPLICATION FOR PERMIT TO CONSTRUCT (OR RECONSTRUCT) A SEWAGE DISPOSAL SYSTEM.

PROPERTY OWNER Richard Hoenes Selfridge Builders

ADDRESS 8668 Baltimore National Pike
Ellicott City, Maryland 21043 PHONE (410) 465-2321

AGENT OR PROSPECTIVE BUYER Same

ADDRESS _____ PHONE _____

PROPERTY LOCATION:

SUBDIVISION White Property LOT NO. 1015

ROAD AND DESCRIPTION 15262 Ridge Hunt Drive
South side 15000 block of Carrs Mill Road; 1 mile +/- west
of Roxbury Mills Road intersection.

TAX MAP 14 PARCEL # 14

SIZE OF LOT 60,000 SF TYPE BLDG. Single Family - 5Bum
(SINGLE FAMILY DWELLING OR COMMERCIAL)

BLDG. PERMIT SIGNED

AND RETURNED 8-25-98
Serial # B00713578

THE SYSTEM INSTALLED UNDER THIS APPLICATION IS ACCEPTABLE ONLY UNTIL PUBLIC FACILITIES BECOME AVAILABLE. I FULLY UNDERSTAND THE
FEE CONNECTED WITH THE FILING OF THIS PERC TEST APPLICATION IS NON-REFUNDABLE UNDER ANY CIRCUMSTANCES. I ALSO AGREE TO
COMPLY WITH ALL M.O.S.H.A. REQUIREMENTS IN TESTING THIS LOT. Richard Hoenes
(SIGNATURE OF APPLICANT)

APPROVED BY _____ FOR _____ DATE _____

DISAPPROVED BY _____ FOR _____ DATE _____

HOLD PENDING FURTHER TESTS _____

REASONS FOR REJECTION OR HOLDING _____

PERCOLATION TEST PLAT/PRELIMINARY PLAT - TITLE OR I.D. # _____ DATE _____

SITE DEVELOPMENT PLAN/FINAL PLAT - TITLE OR I.D. # _____ DATE _____

THIS IS NOT A PERMIT

50388J

COUNTY#

SOIL PROFILE

0' 1143 1141
orange
brn
CL

3' orange
and
tan
mix
SCL

5' orange
brn
SIL
50%
saprolite
pockets

11.5'

1257

red
brn
CL

3' tan
SIL w/
reddish
tint


8' lgt tan
w/
greenish
tint

1256

4' tan c
w/ grey
mottles

greyish
tan
SIL
50%
shale

7.5' greyish
tan
SIL
mottled
10% shale

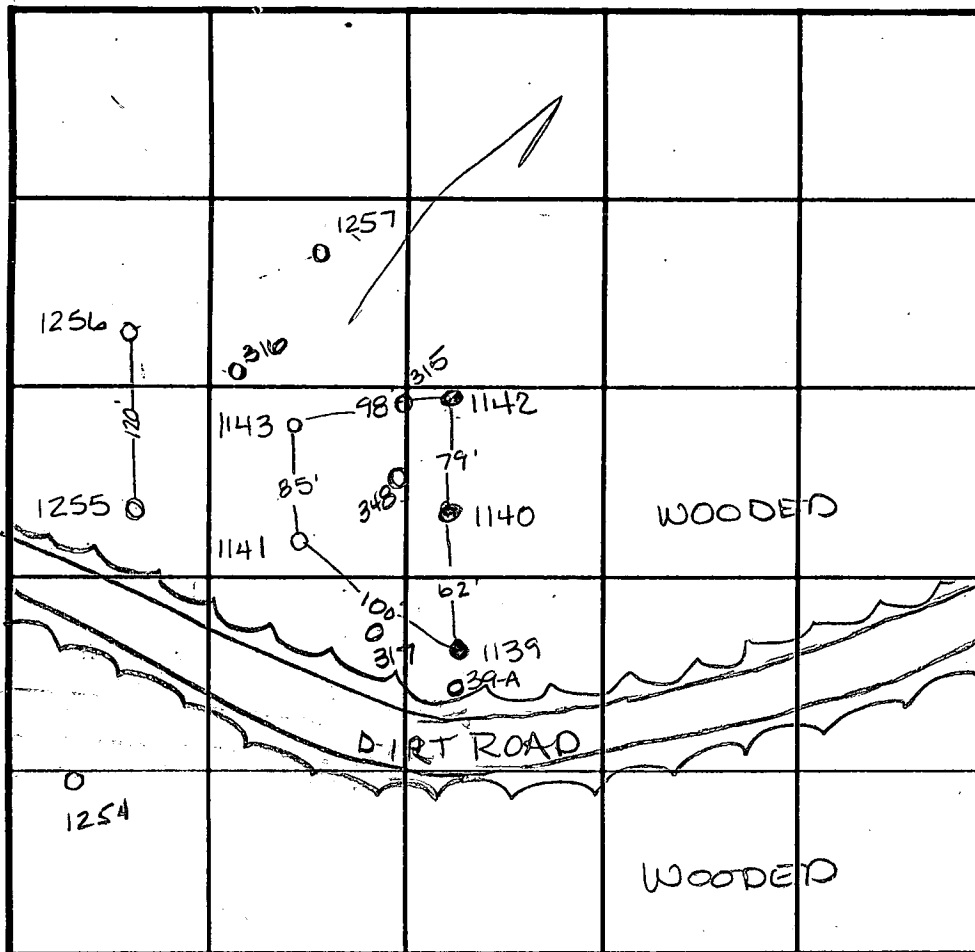

INDICATE NORTH - NAME ADJOINING ROADWAY AS BASE LINE.

SOIL PROFILE

0' 1258
yellow
tan
SCL

4' orange
brn
SL

8' greenish
tan
SL

12' 1254
bright orange
CSL w/
lgt yellow
tan spots

4' lgt brn
SIL
white SL
patches

11'

DATE	TEST NO.	DEPTH	PRE-WET		TEST - 1" DROP		TIME
			START	STOP	START	STOP	
12-16-94	1141	4' VII.5	5:42 ³⁰	5:44	5:44	5:46 ³⁰	2 1/2 min
	1139	Hard bottom	4.5'				F
	1143	4.5' VII.2	5:52 ⁴⁵	>30 min			Slow
	1142	Hard bottom	8'	>50%			F
	1140	Hard bottom	5.5'				F
	1143	6' VII.2	10:15 ¹⁵	10:16 ¹⁵	10:16 ¹⁵	10:20 ³⁰	4 1/4 min
12-22-94	1257	5.5' VII.5	6:00 ⁴⁵	6:02 ¹⁵	6:02 ¹⁵	6:05 ¹⁵	2 3/4 min
	1256	4' VII.2	6:06 ³⁰	6:09 ¹⁵	6:09 ¹⁵	6:12 ¹⁵	3 1/4 min
	1255	4.5' VII.2	6:15 ¹⁵	6:16 ¹⁵	6:16 ¹⁵	6:18 ³⁰	2 1/2 min
	1254	4.5' VII.1	6:19 ⁴⁵	6:20 ¹⁵	6:20 ¹⁵	6:21 ⁴⁵	1 1/2 min

REMARKS wet season

TYPE OF SOIL

TESTED BY Amy McMillen

ALSO PRESENT

TRENCH DESIGN DATA: AVERAGE PERCOLATION TIME

TRENCH WIDTH

INLET DEPTH

MAXIMUM BOTTOM DEPTH

SQ. FT./BEDROOM

A50388I

COUNTY #

SOIL PROFILE

39-A

orange
brown
siltmheavy
brown
clmbrn
silmwhite
silm
mottled
H₂O

37

looks
like
39-A
but
water
was
seeping
at all
levels
of test
hole

315/348

red brn
siltmgreenish
tan
salm
<5%

Suprolite

SOIL PROFILE

316

red
brown
siltmlgt tan
siltmmottled
silm
may be
H₂O
related

INDICATE NORTH - NAME ADJOINING ROADWAY AS BASE LINE.

DATE	TEST NO.	DEPTH	PRE-WET		TEST - 1" DROP		TIME
			START	STOP	START	STOP	
3-21-96	39-A	Visual	to 12.0	— see profile	—	—	F
	317	Visual	to 12.0	— see profile	—	—	F
	315	Visual	to 12.5	— see profile	—	—	OK
	316	Visual	to 13.0	— see profile	—	—	OK
	348	Visual	to 12.5	— see profile	—	—	OK

REMARKS All wet season 3-96, left open > 3 hrs

TYPE OF SOIL

TESTED BY Amy McMillen / Craig Williams ALSO PRESENT

TRENCH DESIGN DATA: AVERAGE PERCOLATION TIME TRENCH WIDTH

INLET DEPTH MAXIMUM BOTTOM DEPTH SQ. FT./BEDROOM

APPLICATION

PERCOLATION TESTING

A 503881

P _____

HOWARD COUNTY HEALTH DEPARTMENT

BUREAU OF ENVIRONMENTAL HEALTH

3525-H ELLICOTT MILLS DRIVE/ELLICOTT CITY, MARYLAND 21043

TELEPHONE: 313-2640

DISTRICT _____

DATE 11/10/94

TO: THE COUNTY HEALTH OFFICER
ELLICOTT CITY, MARYLAND

I HEREBY APPLY FOR THE NECESSARY TEST PRIOR TO APPLICATION FOR PERMIT TO CONSTRUCT (OR RECONSTRUCT) A SEWAGE DISPOSAL SYSTEM.

PROPERTY OWNER Richard Hoenes

ADDRESS 8668 Baltimore National Pike
Ellicott City, Maryland 21043 PHONE (410) 465-2321

AGENT OR PROSPECTIVE BUYER Same

ADDRESS _____ PHONE _____


PROPERTY LOCATION:

SUBDIVISION White Property LOT NO. 810 11513

ROAD AND DESCRIPTION South side 15000 block of Carrs Mill Road; 1 mile +/- west
of Roxbury Mills Road intersection.

TAX MAP 14 PARCEL # 14

SIZE OF LOT 60,000 SF TYPE BLDG. Single Family
(SINGLE FAMILY DWELLING OR COMMERCIAL)

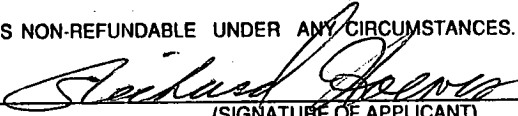THE SYSTEM INSTALLED UNDER THIS APPLICATION IS ACCEPTABLE ONLY UNTIL PUBLIC FACILITIES BECOME AVAILABLE. I FULLY UNDERSTAND THE
FEE CONNECTED WITH THE FILING OF THIS PERC TEST APPLICATION IS NON-REFUNDABLE UNDER ANY CIRCUMSTANCES. I ALSO AGREE TO
COMPLY WITH ALL M.O.S.H.A. REQUIREMENTS IN TESTING THIS LOT. 
(SIGNATURE OF APPLICANT)

APPROVED BY _____ FOR _____ DATE _____

DISAPPROVED BY _____ FOR _____ DATE _____

HOLD PENDING FURTHER TESTS _____

REASONS FOR REJECTION OR HOLDING _____

PERCOLATION TEST PLAT/PRELIMINARY PLAT - TITLE OR I.D. # _____ DATE _____

SITE DEVELOPMENT PLAN/FINAL PLAT - TITLE OR I.D. # _____ DATE _____

THIS IS NOT A PERMIT

A 50388T
COUNTY #


SOIL PROFILE

0' 1138
bright red CL
1' 1gt tan almost white SL
4' white SL large grained S. mixed color from parent rock
12'

1134
1gt brn w/ orange tint C
4' 1gt orange tan SiSL >50% rock frags OK
11'

SOIL PROFILE

0'

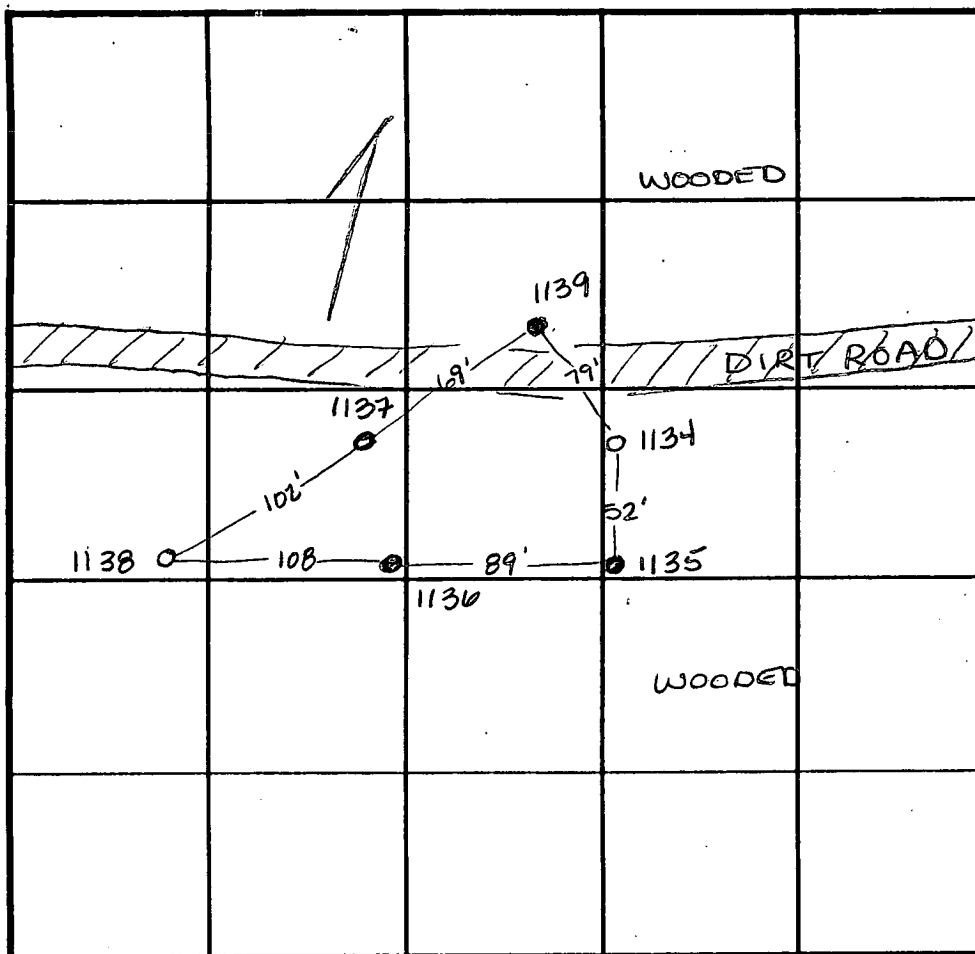

INDICATE NORTH - NAME ADJOINING ROADWAY AS BASE LINE.

DATE	TEST NO.	DEPTH	PRE-WET		TEST - 1" DROP		TIME
			START	STOP	START	STOP	
12-16-94	1138	3' / v12	5:47	5:48	5:48	5:49 ³⁰	1 1/2 min
	1137	Hard bottom at 2'					F
	1136	Hard bottom at 2'					F
	1139	Hard bottom at 4.5'					F
	1135	Hard bottom at 4'					F
	1134	4' / v11	8:28	8:29	8:29	8:30 ⁴⁵	1 3/4 min

REMARKS _____


TYPE OF SOIL _____

TESTED BY Amy McMillen ALSO PRESENT _____

TRENCH DESIGN DATA: AVERAGE PERCOLATION TIME _____ TRENCH WIDTH _____

INLET DEPTH _____ MAXIMUM BOTTOM DEPTH _____ SQ. FT./BEDROOM _____

40,458 (5330) Ft



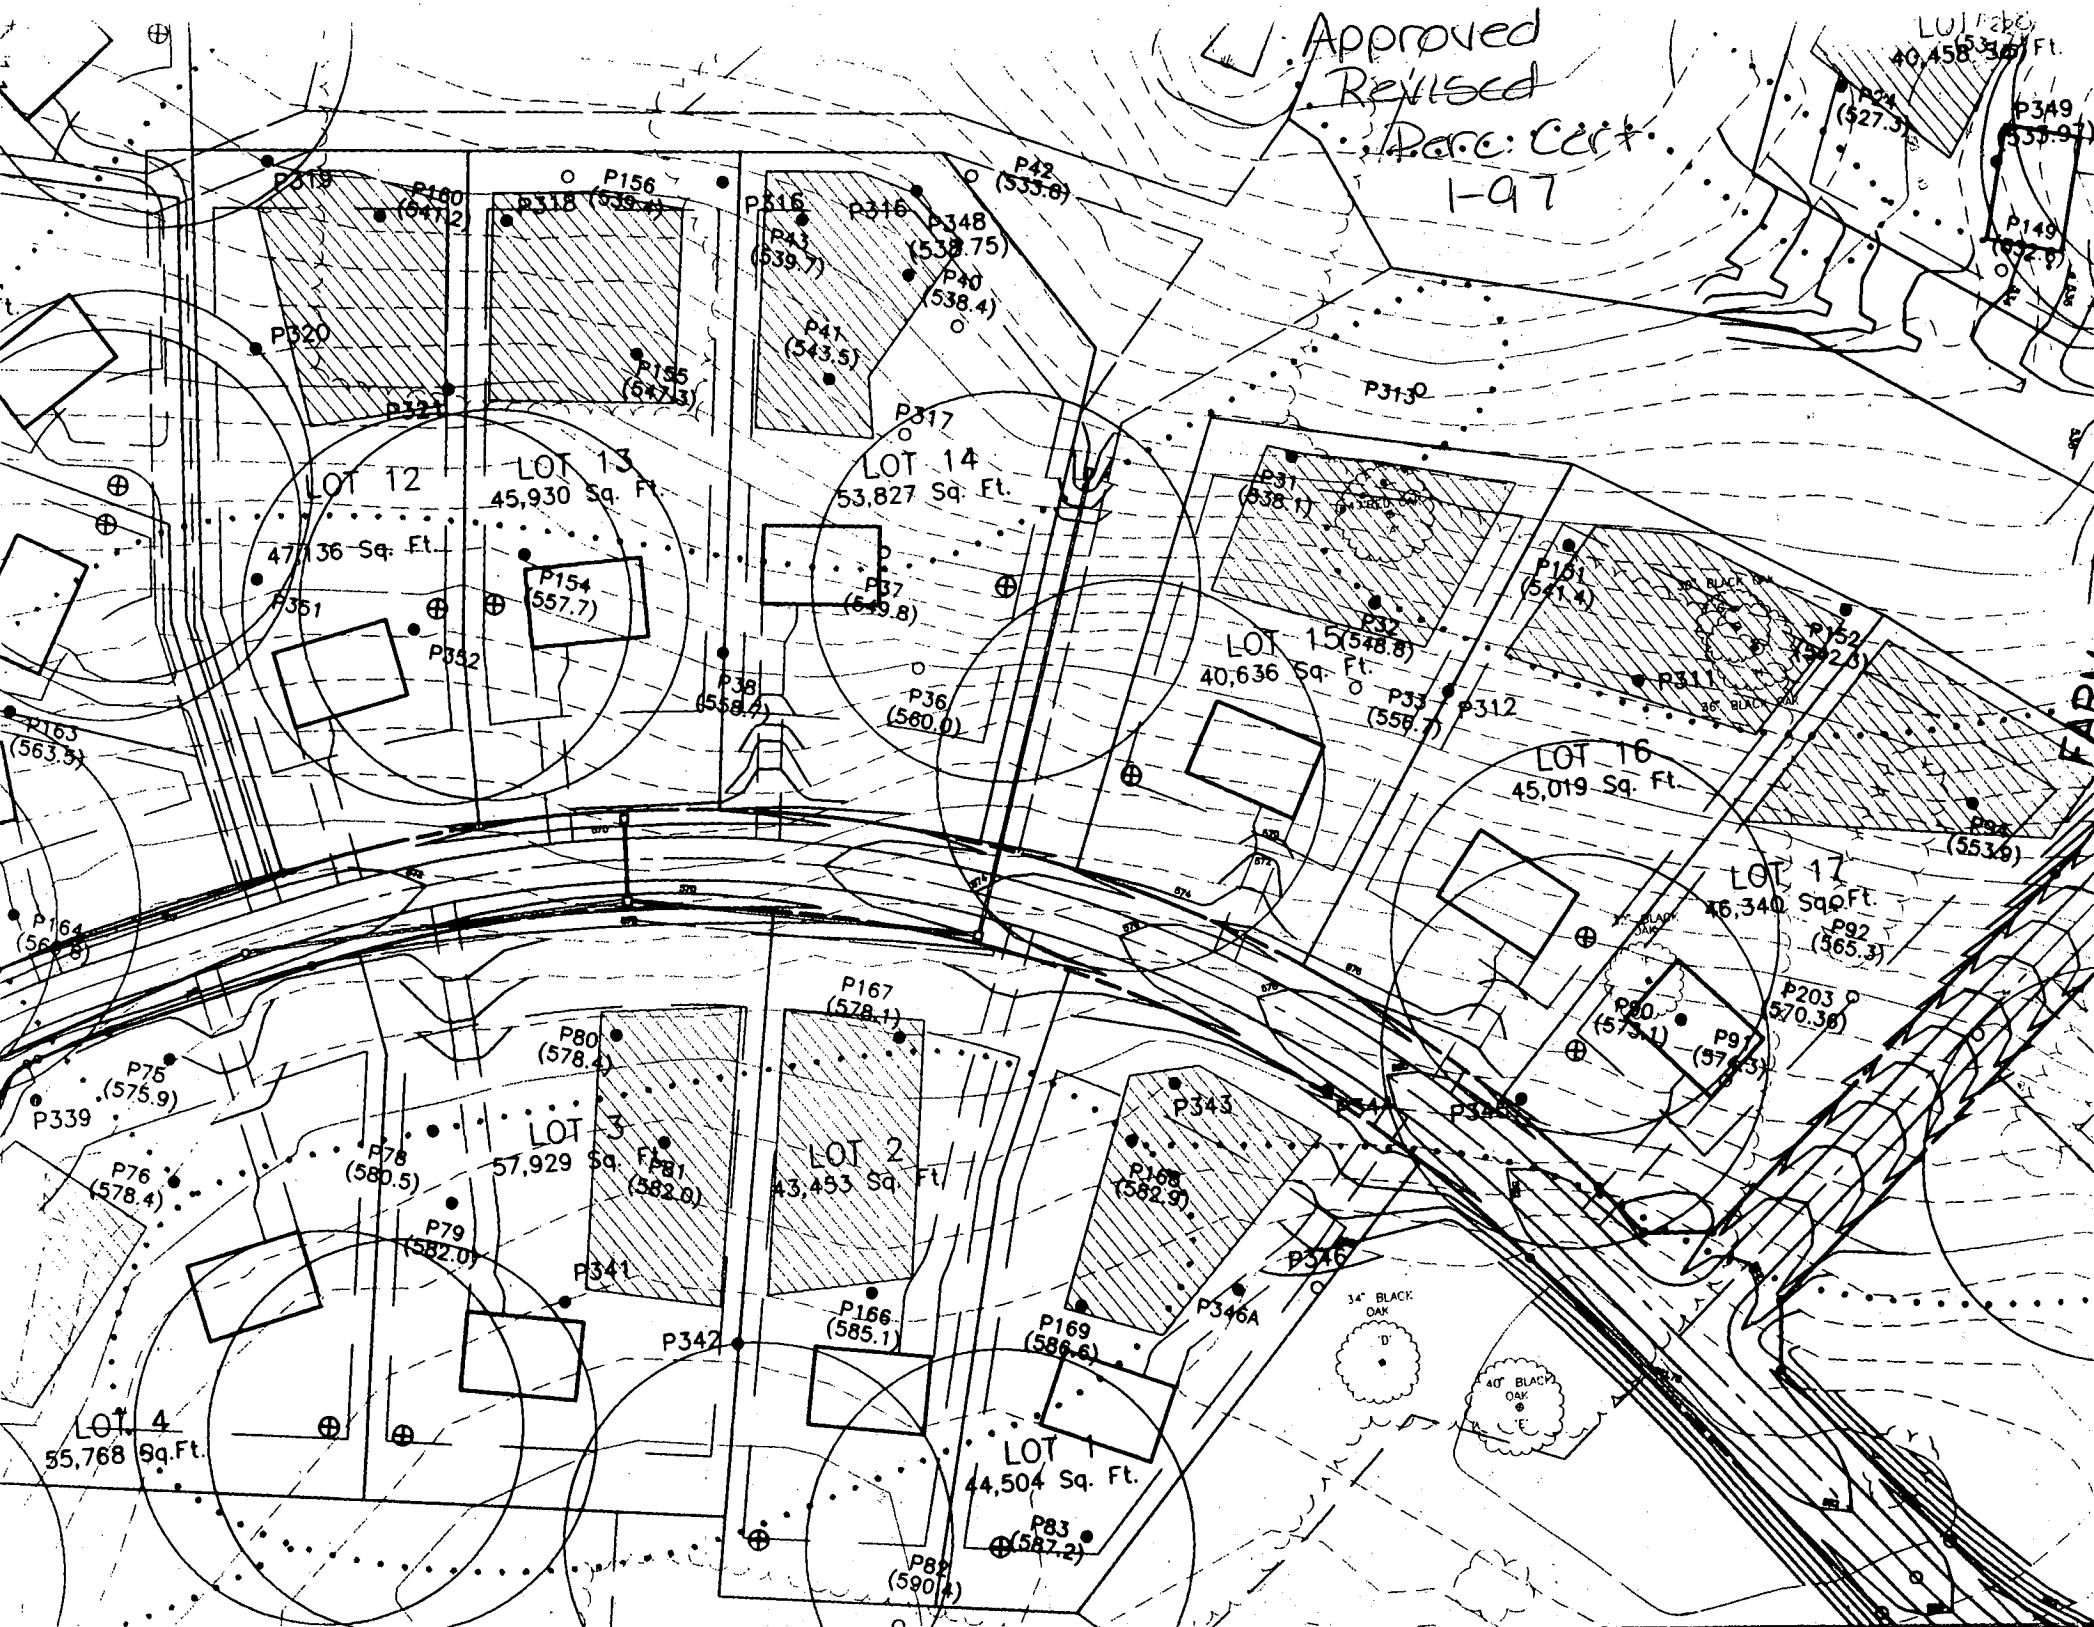


SEPTIC SYSTEM DATE CHART

LOT •	INV. AT HOUSE	INV IN AT S.T.	INV. OUT AT S.T.	GROUND AT S.T.	GROUND AT DIST BOX	INV. AT DIST BOX
1	584.8	584.4	584.1	587.4	560.0	566.0
2	581.0	580.6	580.3	586.0	584.6	579.6
3	548.7	544.0	543.7	545.0	545.0	542.0
4	536.4	536.0	535.7	539.0	533.0	532.0
5	558.4	558.0	557.7	561.0	551.0	548.0

Approved Septic System Plan
Howard County Health Department

Angie M. McCall 8/25/98
Signature Date

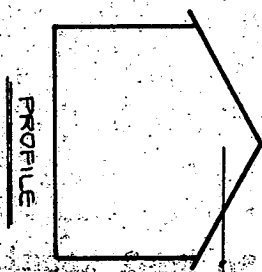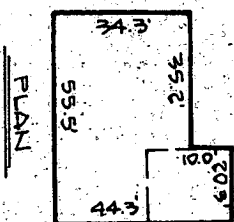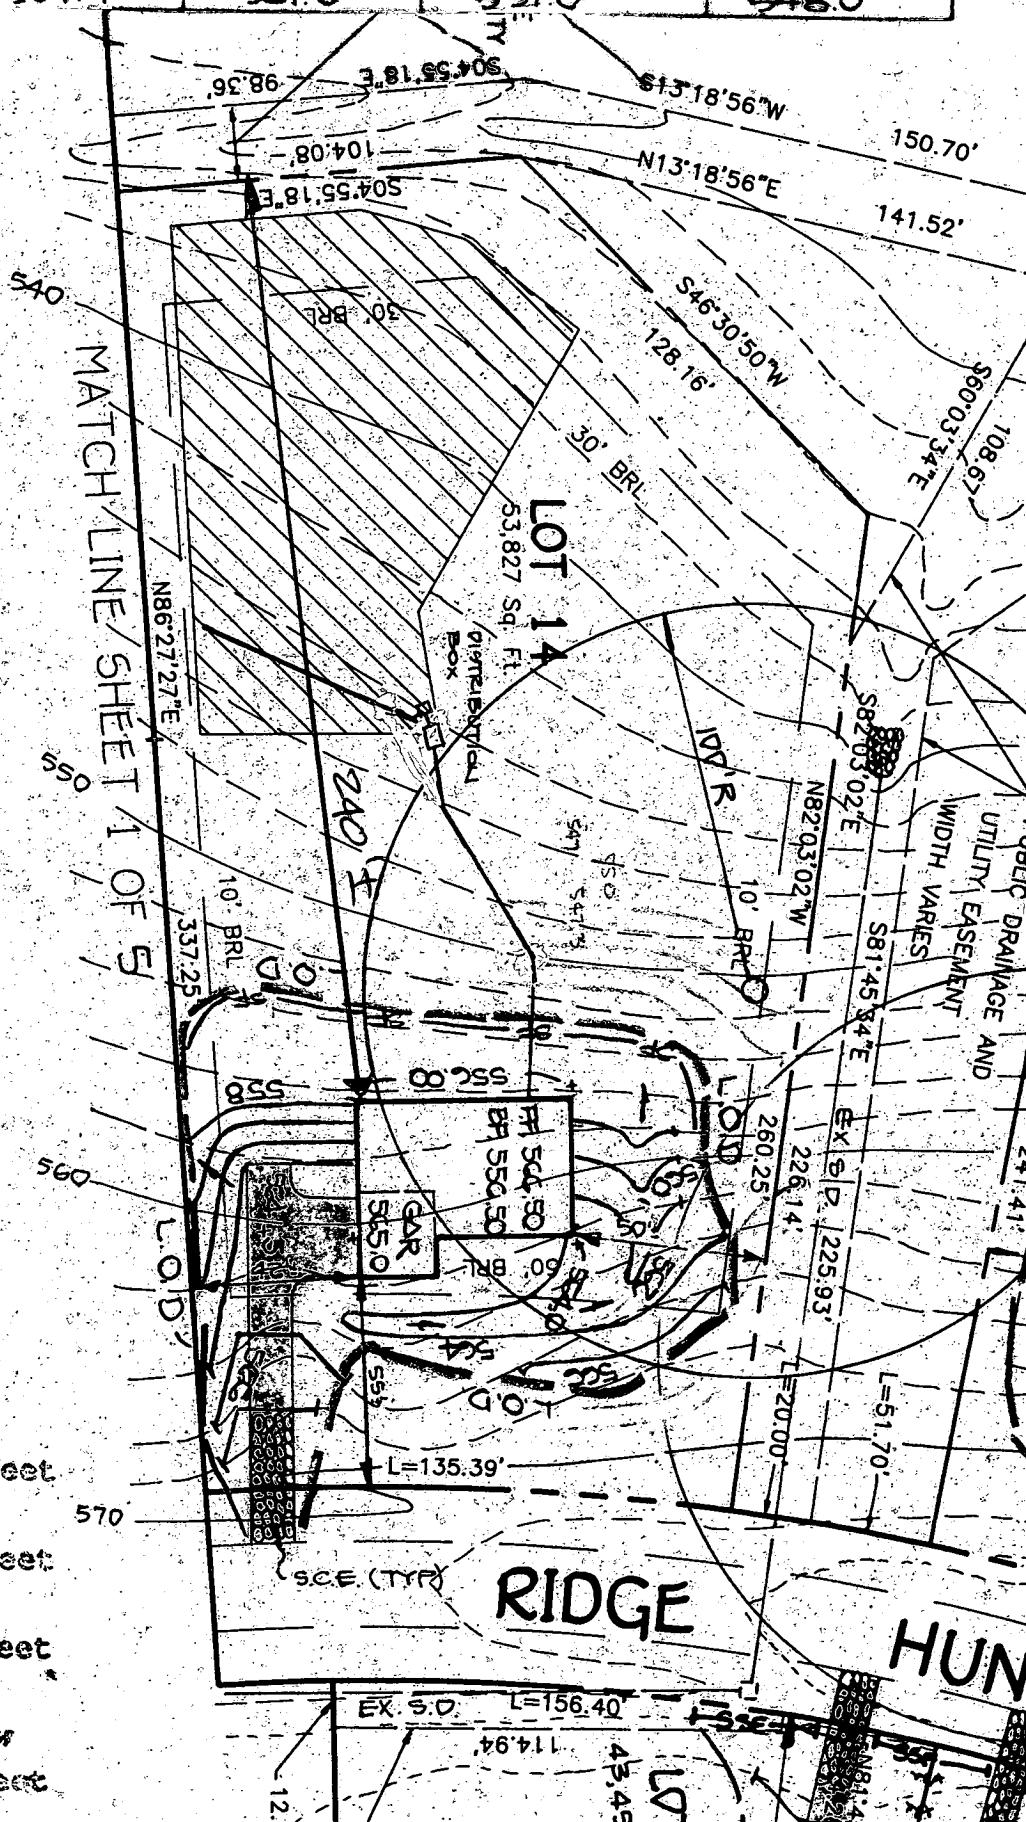

Width of trench(es) 3.0 feet

Depth of trench(es) 5.0 feet

Depth of stone required below
distribution pipe 2.0 feet

C 1 6510 SEQUENCE NO. (MDE USE ONLY)

STATE OF MARYLAND
WELL COMPLETION REPORT
FILL IN THIS FORM COMPLETELY
PLEASE PRINT OR TYPETHIS REPORT MUST BE SUBMITTED WITHIN
45 DAYS AFTER WELL IS COMPLETED.COUNTY
NUMBER A 50388J1 2 3 6
(THIS NUMBER IS TO BE PUNCHED
IN COLS. 3-6 ON ALL CARDS)ST/CO USE ONLY
DATE Received

08 06 97

DATE WELL COMPLETED

02 07 97

Depth of Well

22 140 26
(TO NEAREST FOOT)PERMIT NO.
FROM "PERMIT TO DRILL WELL"
HO - 94 - 1020

OWNER RH Development

STREET OR RFD Elen View DR

TOWN Glenwood

SUBDIVISION Elen View

SECTION

LOT 15 14

WELL LOG

Not required for driven wells

STATE THE KIND OF FORMATIONS PENETRATED, THEIR
COLOR, DEPTH, THICKNESS AND IF WATER BEARINGDESCRIPTION (Use
additional sheets if needed)

FEET

FROM

TO

check
if water
bearing

top soil

0

2

shale

2

30

sand stone
mud

30

40

sand stone

40

65

granite

65

78

Quartz

78

90

granite

90

140

GROUTING RECORD

WELL HAS BEEN GROUTED
(Circle Appropriate Box)yes
N 44

TYPE OF GROUTING MATERIAL (Circle one)

CEMENT CM

BENTONITE CLAY BC

NO. OF BAGS 22

NO. OF POUNDS 2200

GALLONS OF WATER 110

DEPTH OF GROUT SEAL (to nearest foot)

from 0 ft. to 41 ft.
(enter 0 if from surface)

CASING RECORD

casing
types
insert
appropriate
code
below

ST

STEEL

CO

CONCRETE

PL

PLASTIC

OT

OTHER

MAIN
CASING
TYPE
STNominal diameter
top (main) casing
(nearest inch)
6Total depth
of main casing
(nearest foot)
51E
A
C
H
C
A
S
I
N
G

OTHER CASING (if used)

diameter
inchdepth (feet)
from toscreen type
or open hole

SCREEN RECORD

(insert
appropriate
code
below)

ST

STEEL

BR

BRASS

PL

PLASTIC

HO

OPEN

OT

OTHER

NUMBER OF UNSUCCESSFUL WELLS: 0

WELL HYDROFRACTURED

yes
Yno
N

CIRCLE APPROPRIATE LETTER

A A WELL WAS ABANDONED AND SEALED
WHEN THIS WELL WAS COMPLETED

E ELECTRIC LOG OBTAINED

P TEST WELL CONVERTED TO PRODUCTION
WELLI HEREBY CERTIFY THAT THIS WELL HAS BEEN CONSTRUCTED IN
ACCORDANCE WITH COMAR 26.04.04 "WELL CONSTRUCTION" AND
IN CONFORMANCE WITH ALL CONDITIONS STATED IN THE ABOVE
CAPTIONED PERMIT, AND THAT THE INFORMATION PRESENTED
HEREIN IS ACCURATE AND COMPLETE TO THE BEST OF MY
KNOWLEDGE.

DRILLERS LIC. NO. MW DA 040

DRILLERS SIGNATURE
(MUST MATCH SIGNATURE ON APPLICATION)

LIC. NO. MW D 481

SITE SUPERVISOR (sign. of driller or journeyman
responsible for sitework if different from permittee)GRAVEL PACK
IF WELL DRILLED
WAS FLOWING WELL
INSERT F IN BOX 68MDE USE ONLY
(NOT TO BE FILLED IN BY DRILLER)

T

(E.R.O.S.)

W Q

70

72

74 75 76

TELESCOPE
CASINGLOG
INDICATOR

OTHER DATA

C 3

PUMPING TEST

HOURS PUMPED (nearest hour)

3

PUMPING RATE (gal. per min.)

15

METHOD USED TO
MEASURE PUMPING RATE

Bucket

WATER LEVEL (distance from land surface)

13

BEFORE PUMPING

17 20 ft.

WHEN PUMPING

22 25 ft.

TYPE OF PUMP USED (for test)

A air

P piston

T turbine

C centrifugal

R rotary

O other
(describe
below)

J jet

S submersible

PUMP INSTALLED

DRILLER WILL INSTALL PUMP
(CIRCLE) (YES or NO)

YES NO

IF DRILLER INSTALLS PUMP, THIS SECTION
MUST BE COMPLETED FOR ALL WELLS.TYPE OF PUMP INSTALLED
PLACE (A,C,J,P,R,S,T,O)
IN BOX 29.CAPACITY:
GALLONS PER MINUTE
(to nearest gallon)

31 35

PUMP HORSE POWER

37 41

PUMP COLUMN LENGTH
(nearest ft.)

43 47

CASING HEIGHT (circle appropriate box
and enter casing height)


+ above

LAND SURFACE




- below

2 (nearest
foot)

LOCATION OF WELL ON LOT

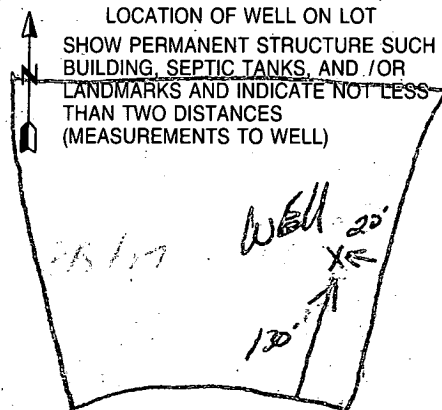
SHOW PERMANENT STRUCTURE SUCH AS
BUILDING, SEPTIC TANKS, AND /OR
LANDMARKS AND INDICATE NOT LESS
THAN TWO DISTANCES
(MEASUREMENTS TO WELL)

COUNTY

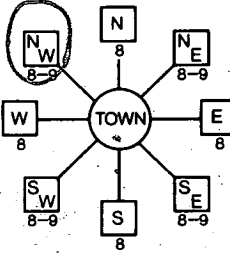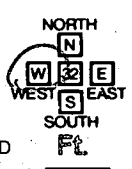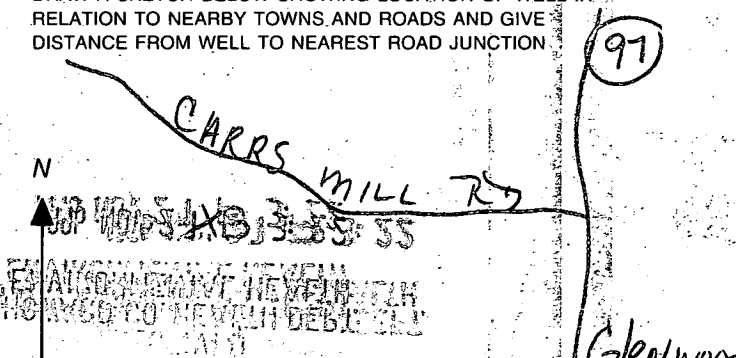B 1 2101 (THIS NUMBER IS TO BE PUNCHED IN COLS. 3-6 ON ALL CARDS)	SEQUENCE NO. (MDE USE ONLY) STATE OF MARYLAND PERMIT TO DRILL WELL please print or type	STATE PERMIT NUMBER HO - 94 - 1020 fill in this form completely
Date Received (APA) 11-27-96 8 MM DD YY 13 OWNER INFORMATION RN 6947 15 Last Name Owner First Name 34 R. H. Development L L C 36 8668 Baltimore National Pike Street or RFD Ellicott City, Md. 21043 57 Town 70 State 72 Zip 76	B 3 Howard LOCATION OF WELL 8 COUNTY 21 Glen View Ridge View Hunt 23 SUBDIVISION 42 SECTION 44 46 LOT 1814 Glenwood 52 NEAREST TOWN 71 MILES FROM TOWN (enter 0 if in town) 1 M 1 73 76 77 78	B 4 1 2 DIRECTION OF WELL FROM TOWN (CIRCLE BOX)  11 NEAR WHAT ROAD 30 Glen View Dr ON WHICH SIDE OF ROAD (CIRCLE APPROPRIATE BOX)  34 125 37 DISTANCE FROM ROAD ENTER FT OR MI 38 39 TAX MAP: _____ BLK: _____ PARCEL: _____
DRILLER INFORMATION George F. Easterday M WD 040 Driller's Name 76 License No. 81 L. Franklin Easterday, Inc. Firm Name 9265 Brown Church Rd., MT. Airy, Md. 21771 Address George F. Easterday 11/23/96 Signature Date	WELL INFORMATION 5 APPROX. PUMPING RATE (GAL. PER MIN.) 8 12 AVERAGE DAILY QUANTITY NEEDED (GAL. PER DAY) 500 14 20	
USE FOR WATER (CIRCLE APPROPRIATE BOX) ☒ HOME (SINGLE OR DOUBLE HOUSEHOLD UNIT ONLY) ☐ FARMING (LIVESTOCK WATERING & AGRICULTURAL IRRIGATION) 22 ☐ INDUSTRIAL, COMMERCIAL, STATE AND FEDERAL GOV. OTHER (REQUIRES APPROPRIATION PERMIT) ☐ PUBLIC OR PRIVATE WATER COMPANY (REQUIRES APPROPRIATION PERMIT AND STATE APPROVAL) ☐ TEST, OBSERVATION, MONITORING (MAY REQUIRE APPROPRIATION PERMIT)	NOT TO BE FILLED IN BY DRILLER, HEALTH DEPARTMENT APPROVAL Howard Co. A50388J COUNTY NAME COUNTY NO. STATE SIGNATURE _____ INSERT S → 41 DATE ISSUED 12-20-96 A M. Miller 12-20-97 43 MM DD YY 48 CO SIGNATURE EXP. DATE NORTH GRID 536 0 0 0 EAST GRID 788 0 0 0 50 55 57 63	
APPROXIMATE DEPTH OF WELL 300 FEET 24 28 APPROXIMATE DIAMETER OF WELL 6 INCH NEAREST TOWN	SHOW MAJOR FEATURES OF BOX & LOCATE WELL WITH AN X SOURCES OF DRILLING WATER 1. wells 2. 3. WRITE THE BOX NUMBER FROM THE MAP HERE E 780 N 530 000 000	
METHOD OF DRILLING (circle one) BORED (or Augered) JETTED Jetted & DRIVEN 30 AIR-ROTARY AIR-PERCussion. ROTARY (Hydraulic Rotary) 37 CABLE REVERSE-ROTARY Drive-POINT other	DRAW A SKETCH BELOW SHOWING LOCATION OF WELL IN RELATION TO NEARBY TOWNS AND ROADS AND GIVE DISTANCE FROM WELL TO NEAREST ROAD JUNCTION 	
REPLACEMENT OR DEEPEMED WELLS (CIRCLE APPROPRIATE BOX) ☒ THIS WELL WILL NOT REPLACE AN EXISTING WELL ☐ THIS WELL WILL REPLACE A WELL THAT WILL BE ABANDONED AND SEALED 39 ☐ THIS WELL WILL REPLACE A WELL THAT WILL BE USED AS A STANDBY-CONTACT LOCAL APPROVING AUTHORITY FOR POLICY ON STANDBY WELLS ☐ THIS WELL WILL DEEPEN AN EXISTING WELL PERMIT NUMBER OF WELL TO BE REPLACED OR DEEPEMED (IF AVAILABLE) 41 52	Not to be filled in by driller (MDE OR COUNTY USE ONLY) APPROP. PERMIT NUMBER 54 G A P 63 FORCE Am WRITE INITIALS IN BOX PERMIT No. HO - 94 - 1020 67 68 70 71 72 73 74 75 76 77 78 79	
SPECIAL CONDITIONS NOTE - APPROVING AUTHORITIES SHOULD USE SEPARATE SHEET IF NEEDED		

PARCEL OF SWMF

Field Measurements
Pool to Septic Line
18' to 20'

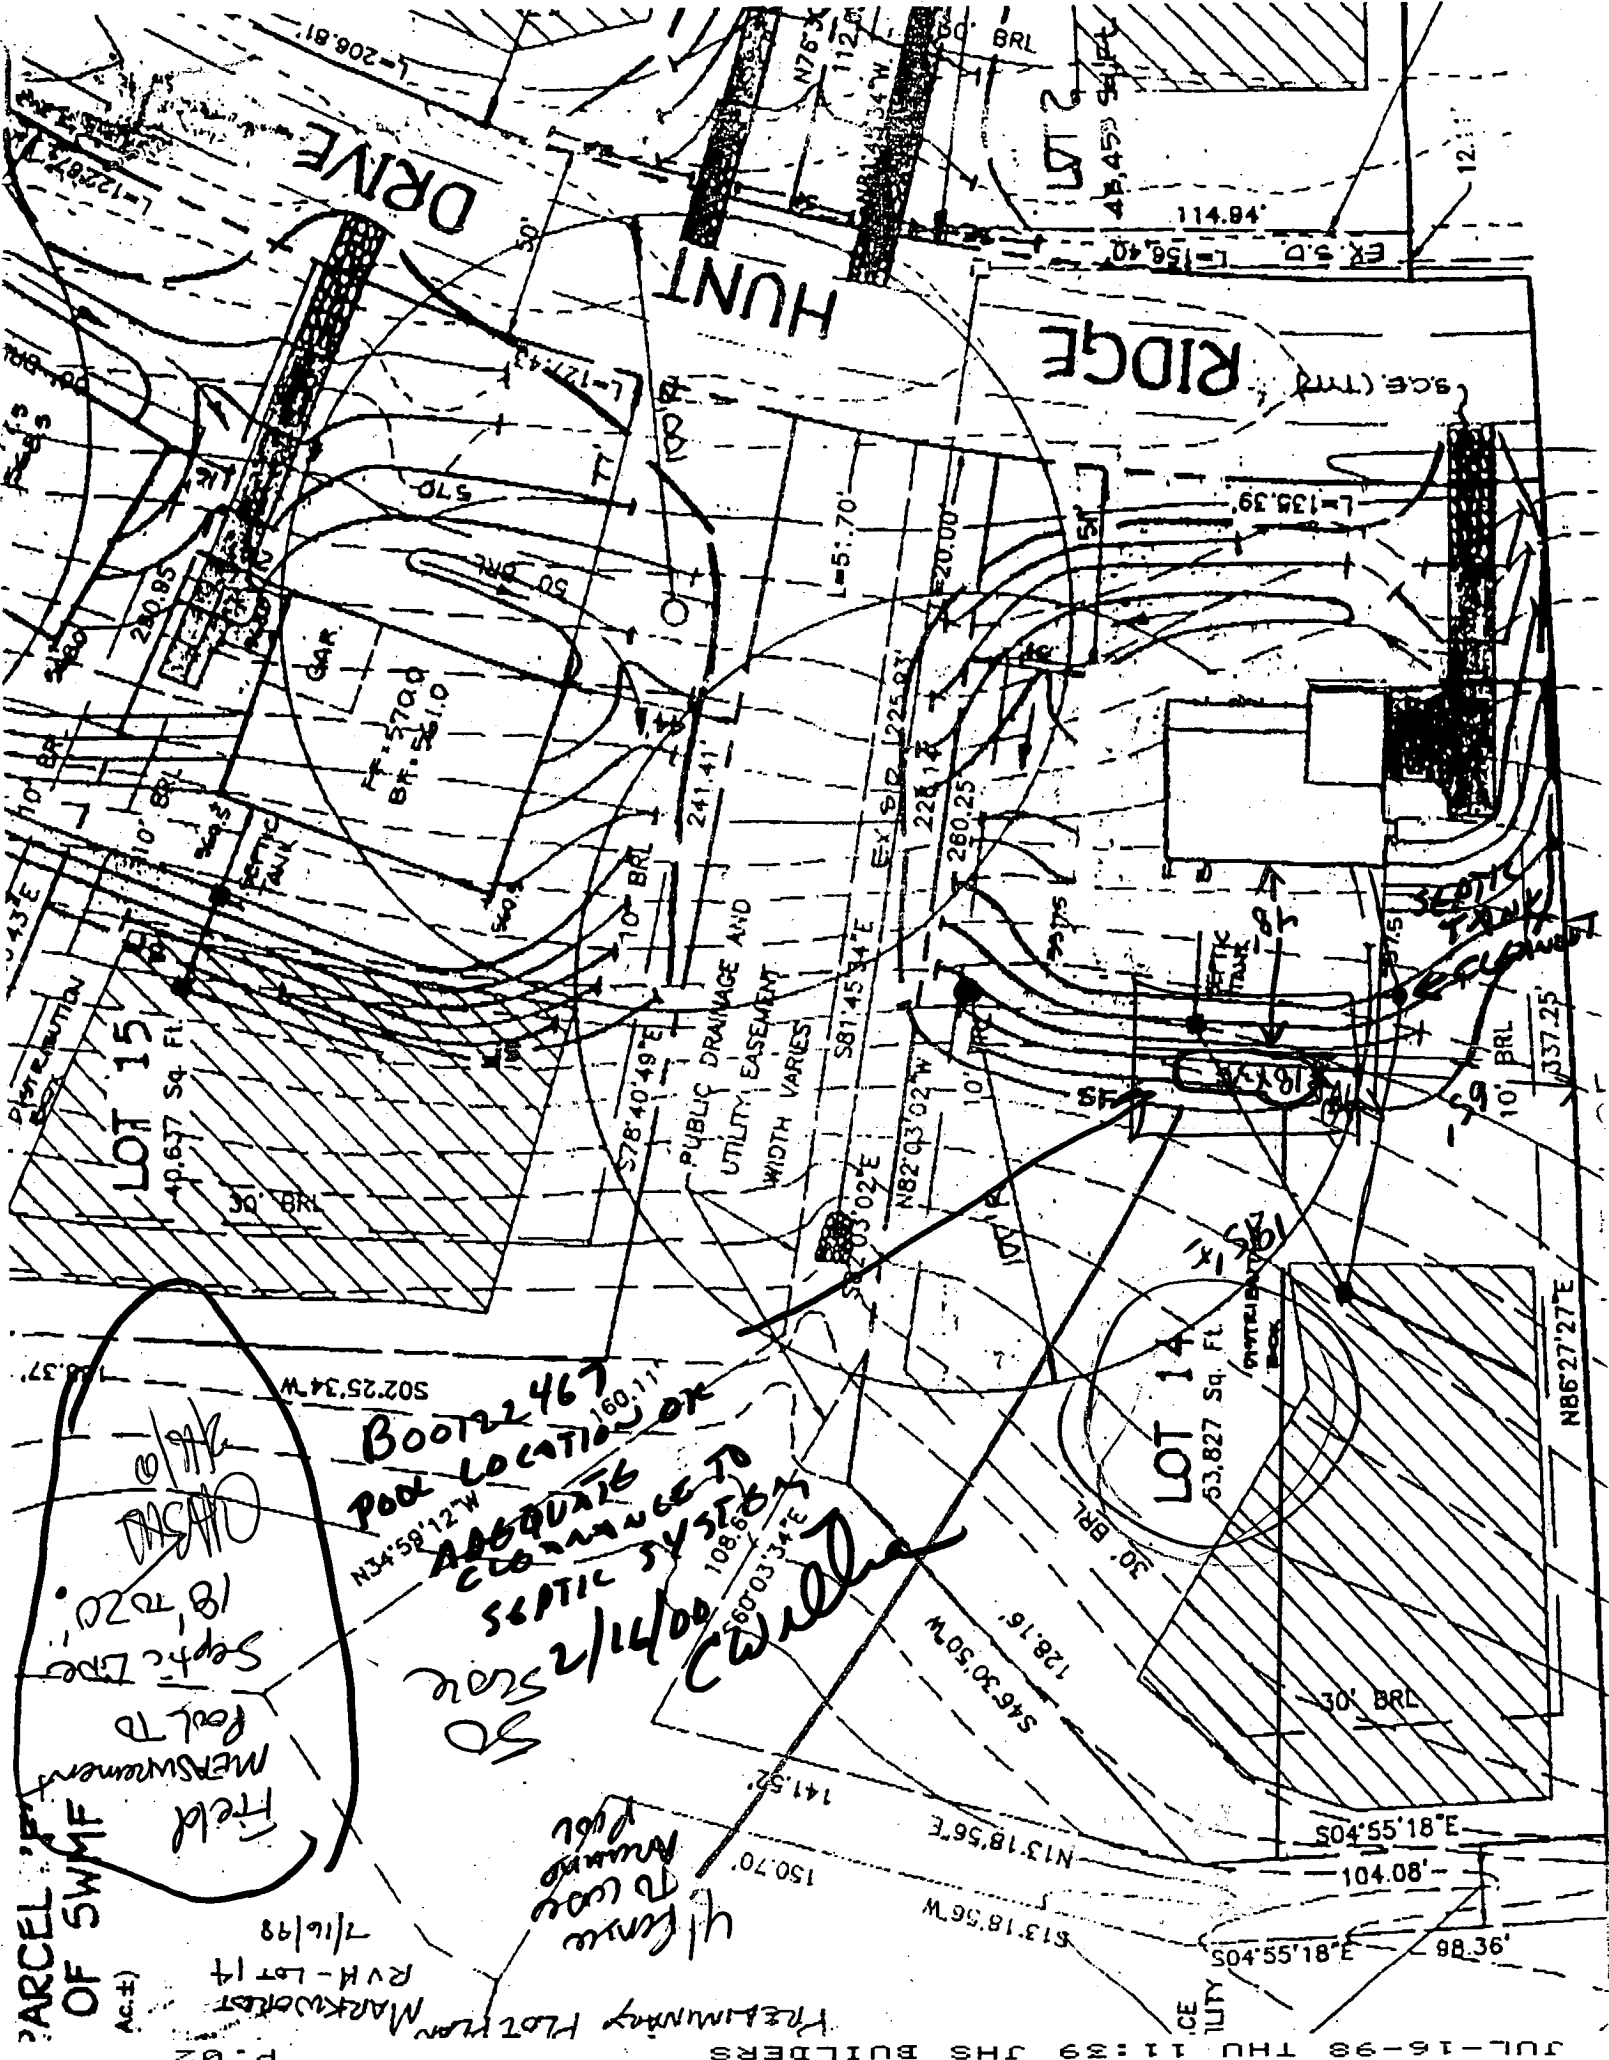

MARKED LOT 14
RVH - Lot 14
7/16/98

00022467
Pool Location or
Adequate
Clearance to
Septic System
30
00/12/2000
C. Wilkins

U/Lence
to Cool
Mound
Pool