

12/30/98

SEWAGE DISPOSAL SYSTEM

P 511327

50388-S

DEPARTMENT OF HEALTH AND MENTAL HYGIENE

DISTRICT 4th

HOWARD COUNTY HEALTH DEPARTMENT

BUREAU OF ENVIRONMENTAL HEALTH

~~XXXXXX~~ 410-313-2640

#360710
INDEXED

DATE 12/30/98

DATE SYSTEM APPROVED 12/30/98

INSPECTOR. AI

K & K Excavating

IS PERMITTED TO INSTALL ☒ ALTER

ADDRESS 14960 Route 144, Woodbine, MD 21797

PHONE 410-442-1336

SUBDIVISION Ridge View Hunt

LOT 3

ROAD 15263 Ridge Hunt Drive

PROPERTY OWNER Selfridge Builders

ADDRESS

SEPTIC TANK CAPACITY 1250 GALLONS

NUMBER OF BEDROOMS 4

180 SQUARE FEET PER BEDROOM

LINEAR FEET OF TRENCH REQUIRED 240

TRENCHES - Trench to be 3 feet wide. Inlet 3 feet below original grade. Bottom maximum depth 5 feet below original grade. Effective area begins at 3 feet below original grade. 2 feet of stone below distribution pipe.

LOCATION - Begin trenches 215 feet up the left (308.70') lot line and 50 feet off that same lot line as seen from Ridge Hunt Drive. Run trenches on contour toward the left lot line.

NOTES - No trench to exceed 100 feet in length. Provide 6" - 8" diameter cleanout and cap to grade or above on septic tank.

2/29/98 MAINTAIN 20' TO HOUSE (MR)

PLANS APPROVED BY Amy McMillen/Donna K. Soe *OK JJ 10-1-98* DATE 9-21-98

COVER NO WORK UNTIL INSPECTED AND APPROVED

NEITHER THE HOWARD COUNTY COUNCIL NOR THE HEALTH DEPARTMENT IS RESPONSIBLE FOR THE SUCCESSFUL OPERATION OF ANY SYSTEM

NOTE: CLEANOUT REQUIRED EVERY 70 FEET OF SEWER LINE AND/OR AT 90° SWEEPS IN LINES FROM HOUSE TO DRAIN FIELDS. 90° ELBOWS NOT ACCEPTABLE

NOTE: ALL PARTS OF SEPTIC SYSTEMS (I.E. TANK, DISTRIBUTION BOX TRENCHES) TO BE 100 FEET FROM WELL (UNLESS OTHERWISE SPECIFICALLY AUTHORIZED)

NOTE: IF DEEP TRENCH(ES) ARE USED CALL FOR INSPECTION BEFORE AND AFTER PLACING GRAVEL IN TRENCH(ES)

NOTE: NO DRY WELL SHALL EXCEED 15 FOOT IN DIAMETER NO ABSORPTION TRENCH TO EXCEED 100 FEET IN LENGTH

NOTE: ALL PIPE FROM HOUSE TO SEPTIC TANK MUST BE CAST IRON OR SCHEDULE 35/40 PVC OR ABS

PERMIT VOID AFTER TWO YEARS

NOTE: INSTALL STAND PIPE ON SEPTIC TANK AND DRY WELL STAND PIPES MUST BE 6 INCHES IN DIAMETER CAST IRON. CONCRETE OR TERRA COTTA OR PVA OR ABS ACCEPTED. IF TOP OF SEPTIC TANK IS DEEPER THAN 3 FEET, MANHOLE TO GRADE REQUIRED.


NOTE: DISTRIBUTION BOXES MUST HAVE BAFFLES

***INSTALLER IS RESPONSIBLE FOR OBTAINING FINAL APPROVAL ON THIS PERMIT**

*CALL 461-9933 FOR INSPECTION OF SEPTIC SYSTEM.

HD-260(6-90)

A 50388-5

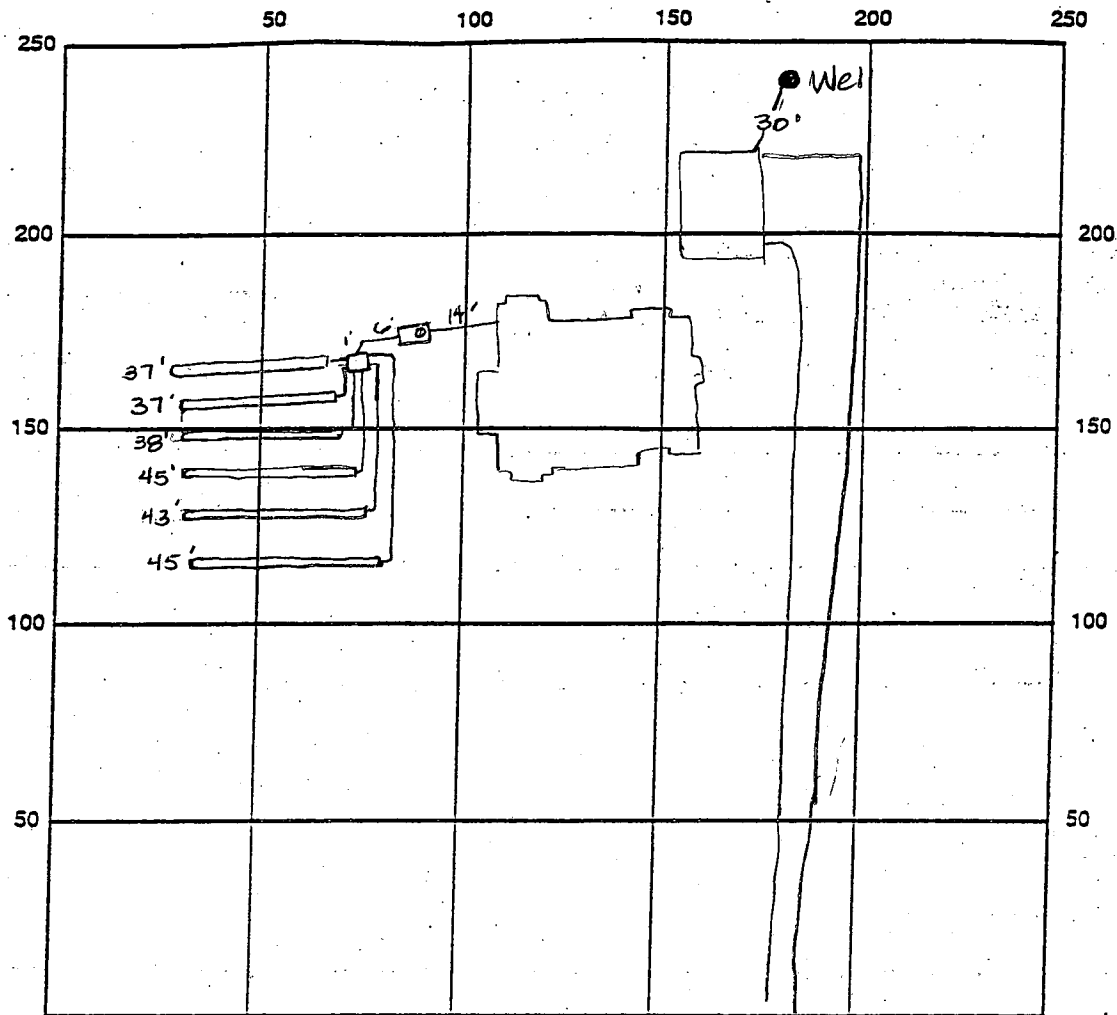

INDICATE NORTH - NAME ADJOINING ROADWAY AS BASE LINE Bridge Hunt Dr

SEPTIC TANK LEVEL OK 1500 gal CLEANOUTS OK

DISTRIBUTION BOX LEVEL OK

DRAIN FIELD/TITLE DEPTH 5.0 FT. TRENCH WIDTH 3.0 FT. INLET DEPTH 3.0 FT.

EFFECTIVE GRAVEL DEPTH 2.0 FT. TOTAL LENGTH 245 FT.

NUMBER OF TRENCHES 6 ONE SIDEWALL/BOTTOM AREA 735 SQ. FT.

DRYWALL INSIDE DIAMETER — FT. EFFECTIVE DEPTH BELOW INLET 2.0 FT.

ABSORBENT AREA — SQ. FT.

REMARKS: 12/30/98 OK to cover all work final

DATE SYSTEM APPROVED 12/30/98 INSPECTOR A. McMeel

APPLICATION

PERCOLATION TESTING

A 50388R

P _____

HOWARD COUNTY HEALTH DEPARTMENT

BUREAU OF ENVIRONMENTAL HEALTH

3525-H ELLICOTT MILLS DRIVE/ELLICOTT CITY, MARYLAND 21043
TELEPHONE: 313-2640

DISTRICT _____

DATE 11/10/94

TO: THE COUNTY HEALTH OFFICER
ELLICOTT CITY, MARYLAND

I HEREBY APPLY FOR THE NECESSARY TEST PRIOR TO APPLICATION FOR PERMIT TO CONSTRUCT (OR RECONSTRUCT) A SEWAGE DISPOSAL SYSTEM.

PROPERTY OWNER Richard Hoenes Selfridge Builders

8668 Baltimore National Pike
ADDRESS Ellicott City, Maryland 21043 PHONE (410) 465-2321

AGENT OR PROSPECTIVE BUYER Same

ADDRESS _____ PHONE _____

PROPERTY LOCATION:

SUBDIVISION White Property LOT NO. 18 17 5/4

ROAD AND DESCRIPTION South side 15000 block of Carrs Mill Road; 1 mile +/- west
of Roxbury Mills Road intersection. (15263 Ridge Hunt Drive)

TAX MAP 14 PARCEL # 14

SIZE OF LOT 60,000 SF TYPE BLDG. Single Family - 4 Brm
(SINGLE FAMILY DWELLING OR COMMERCIAL)

BLDG. PERMIT SIGNED

AND RETURNED 9-21-98

Serial # 230113583

THE SYSTEM INSTALLED UNDER THIS APPLICATION IS ACCEPTABLE ONLY UNTIL PUBLIC FACILITIES BECOME AVAILABLE. I FULLY UNDERSTAND THE
FEE CONNECTED WITH THE FILING OF THIS PERC TEST APPLICATION IS NON-REFUNDABLE UNDER ANY CIRCUMSTANCES. I ALSO AGREE TO
COMPLY WITH ALL M.O.S.H.A. REQUIREMENTS IN TESTING THIS LOT. Richard Hoenes
(SIGNATURE OF APPLICANT)

APPROVED BY _____ FOR _____ DATE _____

DISAPPROVED BY _____ FOR _____ DATE _____

HOLD PENDING FURTHER TESTS _____

REASONS FOR REJECTION OR HOLDING _____

PERCOLATION TEST PLAT/PRELIMINARY PLAT - TITLE OR I.D. # _____ DATE _____

SITE DEVELOPMENT PLAN/FINAL PLAT - TITLE OR I.D. # _____ DATE _____

THIS IS NOT A PERMIT

A50388R

COUNTY #

LOT 18

SOIL PROFILE

1176

red
brn
CL

orange
sil
very
dry
structured
(blocky)

very lgt
tan
SL
dry

1175

yellow
brn
CSL

Yel
brn
SiSL
some

pocket
of white
SiSL


Saprolite
<5%
block
structure

1178

red &
yellow
streaked
C

lgt tan
SiSL
to a
yellow
tan
SSiSL
toward
bottom
6'-9'
pocket of
white

gravelly
sand

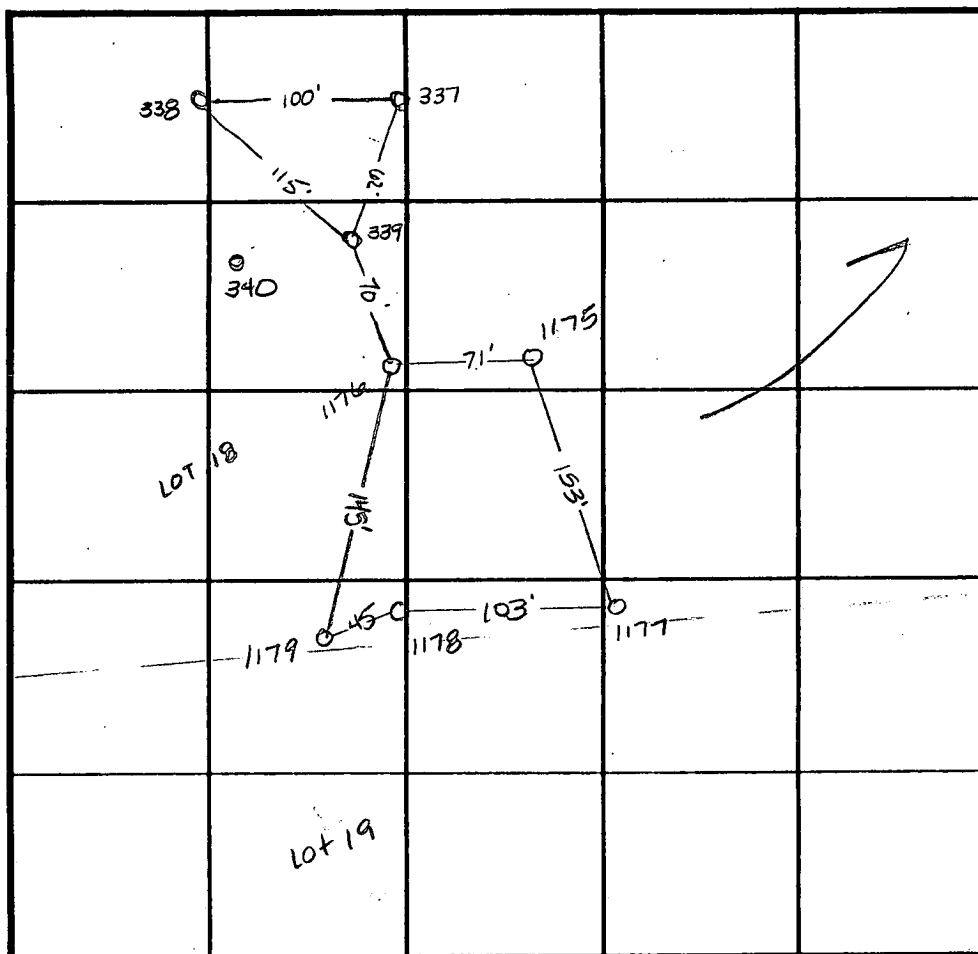

INDICATE NORTH - NAME ADJOINING ROADWAY AS BASE LINE.

SOIL PROFILE

1179

brn
CSiSL
gravelly

red
to
pink
SSiSL

1177

brn
CSiSL
orange
tan
SiSL

lgt tan
SSiSL
10-15%
rock
OK

DATE	TEST NO.	DEPTH	PRE-WET		TEST - 1" DROP		TIME
			START	STOP	START	STOP	
12-15-94	1176	4.5' V11.5	6:42 ⁴⁵	6:44	6:44	6:45 ³⁰	1 1/2 min
	1175	4' V12'	6:47 ⁴⁵	6:50 ¹⁵	6:50 ¹⁵	6:54	3 3/4 min
	1178	3.5' V11.5	7:03 ¹⁵	7:06 ³⁰	7:06 ³⁰	>30 min	slow
	1179	3.5' V12'	7:52 ³⁰	7:54	7:54	7:55 ⁴⁵	1 3/4 min
	1179	7' V12'	7:56 ¹⁵	7:57 ³⁰	7:57 ³⁰	7:59 ¹⁵	2 1/4 min
	1177	4' V12	7:59 ³⁰	8:01 ³⁰	8:01 ³⁰	8:04 ³⁰	3 min
	1178	5' V11.5	9:10 ³⁰	9:11 ⁴⁵	9:11 ⁴⁵	9:14	4 1/4 min

REMARKS

TYPE OF SOIL

TESTED BY Amy McMillen

ALSO PRESENT

TRENCH DESIGN DATA: AVERAGE PERCOLATION TIME

TRENCH WIDTH

INLET DEPTH

MAXIMUM BOTTOM DEPTH

SQ. FT/BEDROOM

A50388-R

COUNTY #

SOIL PROFILE

337

lgt tan
SiClmyellow
orange
to
pink
Salin
few
patches
of
decayed
feldspar

SOIL PROFILE

INDICATE NORTH - NAME ADJOINING ROADWAY AS BASE LINE.

DATE	TEST NO.	DEPTH	PRE-WET		TEST - 1" DROP		TIME
			START	STOP	START	STOP	
3-21-96	337	Visual	to 12.5	- see profile -			OK
	338	Visual	to 12.5	- see profile -			OK
	339	Visual	to 12.5	- see profile -			OK
	340	Visual	to 12.0	- see profile -			OK

REMARKS

TYPE OF SOIL

TESTED BY

Amy McMillen

ALSO PRESENT

TRENCH DESIGN DATA: AVERAGE PERCOLATION TIME

TRENCH WIDTH

INLET DEPTH

MAXIMUM BOTTOM DEPTH

SQ. FT./BEDROOM

APPLICATION

PERCOLATION TESTING

A 503885

P _____

HOWARD COUNTY HEALTH DEPARTMENT

BUREAU OF ENVIRONMENTAL HEALTH

3525-H ELLICOTT MILLS DRIVE/ELLICOTT CITY, MARYLAND 21043
TELEPHONE: 313-2840

DISTRICT _____

DATE 11/10/94

TO: THE COUNTY HEALTH OFFICER
ELLICOTT CITY, MARYLAND

I HEREBY APPLY FOR THE NECESSARY TEST PRIOR TO APPLICATION FOR PERMIT TO CONSTRUCT (OR RECONSTRUCT) A SEWAGE DISPOSAL SYSTEM.

PROPERTY OWNER Richard Hoenes

ADDRESS 8668 Baltimore National Pike
Ellicott City, Maryland 21043 PHONE (410) 465-2321

AGENT OR PROSPECTIVE BUYER Same

ADDRESS _____ PHONE _____

PROPERTY LOCATION:

SUBDIVISION White Property LOT NO. 19 18 22 31

ROAD AND DESCRIPTION South side 15000 block of Carrs Mill Road; 1 mile +/- west
of Roxbury Mills Road intersection.

TAX MAP 14 PARCEL # 14

SIZE OF LOT 60,000 SF TYPE BLDG. Single Family
(SINGLE FAMILY DWELLING OR COMMERCIAL)

THE SYSTEM INSTALLED UNDER THIS APPLICATION IS ACCEPTABLE ONLY UNTIL PUBLIC FACILITIES BECOME AVAILABLE. I FULLY UNDERSTAND THE
FEE CONNECTED WITH THE FILING OF THIS PERC TEST APPLICATION IS NON-REFUNDABLE UNDER ANY CIRCUMSTANCES. I ALSO AGREE TO
COMPLY WITH ALL M.O.S.H.A. REQUIREMENTS IN TESTING THIS LOT. Richard Hoenes
(SIGNATURE OF APPLICANT)

APPROVED BY _____ FOR _____ DATE _____

DISAPPROVED BY _____ FOR _____ DATE _____

HOLD PENDING FURTHER TESTS _____

REASONS FOR REJECTION OR HOLDING _____

PERCOLATION TEST PLAT/PRELIMINARY PLAT - TITLE OR I.D. # _____ DATE _____

SITE DEVELOPMENT PLAN/FINAL PLAT - TITLE OR I.D. # _____ DATE _____

THIS IS NOT A PERMIT

A503885.

COUNTY #

LOT 19

SOIL PROFILE

0' 1180 1181
brn
SSIL 1178 342

4' orange
tan
SSIL

6' Lgt
tan
SSIL
45%
rock

11'

1179

brn
SSIL
gravellyred to
pink
SSIL

12'


1177

brn
SSILorange
tan
SSIL

8'

Lgt
tan
SSIL
10-15%
rock

12'

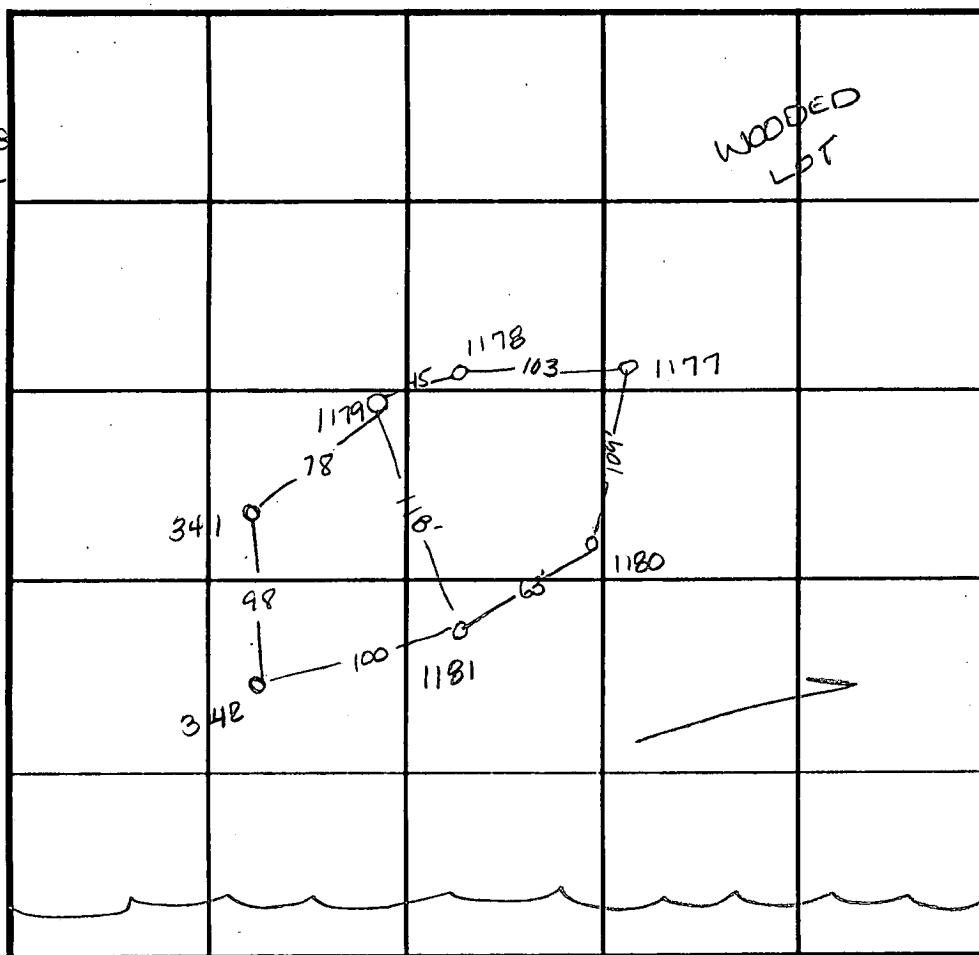

INDICATE NORTH - NAME ADJOINING ROADWAY AS BASE LINE

SOIL PROFILE

0' 1178
red's
yellow
streaked
c

3' lgt tan
SSIL
to a
yellow
tan
SSIL
toward
bottom
6-9'
packet of
white
gravelly sand

11.5' 341
red brn
SSIL
bright red
to pink
SSIL
100% grass

2.5' 40% rock
black pink
SSIL

7.5' 13.5'

DATE	TEST NO.	DEPTH	PRE-WET		TEST - 1" DROP		TIME
			START	STOP	START	STOP	
12-15-94	1180	4.1' / VII.1'	8:05 ³⁰	8:07	8:07	8:10 ¹⁵	3 1/4 min
	1181	4.5' / VII.2'	8:08	8:12	8:12	8:16 ¹⁵	4 1/4 min
	1178	5' / VII.5'	9:10 ³⁰	9:11 ⁴⁵	9:11 ⁴⁵	9:14	2 1/4 min
	1179	7' / VII.2'	7:56 ¹⁵	7:57 ³⁰	7:57 ³⁰	7:59 ¹⁵	2 1/4 min
	1179	3.5' / VII.2'	7:52 ³⁰	7:54	7:54	7:55 ⁴⁵	1 3/4 min
	1177	4' / VII.2'	7:59 ³⁰	8:01 ³⁰	8:01 ³⁰	8:04 ³⁰	3 min
	1178	3.5' / VII.5'	7:03 ¹⁵	7:06 ³⁰	> 30 min —		slow
3-20-96	341	Visual	to 13.5 — see profile —				OK
	342	Visual	to 11.0 — refusal at 11.0 —				OK

REMARKS _____

TYPE OF SOIL _____



TESTED BY Amy McMillen ALSO PRESENT _____

TRENCH DESIGN DATA: AVERAGE PERCOLATION TIME _____ TRENCH WIDTH _____

INLET DEPTH _____ MAXIMUM BOTTOM DEPTH _____ SQ. FT./BEDROOM _____

GENERAL NOTES:

- 1) THIS PLAT IS PREPARED FOR THE BENEFIT OF THE CLIENT SIGNING THE HOUSE LOCATION SURVEY APPROVAL FORM INsofar AS IT IS REQUIRED BY A LENDER OR TITLE INSURANCE COMPANY OR ITS AGENTS IN CONNECTION WITH THE CONTEMPLATED TRANSFER, FINANCING OR RE-FINANCING. UNLESS INDICATED AS BEING A BOUNDARY SURVEY, THIS PLAT IS NOT INTENDED FOR USE IN THE ESTABLISHMENT OF PROPERTY LINES AND IS NOT TO BE RELIED UPON FOR THE ESTABLISHMENT OR LOCATIONS OF FENCES, GARAGES, BUILDINGS OR OTHER EXISTING OR FUTURE IMPROVEMENTS. AS A RESULT, THIS PLAT DOES NOT PROVIDE FOR ACCURATE IDENTIFICATION OF PROPERTY LINE, BUT SUCH IDENTIFICATION MAY NOT BE REQUIRED FOR THE TRANSFER OF TITLE OR SECURING FINANCING OR RE-FINANCING.
- 2) SUBJECT PROPERTY IS SHOWN IN ZONE C ON THE NATIONAL FLOOD INSURANCE PROGRAM FLOOD INSURANCE RATE MAP OF HOWARD COUNTY, MARYLAND, COMMUNITY PANEL No. 2400440008 B, EFFECTIVE DATE: DEC. 4, 1986.
- 3) THE OFFSETS FROM BUILDING LINE TO PROPERTY LINE AS SHOWN ON THE PLAT HEREON ARE TO AN ACCURACY OF 1' PLUS OR MINUS ($\pm$).

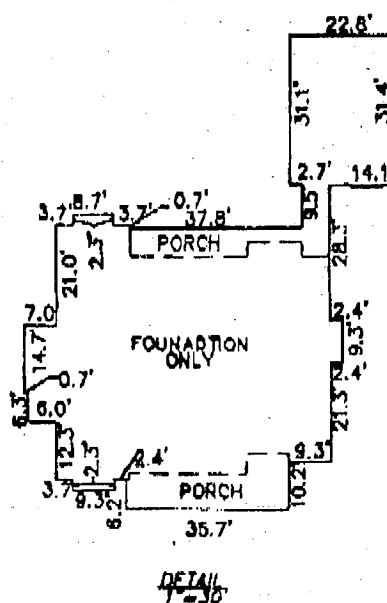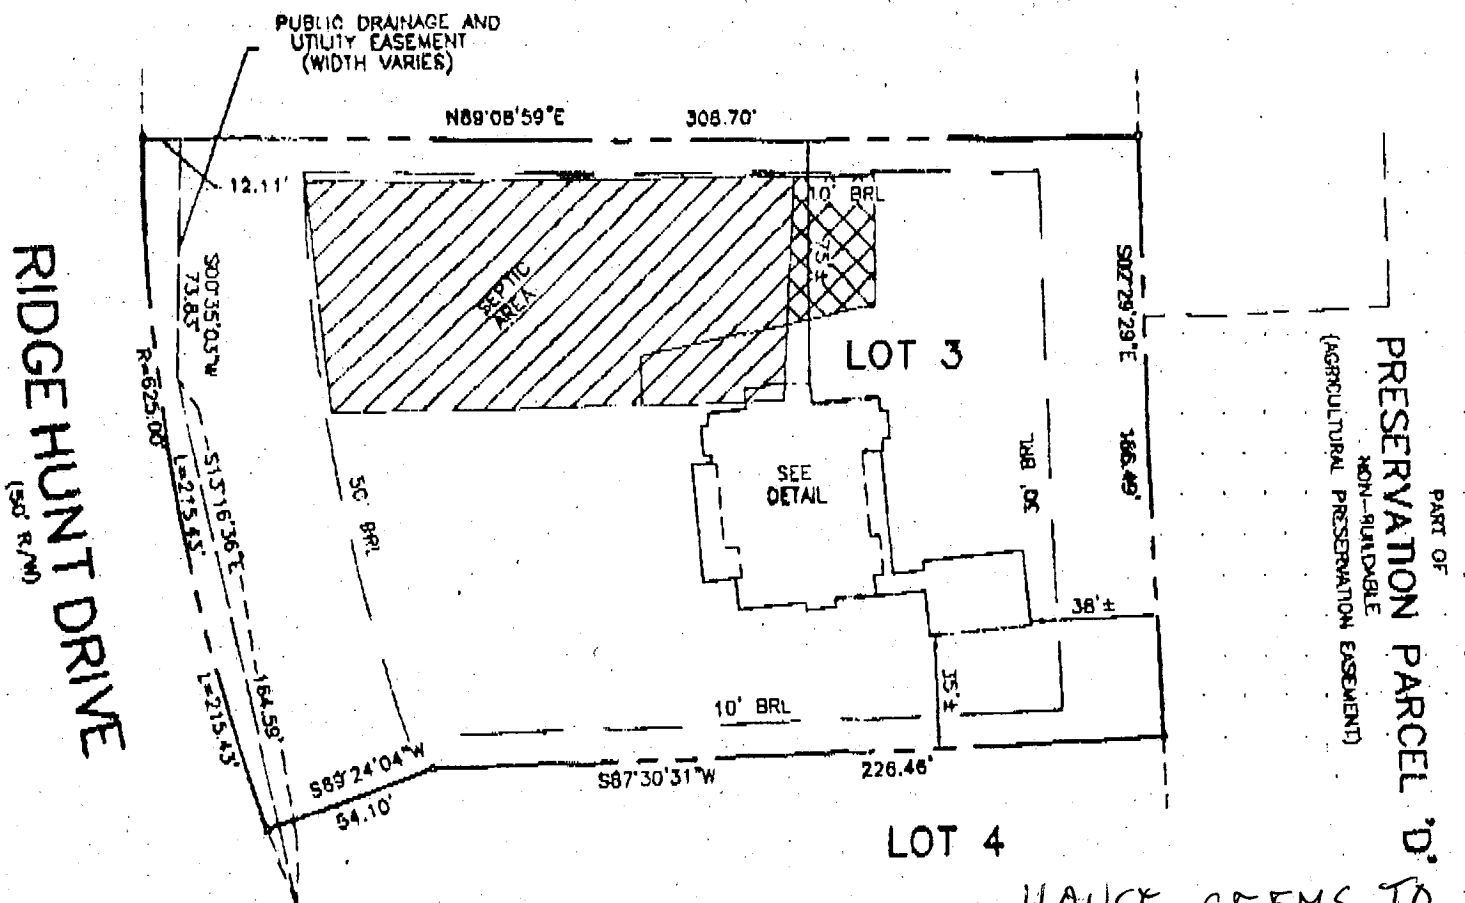

 PRIVATE SEWAGE DISPOSAL AREA
AS PER PLAT #13008

 REVISED SEWAGE DISPOSAL AREA
AS PER HOWARD COUNTY HEALTH
DEPARTMENT

B.R.L. - BUILDING RESTRICTION LINE
TOP OF FOUNDATION ELEV. -590.3'±

FISHER, COLLINS & CARTER, INC.
CIVIL ENGINEERING CONSULTANTS & LAND SURVEYORS

CENTRAL POLICE OFFICE PARK - 1077 BALTIMORE NATIONAL FIRE
BLUETT CITY, MARYLAND 21042
(410) 481 - 2800



PROFESSIONAL LAND SURVEYOR
REG. # 107603

HOUSE LOCATION
DRAWING

FOUNDATION LOCATION: 12/11/
FINAL LOCATION: _____
BOUNDARY SURVEY: _____

SCALE: 1" = 50'
DATE: 12/11/98
DRAWN BY: T.P.F.
CHECKED BY: M.R.L.
PROJECT No.: 6123J

WELL IS CLOSER THAN SHOWN TO GARAGE (~20') OK MR 9/4/98

SEPTIC SYSTEM DATA CHART

LOT #	INV. AT HOUSE	INV. IN AT S.T.	INV. OUT AT S.T.	GROUND AT S.T.	GROUND AT DIST BOX	INV. AT DIST BOX
3	585.4	586.0	584.7	587.5	587.0	584.0

MATCH LINE SHEET 2 OF 5

Approved Septic System Plan
Howard County Health Department

Signature

[Signature]

9/21/98
PRESERVATION PARCEL 'D'


NON-BUILDABLE
TOTAL AREA 14.41 Ac. ±
(AGRICULTURAL PRESERVATION EASEMENT)


depth of stone required below distribution pipe 2 feet

(width of trench(es)) 3 feet
depth of trench(es) 5 feet

Total linear feet of trench required 240 feet

CLEAN WATER DIVERSION

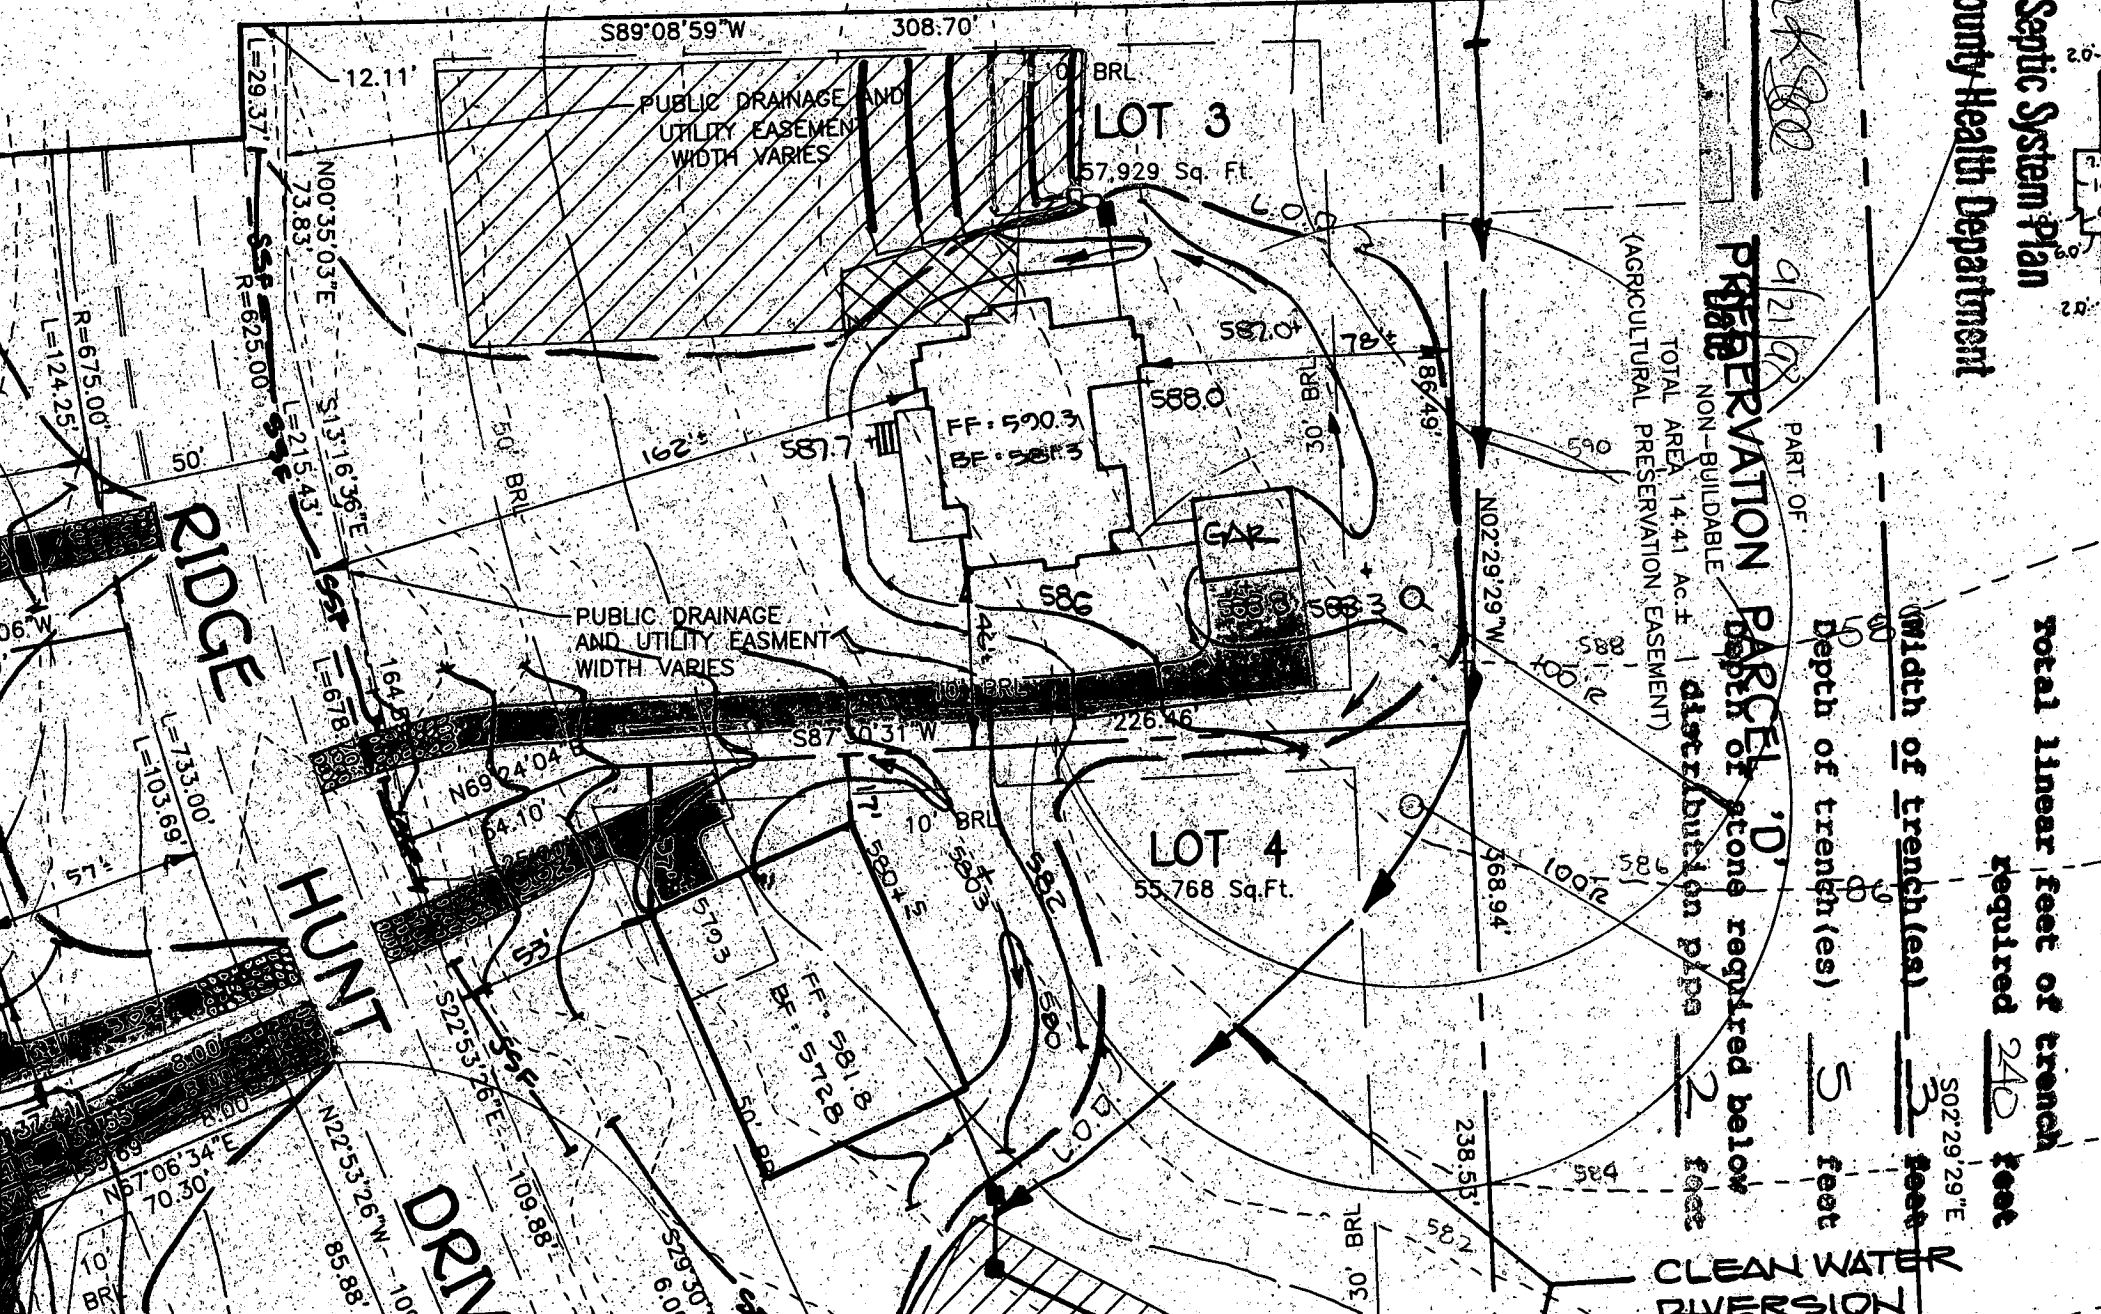

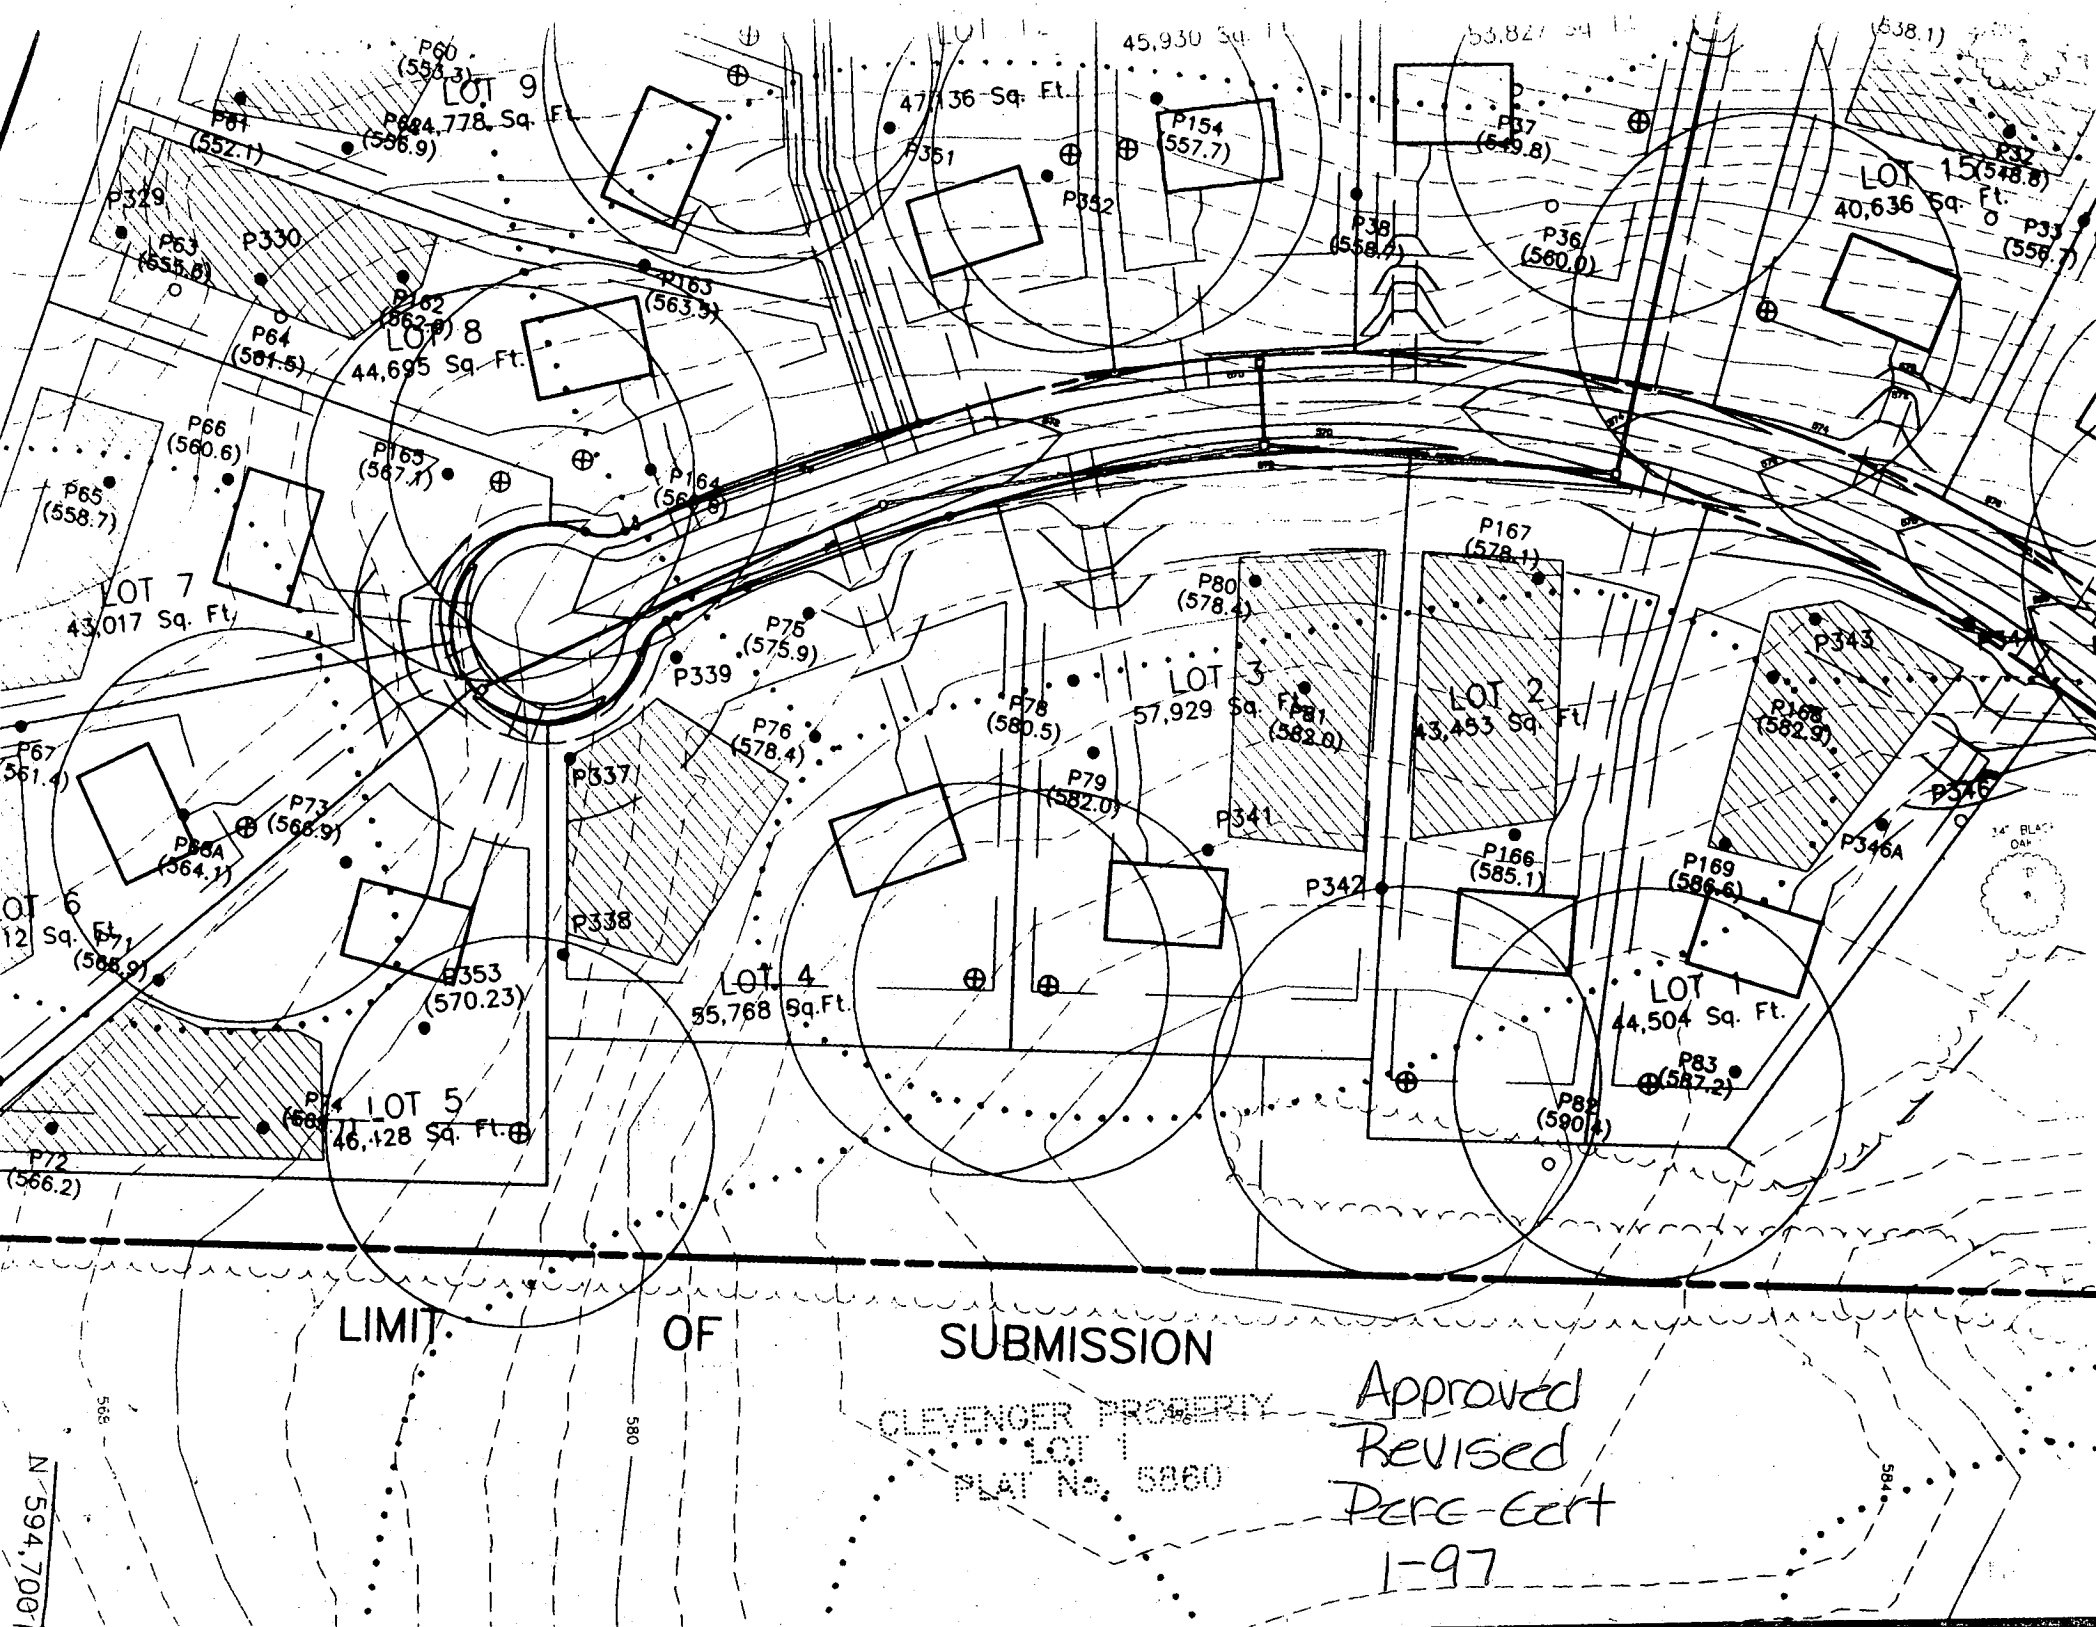

7/23/98

APPLIC ADVISED TO

~~SEND~~ SUBMIT \$225

TEST FEE, APPL. FORM

+ SITE PLAN w/PROP.

HOUSE LOC.; APPLIC ALSO


ADVISED OF TWO TEST

HOLES INVICINITY OF

PROP ADJUSTMENT (ONLY 1 OF

WHICH PASSED) + ~~CONCERN~~

OF WELLS DOWN SLOPE

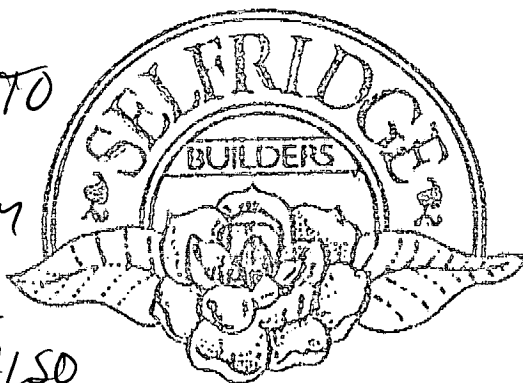

James H. Selfridge Builders, Inc.

14045 Gared Drive

Glenwood, Maryland 21738

410-992-8282

Fax 410-992-8287

ON LOTS 12 + 13

FAX TRANSMITTAL SHEET

MR

7/31/98

PERALM,

ABSOLUTELY,

NO SDA ADJ MENT

ALLOWED

TO:

CRAIG WILLIAMS

DESK SAN

FROM:

Jim SELF RIDGE

SUBJECT:

RIDGE VIEW HUNT - LOT 3 PERC REVISION

DATE:

7/22/98

NUMBER OF PAGES INCLUDING COVER SHEET: 3

ADDITIONAL INFORMATION: CRAIG - IS THIS ENOUGH

INFORMATION TO REQUEST A PERC TEST TO CHANGE

THE EASEMENT? IF NOT PLEASE LET ME KNOW.

I WILL HAVE THE EASEMENT REVISION CERTIFIED BY

OUR ENGINEER ~~BEA~~ ON THE PLOT PLAN WHEN WE SUBMIT


FOR A BUILDING PERMIT. ANY QUESTIONS

PLEASE GIVE ME A CALL.



THANKS

SIGNATURE

② REVISED PERC EASEMENT

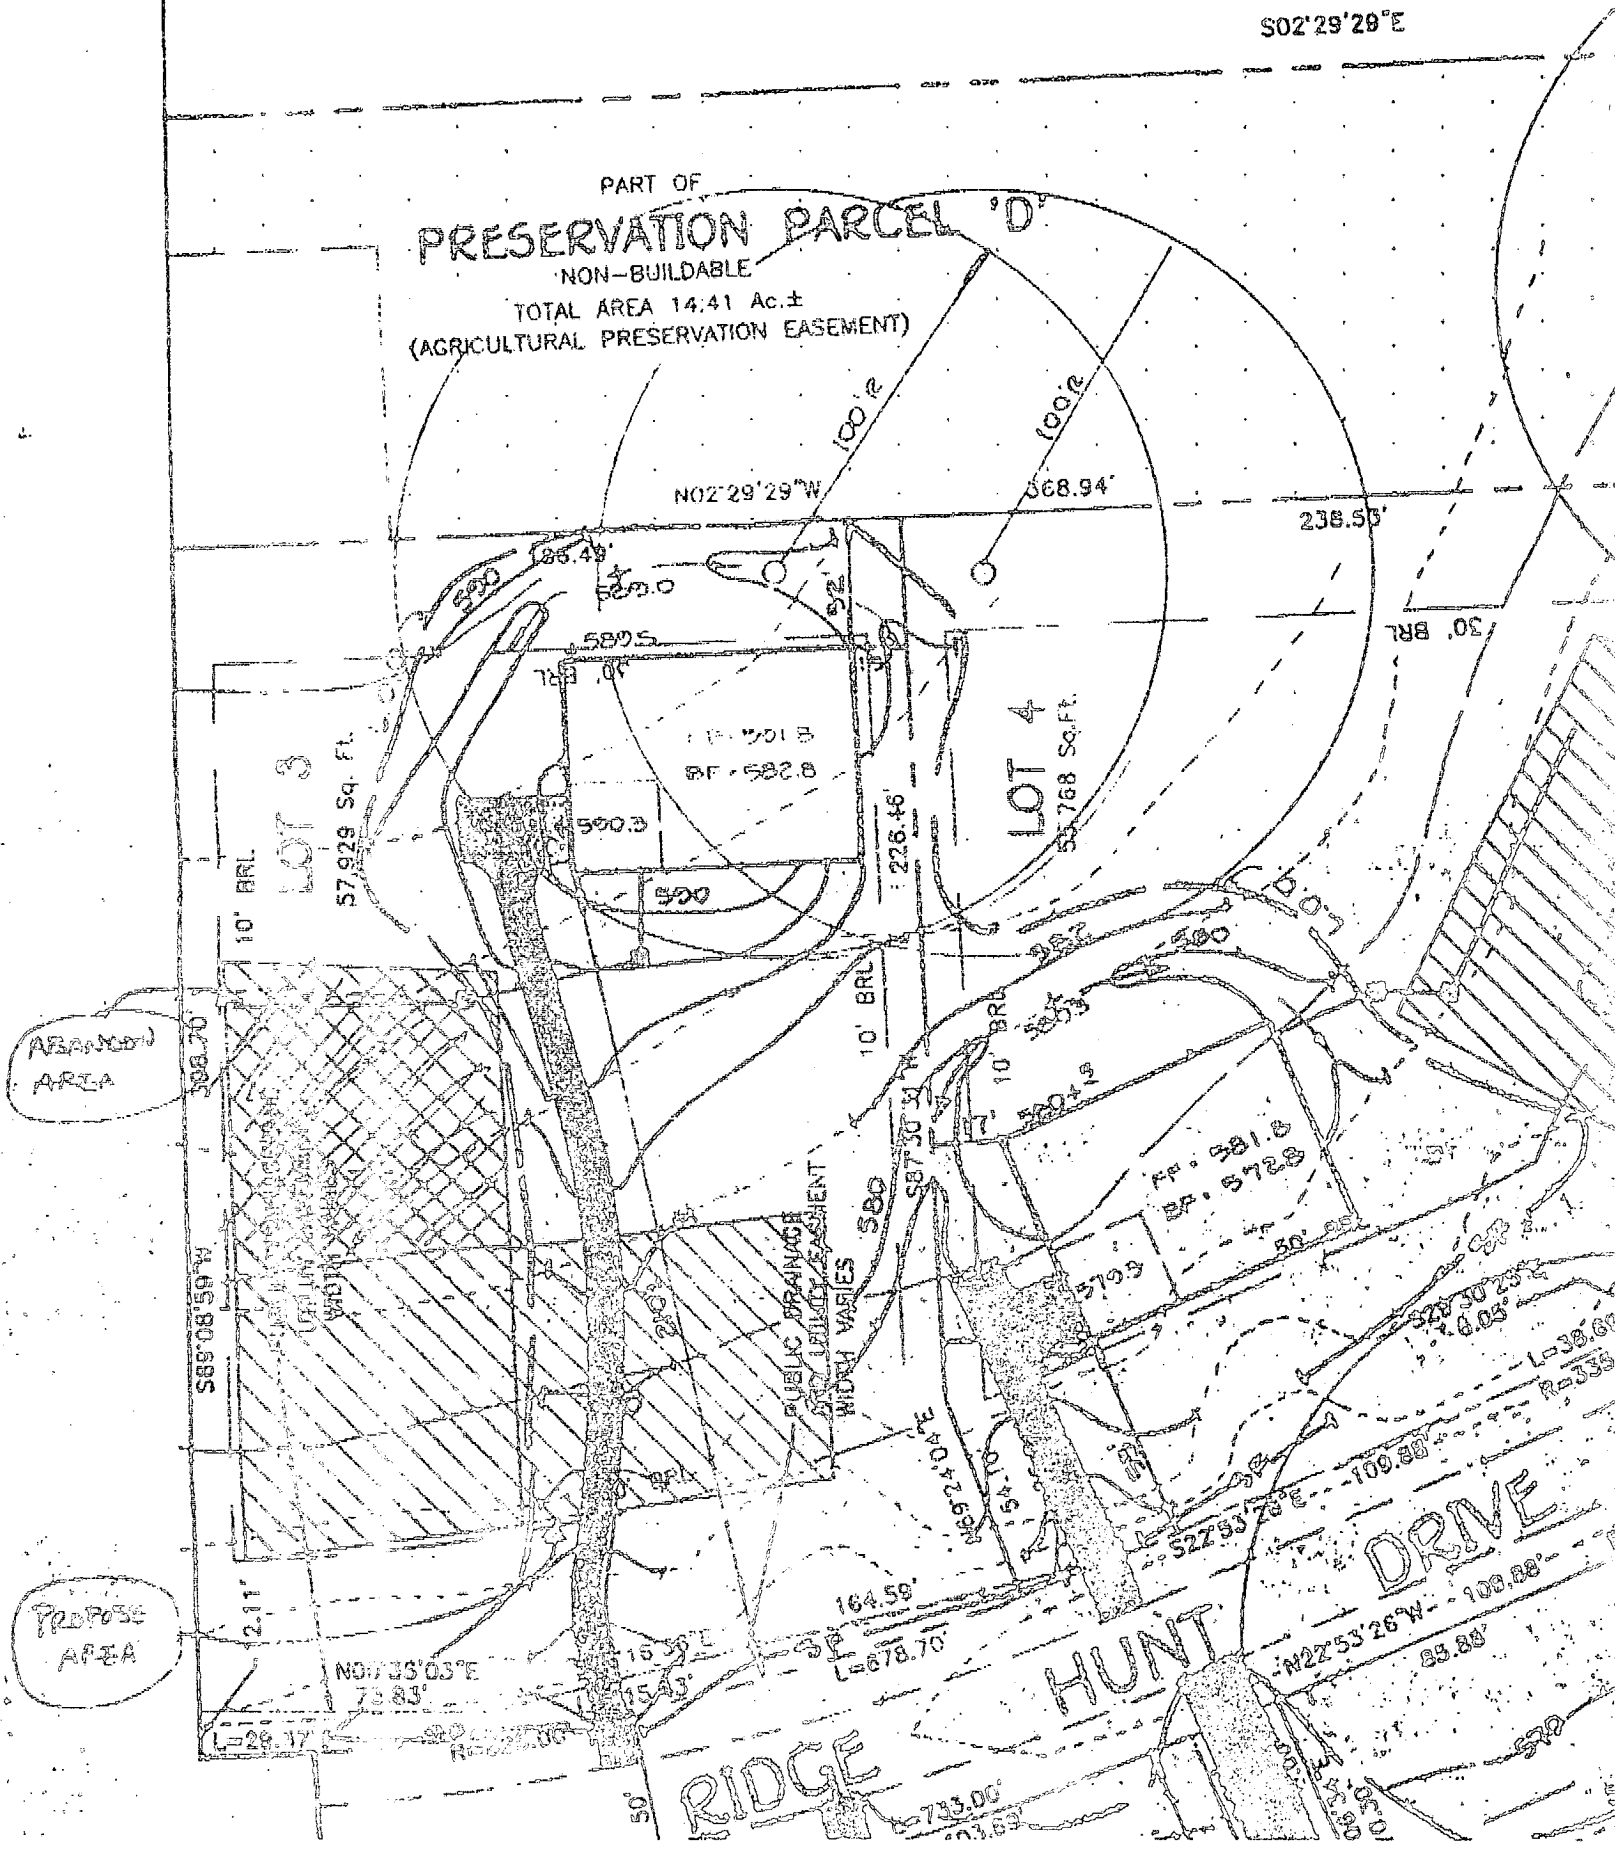

C 1		4355		SEQUENCE NO. (MDE USE ONLY)		STATE OF MARYLAND WELL COMPLETION REPORT FILL IN THIS FORM COMPLETELY. PLEASE TYPE		THIS REPORT MUST BE SUBMITTED AFTER WELL IS COMPLETED.	
ST/CO USE ONLY DATE Received MM DD YY 8 13		DATE WELL COMPLETED MM DD YY 07 02 98		Depth of Well. 22 350' 26 (TO NEAREST FOOT)		COUNTY NUMBER A 50388 S		PERMIT NO. FROM "PERMIT TO DRILL WELL" HO 94-1623	
OWNER STREET OR RFD SUBDIVISION		last name R. Selbridge Blennview Dr Ridge View Hunt		first name TOWN Blennwood		SECTION LOT 3			
WELL LOG Not required for driven wells		STATE THE KIND OF FORMATIONS PENETRATED, THEIR COLOR, DEPTH, THICKNESS AND IF WATER BEARING		GROUTING RECORD WELL HAS BEEN GROUTED (Circle Appropriate Box) TYPE OF GROUTING MATERIAL (Circle one) CEMENT ☒ CM BENTONITE CLAY ☒ BC NO. OF BAGS 9 NO. OF POUNDS 900 GALLONS OF WATER 54 DEPTH OF GROUT SEAL (to nearest foot) from 0 ft. to 26 ft. (enter 0 if from surface)		C 3 PUMPING TEST HOURS PUMPED (nearest hour) 6 PUMPING RATE (gal. per min.) 3 METHOD USED TO MEASURE PUMPING RATE Bucket WATER LEVEL (distance from land surface) BEFORE PUMPING 51 ft. WHEN PUMPING 127 ft. TYPE OF PUMP USED (for test) A air P piston T turbine C centrifugal R rotary O other (describe below) J jet S submersible			
DESCRIPTION (Use additional sheets if needed)		FEET FROM TO		check if water bearing		C 2 DEPTH (nearest ft.) 1 HO 26 350 2 23 24 26 30 32 36 3 38 39 41 45 47 51 SLOT SIZE 1 2 3 DIAMETER OF SCREEN 56 60 (NEAREST INCH) from to GRAVEL PACK IF WELL DRILLED WAS FLOWING WELL INSERT F IN BOX 68		PUMP INSTALLED DRILLER INSTALLED PUMP (CIRCLE) (YES or NO) YES NO IF DRILLER INSTALLS PUMP, THIS SECTION MUST BE COMPLETED FOR ALL WELLS. TYPE OF PUMP INSTALLED PLACE (A,C,J,P,R,S,T,O) IN BOX 29 CAPACITY: GALLONS PER MINUTE (to nearest gallon) 31 35 PUMP HORSE POWER 37 41 PUMP COLUMN LENGTH (nearest ft.) 43 47 CASING HEIGHT (circle appropriate box and enter casing height) + above LAND SURFACE - below 2 (nearest foot) LOCATION OF WELL ON LOT SHOW PERMANENT STRUCTURES AND INDICATE NOT LESS THAN TWO DISTANCES (MEASUREMENTS TO WELL) 250' well 125' Prop Lin	
NUMBER OF UNSUCCESSFUL WELLS: 0		WELL HYDROFRACTURED yes Y no N		CIRCLE APPROPRIATE LETTER A A WELL WAS ABANDONED AND SEALED WHEN THIS WELL WAS COMPLETED E ELECTRIC LOG OBTAINED P TEST WELL CONVERTED TO PRODUCTION WELL		MDE USE ONLY (NOT TO BE FILLED IN BY DRILLER) T (E.R.O.S.) W Q 70 72 74 75 76 TELESCOPE CASING LOG INDICATOR OTHER DATA			
I HEREBY CERTIFY THAT THIS WELL HAS BEEN CONSTRUCTED IN ACCORDANCE WITH COMAR 26.04.04 "WELL CONSTRUCTION" AND IN CONFORMANCE WITH ALL CONDITIONS STATED IN THE ABOVE CAPTIONED PERMIT, AND THAT THE INFORMATION PRESENTED HEREIN IS ACCURATE AND COMPLETE TO THE BEST OF MY KNOWLEDGE.		DRILLERS LIC. NO. M S D 116 Ralph Wayne DRILLERS SIGNATURE (MUST MATCH SIGNATURE ON APPLICATION) LIC. NO. M S D 112 Ralph E. Wayne		SITE SUPERVISOR (sign. of driller or journeyman responsible for sitework if different from permittee)					

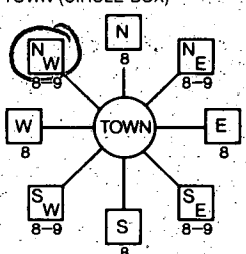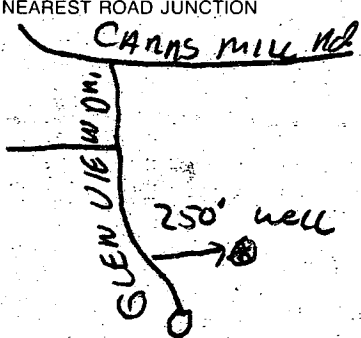B 1 <u>4761</u> 1 2 3 4 5 6	SEQUENCE NO. (MDE USE ONLY)	STATE OF MARYLAND PERMIT TO DRILL WELL please print or type	STATE PERMIT NUMBER <u>HO-94-1623</u> fill in this form completely
Date Received (APA) <u>7.6.98</u> 8 MM DD YY 13 OWNER INFORMATION 15 Last Name <u>SELRIDGE</u> Owner <u>Builders Inc</u> First Name <u>Dr.</u> 34 36 <u>17045 GARZO DR.</u> Street or RFD 55 <u>GLENWOOD MD 21738</u> 57 Town 70 State 72 Zip 76		B 3 <u>Howard</u> LOCATION OF WELL 8 COUNTY <u>RIDGE VIEW Hunt</u> 21 23 SUBDIVISION _____ 42 SECTION _____ LOT <u>3</u> 44 46 48 50 <u>GLENWOOD</u> 52 NEAREST TOWN _____ 71 MILES FROM TOWN (enter 0 if in town) <u>2</u> M I 73 76 77 78	
DRILLER INFORMATION Driller's Name <u>Ralph MAYNE</u> MS D 116 76 License No. 81 Firm Name <u>Ralph MAYNE well drilling</u> Address <u>9120 Brown Church Rd Mt Airy</u> <u>John Mayne</u> 6-29-98 Signature Date		B 4 <u>GLENVIEW MD</u> 11 NEAR WHAT ROAD 30 ON WHICH SIDE OF ROAD (CIRCLE APPROPRIATE BOX) NORTH ☒ N ☐ E ☐ S ☐ W WEST SOUTH EAST 34 <u>250</u> 37 DISTANCE FROM ROAD <u>ft</u> ENTER FT OR MI 38 39 TAX MAP: <u>14</u> BLK: <u>8/9</u> PARCEL <u>14</u>	
B 2 WELL INFORMATION 1 2 APPROX. PUMPING RATE <u>5</u> (GAL. PER MIN.) 8 500 12 AVERAGE DAILY QUANTITY NEEDED <u>500</u> (GAL. PER DAY) 14 20		DIRECTION OF WELL FROM TOWN (CIRCLE BOX) 	
USE FOR WATER (CIRCLE APPROPRIATE BOX) ☒ D DOMESTIC POTABLE SUPPLY & RESIDENTIAL IRRIGATION ☐ F FARMING (LIVESTOCK WATERING & AGRICULTURAL IRRIGATION) 22 ☐ I INDUSTRIAL, COMMERCIAL, DEWATERING ☐ P PUBLIC WATER SUPPLY WELL ☐ T TEST, OBSERVATION, MONITORING ☐ G GEO-THERMAL		NOT TO BE FILLED IN BY DRILLER HEALTH DEPARTMENT APPROVAL <u>Howard</u> <u>A 50388 S</u> COUNTY NAME COUNTY NO. STATE SIGNATURE _____ INSERT S → DATE ISSUED <u>7.13.98</u> <u>Kim Minto</u> <u>7.13.99</u> 41 43 MM DD YY 48 CO SIGNATURE EXP. DATE NORTH GRID <u>536</u> 000 EAST GRID <u>788</u> 000 50 55 57 63	
APPROXIMATE DEPTH OF WELL <u>150</u> FEET 24 28 APPROXIMATE DIAMETER OF WELL <u>6"</u> NEAREST INCH		SHOW MAJOR FEATURES OF BOX & LOCATE WELL WITH AN X SOURCES OF DRILLING WATER 1. <u>well</u> 2. _____ 3. _____ WRITE THE BOX NUMBER FROM THE MAP HERE E <u>79888</u> N <u>54036</u> ← 000 000	
METHOD OF DRILLING (circle one) BORED (or Augered) JETTED Jetted & DRIVEN 30 <u>AIR-ROTARY</u> AIR-PERCussion ROTARY (Hydraulic Rotary) 37 <u>CABLE</u> REVERSE-ROTARY Drive-POINT other _____		DRAW A SKETCH BELOW SHOWING LOCATION OF WELL IN RELATION TO NEARBY TOWNS AND ROADS AND GIVE DISTANCE FROM WELL TO NEAREST ROAD JUNCTION 	
REPLACEMENT OR DEEPEENED WELLS (CIRCLE APPROPRIATE BOX) ☒ N THIS WELL WILL NOT REPLACE AN EXISTING WELL ☐ Y THIS WELL WILL REPLACE A WELL THAT WILL BE ABANDONED AND SEALED 39 ☐ S THIS WELL WILL REPLACE A WELL THAT WILL BE USED AS A STANDBY-CONTACT LOCAL APPROVING AUTHORITY FOR POLICY ON STANDBY WELLS ☐ D THIS WELL WILL DEEPEEN AN EXISTING WELL PERMIT NUMBER OF WELL TO BE REPLACED OR DEEPEENED (IF AVAILABLE) - 41 _____ 52		Not to be filled in by driller (MDE OR COUNTY USE ONLY) APPROP. PERMIT NUMBER _____ GAP _____ 54 63 PERMIT No. <u>HO-94-1623</u> 70 71 72 73 74 75 76 77 78 79	
SPECIAL CONDITIONS NOTE - APPROVING AUTHORITIES SHOULD USE SEPARATE SHEET IF NEEDED			